



SANITARY SEWER TO SERVE LOT 1,
MOBILE MANOR SOUTH ADDITION
PROJECT NO. 895PPS
BUILT BY MIES CONSTRUCTION CO.
BOOKED 4/10/00 PER AS BUILT PLAN



SCALE: 1" = 100'

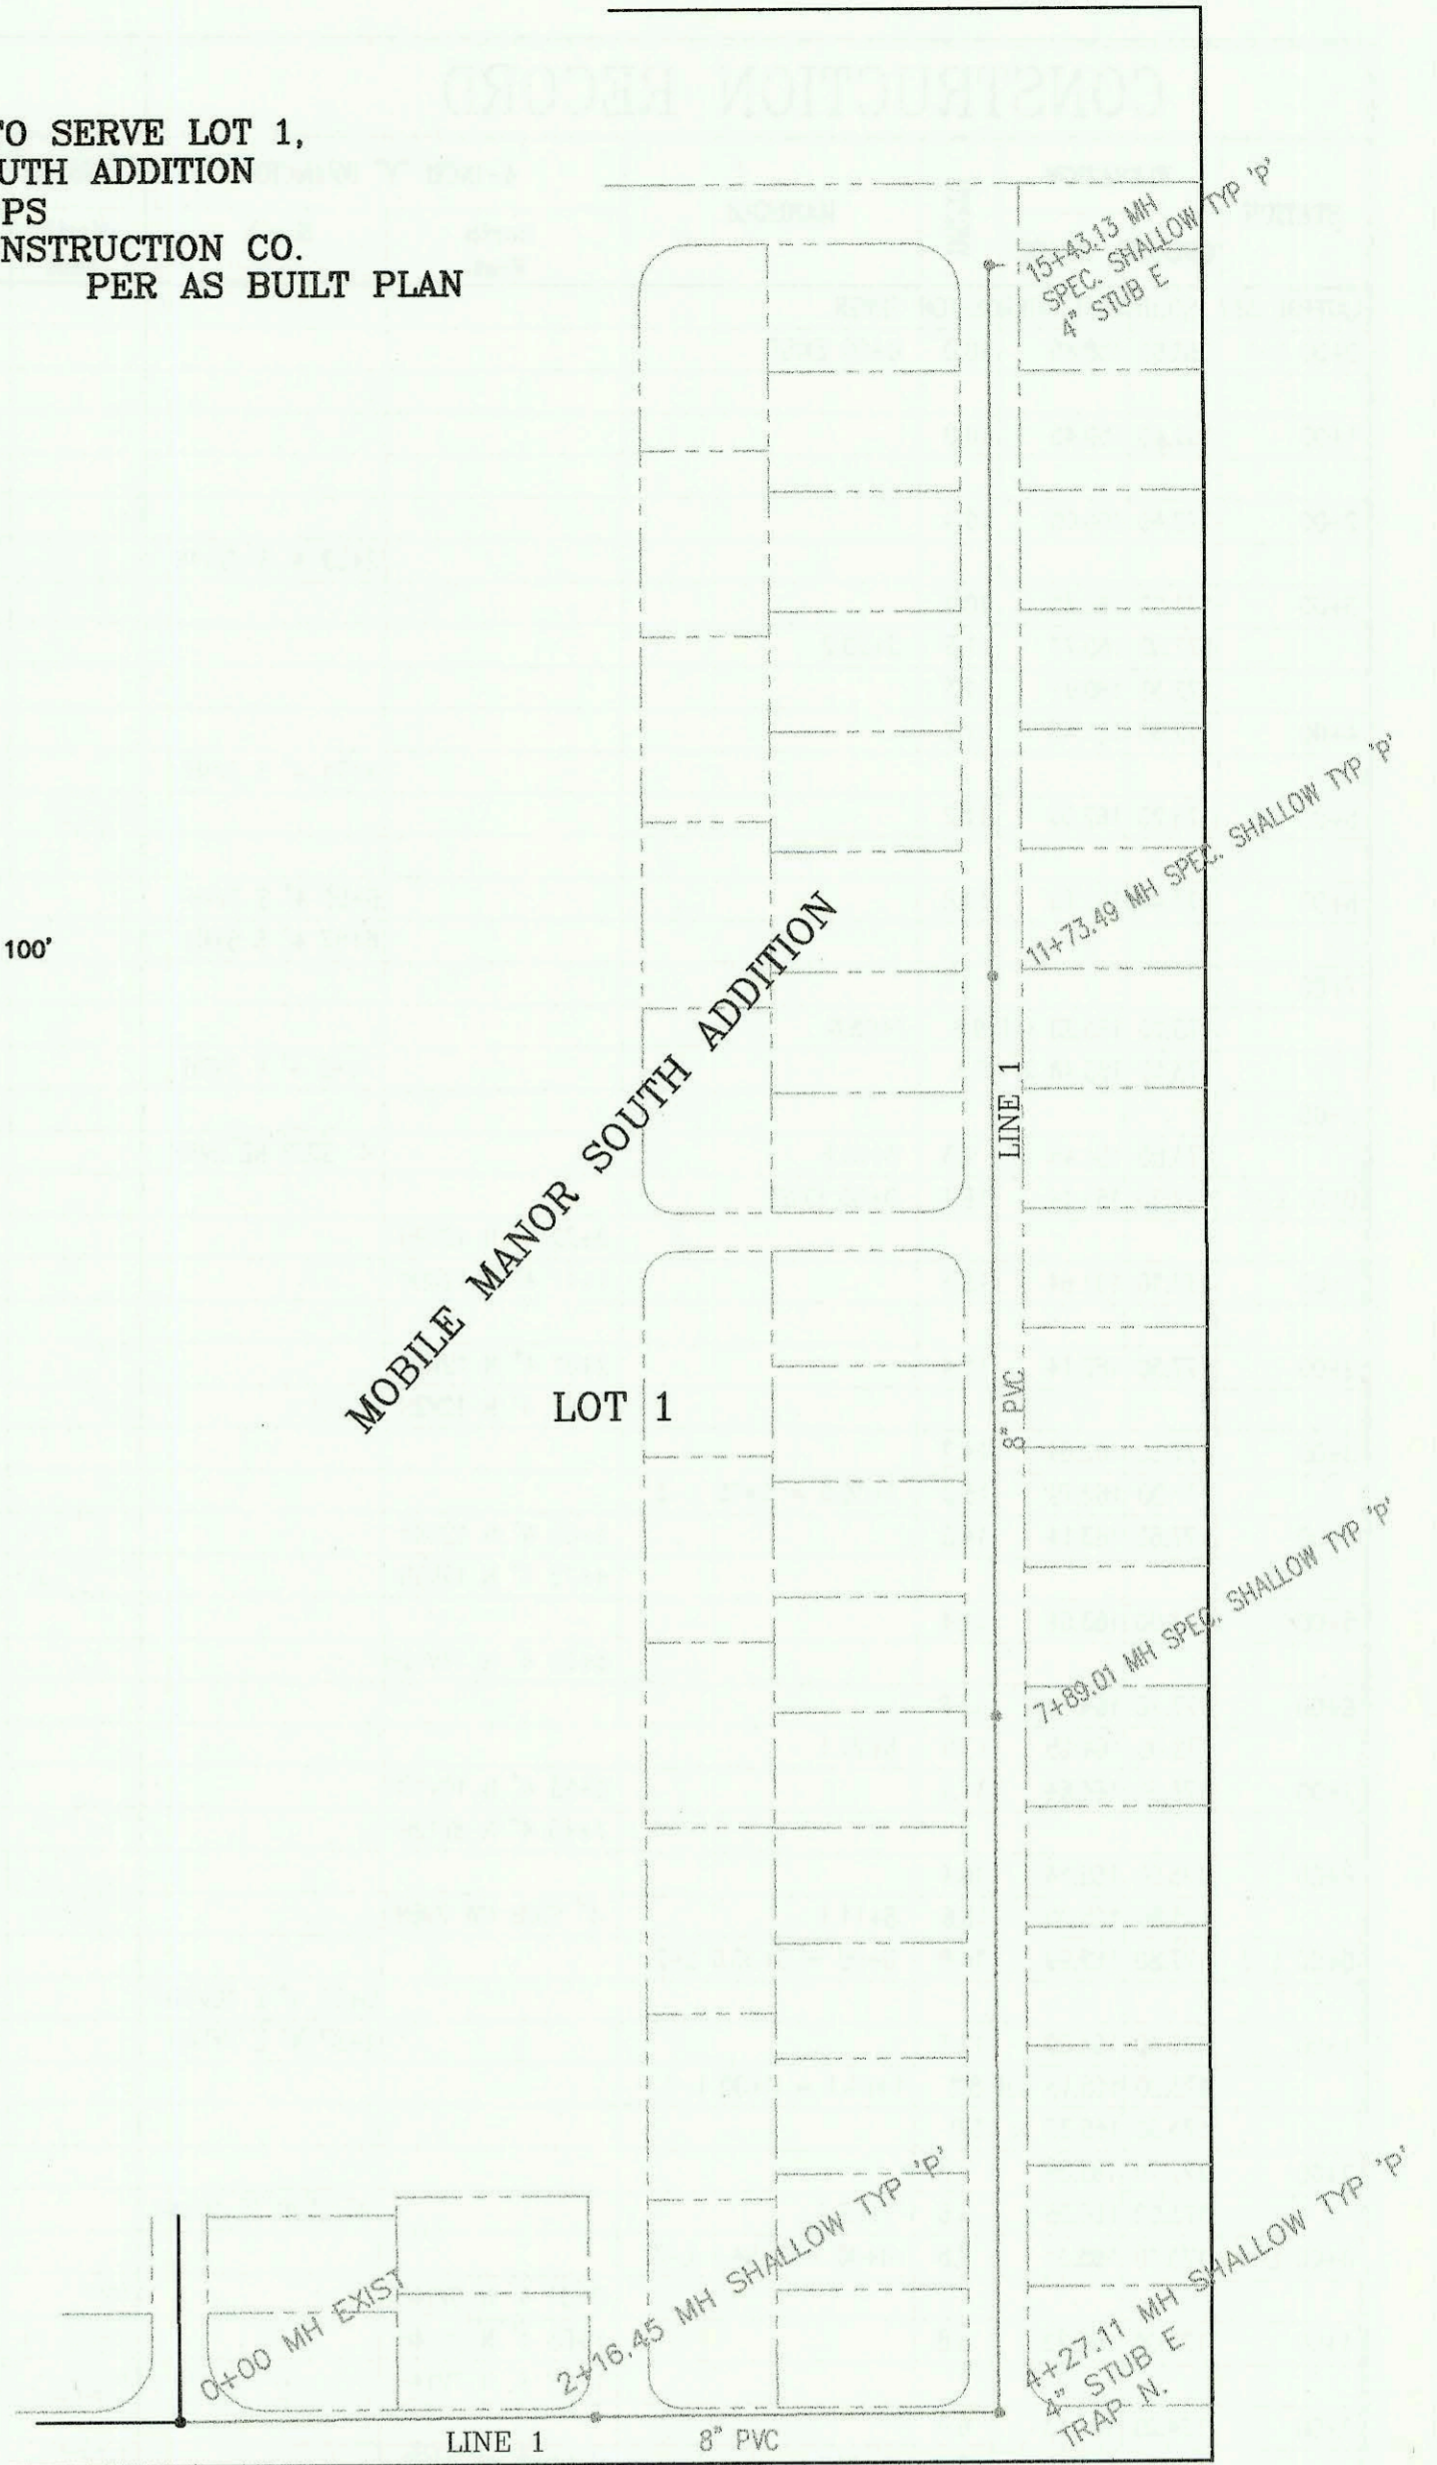

SCALE: 1" = 100'

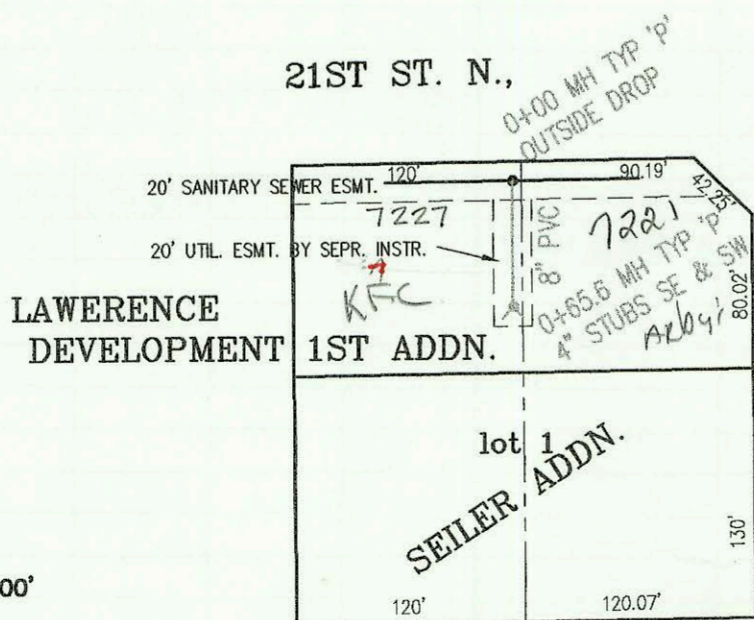

SANITARY SEWER TO SERVE ARBY'S RESTAURANT
AT 21ST ST. N. AND RIDGE ROAD
PROJECT NO. 942PPS
BUILT BY McCULLOUGH EXCAVATION INC.
BOOKED 4/18/00 PER AS BUILT PLAN

