


LATERAL 438, SOUTHWEST INTERCEPTOR SEWER
 PROJECT NO. 468-83030 (743815)
 BUILT BY MIES CONSTRUCTION CO.
 BOOKED 5/26/00 PER AS BUILT PLAN



SCALE: 1" = 100'

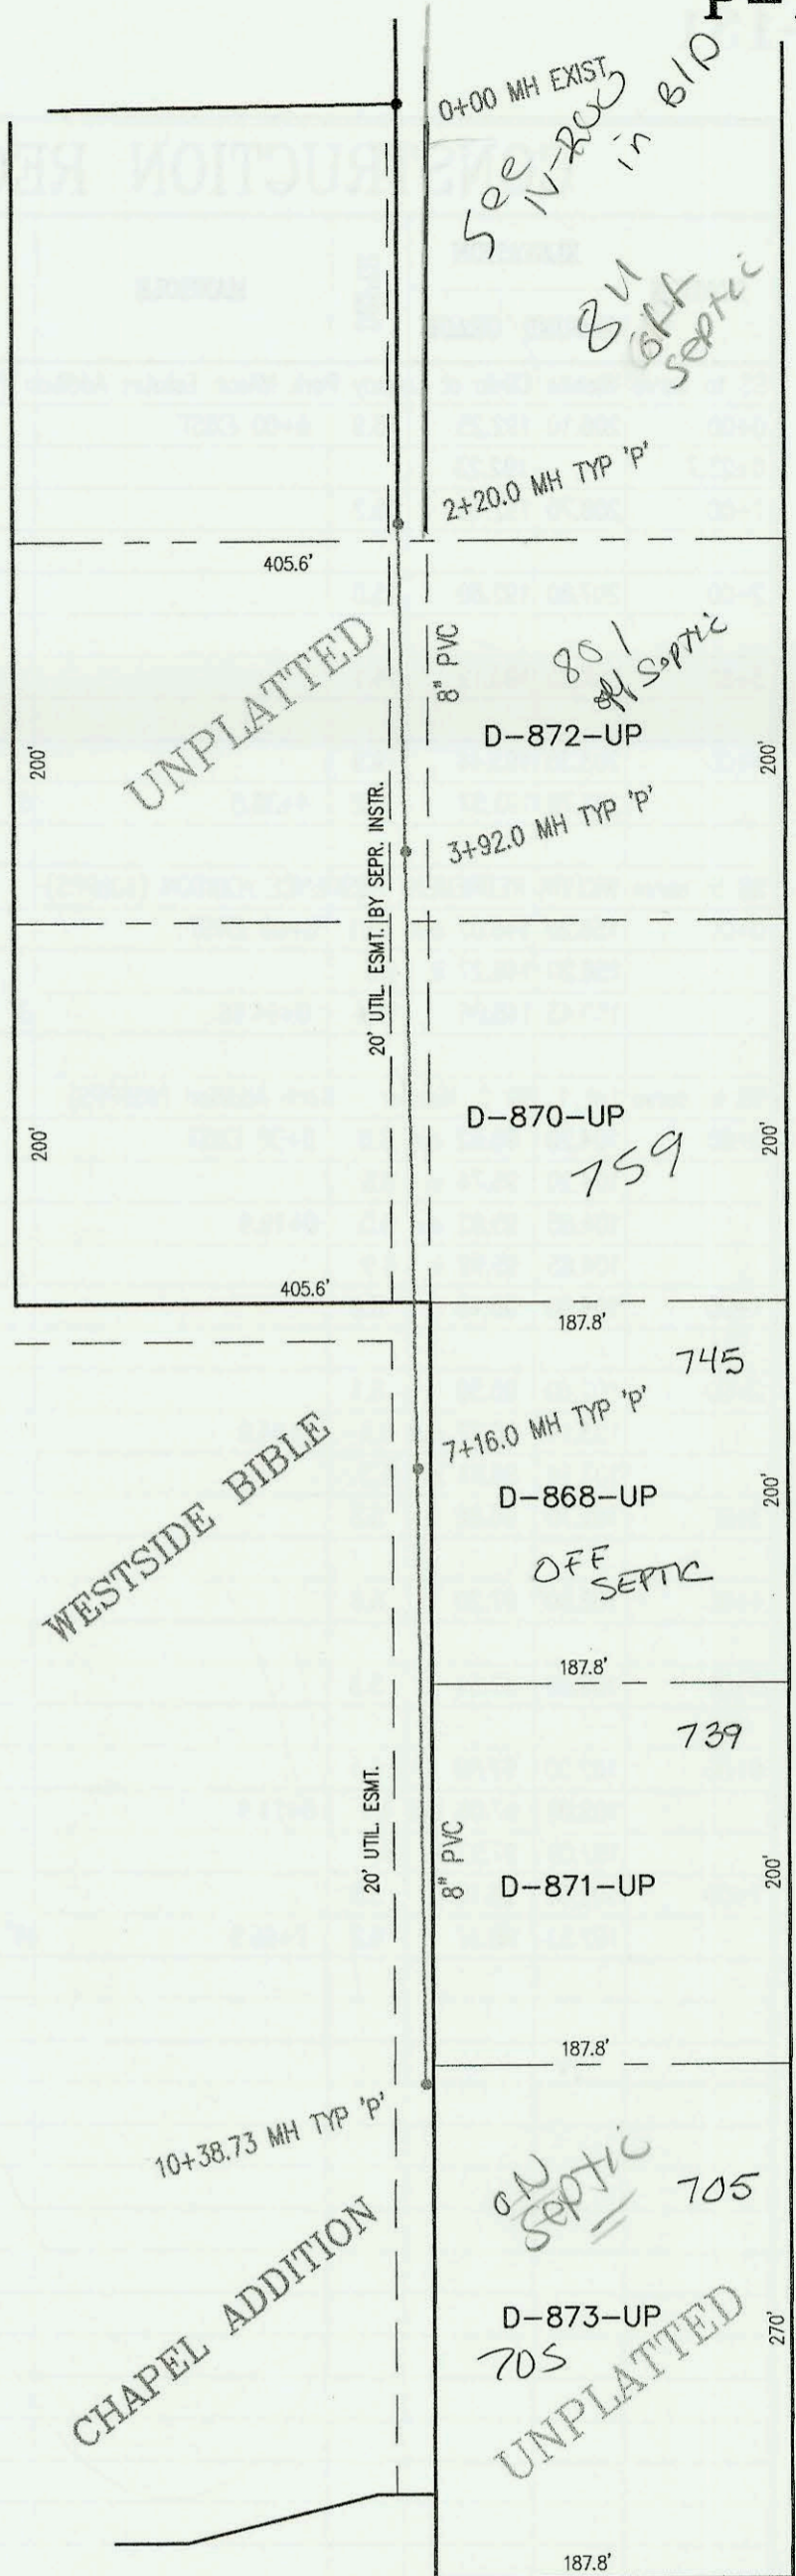


119TH STREET WEST



SCALE: 1" = 100'

PRIV. SANITARY SEWER TO SERVE LOT 1, BLK 1,
 WILLOWOOD ESTATES (PHASE 4)
 PROJECT NO. 906PPS
 BUILT BY A-PLUS PLUMBING
 BOOKED 6/30/00 PER AS BUILT PLAN

CENTRAL

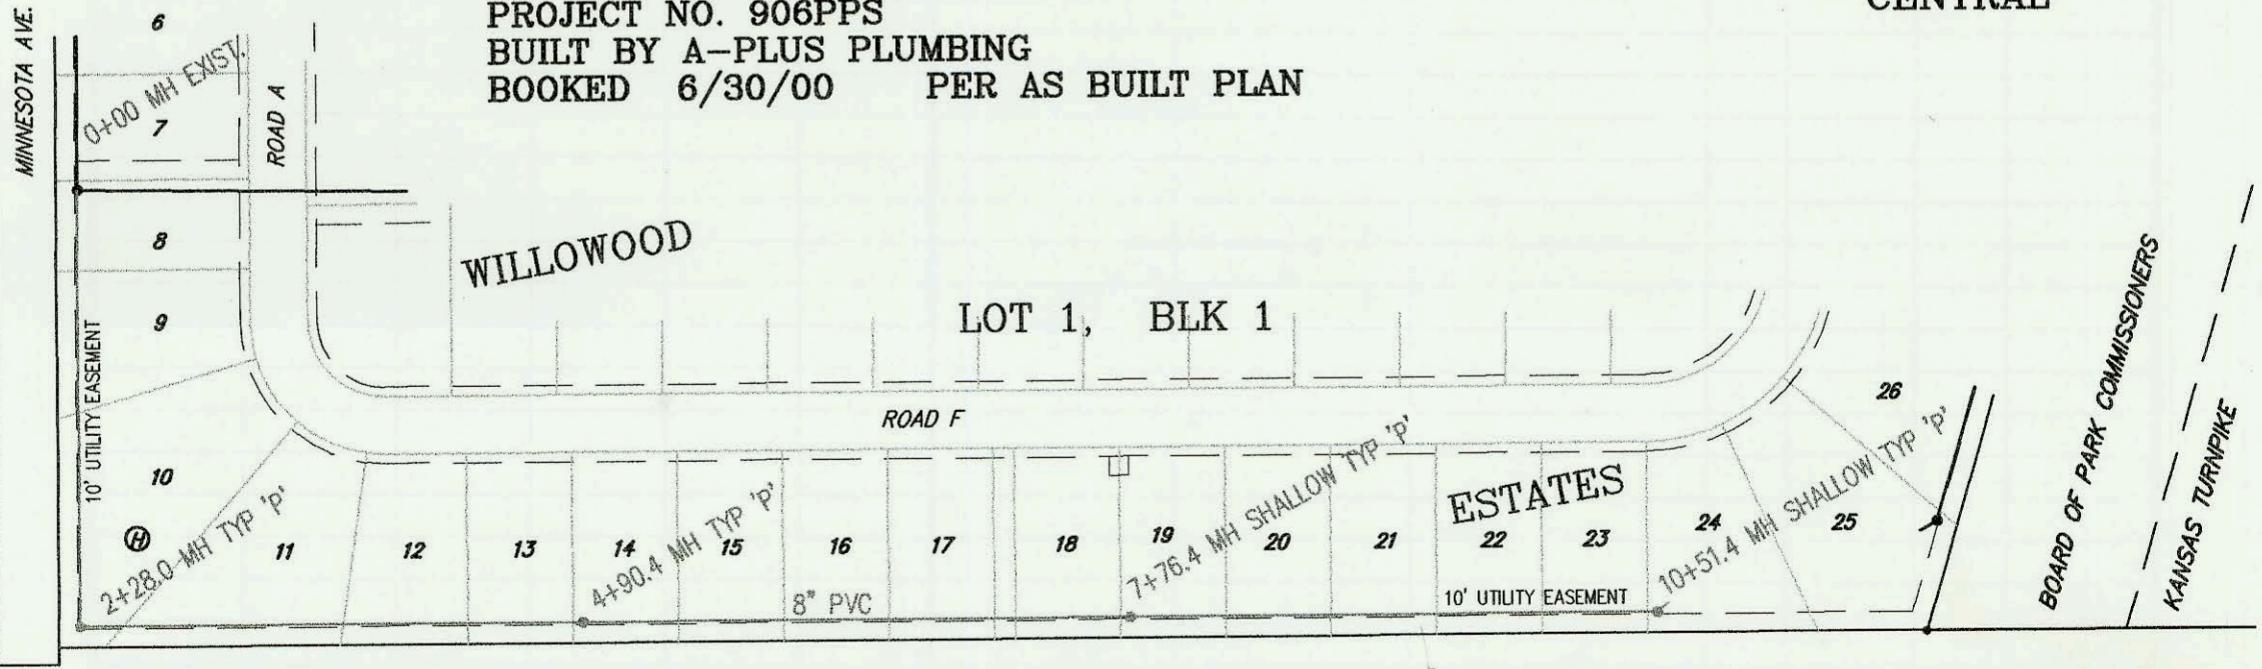

CONSTRUCTION RECORD					SERVICE RECORD							
STATION	ELEVATION		DEPTH	MANHOLE	4-INCH "Y" BRANCHES		No. of Permit		House Number		DATE OF PERMITS	
	GROUND	GRADE			North West	South East	North West	South East	North West	South East	North West	South East
LATERAL 438, SOUTHWEST INTERCEPTOR SEWER												
0+00	158.50	146.71	11.8	0+00 EXIST								
	158.10	147.37 out	10.7	2+20.0								
	158.10	147.47 in	10.6				26th 500th		281 19th		1-8-02	
3+00	157.70	147.71	10.0									
	156.90	147.99	8.9	3+92.0								
4+00	156.30	148.01	8.3									
5+00	156.90	148.31	8.6									
6+00	156.70	148.61	8.1		4" SCH 40 4+98.0		2000 01435		759 N 119th St W		6-16-00	
7+00	156.30	148.91	7.4		4" SCH 40 6+87 Saddle		2001- 00350		745 N 119th W		2-20-01	
	156.70	148.96	7.7	7+16.0								
8+00	156.10	149.21	6.9									
9+00	156.50	149.51	7.0									
10+00	156.60	149.81	6.8									
	157.00	149.93	7.1	10+38.7	10+32.7 4" SCH 40		2005- 02387		705 N 119th St N		9-28-05	
SANITARY SEWER TO SERVE WILLOWOOD ESTATES PHASE 4 (906PPS)												
0+00	87.90	78.70	9.2	0+00 EXIST								
1+00	87.80	78.99	8.8									
2+00	88.20	79.28	8.9									
	88.65	79.36 out	9.3	2+28.0								
	88.65	79.44 in	9.2									
3+00	88.20	79.64	8.6									
4+00	88.00	79.92	8.1									
	88.16	80.17	8.0	4+90.4								
5+00	88.00	80.19	7.8									
6+00	87.70	80.45	7.3									
7+00	87.50	80.70	6.8									
	87.47	80.90	6.6	7+76.4								
8+00	87.30	80.99	6.3									
9+00	87.00	81.37	5.6									
10+00	86.80	81.75	5.0									
	86.84	81.95	4.9	10+51.4	4" STUB NE 82.16							