




SANITARY SEWER TO SERVE LOT 1,
BLK. 1, EXPLORATION PLACE
PROJECT NO. 746PPS
BUILT BY NOWAK CONSTRUCTION CO.
BOOKED 7/20/00 PER AS BUILT PLAN

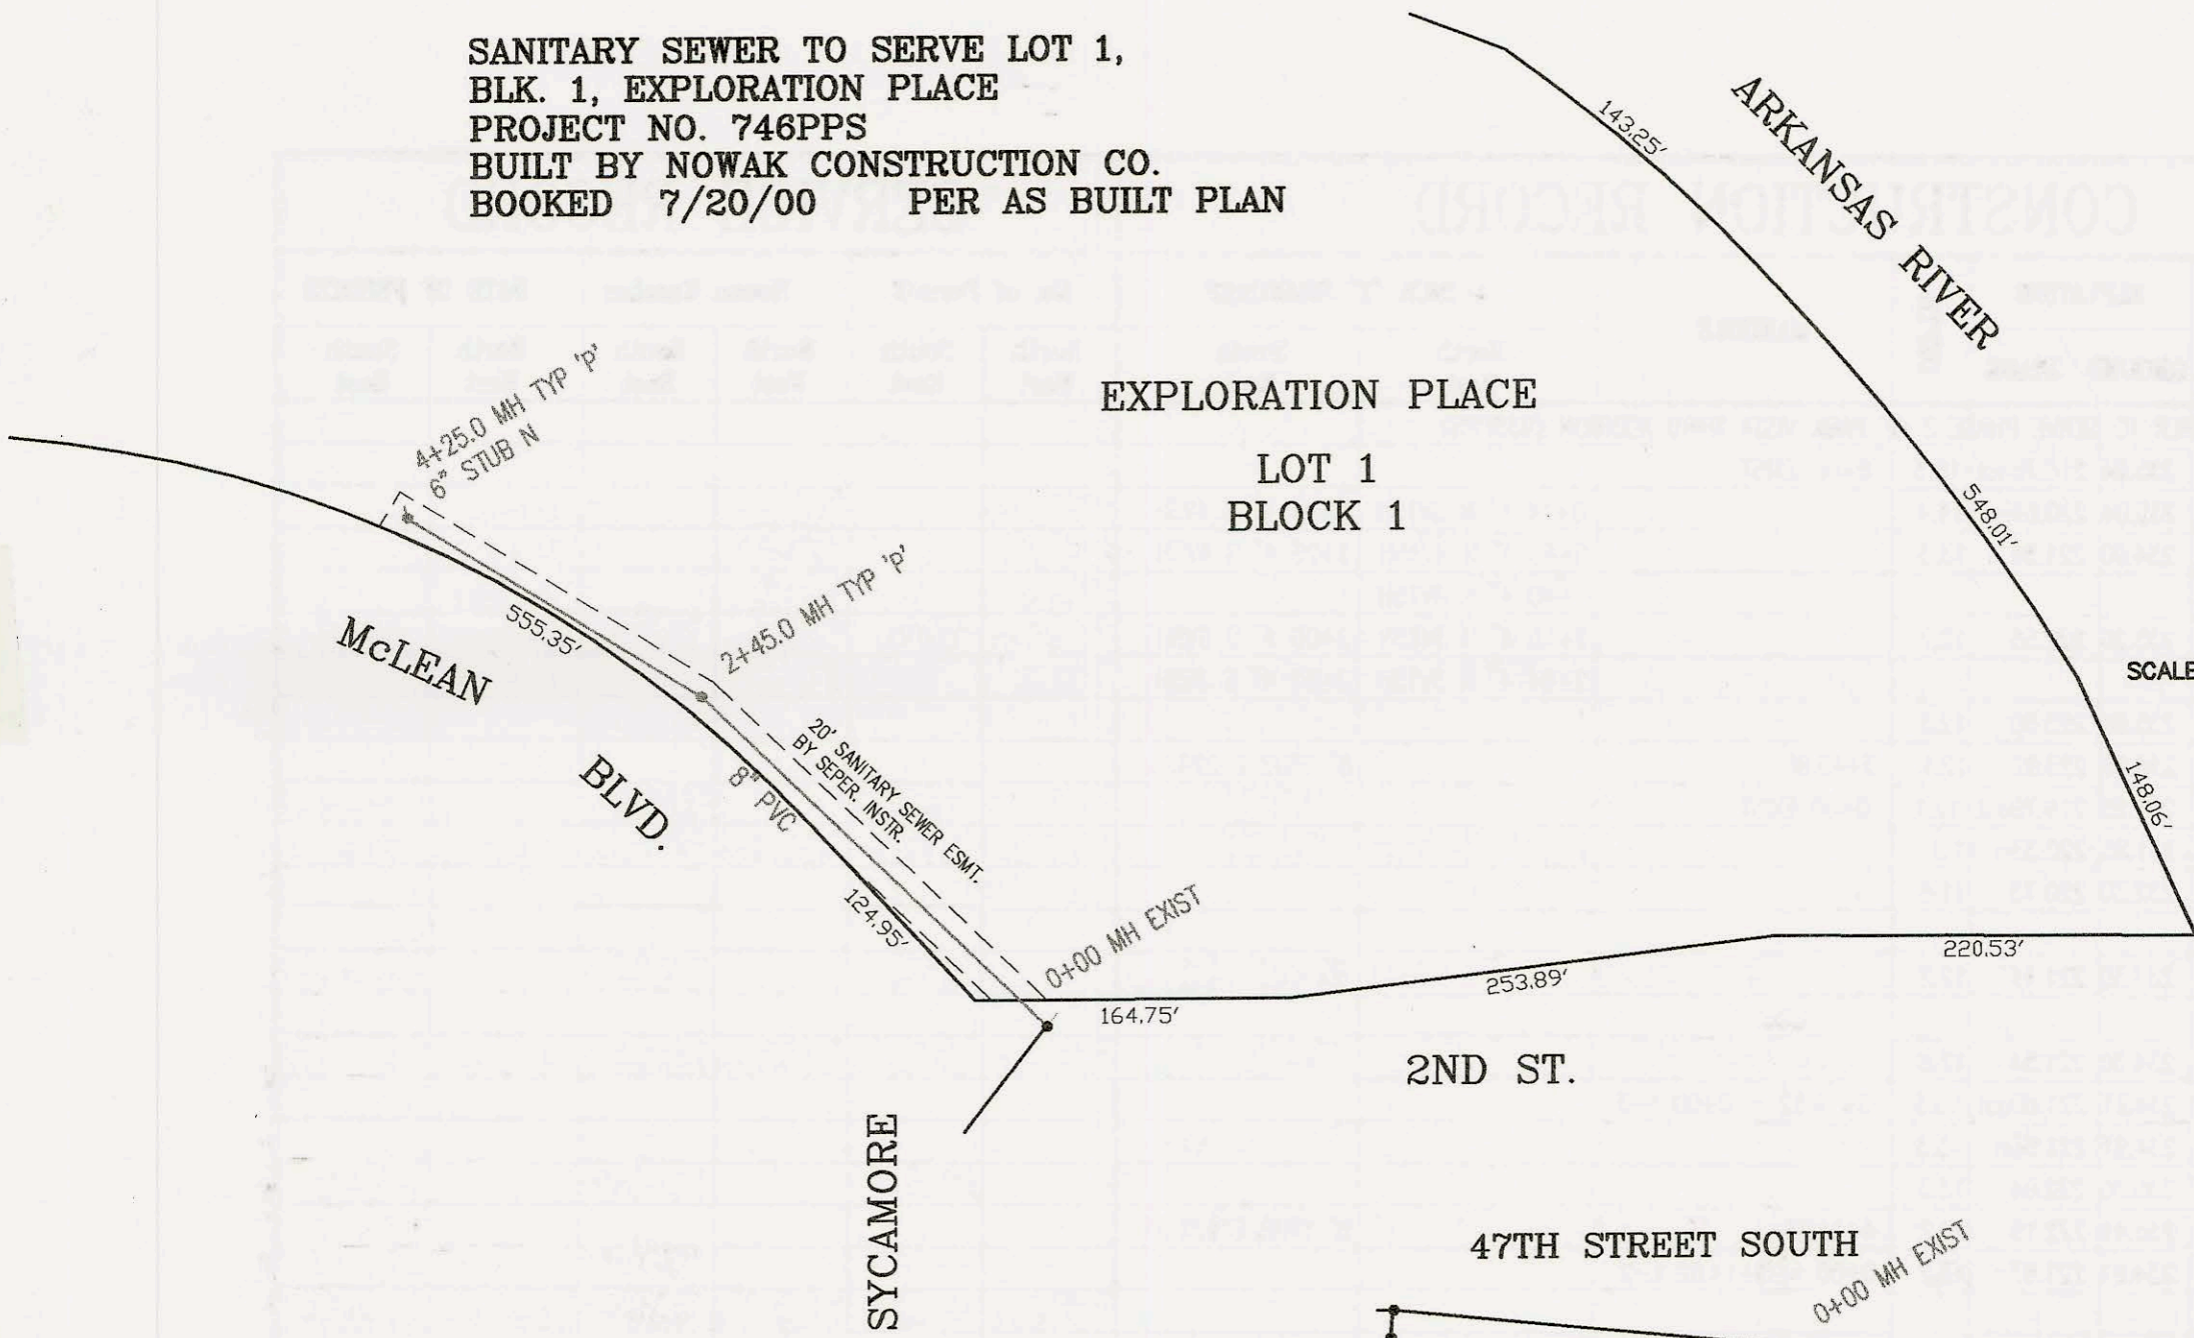

SANITARY SEWER TO SERVE
DOLLAR GENERAL STORE AT
47TH ST. SO. AND WATER
PROJECT NO. 921PPS
BUILT BY McCULLOUGH EXCAVATION
BOOKED 7/20/00 PER AS BUILT PLAN

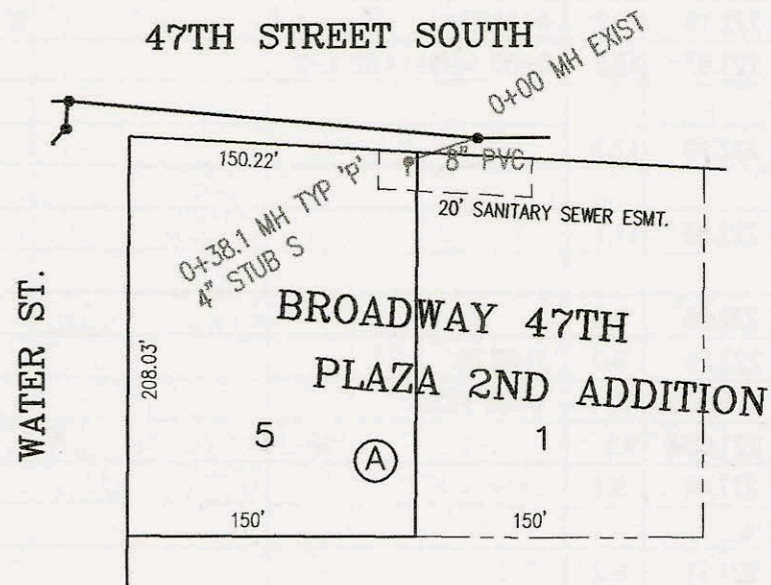


U.S. HIGHWAY 54

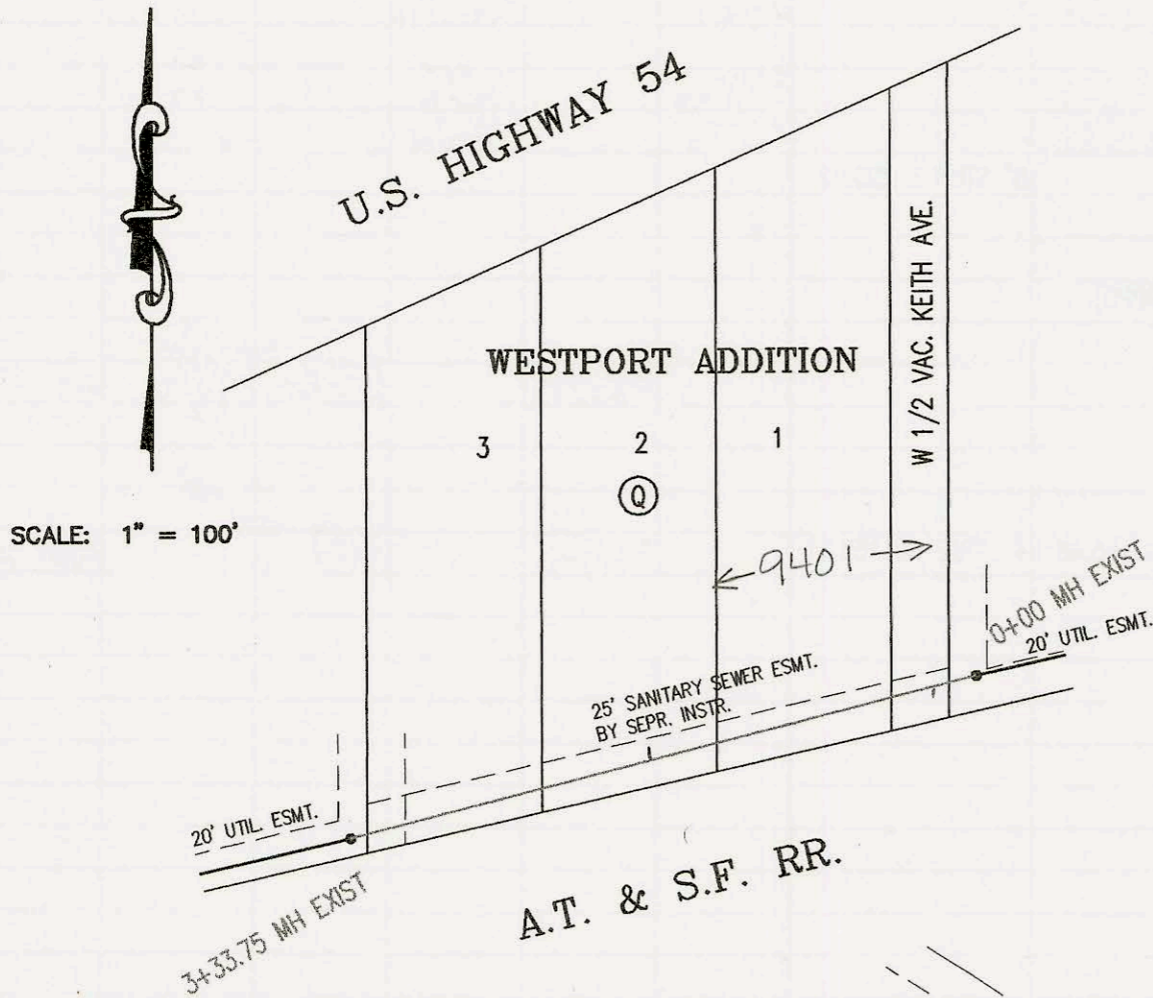

SANITARY SEWER TO SERVE
TRACTOR SUPPLY CO.
LOTS 1-3, BLK Q, WESTPORT ADDN.
PROJECT NO. 913PPS
BUILT BY WICHITA EXCAVATION
BOOKED 7/20/00 PER AS BUILT PLAN

SANITARY SEWER TO SERVE
LOTS 1, BLK 1, WOODLAWN PLACE 2ND ADDN.
PROJECT NO. 993PPS
BUILT BY W.B. CARTER CONSTRUCTION
BOOKED 7/20/00 PER AS BUILT PLAN

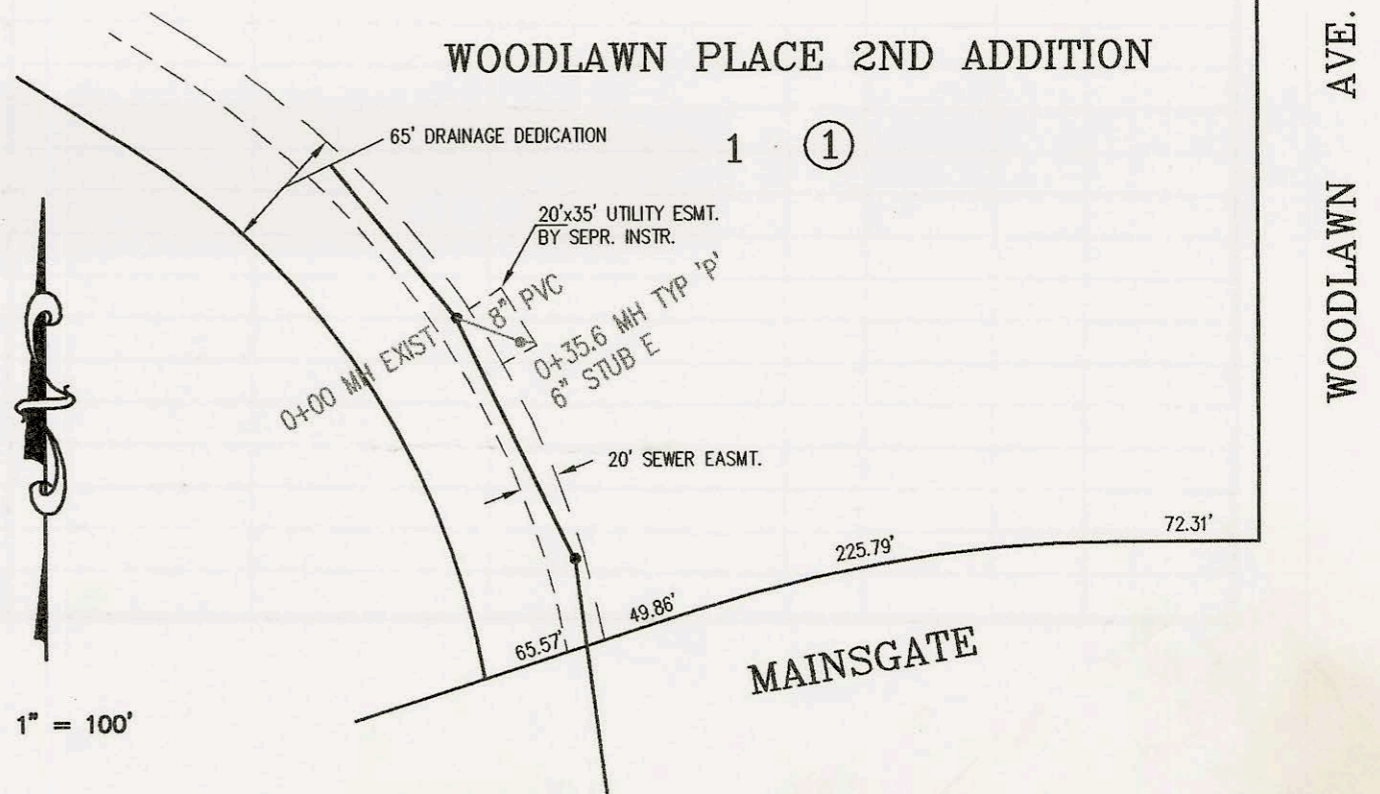

CONSTRUCTION RECORD						SERVICE RECORD						
STATION	ELEVATION		DEPTH	MANHOLE	4-INCH "Y" BRANCHES		No. of Permit		House Number		DATE OF PERMITS	
	GROUND	GRADE			North West	South East	North West	South East	North West	South East	North West	South East
SANITARY SEWER TO SERVE LOT 1, BLK 1, EXPLORATION PLACE (746PPS)												
0+00	113.91	104.14 out	9.8	0+00 EXIST								
	113.91	104.32 in	9.6									
1+00	114.70	104.74	10.0									
2+00	114.00	105.17	8.8									
	114.63	105.36 out	9.3	2+45.0								
	114.63	105.48 in	9.1									
3+00	114.00	105.69	8.3									
4+00	113.70	106.07	7.6									
	114.32	106.16	8.2	4+25.0	6" STUB N 106.68							
SANITARY SEWER TO SERVE DOLLAR GENERAL STORE AT 47TH ST. S. & WATER (921PPS)												
0+00	85.23	73.29 out	11.9	0+00 EXIST								
	85.23	78.98 in	6.3	OUTSIDE DROP								
	86.00	80.27	5.7	0+38.1	4" STUB S 80.60							
SANITARY SEWER TO SERVE TRACTOR SUPPLY CO., LOTS 1-3, BLK Q, WESTPORT ADDN. (913PPS)												
0+00	136.40	123.55 out	12.9	0+00 EXIST	0+31		1999-01080	9401 W Kellogg	TRACTOR SUPPLY East Sewer	11-4-99		
	136.40	123.68 in	12.7									
1+00	134.80	124.28	10.5									
2+00	134.40	124.88	9.5		1+72.75		1999-01082	9401 W Kellogg	TRACTOR SUPPLY West Sewer	11-5-00		
3+00	134.00	125.48	8.5									
	135.28	125.61	9.7	3+33.75 EXIST								
SANITARY SEWER TO SERVE LOT 1, BLK 1, WOODLAWN PLACE 2ND ADDITION (993PPS)												
0+00	179.80	167.34 out	12.5	0+00 EXIST								
	179.80	169.52 in	10.3									
	183.33	170.20	13.1	0+35.6	6" STUB E 172.20							