

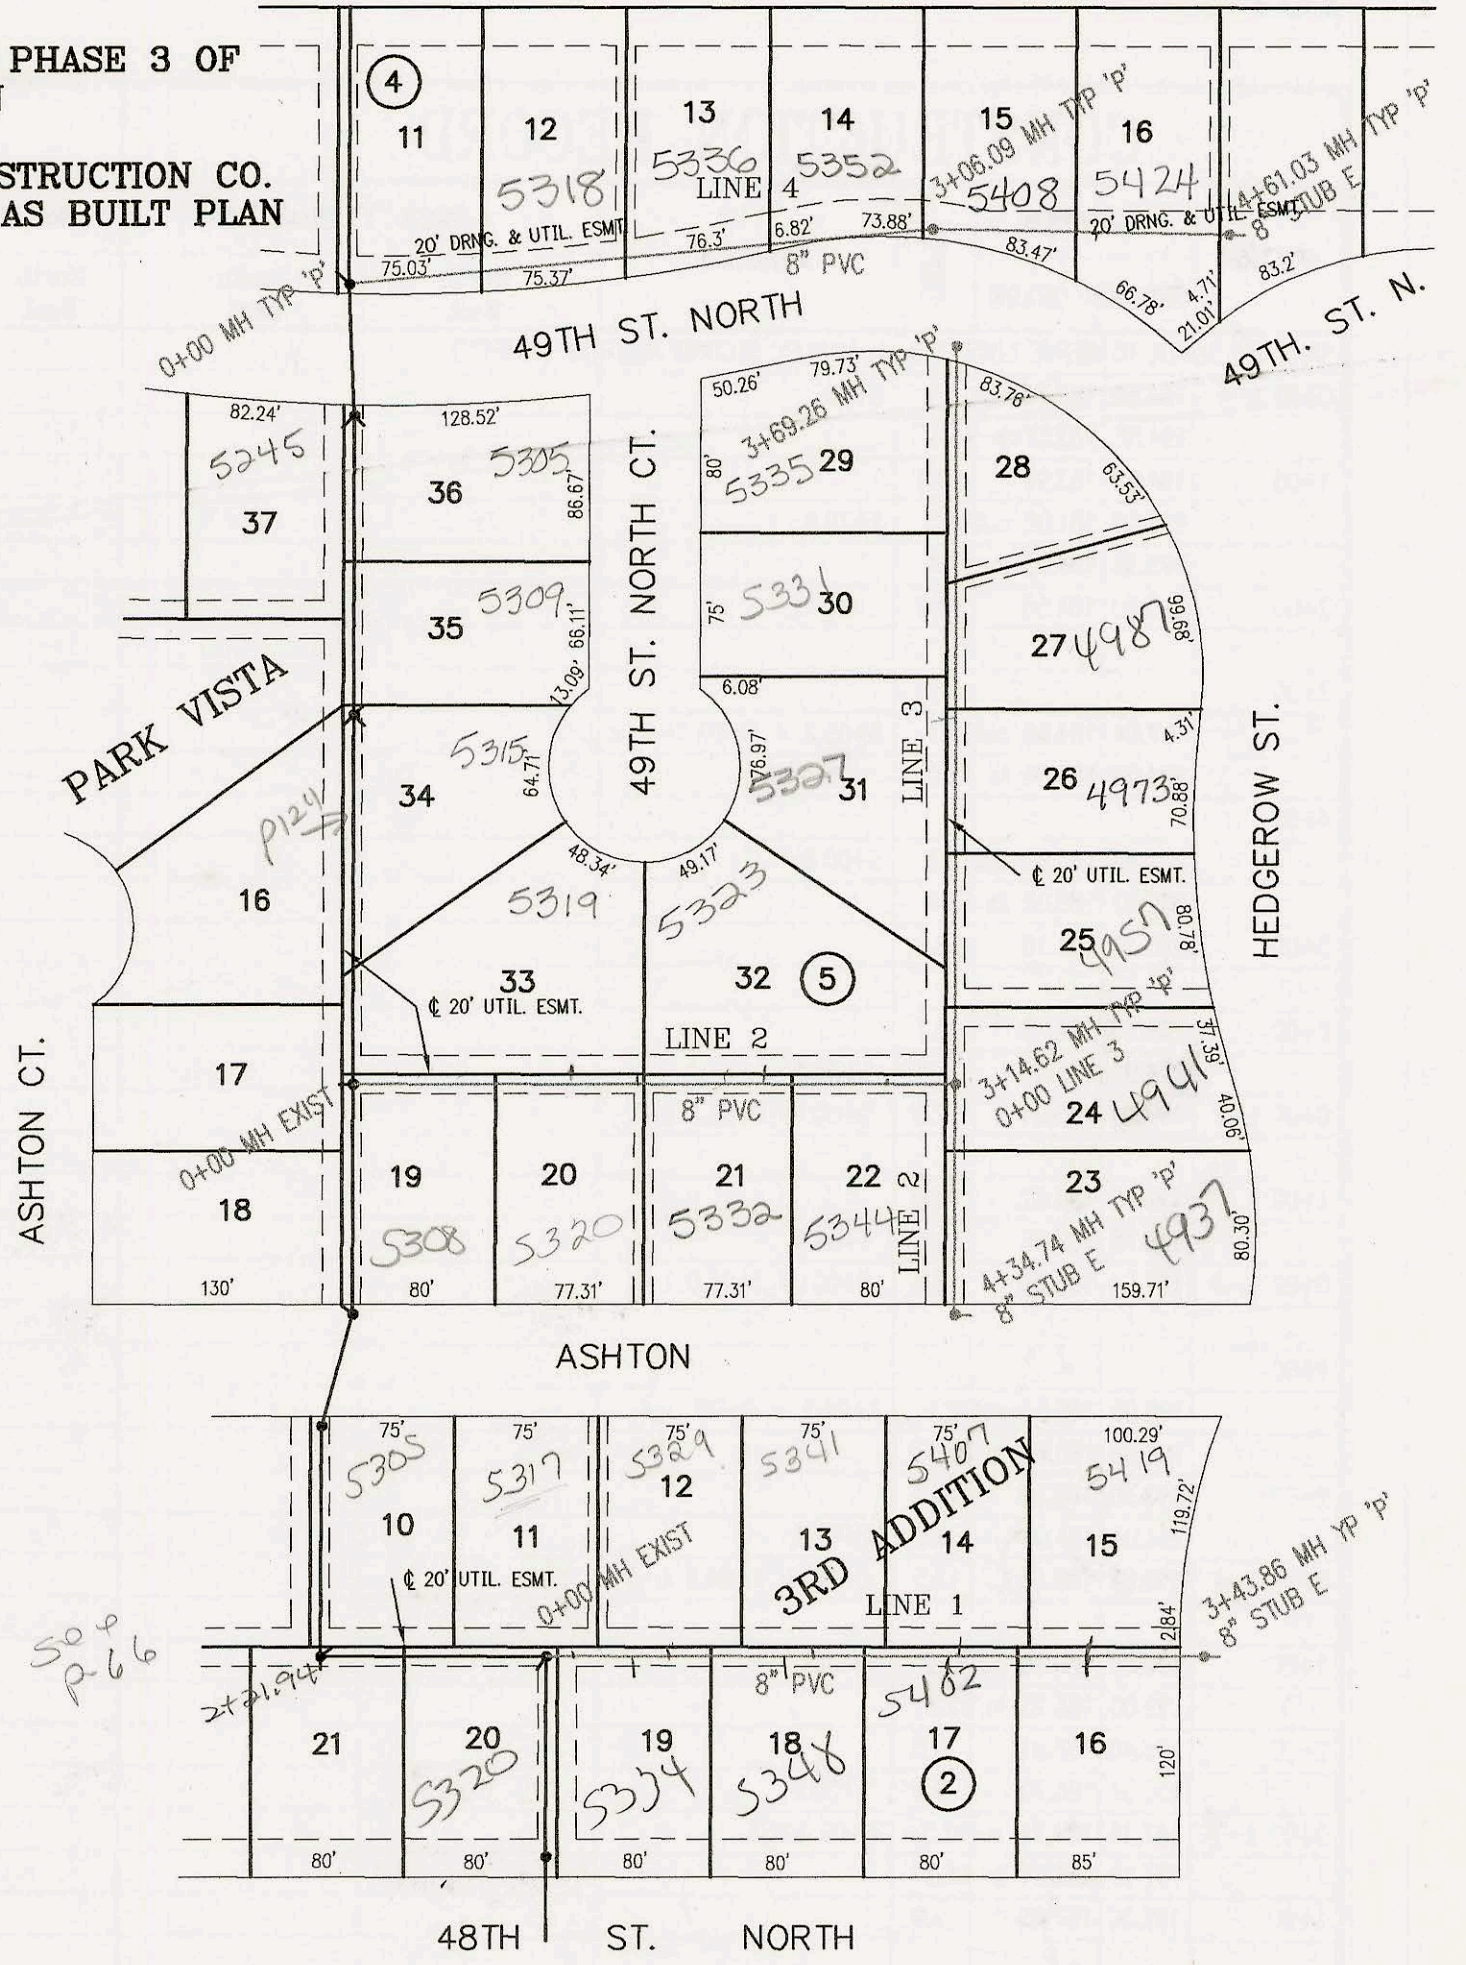


SANITARY SEWER TO SERVE PHASE 3 OF  
PARK VISTA THIRD ADDITION  
PROJECT NO. 935PPS  
BUILT BY W.B. CARTER CONSTRUCTION CO.  
BOOKED 7/21/00 PER AS BUILT PLAN

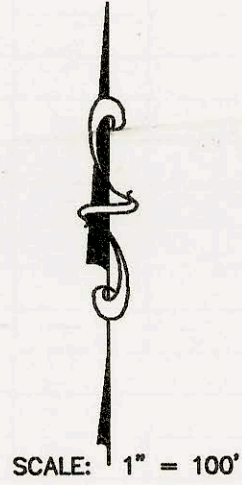

SANITARY SEWER TO SERVE LOT 1, BLK A,  
L. R. JONES THIRD ADDITION  
PROJECT NO. 969PPS  
BUILT BY McCULLOUGH EXCAVATION  
BOOKED 8/17/00 PER AS BUILT PLAN

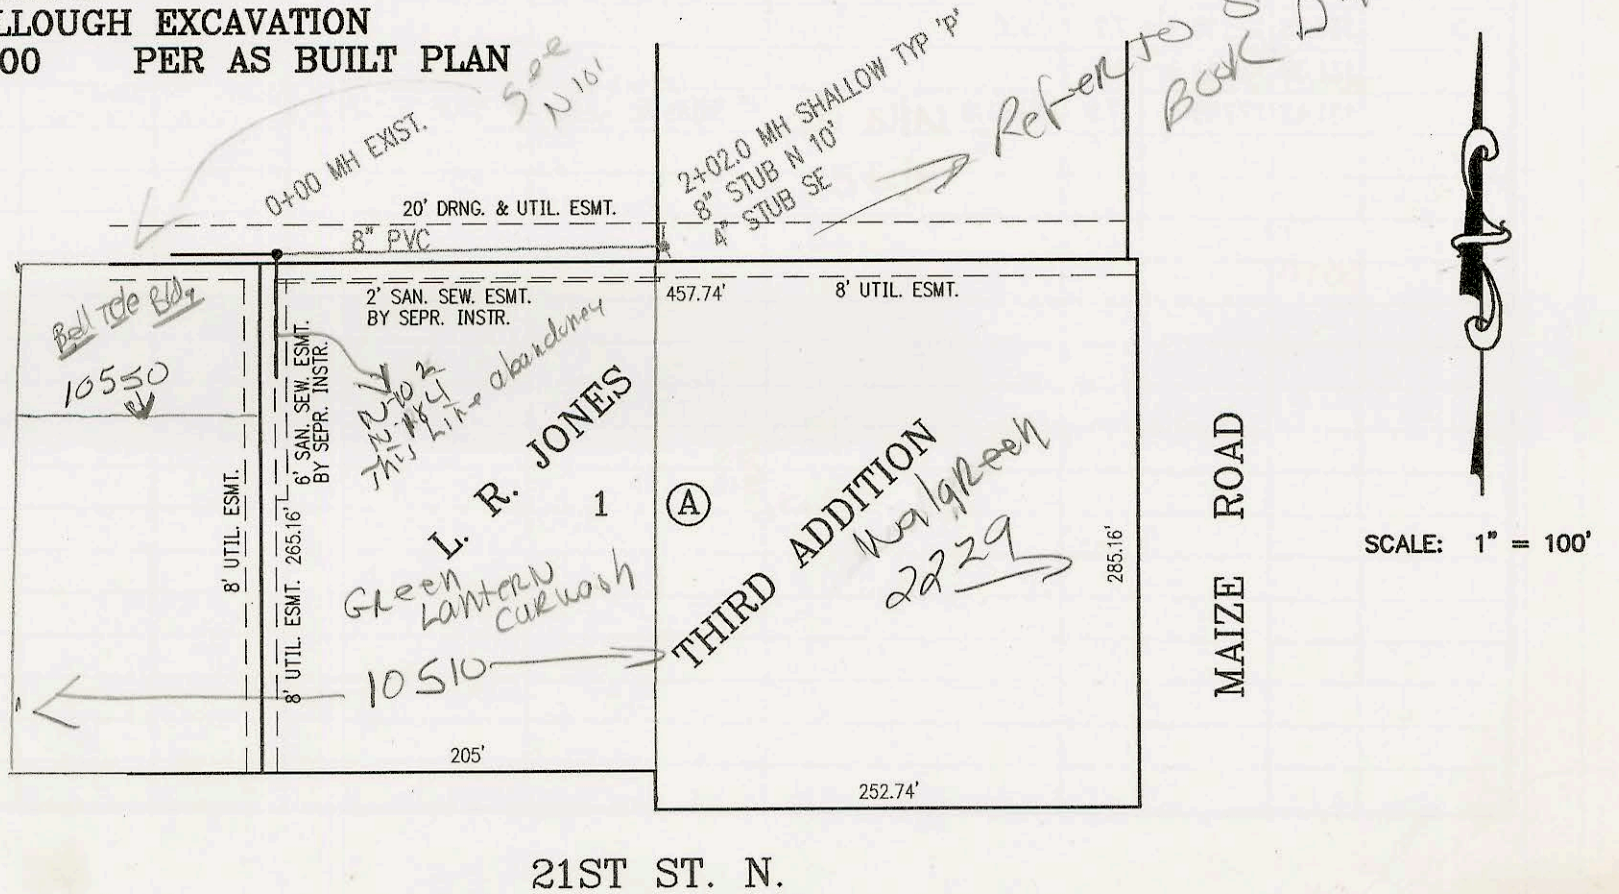

SCALE: 1" = 100'

21ST ST. N.

CONSTRUCTION RECORD						SERVICE RECORD						
STATION	ELEVATION		DEPTH	MANHOLE	4-INCH "Y" BRANCHES		No. of Permit		House Number		DATE OF PERMITS	
	GROUND	GRADE			North West	South East	North West	South East	North West	South East	North West	South East
SANITARY SEWER TO SERVE PHASE 3 OF PARK VISTA THIRD ADDITION (935PPS)												
0+00 L-1	235.04	218.76out	16.3	0+00 EXIST								
	235.04	220.64in	14.4		0+14 4" N 5V15H	0+46 4" S 4V5H	2001-00239		5317 Ashton			2-1-01
1+00	234.90	221.59	13.3		0+65 4" N 4V15H	1+26 4" S 4V5H	2000-01648		5341 Ashton			7-18-00
					1+40 4" N 4V15H		2001-01406		5341 E Ashton			6-7-01
2+00	235.20	222.55	12.7		2+15 4" N 3V15H	2+06 4" S 3V5H	2001-02037	2002-03159	5407 E Ashton	5402 E 48th		8-15-01 3-19-02
					2+84 4" N 3V15H	2+81 4" S 3V5H	2001-02036		5407 E Ashton			8-15-01
3+00	235.80	223.50	12.3									
	236.06	223.92	12.1	3+43.86		8" STUB E 224.12						
0+00 L-2	231.85	219.79out	12.1	0+00 EXIST	4" SCH 40 0+16		2000-01565		5308 E Ashton			7-6-00
	231.85	220.33in	11.5		4" SCH 40 Predco Hill Saddle	4" SCH 40 0+99	2001-01650	2000-01765	5319 E 49th CTN	5320 E Ashton		7-6-01 8-2-00
1+00	232.30	220.73	11.6									
2+00	233.30	221.14	12.2		4" SCH 40 PVC 2+14.62 Saddle		2001-01014		5332 E Ashton			4-27-01
3+00	234.30	221.54	12.8		4" SCH 40 PVC 2+80.62 Saddle		2000-02025	2001-01407	5323 E 49th CTN	5344 E Ashton		9-13-00 6-7-01
	234.91	221.60out	13.3	3+14.62 = 0+00 L-3								
	234.91	221.66in	13.3									
4+00	235.30	222.04	13.3					2002-00000		4937 Hedgerow		1-28-02
	235.41	222.19	13.2	4+34.74		8" STUB E 222.31						
0+00 L-3	234.91	221.67	13.2	0+00 = 3+14.62 L-2				2002-00637	4973 N Hedgerow	4957 Hedgerow		3-11-02 9-26-02
1+00	234.40	222.10	12.3		4" SCH 40 1+89		2001-00525		5307 49th			1-5-01
2+00	233.60	222.53	11.1		4" SCH 40 2+40.46		2000-01564	2002-02056	5331 E 49th CTN	4937 Hedgerow		7-6-00 9-30-02
3+00	232.60	222.96	9.6		4" SCH 40 PVC 3+22.26 Saddle		2001-01632		5335 E 49th CTN			7-6-01
	232.27	223.26	9.0	3+69.26								
0+00 L-4	230.57	220.50out	10.1	0+00 EXIST	4" SCH 40 0+91		2000-00849		5318 E 49th STN			4-6-00
	230.57	221.05in	9.5									
1+00	230.60	221.48	9.1		4" SCH 40 PVC 1+65.09 Saddle		2001-00623		5326 E 49th STN			3-21-01
2+00	231.10	221.91	9.2									
3+00					4" SCH 40 PVC 2+41.09 Saddle		2001-00901		5352 E 49th STN			4-16-01
	232.32	222.37out	10.0	3+06.09								
	232.32	222.42in	9.9		4" SCH 40 PVC 3+68.09 Saddle		2001-00143		5408 E 49th N			1-23-01
4+00	232.60	222.80	9.8		4" SCH 40 PVC 3+93.03 Saddle		2001-01405		5424 E 49th N			6-7-01
	233.30	223.05	10.3	4+61.03		8" STUB E 223.12						
SANITARY SEWER TO SERVE LOT 1, BLK A, L.R. JONES THIRD ADDITION (969PPS)												
0+00	162.90	154.07 out	8.8	0+00 EXIST								
	162.90	154.57 in	8.3					2002-02381	10310 Sloop Walk	10310 Sloop Walk		9-11-03
1+00	162.00	155.01	7.0									
2+00	162.61	155.45	7.2	2+02.0	8" STUB N 155.48	4" STUB SE 155.51	2002-01241		2229 Walgreens			5/23/00