
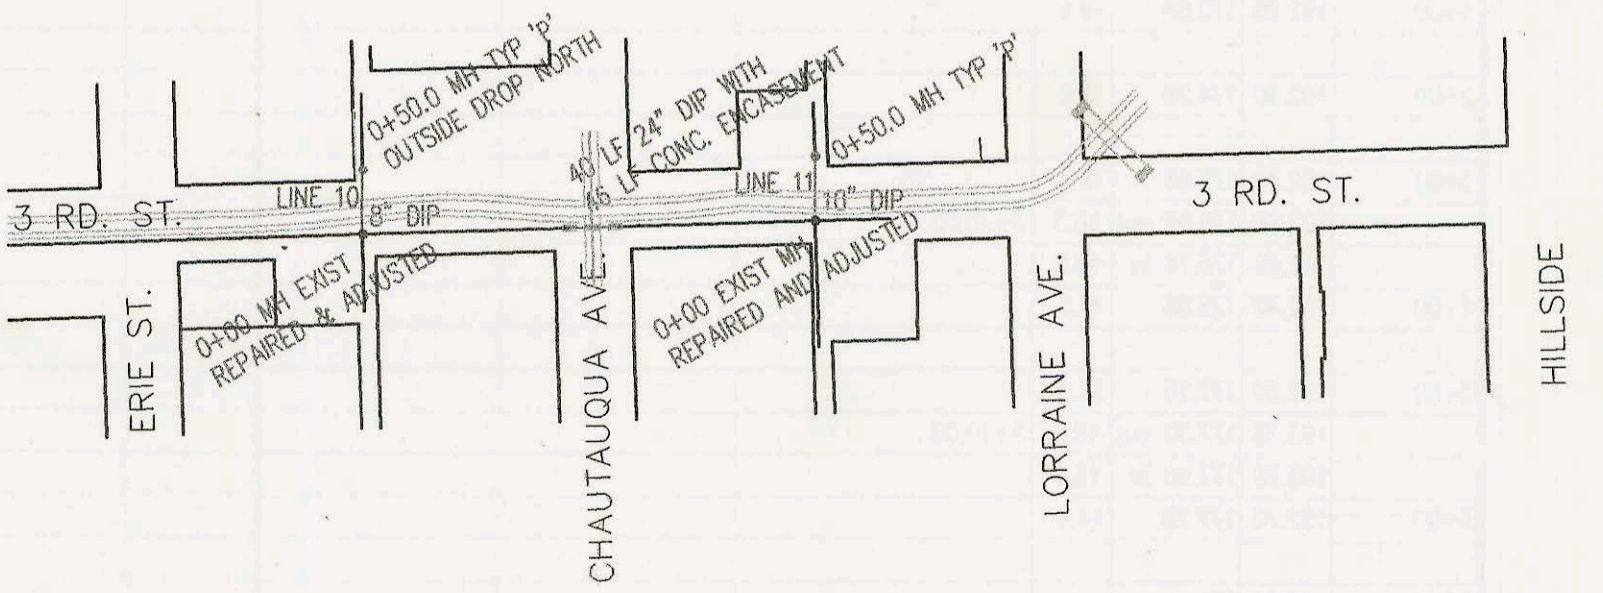


SCALE: 1" = 150'

**3RD STREET DRAINAGE IMPROVEMENTS -
SANITARY SEWER RELOCATIONS**
PROJECT NO. 468-82520 (660563)
BUILT BY CORNEJO & SONS
8/1/00 PER PLAN

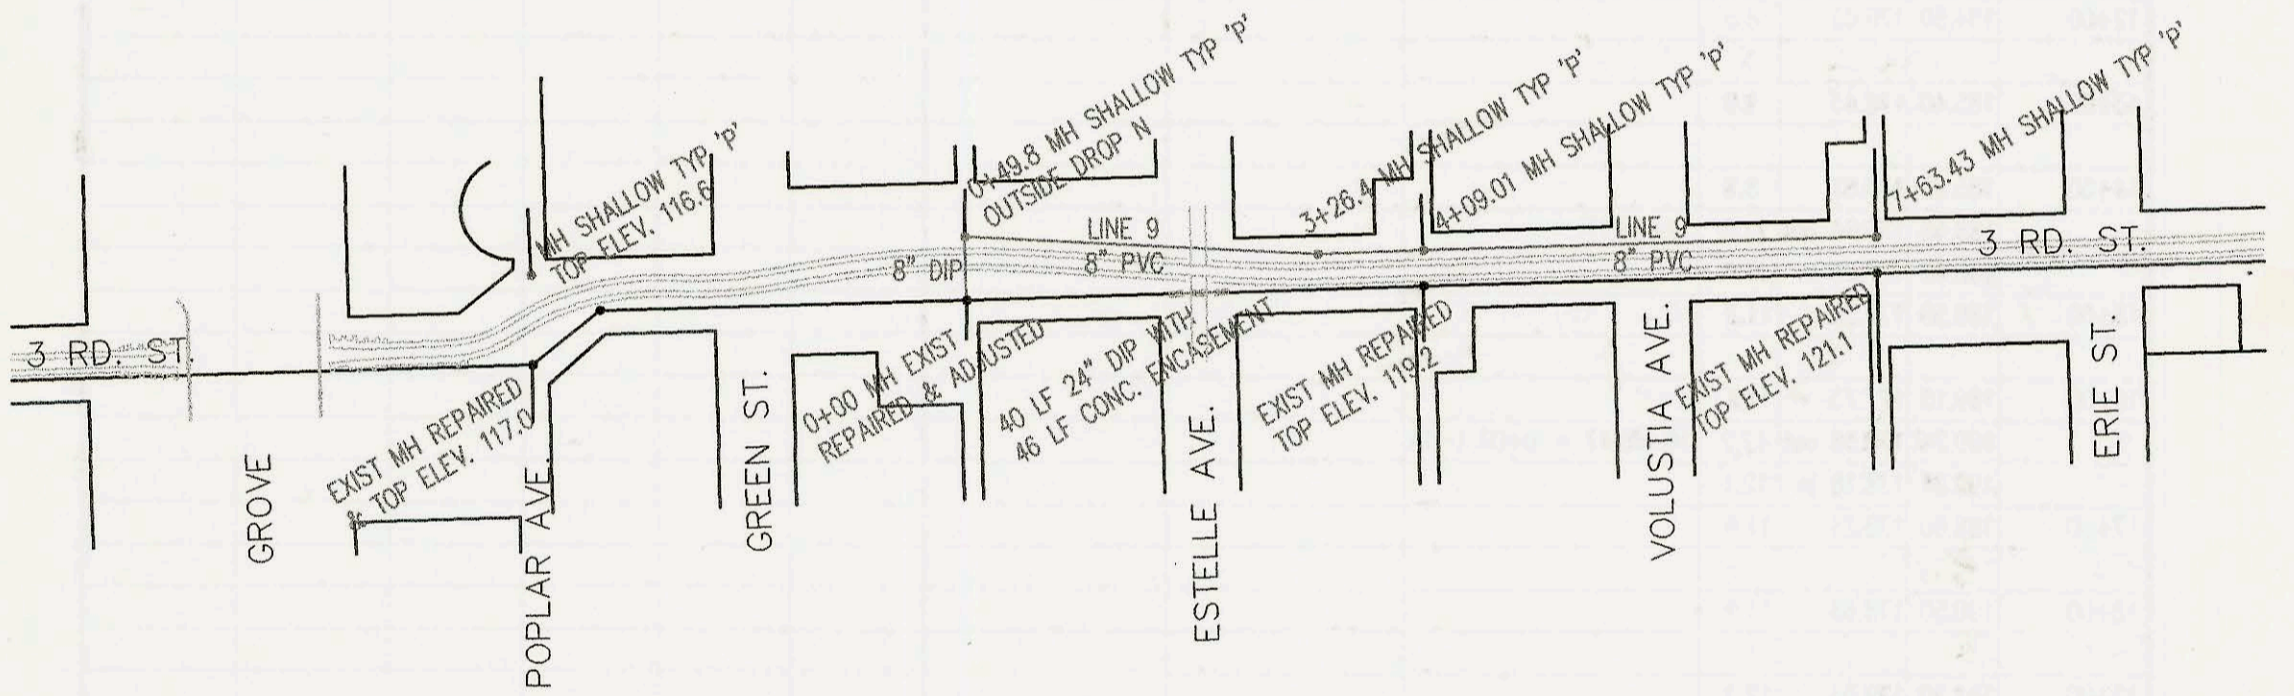

CONSTRUCTION RECORD						SERVICE RECORD						
STATION	ELEVATION		DEPTH	MANHOLE	4-INCH "Y" BRANCHES		No. of Permit		House Number		DATE OF PERMITS	
	GROUND	GRADE			North West	South East	North West	South East	North West	South East	North West	South East
3RD ST. DRAINAGE IMPROVEMENTS - SANITARY SEWER RELOCATIONS												
0+00 L-2	108.20	99.90 out	8.3	0+00 EXIST								
	108.20	100.60 in	7.6									
	108.10	100.76 out	7.3	0+38.4 OUTSIDE DROP								
	108.10	100.96 in	7.1	106.13 IN N, 106.43 IN W								
0+00 L-3	106.30	102.34 out	4.0	0+00								
		100.23 out		30" W								
	106.30	102.34 in	4.0	100.73 IN E								
	110.50	102.39	8.1	0+45.0								
0+00 L-4	111.40	101.01	10.4	0+00								
1+00	105.60	101.04	4.6									
2+00	110.60	101.06	9.5									
	111.50	101.07	10.4	2+25.8								
0+00 L-5	110.30	101.70 out	8.6	0+00 EXIST								
	110.30	102.00 in	8.3	104.7 IN S.								
	112.50	102.80 out	9.7	0+85.0								
	112.50	104.80 in	7.7									
0+00 L-6	110.00	103.20 out	6.8	0+00 EXIST								
	110.00	103.40 in	6.6	106.4 IN S								
	112.30	104.70 out	7.6	0+45.0								
	112.30	106.70 in	5.6									
0+00 L-7	111.80	104.83 out	7.0	0+00 EXIST								
	111.80	104.90 in	6.9	107.6 IN S								
	111.50	105.03 out	6.5	0+33.7								
	111.50	106.00 in	5.5	107.8 IN N								
1+00												
	111.40	106.28	5.1	1+02.5								
2+00	111.50	106.67	4.8									
3+00	111.70	107.07	4.6									
	112.00	107.30 out	4.7	3+57.6								
	112.00	107.90 in	4.1									
0+00 L-9	119.50	111.30 out	8.2	0+00 EXIST								
	119.50	111.50 in	8.0	113.7 S								
	117.20	111.70 out	5.5	0+49.8								
	117.20	112.52 in	4.7	113.9 IN N								
1+00	118.20	112.72	5.5									
2+00	118.70	113.12	5.6									
3+00	119.40	113.52	5.9									
	119.10	113.63	5.5	3+26.4								
4+00	119.20	113.92	5.3									
	119.20	113.96	5.2	4+09.01								
5+00	119.70	114.32	5.4									
6+00	120.40	114.72	5.7									
7+00	121.30	115.12	6.2									
	121.60	115.38 out	6.2	7+63.43								
	121.60	117.00 in	4.6									
0+00 L10	124.40	116.50 out	7.9	0+00 EXIST								
	124.40	116.70 in	7.7	118.9 OUT S								
	126.20	116.90 out	9.3	0+50.0								
	126.20	119.10 in	7.1									
0+00 L-11	126.90	120.01 out	6.9	0+00 EXIST								
	126.90	120.20 in	6.7	122.1 S								
	129.40	120.40 out	9.0	0+50.0								
	129.40	121.30 in	8.1									
LAT 2, MAIN 26, WIS (CONT. FROM P-139)												
0+00 L-3	192.97	180.17	12.8	0+00 = 21+43.78 L-1								
	194.70	181.09 out	13.6	0+92.39								
	194.70	181.19 in	13.5									
1+00	194.30	181.27	13.0									
	194.70	181.97 out	12.7	1+70.23								
	194.70	182.07 in	12.6									
2+00	194.50	182.25	12.3									
3+00	195.20	182.85	12.4									
4+00	195.90	183.45	12.5									

5+00 196.30 184.05 12.3
 196.90 184.51 12.4 5+70.0
 194.2 184.42 9.78 5+54.62
 4" SCH 40 5+62 Fredco
 6" STUB NW 184.68
 2001-0145
 2707N RegencyPk
 6-12-01
 SEE 1603 PPS on GIS - Line shortened so bldg could be expanded.