


RECONSTRUCTION OF PART OF MAIN 3, WIS, IN
 FABRIQUE BETWEEN FUNSTON AND HARRY
 PROJECT NO. 468-82993 (620264)
 BUILT BY W.B. CARTER CONSTRUCTION CO.
 BOOKED 9/7/00 PER AS BUILT PLAN

SCALE: 1" = 100'

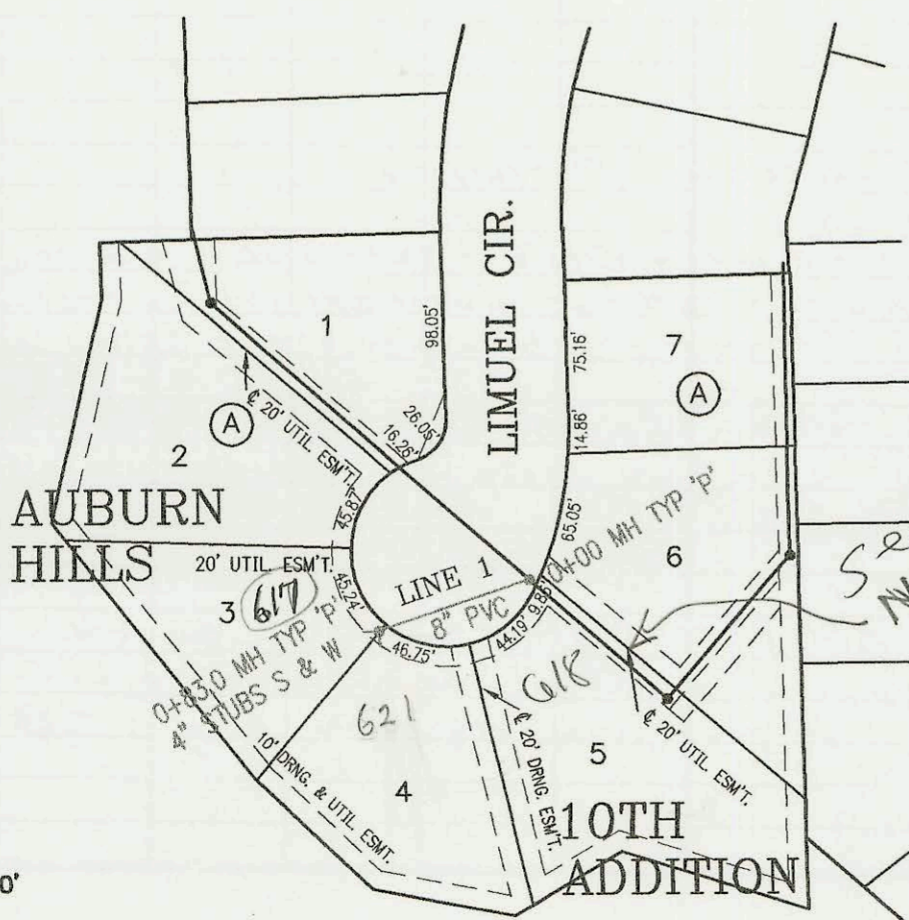

LATERAL 4, MAIN 2, COWSKIN INTERCEPTOR SEWER
 PROJECT NO. 468-83113 (743842)
 BUILT BY NOWAK CONSTRUCTION CO.
 BOOKED 9/27/00 PER PLAN

SCALE: 1" = 100'

CONSTRUCTION RECORD						SERVICE RECORD						
STATION	ELEVATION		DEPTH	MANHOLE	4-INCH "Y" BRANCHES		No. of Permit		House Number		DATE OF PERMITS	
	GROUND	GRADE			North West	South East	North West	South East	North West	South East	North West	South East
RECONSTRUCTION OF PART OF MAIN 3, WAR INDUSTRIES SEWER IN FABRIQUE BETWEEN FUNSTON AND HARRY												
0+00	126.48	113.78	12.7	0+00 EXIST								
	127.40	113.92 out	13.5	0+31.2								
	127.40	114.02 in	13.4									
1+00	127.00	114.26	12.7									
2+00	127.00	114.62	12.4									
3+00	127.00	114.98	12.0									
	127.30	115.25 out	12.1	3+77.2								
	127.30	115.35 in	12.0									
4+00	127.20	115.43	11.8									
5+00	127.50	115.78	11.7									
6+00	127.80	116.13	11.7									
7+00	128.30	116.48	11.8									
	128.30	116.58 out	11.7	7+29.6								
	128.30	116.68 in	11.6									
8+00	128.80	116.97	11.8									
	129.50	117.29 out	12.2	8+79.6								
	129.50	117.39 in	12.1									
9+00	129.20	117.43	11.8									
	129.70	117.52 out	12.2	9+42.8								
	129.70	117.62 in	12.1									
10+00	129.60	117.82	11.8									
11+00	130.00	118.17	11.8									
12+00	130.30	118.52	11.8									
13+00	130.50	118.87	11.6									
	131.00	118.92 out	12.1	13+13.8								
	131.00	119.02 in	12.0									
	132.50	119.25 out	13.3	13+81.2								
	132.50	119.35 in	13.2									
14+00	131.60	119.49	12.1									
	132.70	119.89 out	12.8	14+53.4								
	132.70	119.99 in	12.7									
15+00	132.30	120.14	12.2									
	132.62	120.40	12.2	15+84.8								
LATERAL 4, MAIN 2, COWSKIN INTERCEPTOR SEWER												
0+00	139.50	127.27 out	12.2	0+00								
	139.50	127.79 in	11.7									
	139.40	131.50	7.9	0+83.0	4" STUB W 131.83	4" STUB S 131.83	2003 02041	2004 01871	6175 LIMUCI	671 LIMUCI	8-5-03	7-12-04