



LATERAL 54, MAIN 3, SOUTHWEST INTERCEPTOR SEWER  
PROJECT NO. 468-83060 (743825)  
BUILT BY PADGETT EXCAVATION, INC.  
BOOKED 10/26/00 PER PLAN

SCALE: 1" = 100'

MERIDIAN

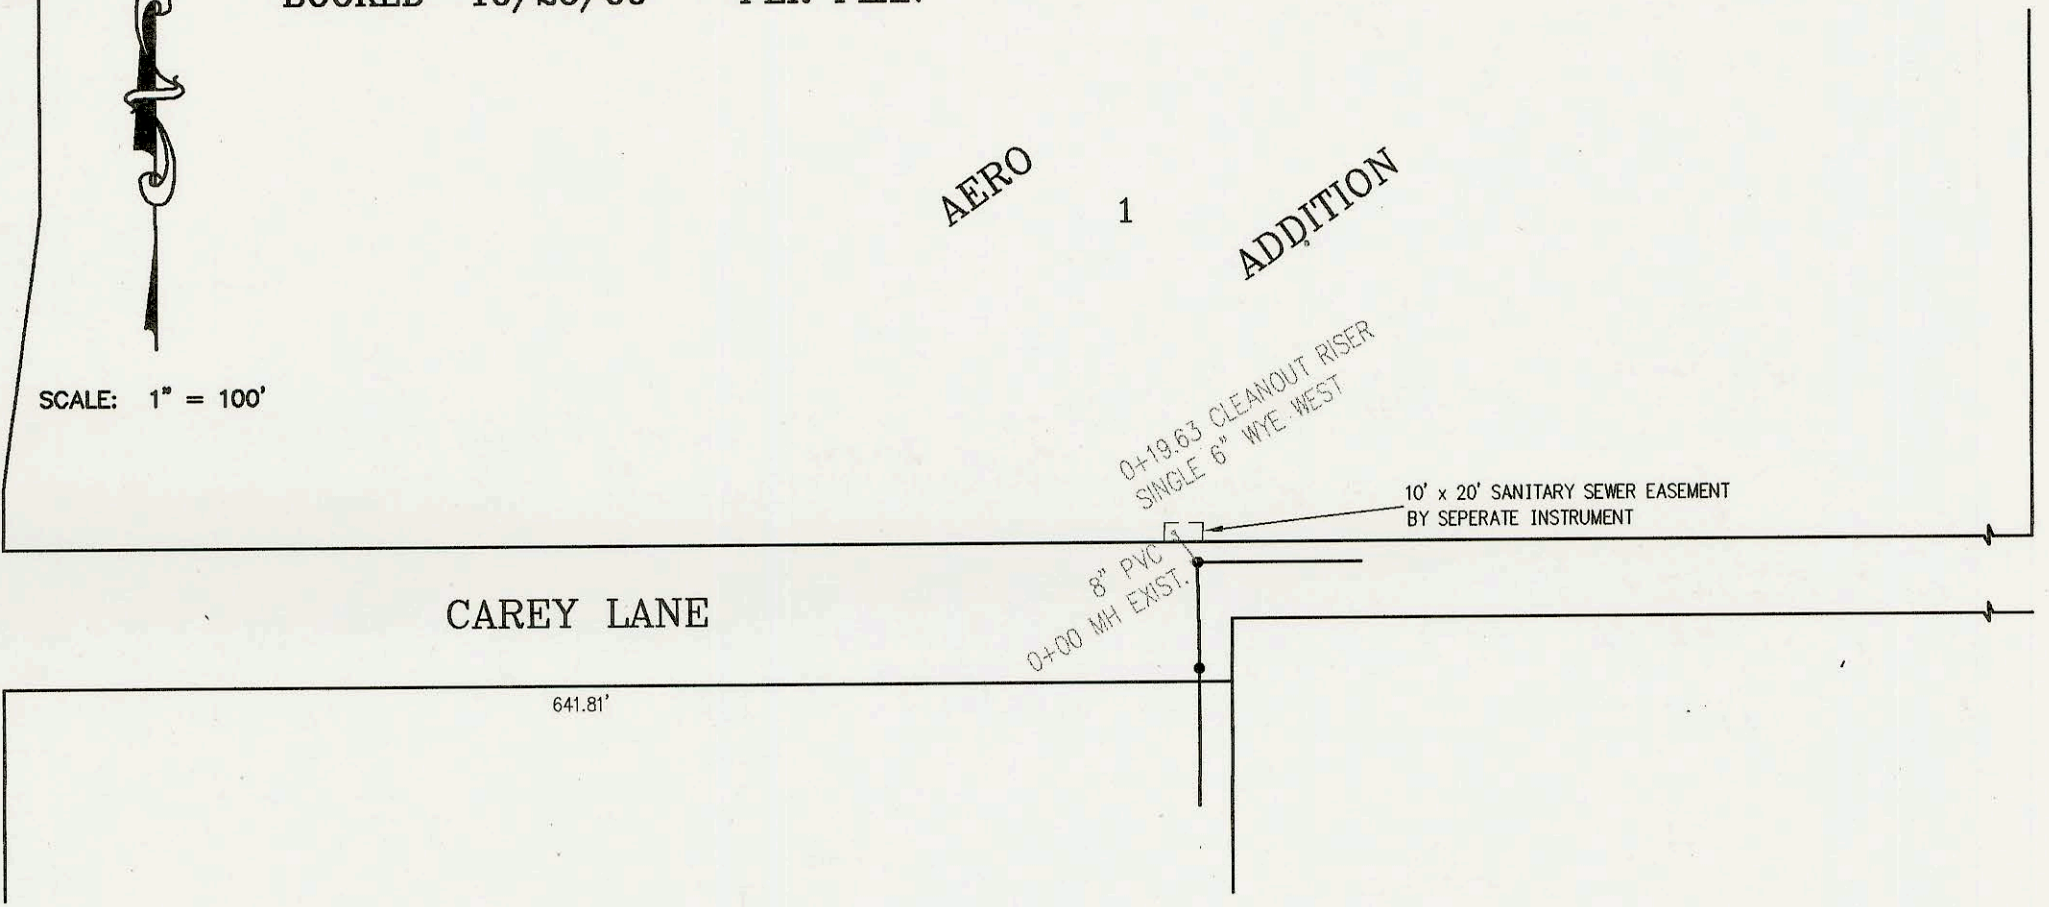

SCALE: 1" = 100'

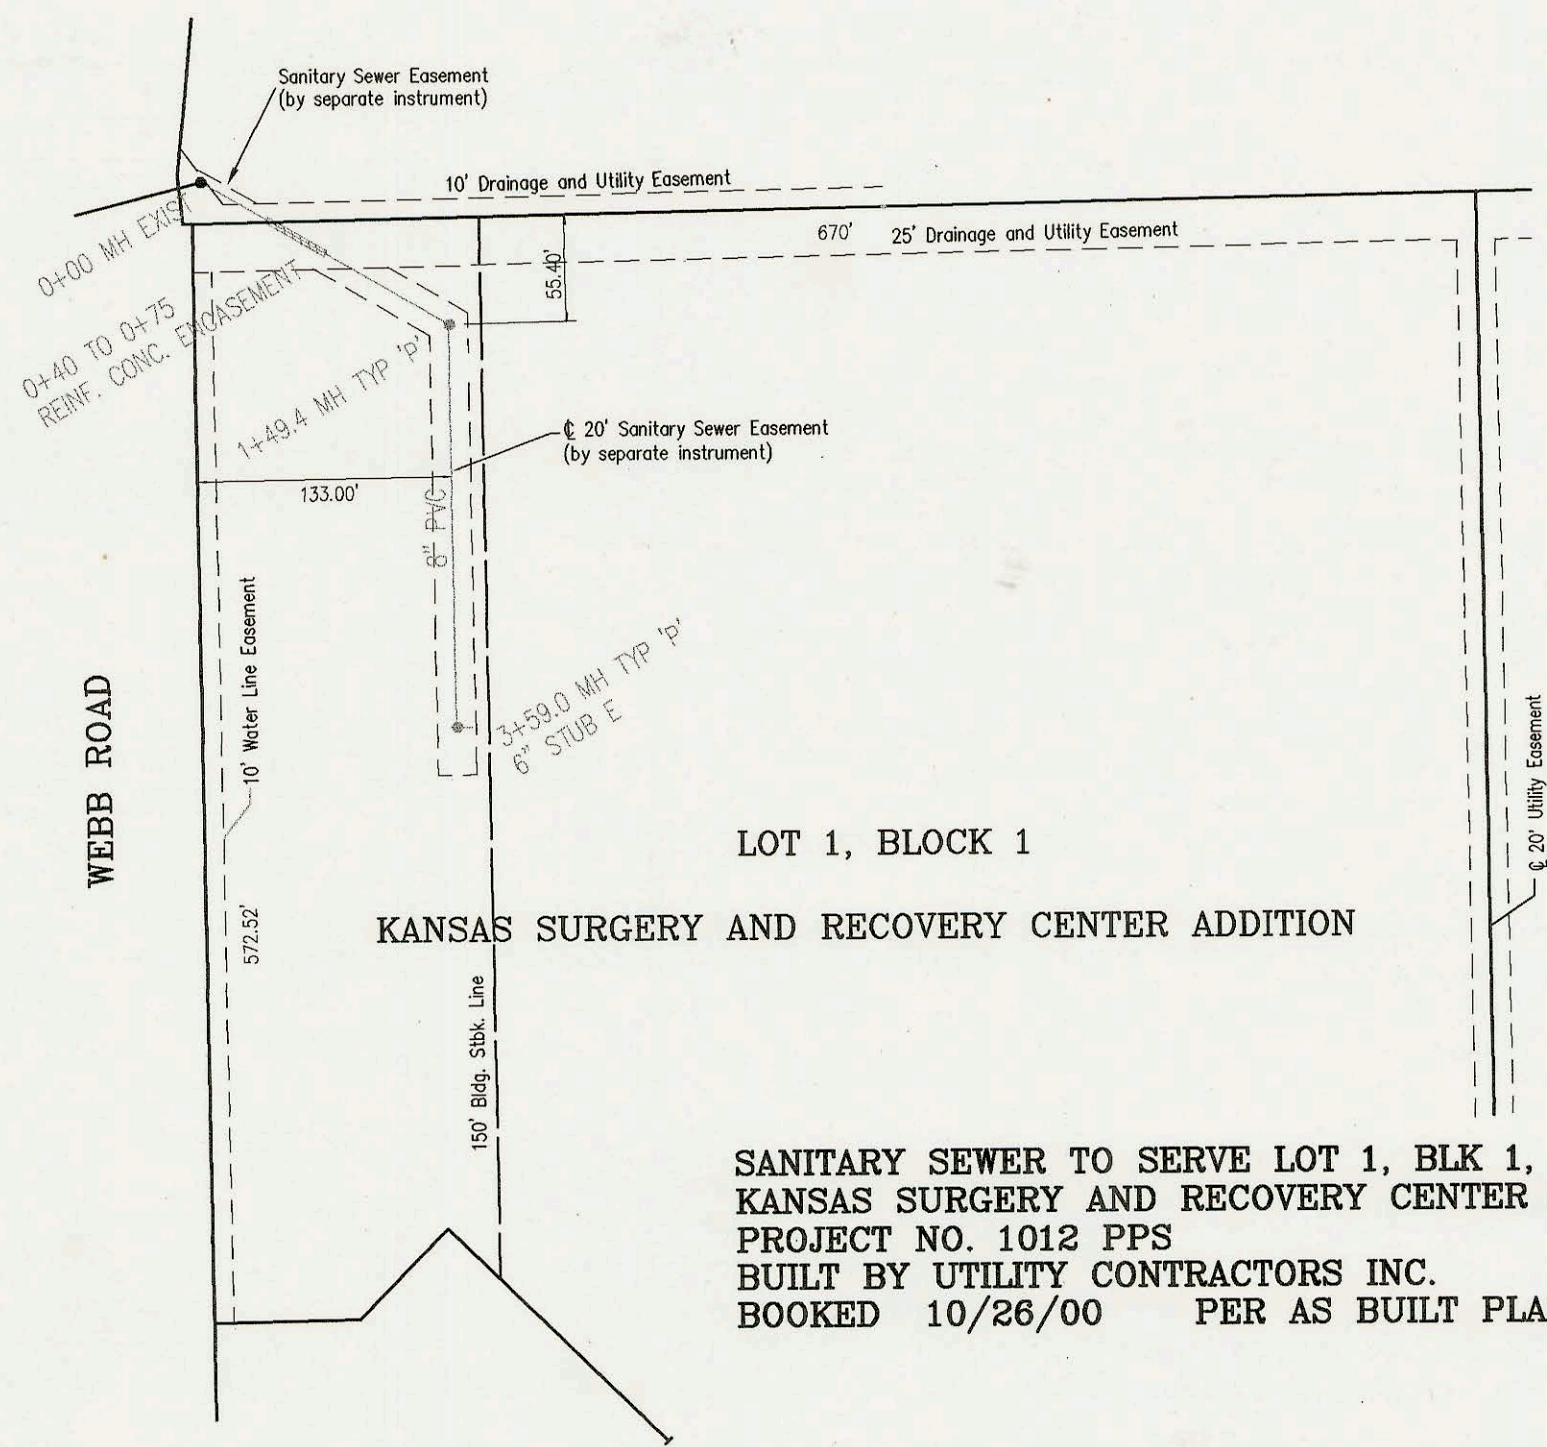


SANITARY SEWER TO SERVE LOT 1, BLK 1,  
KANSAS SURGERY AND RECOVERY CENTER ADDITION  
PROJECT NO. 1012 PPS  
BUILT BY UTILITY CONTRACTORS INC.  
BOOKED 10/26/00 PER AS BUILT PLAN

SANITARY SEWER TO SERVE PART OF LOT 5, BLK 2,  
CARRIAGE HOUSE PLAZA SECOND ADDITION  
PROJECT NO. 1037 PPS  
BUILT BY W.B. CARTER CONSTRUCTION  
BOOKED 10/26/00 PER AS BUILT PLAN

CARRIAGE HOUSE PLAZA SECOND ADDITION  
part of Lot 5, Blk 2

TYLER ROAD

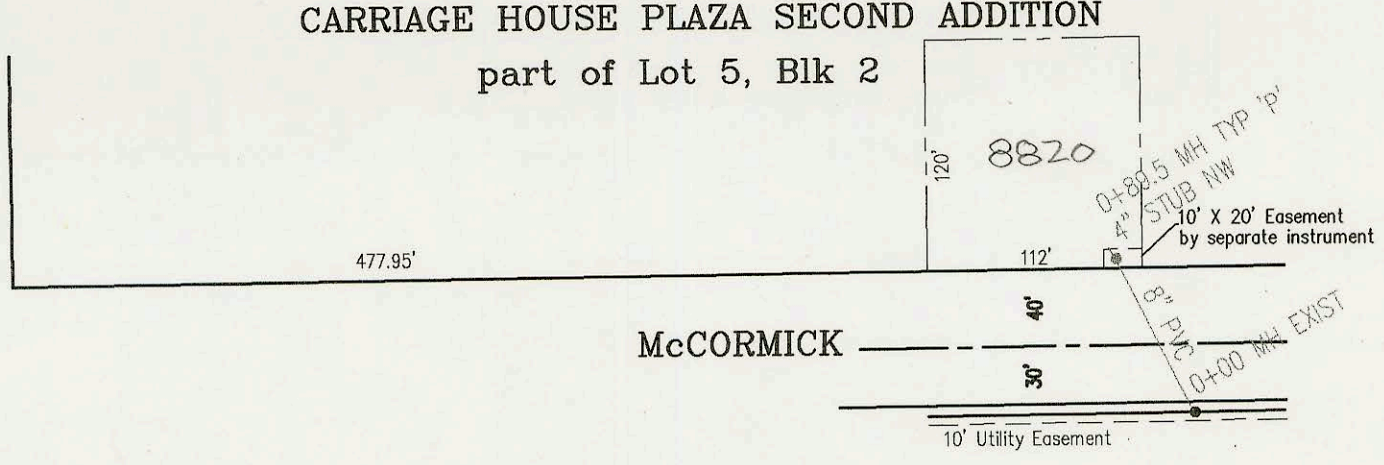

SCALE: 1" = 100'

CONSTRUCTION RECORD						SERVICE RECORD						
STATION	ELEVATION		DEPTH	MANHOLE	4-INCH "Y" BRANCHES		No. of Permit		House Number		DATE OF PERMITS	
	GROUND	GRADE			North West	South East	North West	South East	North West	South East	North West	South East
LATERAL 54, MAIN 3	SOUTHWEST	INTERCEPTOR SEWER										
0+00 L-1	95.12	89.10 out	6.0	0+00 EXIST								
	95.12	89.20 in	5.9									
	95.00	89.28		0+19.63 CLEANOUT RISER	6" WYE WEST			2000-500	3830 S Meridian		1-10-91	
SANITARY SEWER TO	SERVE LOT 1, BLK 1, KANSAS SURGERY AND RECOVERY CENTER ADDITION (1012PPS)											
0+00	223.62	211.74 out	11.9	0+00 EXIST								
	223.62	213.74 in	9.9									
1+00	221.00	214.49	6.5									
	222.10	214.86 out	7.2	1+49.4								
	222.10	214.96 in	7.1									
2+00	222.60	215.16	7.4									
3+00	223.10	215.56	7.5									
	223.20	215.80	7.4	3+59.0		6" STUB E 216.02						
SANITARY SEWER TO	SERVE PART OF LOT 5, BLK 2, CARRIAGE HOUSE PLAZA SECOND ADDITION											
0+00	143.10	135.20 out	7.9	0+00 EXIST								
	143.10	135.40 in	7.7									
	143.87	136.06	7.8	0+89.5	4" STUB NW 136.40			2000-02127	8820 W McCormick	Papa John's Pizza	9-26-00	