



ABERDEEN 3RD ADDITION

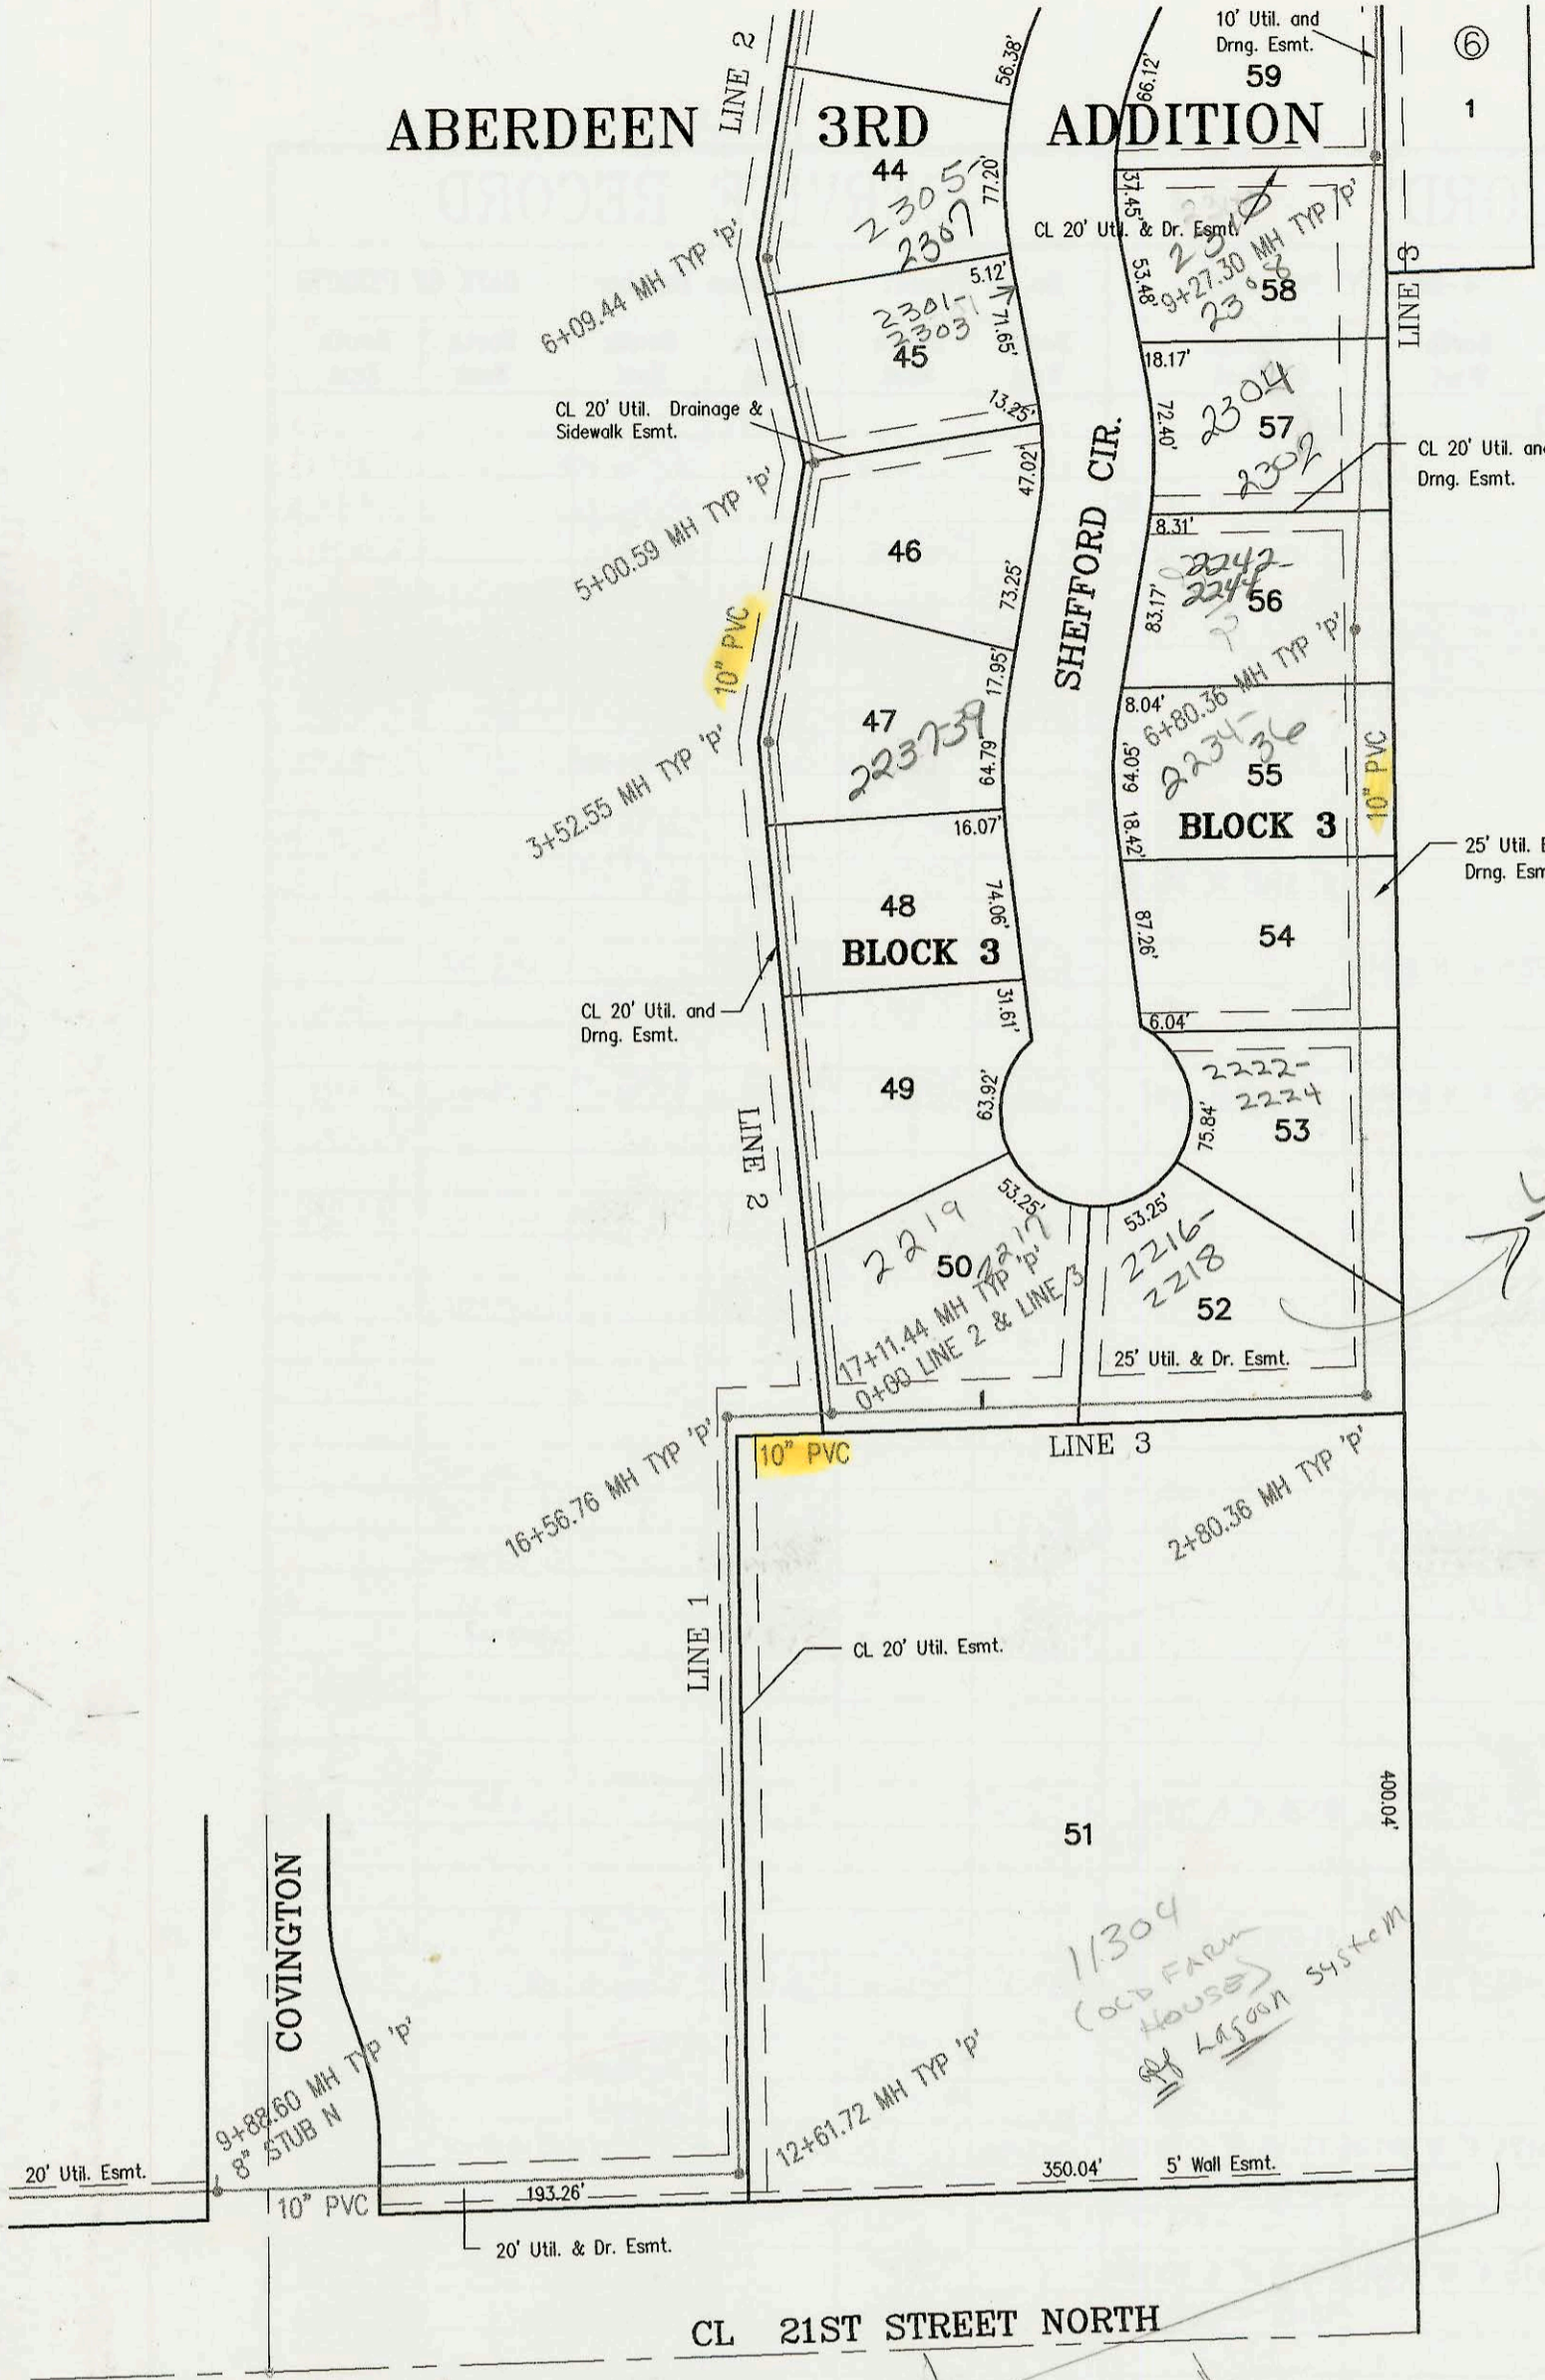

*Lot 52 is site for
old Lagoon for
11304 w 21st
Lagoon abandoned
when house connected
to City Main
BSA*

**LATERAL 432, SOUTHWEST INTERCEPTOR SEWER
PROJECT NO. 468-83004 (743833)
BUILT BY UTILITY CONTRACTORS INC.
BOOKED 10/24/00 PER AS BUILT PLAN**

SCALE: 1" = 100'

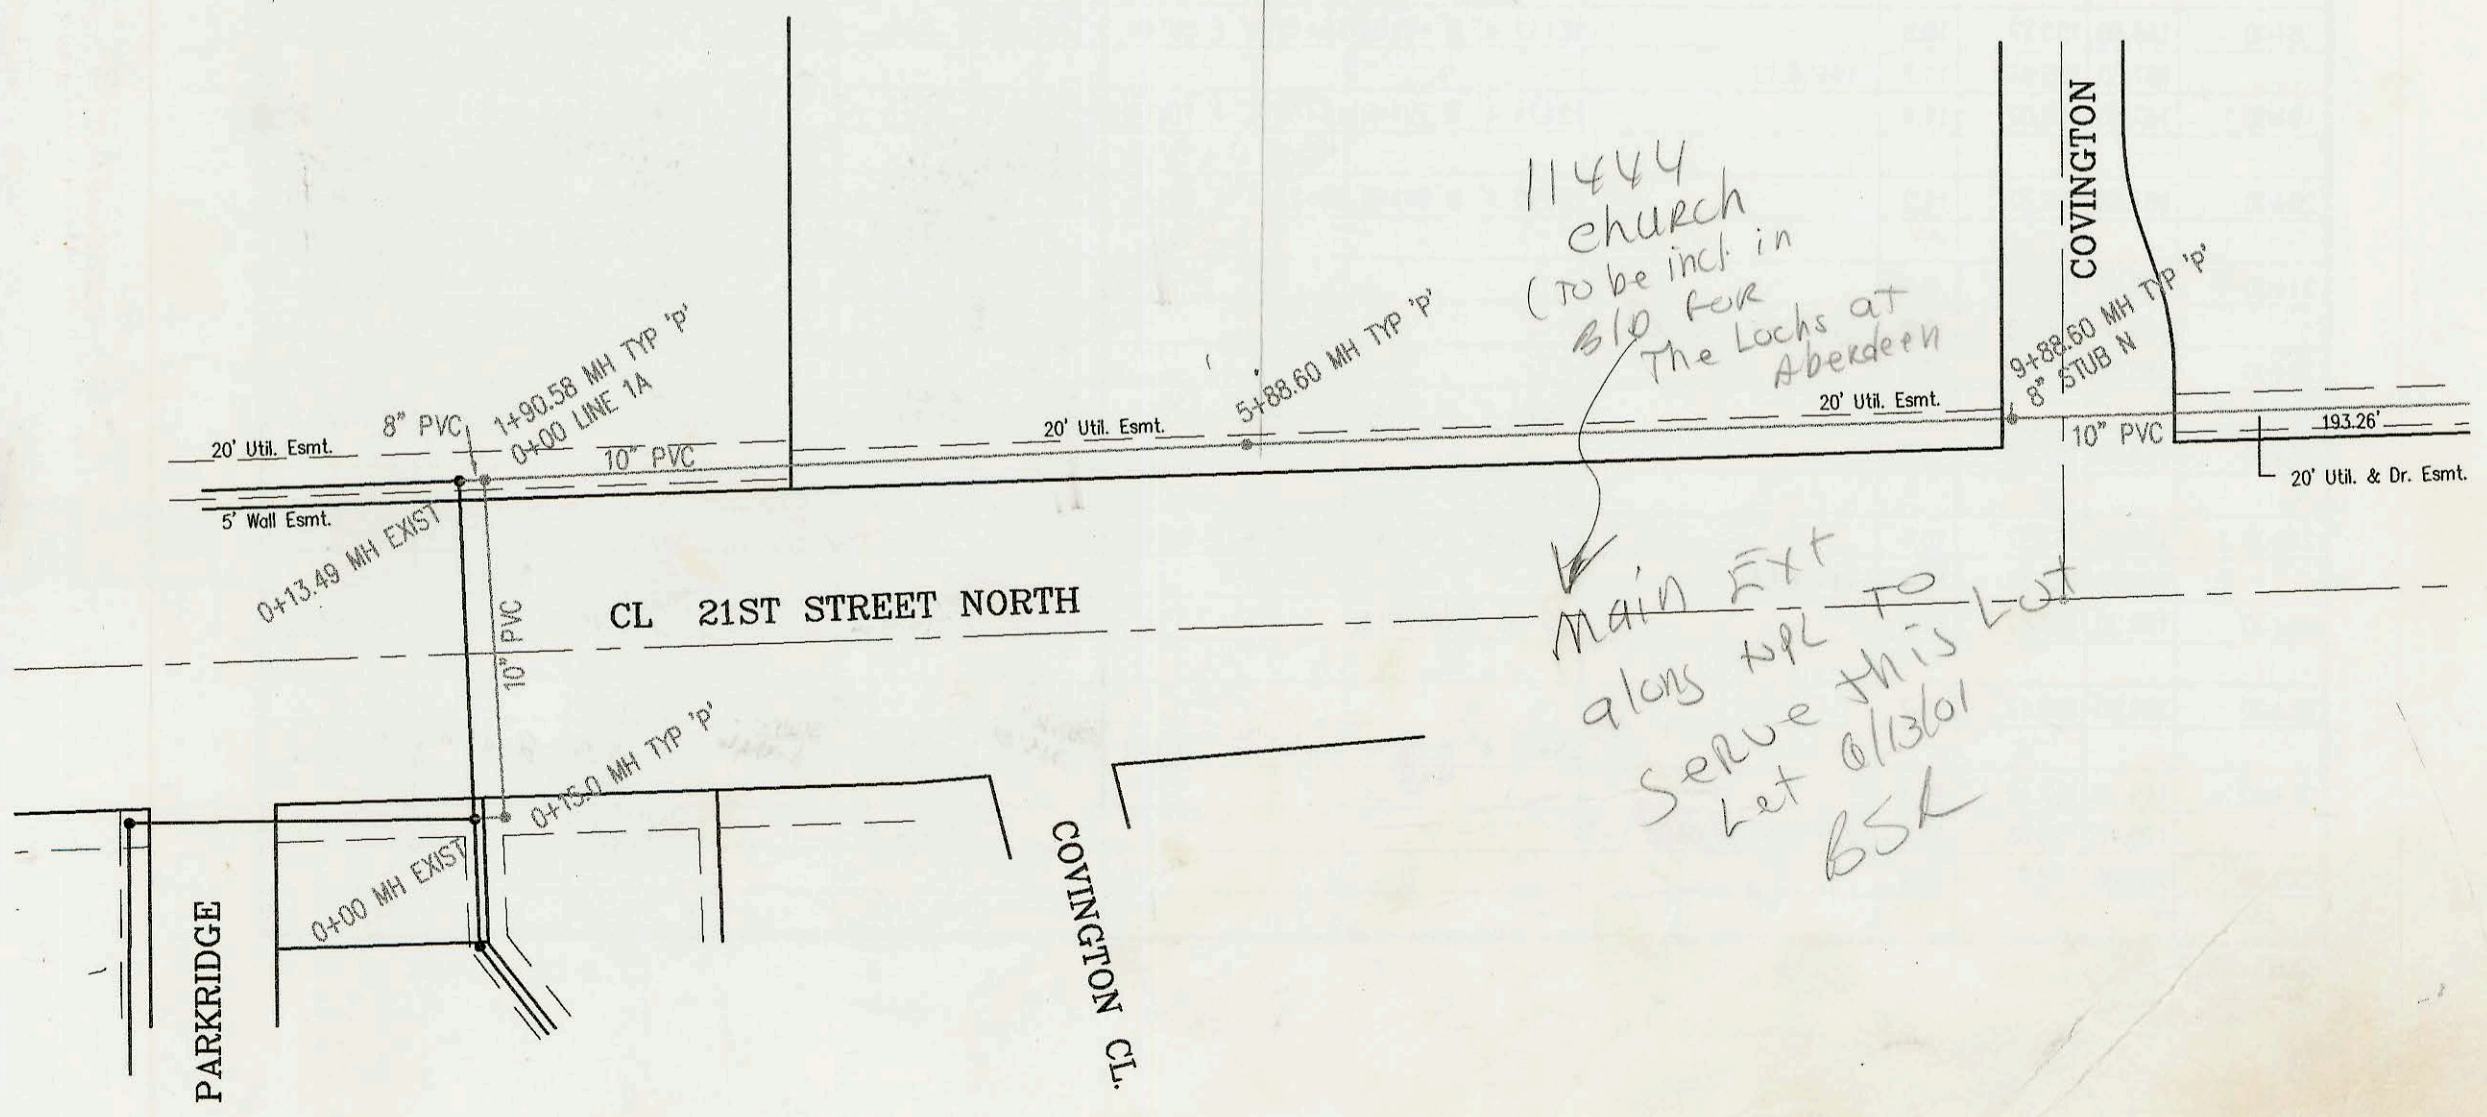

*11444
church
(to be incl. in
BID for
The Locks at
Aberdeen*

*main EXT
along HPL TO
serve this lot
let 01/30/01
BSA*

CONSTRUCTION RECORD					SERVICE RECORD							
STATION	ELEVATION		DEPTH	MANHOLE	4-INCH "Y" BRANCHES		No. of Permit		House Number		DATE OF PERMITS	
	GROUND	GRADE			North West	South East	North West	South East	North West	South East	North West	South East
LATERAL 432, SOUTHWEST INTERCEPTOR SEWER												
0+00 L-1	165.40	147.79	17.6	0+00 EXIST								
	162.50	147.82	out 14.7	0+15.0								
	162.50	147.87	in									
1+00	166.10	148.03										
	165.70	148.20	out 17.5	1+90.58 = 0+00 L-1A								
	165.70	148.42	in									
2+00	165.70	148.44	17.3									
3+00	165.80	148.64	17.2									
4+00	165.40	148.84	16.6									
5+00	165.80	149.04	16.8									
	166.60	149.22	17.4	5+88.60								
6+00	166.20	149.24	17.0									
7+00	166.00	149.44	16.6									
8+00	164.80	149.64	15.2									
9+00	164.00	149.84	14.2									
	164.00	150.02	14.0	9+88.60								
10+00	163.40	150.04	13.4									
11+00	160.40	150.24	10.2									
12+00	161.60	150.44	11.2									
	165.00	150.56	out 14.4	12+61.72								
	165.00	150.66	in 14.3									
13+00	163.50	150.74	12.8									
14+00	163.30	150.94	12.4									
15+00	163.90	151.14	12.8									
16+00	163.50	151.34	12.2									
	165.00	151.45	out 13.6	16+56.76								
	165.00	151.55	in 13.5									
17+00	164.30	151.64	12.7									
	165.00	151.66	13.3	17+11.44 = 0+00 L-2 = 0+00 L-3								
0+00 L-1A	165.70	148.31	17.4	0+00 = 1+90.58 L-1								
	166.10	148.37	17.7	0+13.49 EXIST								
0+00 L-2	164.90	151.69	13.2	0+00 = 16+72.22 L-1								
1+00	164.50	151.89	12.6									
2+00	164.50	152.09	12.4									
3+00	164.40	152.29	12.1									
	164.80	152.40	12.4	3+52.55	4" sch 40 3+69.2		2001-02784	2377-39 Sheffield			11-2-01	
4+00	164.40	152.49	11.9									
5+00	164.80	152.69	12.1	5+00.59	4" sch 40 5+44.3 Predco		2001-00920	2301-03N Sheffield			4-17-01	
6+00	164.40	152.89	11.5				2001-02785	2305-07 Sheffield			11-1-01	
	164.80	152.91	11.9	6+09.44	4" sch 40 7+40.9 Predco		2001-01771	2311 Sheffield			7-17-01	
7+00	164.40	153.09	11.3		4" sch 40 7+38.94 Predco		2001-01778	2307 Sheffield			7-17-01	
	164.80	153.23	out 11.6	7+71.94			2002-04434	2313 Sheffield			9-3-02	
	164.80	153.33	in 11.5									
8+00	164.40	153.39	11.0		4" sch 40 8+71.94 saddle		2001-01669	2317N Sheffield			7-9-01	
9+00	164.40	153.59	10.8									
	164.80	153.77	11.0	9+90.96			2003-01821	2421 Sheffield			7-10-03	
10+00	164.40	153.79	10.6				2002-02652	2401N Sheffield			9-26-02	
11+00	164.40	153.99	10.4				2002-00824	2405N Sheffield			3-22-02	
	164.80	154.17	10.6	11+91.54								
12+00	164.40	154.27	10.1									
	164.80	154.40	10.4	12+57.75 = 0+00 L-2A								
13+00	164.50	154.49	10.0									

CONSTRUCTION RECORD				SERVING RECORD			
DATE	DESCRIPTION	TIME	LOCATION	DATE	DESCRIPTION	TIME	LOCATION
10/1
10/2
10/3
10/31

10/11 10:00 AM
 10/12 10:00 AM
 10/13 10:00 AM
 10/14 10:00 AM
 10/15 10:00 AM
 10/16 10:00 AM
 10/17 10:00 AM
 10/18 10:00 AM
 10/19 10:00 AM
 10/20 10:00 AM
 10/21 10:00 AM
 10/22 10:00 AM
 10/23 10:00 AM
 10/24 10:00 AM
 10/25 10:00 AM
 10/26 10:00 AM
 10/27 10:00 AM
 10/28 10:00 AM
 10/29 10:00 AM
 10/30 10:00 AM
 10/31 10:00 AM