


SANITARY SEWER FOR CROWN CHASE APARTMENTS PHASE 2
PROJECT NO. 800PPS
BUILT BY UTILITY CONTRACTORS INC.
11/17/00 PER AS BUILT PLAN

RIDGE ROAD

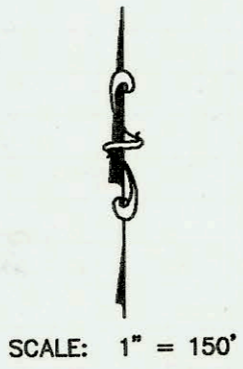

20' EASEMENT

0+00 MH EXIST

SILVER SPRINGS BLVD. (PRIV. ST.)

LOT 4

SILVER SPRINGS

3+95.78 MH TYP 'P'
6" STUBS SW & SE

3+04.3 MH TYP 'P'
8" PVC

LINE 1
20' SANITARY SEWER ESMT.
BY SEPR. INSTR.

0+00 MH EXIST

20' EASEMENT

18" SS

30" SS

30" SS

CENTRAL AVE.

CONSTRUCTION RECORD						SERVICE RECORD						
STATION	ELEVATION		DEPTH	MANHOLE	4-INCH "Y" BRANCHES		No. of Permit		House Number		DATE OF PERMITS	
	GROUND	GRADE			North West	South East	North West	South East	North West	South East	North West	South East
LATERAL 22, COWSKIN INTERCEPTOR SEWER (CONT. FROM P-160)												
0+00 L-2	168.00	154.98 out	13.0	0+00 EXIST								
	168.00	155.15 in	12.9		← 0+35 4" SW 9V10H		2002-00816		13917 Remington			3-22-02
	166.60	156.00 out	10.6	0+91.1 = 0+00 L-2A								
	166.60	156.17 in	10.4									
1+00	166.30	156.31	10.0		← 1+24 4" SW 10V10H		2002-01471		13913 Remington			5-24-02
2+00	168.50	157.86	10.6		← 2+13 4" SW 10V10H		2002-01945		13707 Remington			7-16-02
3+00	169.80	159.41	10.4		← 3+02 4" SW 9V10H		2002-01050		13905 Remington			4-11-02
					← 3+91 4" SW 8V10H		2001-02070		13901 W Remington			8-20-01
4+00	172.70	160.96	11.7									
	176.31	161.80 out	14.5	4+54.0								
	176.31	161.89 in	14.4									
5+00	175.10	162.07	13.0		← 5+37 4" SW 8V10H		2002-01477		14004 Remington			4-11-02
6+00	173.30	162.47	10.8									
	172.13	162.76 out	9.4	6+72.1	8" STUB NW 162.81		2003-01016		14110 Remington			4-16-03
	172.13	162.81 in	9.3									
7+00	171.60	163.54	8.1									
8+00	172.80	166.16	6.6		8+10.1 4" SW 4H		2004-00068 2005-00240		14008 Remington 140120 Remington			1-8-04 2-2-05
9+00	174.50	168.77	5.7									
10+00							2002-03459		14102 Remington			12-19-02
	178.90	171.52	7.4	10+05.1								
0+00 L-2A	166.60	156.10	10.5	0+00 = 0+91.1 L-2								
1+00	167.00	156.45	10.6									
	168.20	156.80 out	11.4	1+95.0 = 0+00 L-2B								
	168.20	156.90 in	11.3									
2+00							2001-01080		13909 Remington			6-6-01
3+00	165.70	157.55	8.1									
	165.30	157.80 out	7.5	3+39.4	10" STUB W 157.77							
	165.30	157.86 in	7.4									
	165.80	160.00 out	5.8	3+98.7	4" NE 4V16H		2001-02050	2004-01066	13941 W Remington 14125 Highland spgs			11-30-01 4-15-04
	165.80	160.10 in	5.7									
4+00					4+68 4" NE 5V16H		2001-01698		13945 Highland spgs			7-11-01
5+00	167.70	161.07	6.6		5+57 4" NE 7V16H		2002-01024		13949 Remington			4-10-02
6+00	169.60	162.02	7.6		4" NE 8V16H	8" STUB SW 162.80	2002-02830		13953 Remington			10-15-02
	171.30	162.70	8.6	6+71.0								
0+00 L-2B	168.20	157.00	11.2	0+00 = 1+95.0 L-2A								
1+00	170.00	159.04	11.0				2002-01002		13933 Remington			4-9-02
	169.20	160.45	8.8	1+69.3	4" STUB SE 160.81		2001-01699		13924 Remington			7-11-01
SANITARY SEWER TO SERVE CROWN CHASE APARTMENTS PHASE 2 (800PPS)												
0+00 L-1	125.84	112.55	13.3	0+00 EXIST								
1+00	125.90	114.27	11.6									
					1+40.1 6" N							
2+00	126.60	115.99	10.6									
3+00												
	126.75	117.78 out	9.0	3+04.3								
	126.75	117.88 in	8.9									
	127.51	119.73	7.8	3+95.78	6" STUB SW 10'	6" STUB SE 12'						
0+00 L-2	127.31	114.94	12.4	0+00 EXIST								
1+00	126.80	116.03	10.8		1+74.8 6" NW	1+51.2 6" SE						
2+00	126.60	117.13	9.5									
	126.41	118.21	8.2	2+98.92	6" STUB NW 9'	6" STUB SE 12'						
						6" STUB E 9'						