



LATERAL 139, MAIN 4, SANITARY SEWER NO. 22
PROJECT NO. 468-83061
BUILT BY McCULLOUGH EXCAVATION
BOOKED 1/10/00 PER PLAN

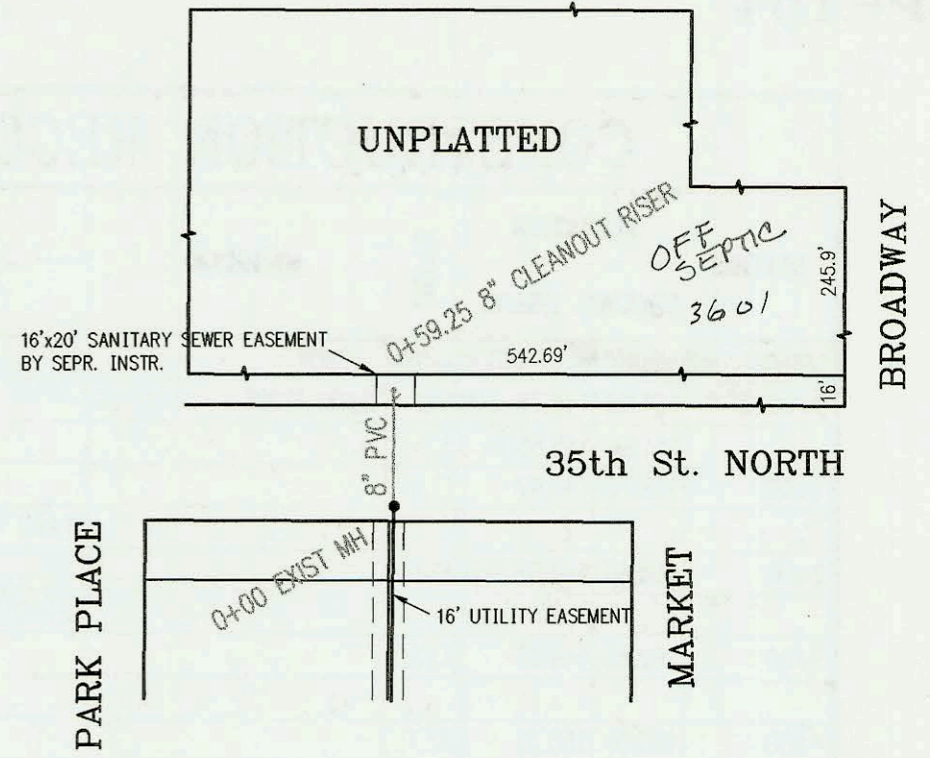

SCALE: 1" = 100'

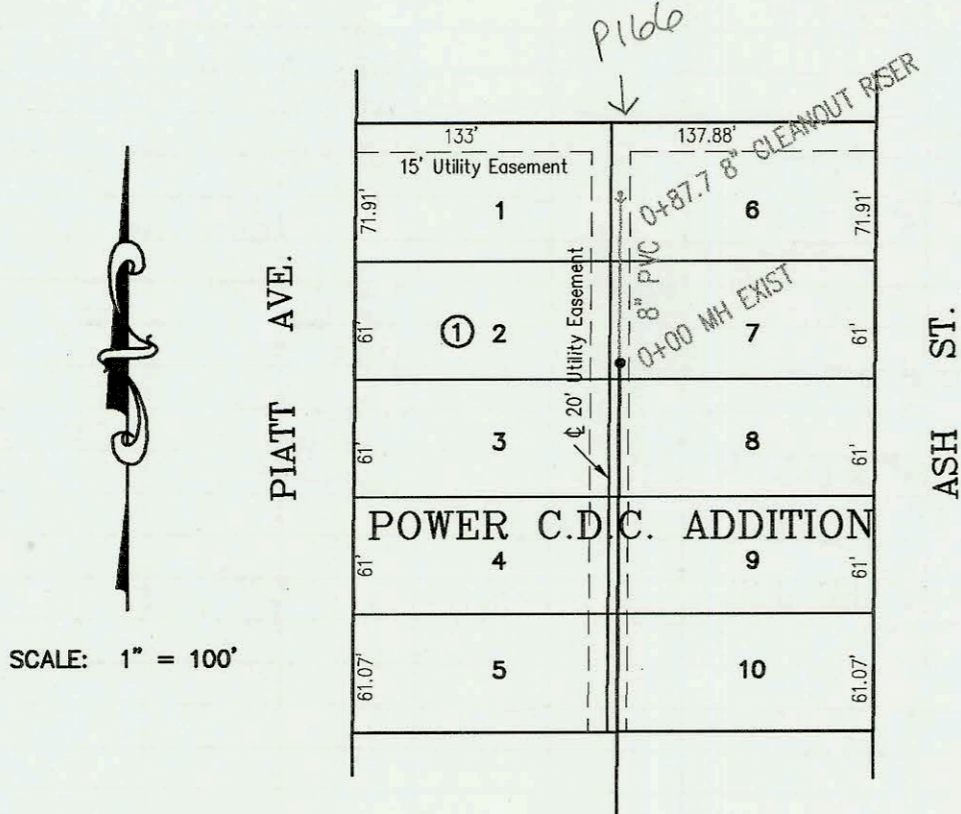


SCALE: 1" = 100'


LATERAL 32, DISTRICT E, SANITARY SEWER NO. 12
PROJECT NO. 468-83055 (743847)
BUILT BY McCULLOUGH EXCAVATION
BOOKED 1/16/01 PER PLAN

SANITARY SEWER REPLACEMENT IN ALLEY
BETWEEN ST. FRANCIS AND SANTA FE
FROM 2ND TO 3RD ST.
PROJECT NO. 468-82758 (621722)
BUILT BY ASSOCIATED CONSTRUCTION SYSTEMS
BOOKED 1/18/01 PER AS BUILT PLAN

SANITARY SEWER TO SERVE
LOTS 1 & 2, BLK A, REYNOLDS ADDITION
PROJECT NO. 1019PPS
BUILT BY BRAND PLUMBING
BOOKED 1/22/01 PER AS BUILT PLAN

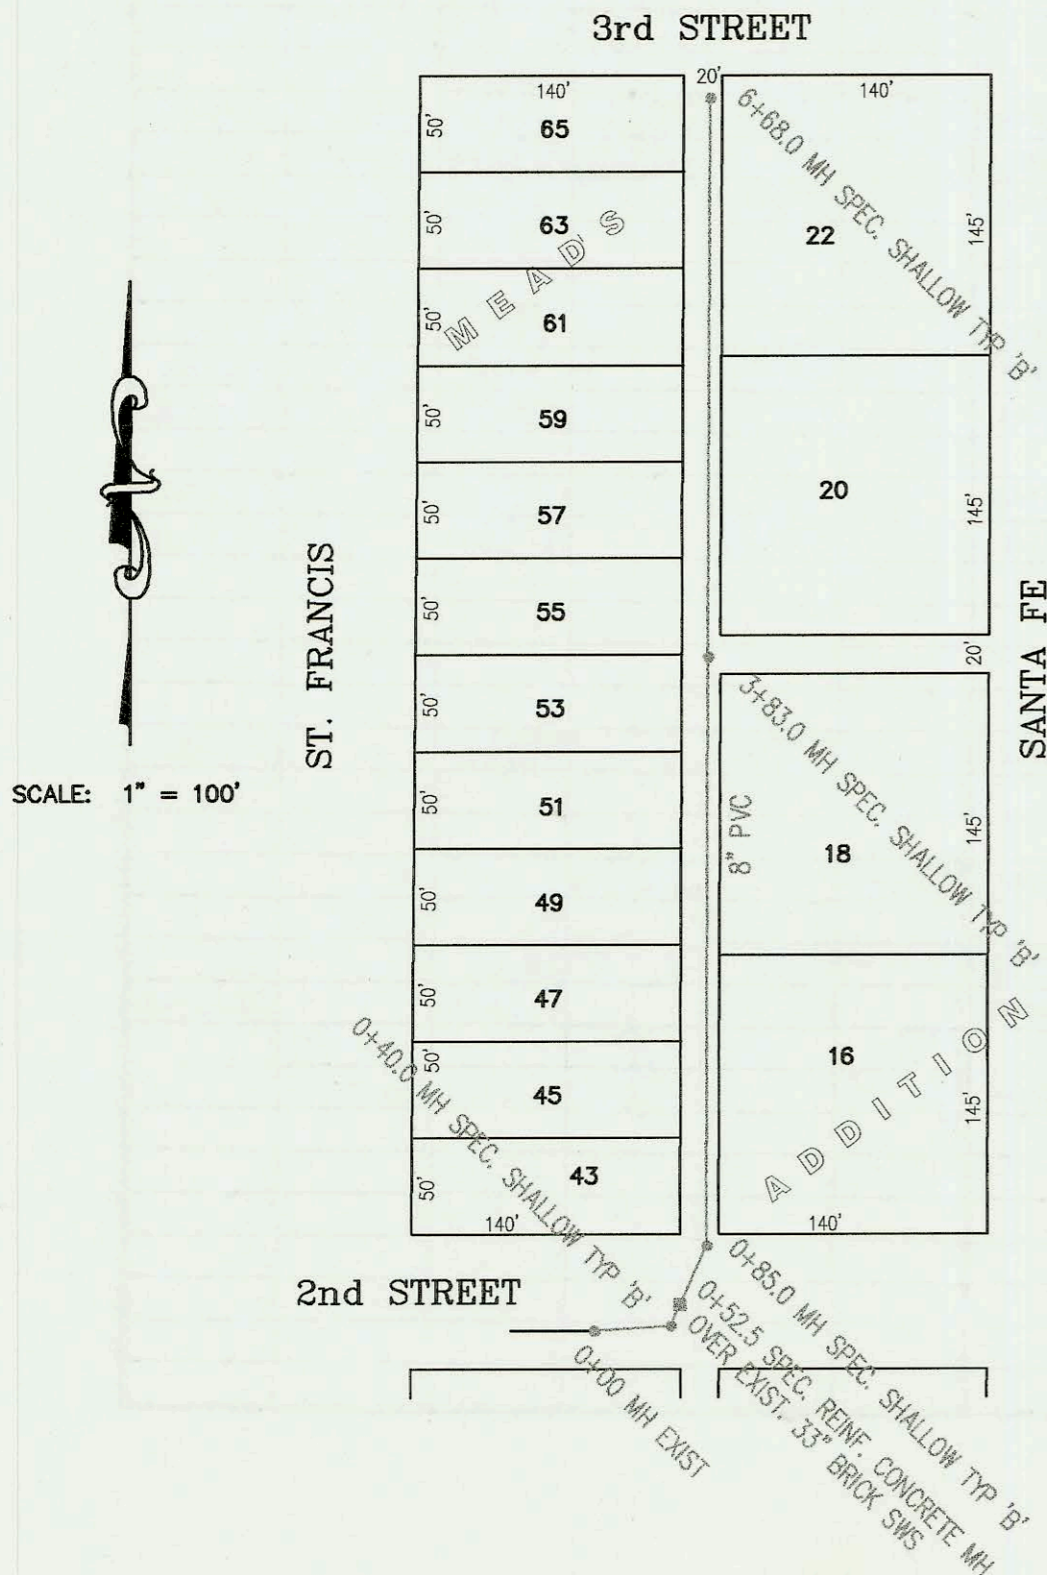

SCALE: 1" = 100'

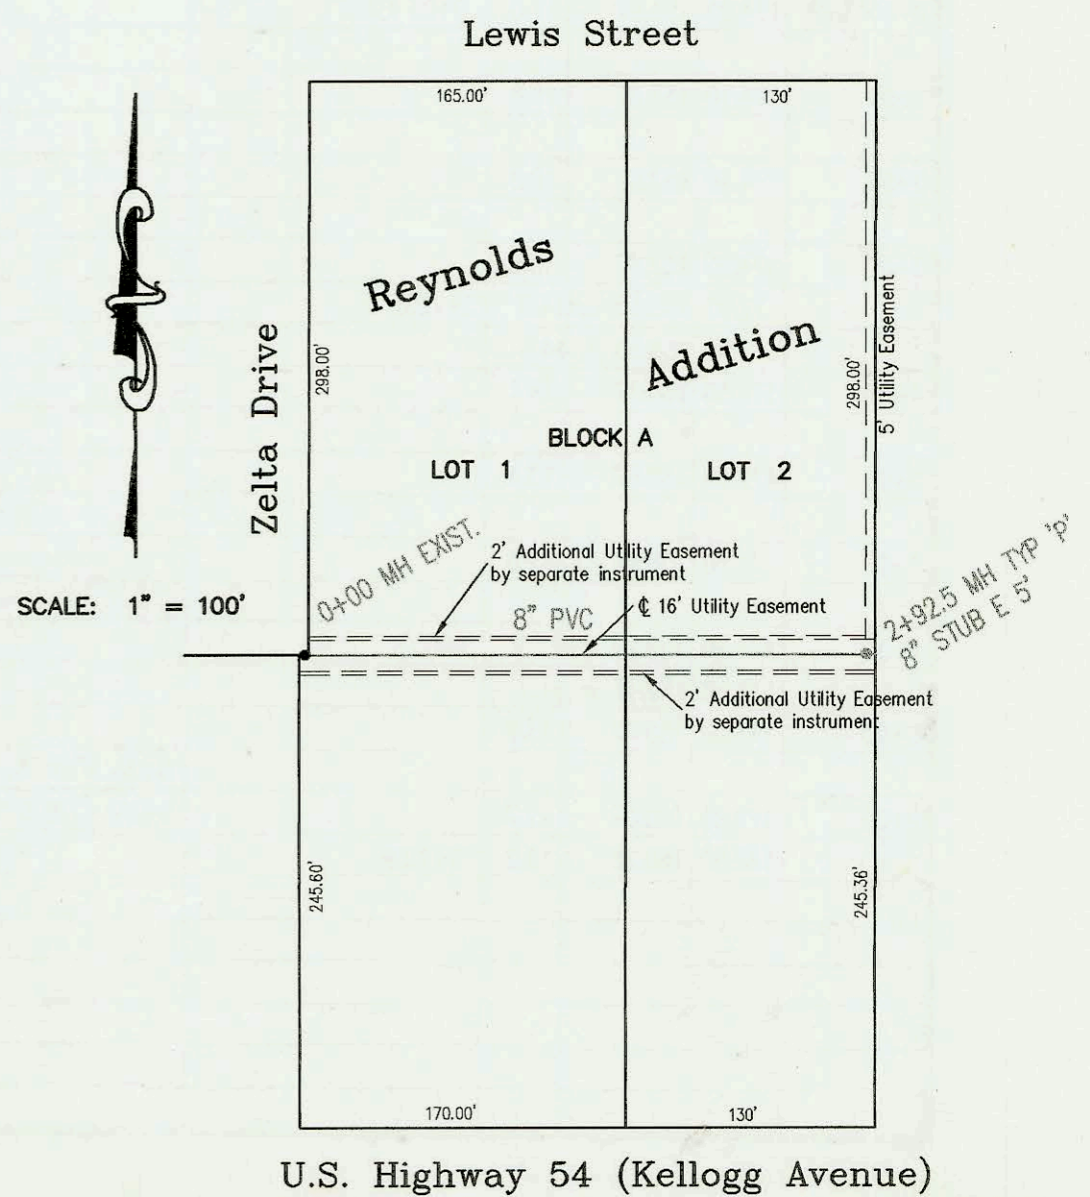

SCALE: 1" = 100'

CONSTRUCTION RECORD					SERVICE RECORD							
STATION	ELEVATION		DEPTH	MANHOLE	4-INCH "Y" BRANCHES		No. of Permit		House Number		DATE OF PERMITS	
	GROUND	GRADE			North West	South East	North West	South East	North West	South East	North West	South East
LATERAL 139, MAIN 4, SANITARY SEWER NO. 23												
0+00	131.30	125.27	6.0	0+00 EXIST								
	131.29	125.48	5.8	0+59.25 CLEANOUT		4" wye E. 4" SCH40		2001-00149		3601 D Reynolds		1-23-01
LATERAL 32, DISTRICT E, SANITARY SEWER NO. 12												
0+00	124.32	119.46 out	4.9	0+00 EXIST								
	124.32	119.56 in	4.8			see P-166						
	125.22	119.80	5.4	0+87.7 CLEANOUT RISER								
SANITARY SEWER FACILITY REPLACEMENT IN ALLEY BETWEEN ST. FRANCIS AND SANTA FE FROM 2ND TO 3RD ST.												
0+00	110.94	106.48	4.5	0+00 EXIST								
	110.90	106.60 out	4.3	0+40.0								
	110.90	106.99 in	3.9									
	111.38	107.06	4.3	0+52.5								
	110.80	107.20 out	3.6	0+85.0								
	110.80	107.40 in	3.4									
1+00	111.00	107.45	3.6									
2+00	111.20	107.75	3.5									
3+00	111.50	108.05	3.5									
	111.80	108.31	3.5	3+83.0								
4+00	111.80	108.35	3.5									
5+00	111.90	108.65	3.3									
6+00	112.10	108.95	3.1									
	112.42	109.12	3.3	6+68.0								
SANITARY SEWER TO SERVE LOTS 1 & 2, BLK A, REYNOLDS ADDITION (1019PPS)												
0+00	178.53	169.45	9.1	0+00 EXIST								
1+00	178.50	169.85	8.7									
2+00	176.50	170.25	6.3									
	178.30	170.64	7.7	2+92.45		8" STUB E 5'						