


LATERAL 383, SOUTHWEST INTERCEPTOR SEWER  
PROJECT NO. 468-82768 (743854)  
BUILT BY W.B. CARTER CONSTRUCTION CO.  
BOOKED 1/17/01 PER AS BUILT PLAN

SCALE: 1" = 100'

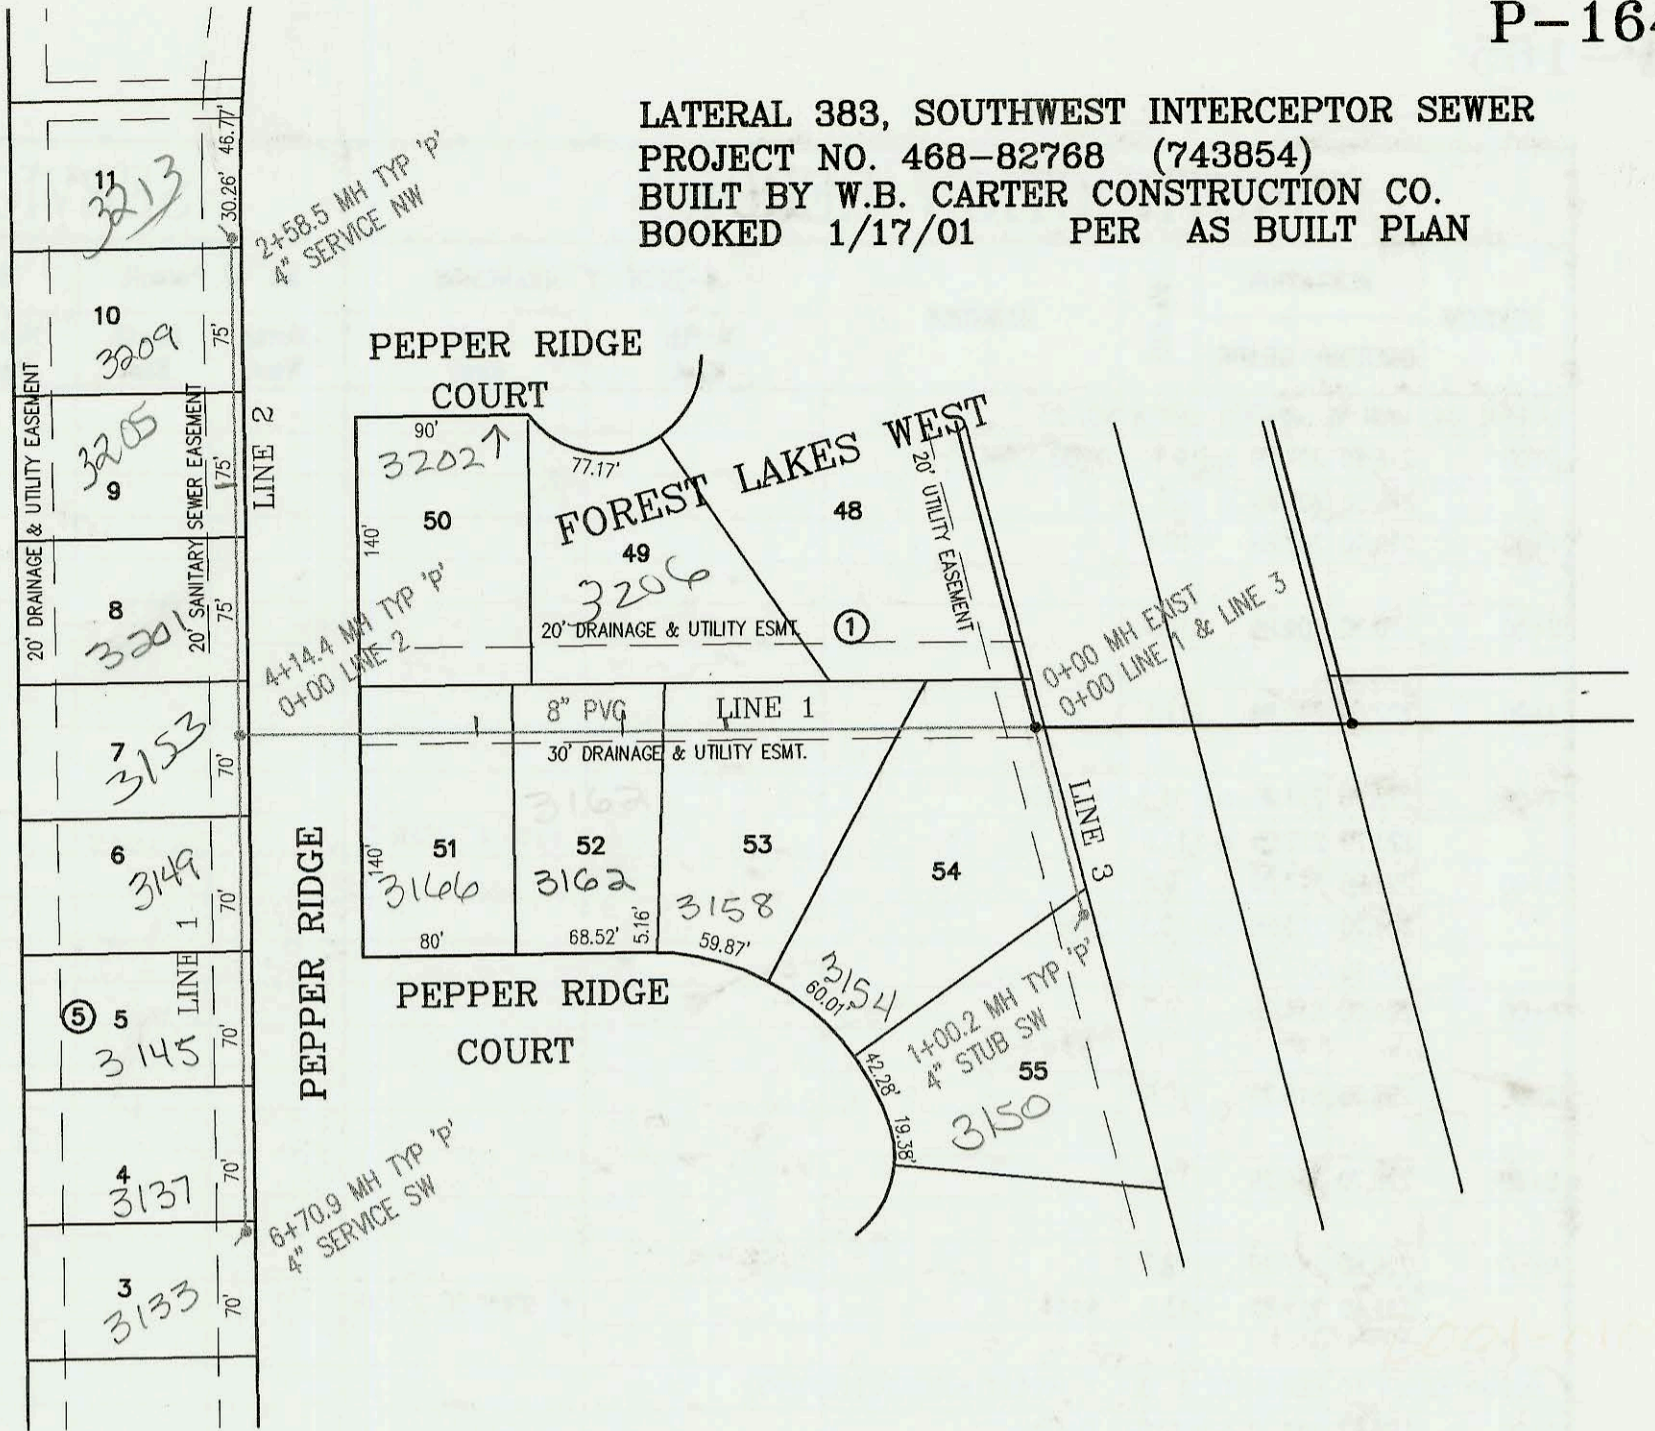

SCALE: 1" = 100'


LATERAL 461, SOUTHWEST INTERCEPTOR SEWER  
PROJECT NO. 468-83147 (743850)  
BUILT BY W.B. CARTER CONSTRUCTION CO.  
BOOKED 1/17/01 PER PLAN

*abandoned  
P84*

*Central Park  
ct.*

*11207*

*V. Hinas gave  
permission to  
TOP N. of  
MH 7409  
and abandon  
city line 3-11  
book P-84  
8/11/01  
ASB*

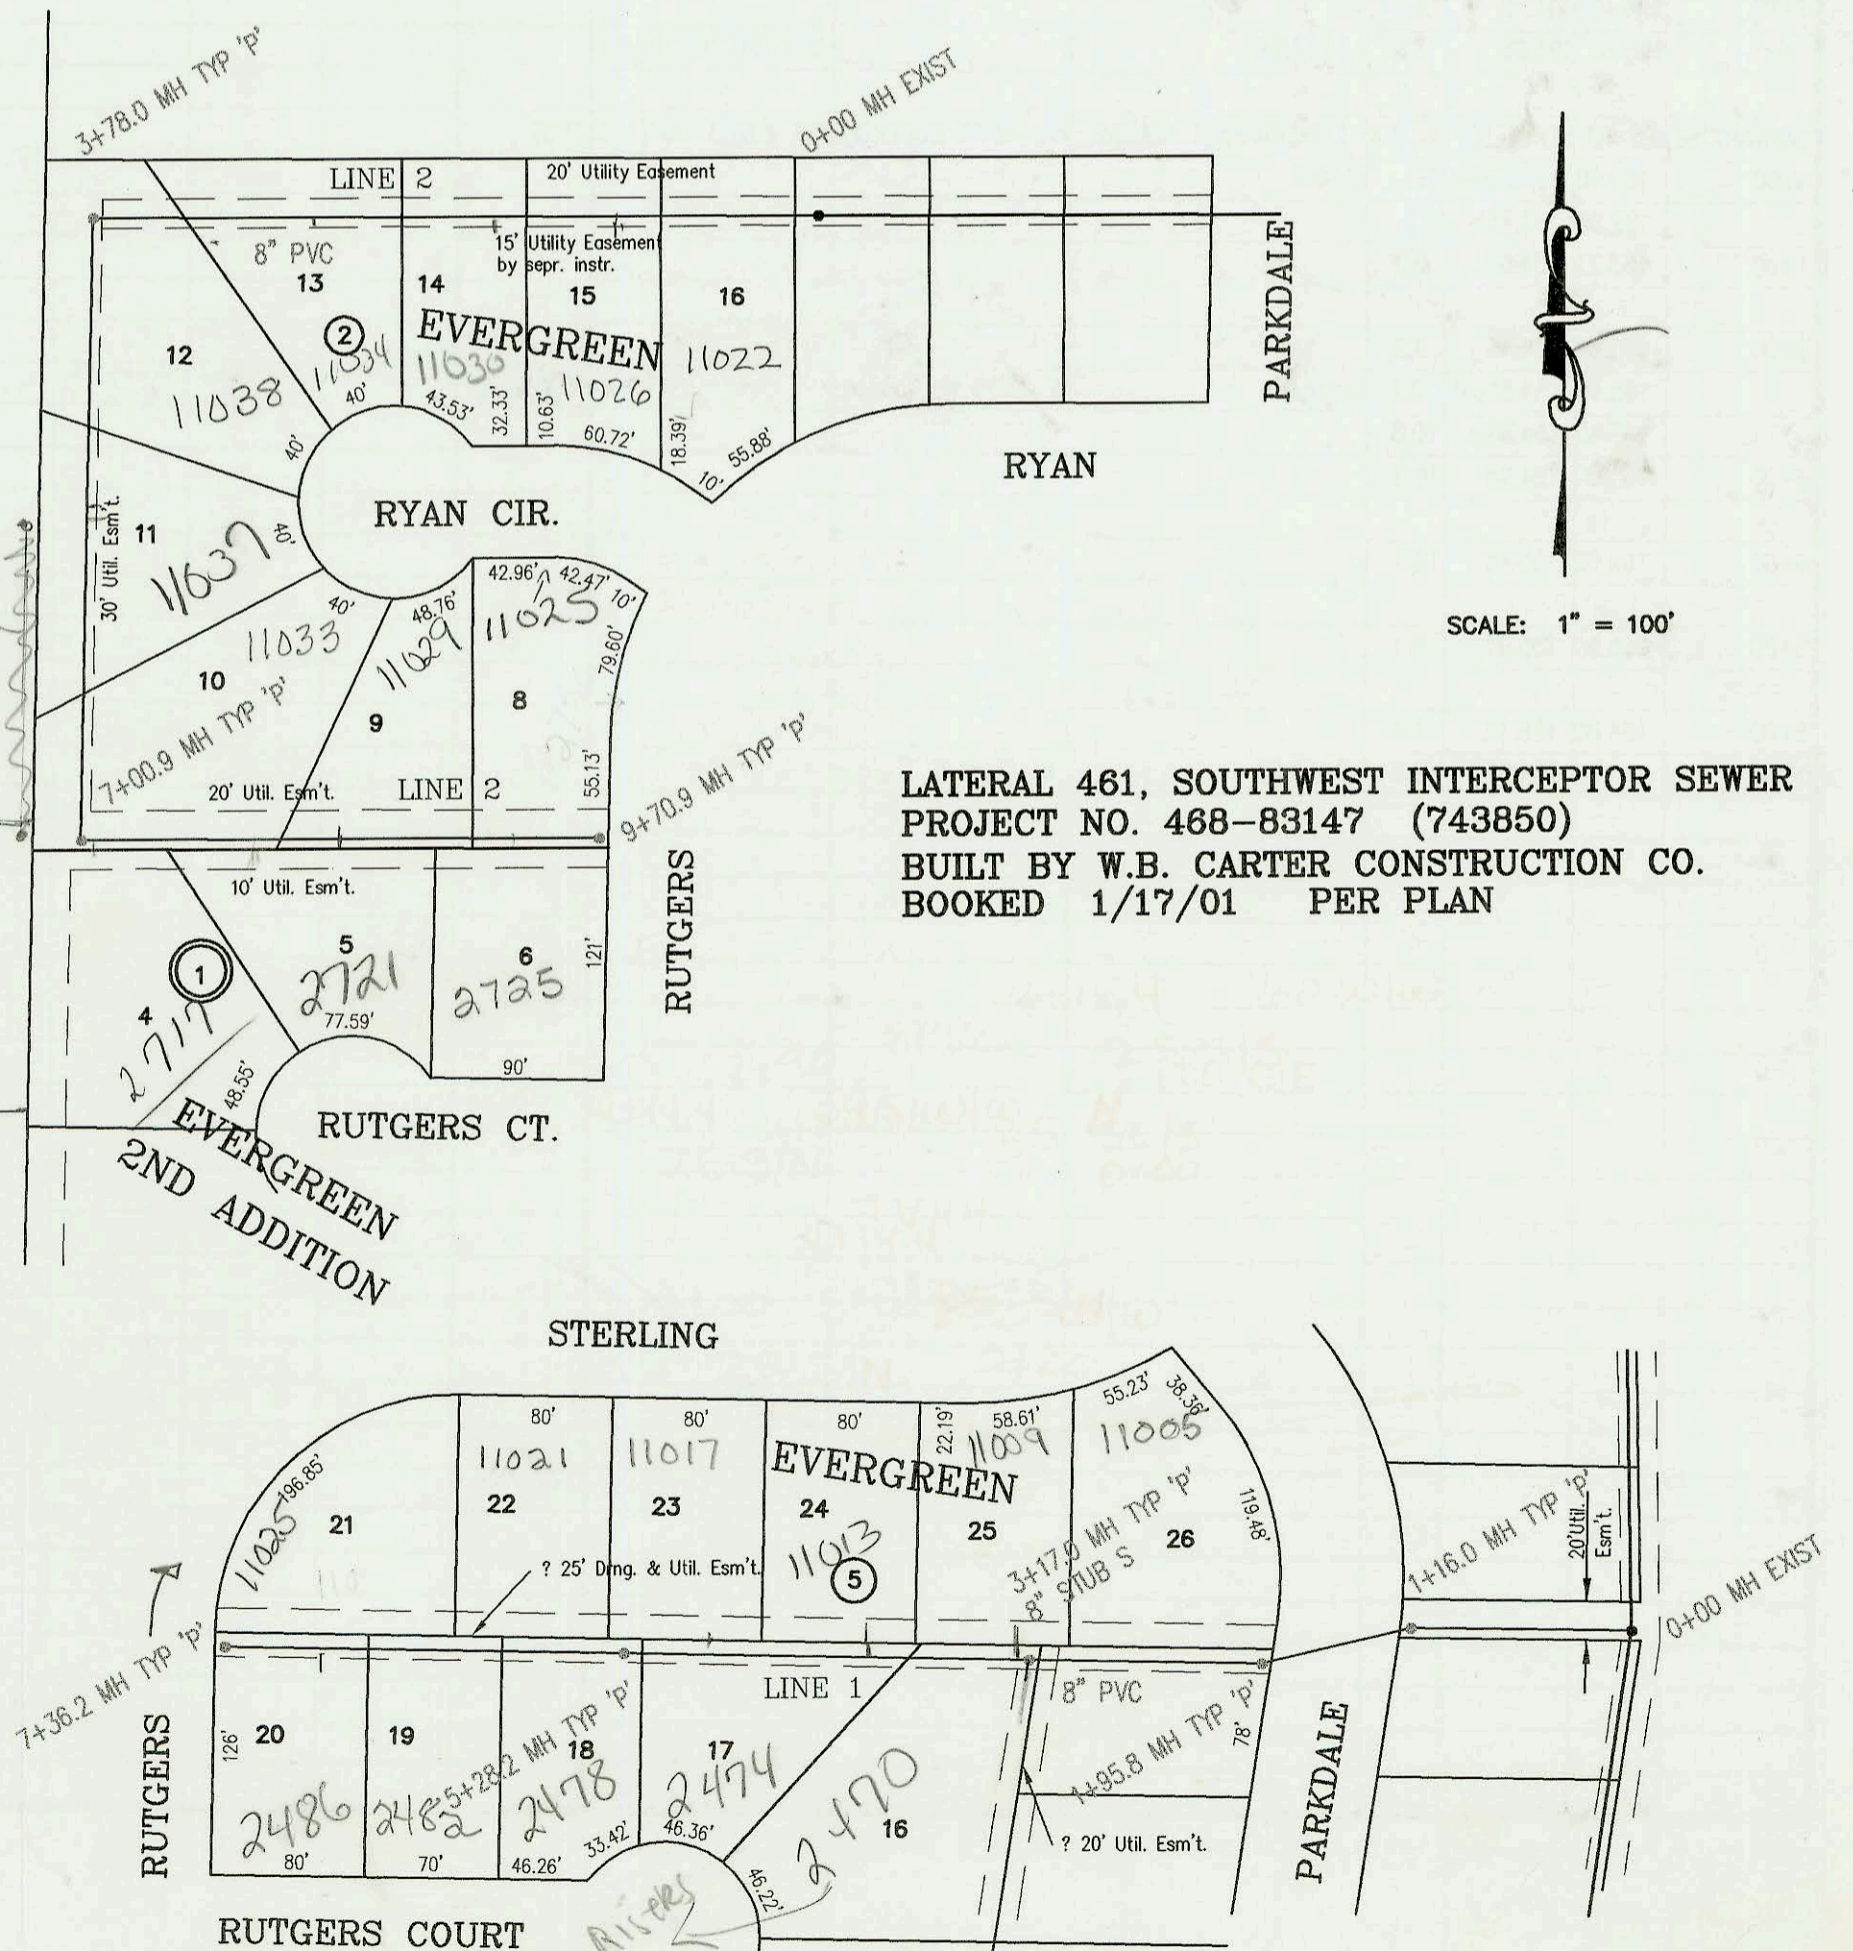

*Two pipes  
above  
line 1  
are on  
MISLINE*

