


LATERAL 64, MAIN 9, SANITARY SEWER NO. 23
PROJECT NO. 468-83053 (743852)
BUILT BY NOWAK CONSTRUCTION CO.
BOOKED 1/23/01 PER AS BUILT PLAN


37TH ST. N.



SCALE: 1" = 100'

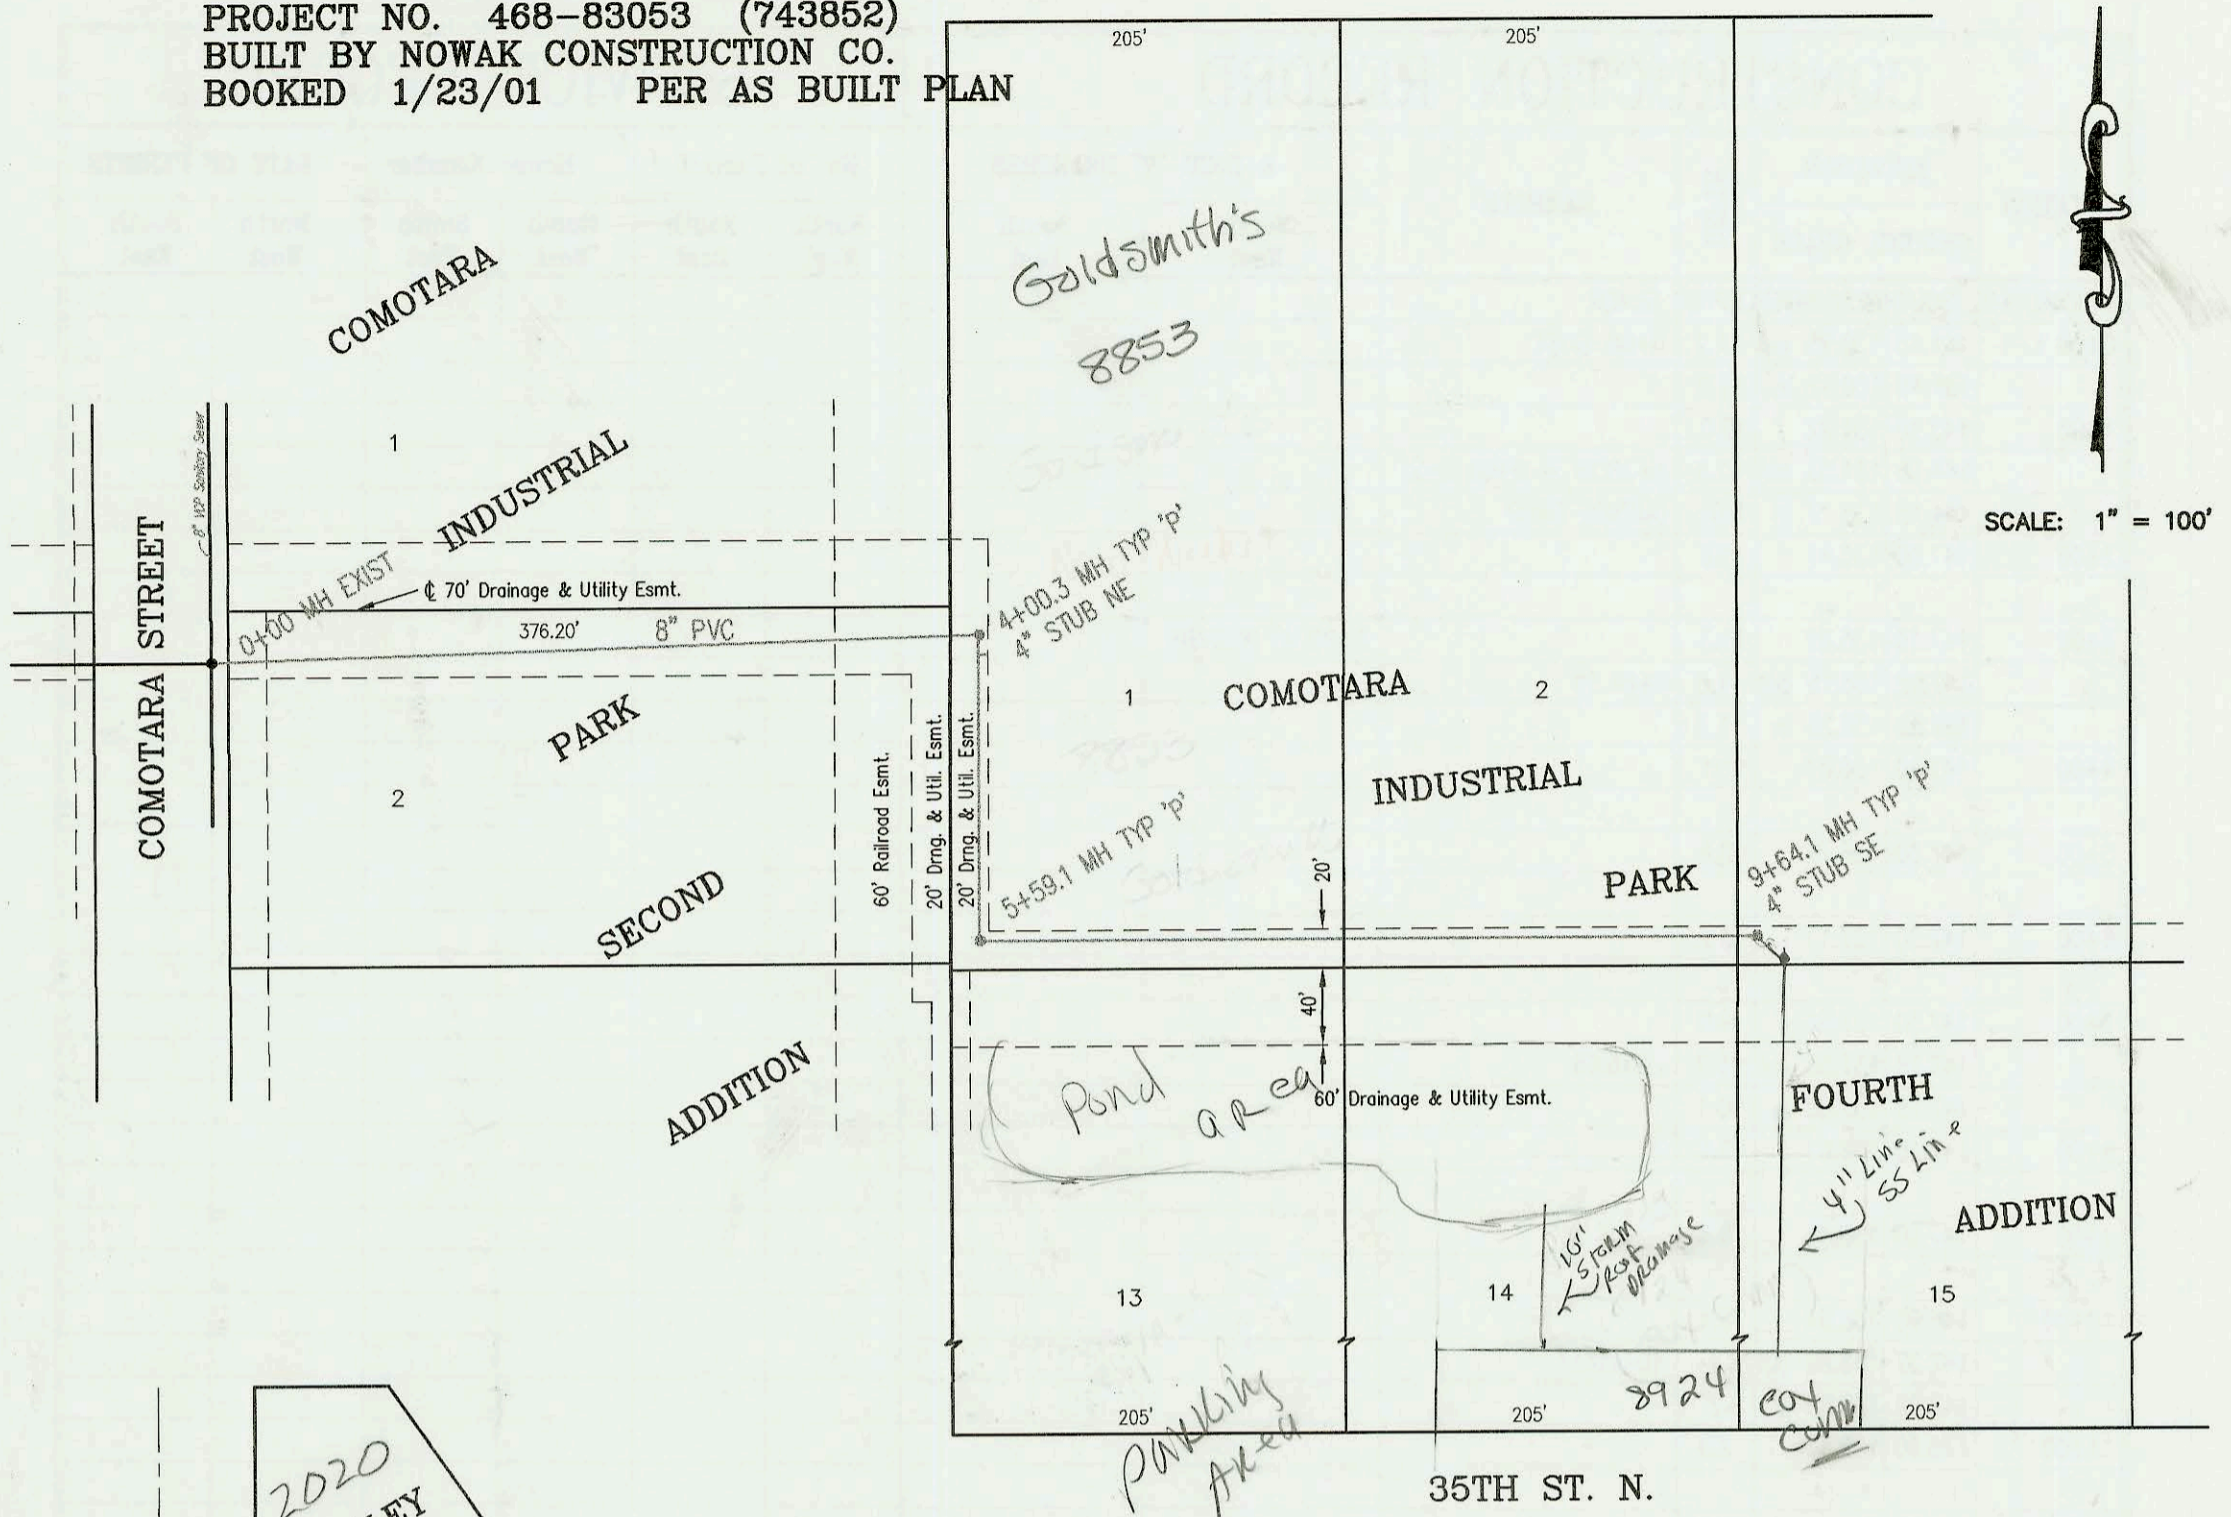

SCALE: 1" = 100'

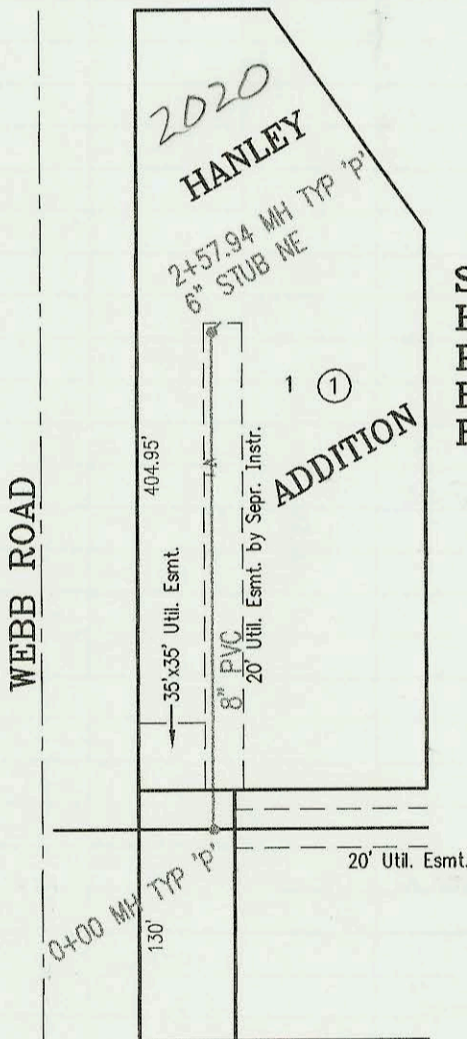


SANITARY SEWER TO SERVE LOT 1, BLK 1
HANLEY ADDITION
PROJECT NO. 1059PPS
BUILT BY McCULLOUGH EXCAVATION
BOOKED 2/14/01 PER AS BUILT PLAN

19TH ST. N.



SCALE: 1" = 150'

SANITARY SEWER TO SERVE LOT 1, BLK 1
NEWMARKET SQUARE ADDITION
WAL-MART SUPERCENTER #3283-00
PROJECT NO. 1085PPS
BUILT BY W.B. CARTER CONSTRUCTION
BOOKED 2/14/01 PER AS BUILT PLAN

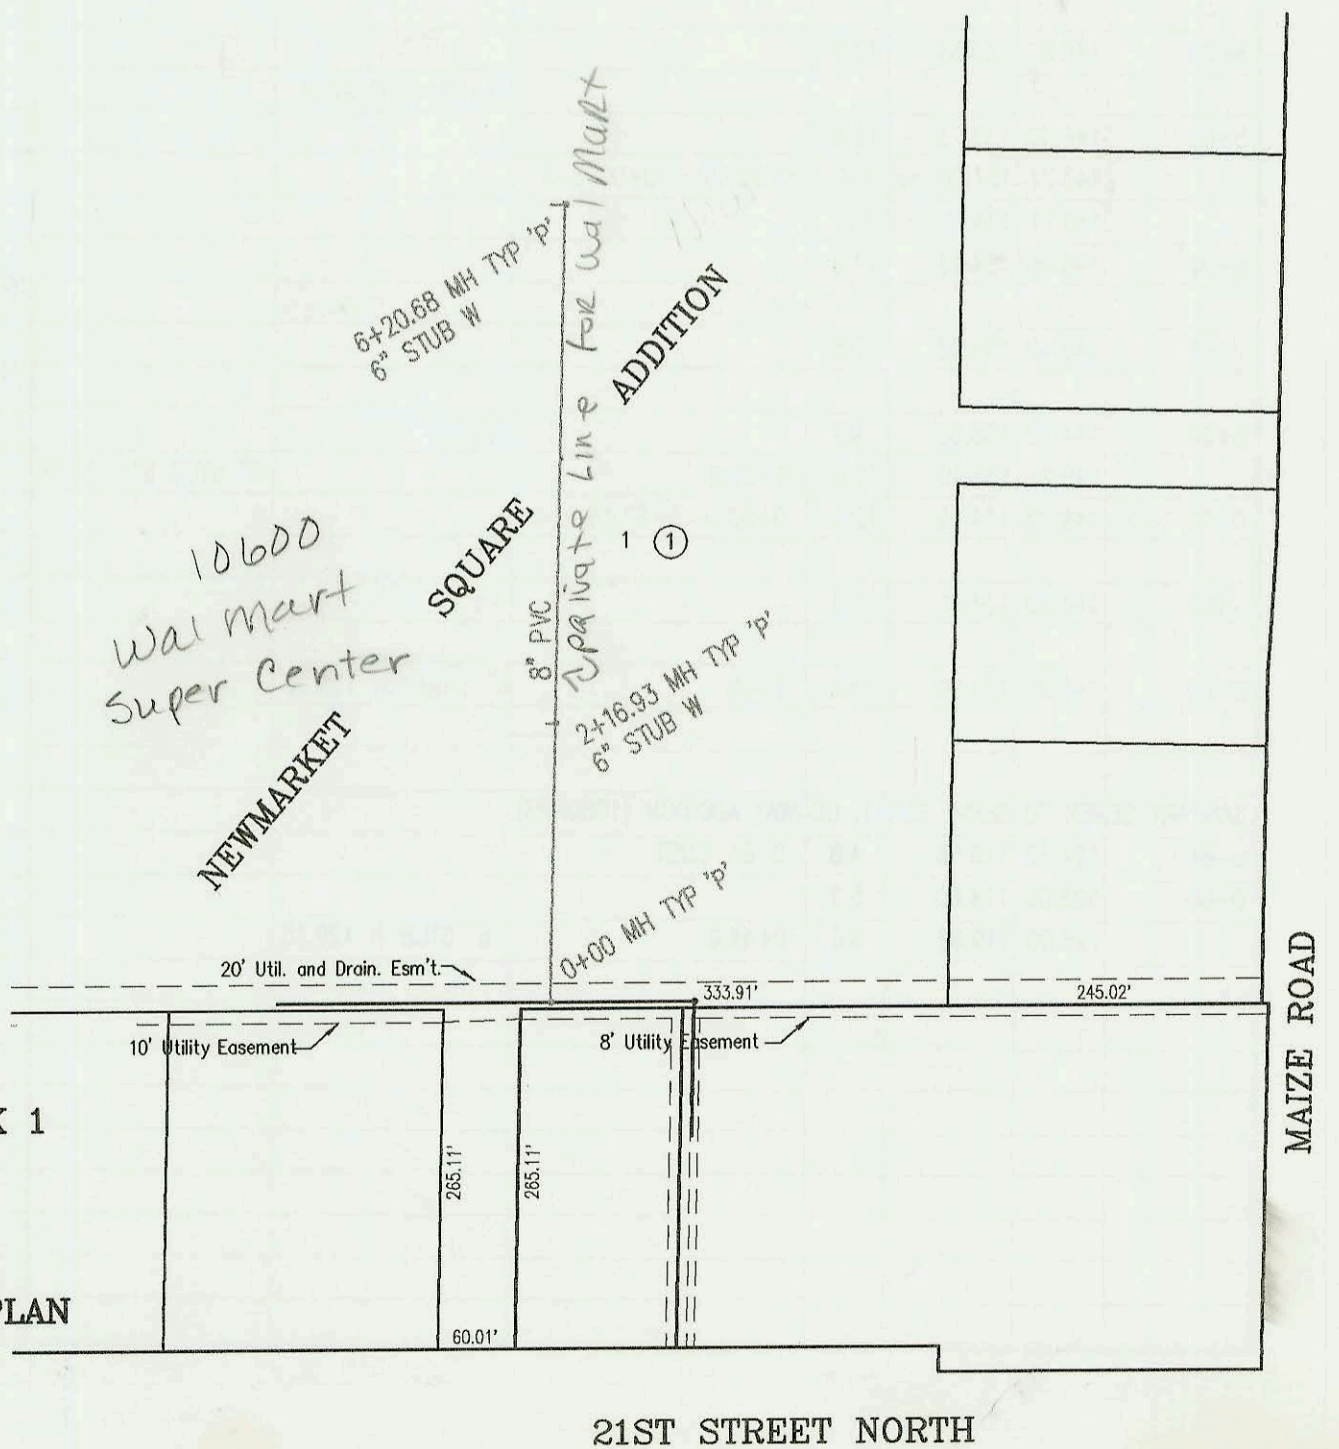

21ST STREET NORTH

MAIZE ROAD

CONSTRUCTION RECORD					SERVICE RECORD							
STATION	ELEVATION		DEPTH	MANHOLE	4-INCH "Y" BRANCHES		No. of Permit		House Number		DATE OF PERMITS	
	GROUND	GRADE			North West	South East	North West	South East	North West	South East	North West	South East
LATERAL 64,	MAIN 9,	SANITARY SEWER		NO. 23								
0+00	216.80	207.69 out	9.1	0+00 EXIST								
	216.80	207.89 in	8.9									
1+00	219.00	208.89	10.1									
2+00	220.30	209.89	10.4									
3+00	222.00	210.89	11.1									
4+00	223.70	211.89 out	11.8	4+00.3								
	223.70	212.09 in	11.6		4+10 4" RISER E		2000-02505		8858 E 5TH ST N		11-16-00	
5+00	222.90	213.09	9.8									
	224.10	213.58 out	10.5	5+59.1								
	224.10	213.78 in	10.3									
6+00	224.00	214.29	9.7									
7+00	225.30	215.29	10.0									
8+00	226.70	216.29	10.4									
9+00	229.60	217.29	12.3									
	231.40	217.83	13.6	9+64.1		4" STUB SE 218.16						
SANITARY SEWER TO SERVE LOT 1, BLK 1, HANLEY ADDITION (1059PPS)												
0+00	196.52	184.50 out	12.0	0+00								
	196.52	186.50 in	10.0		4" SCH 40 PVC 1+87.94 Saddle		2001-00301		2020 W 21ST N # 200		2-12-01	
1+00	196.40	189.04	7.4		4" SCH 40 PVC 1+97.94 Saddle		2001-00302		2020 W 21ST N # 300		2-12-01	
2+00	196.40	191.58	4.8									
	196.68	193.05	3.6	2+57.94		6" STUB NE 193.15						
SANITARY SEWER TO SERVE LOT 1, BLK 1, NEWMARKET SQUARE, WAL-MART SUPERCENTER #3283-00 (1085PPS)												
0+00	162.90	153.36 out	9.5	0+00								
	162.90	153.71 in	9.2									
1+00	163.27	154.08	9.2									
2+00	163.64	154.45	9.2									
	165.40	154.51 out	10.9	2+16.93	6" STUB W SCH 40		2001-00331		10600 W 21ST N WalMart # 2		2-15-01	
	165.40	154.58 in	10.8									
3+00	165.80	154.98	10.8									
4+00	165.60	155.46	10.1									
5+00	165.30	155.94	9.4									
6+00	164.80	156.42	8.4									
	164.78	156.51	8.3	6+20.68	6" STUB W SCH 40		2001-00330		10600 W 21ST N WalMart # 1		2-15-01	

SMR 2001-02577 11/27/00 10600 W 21ST - WalMart - tri state o/hg - 2 grease intd and one mud+oil sep.