



37TH ST. N.

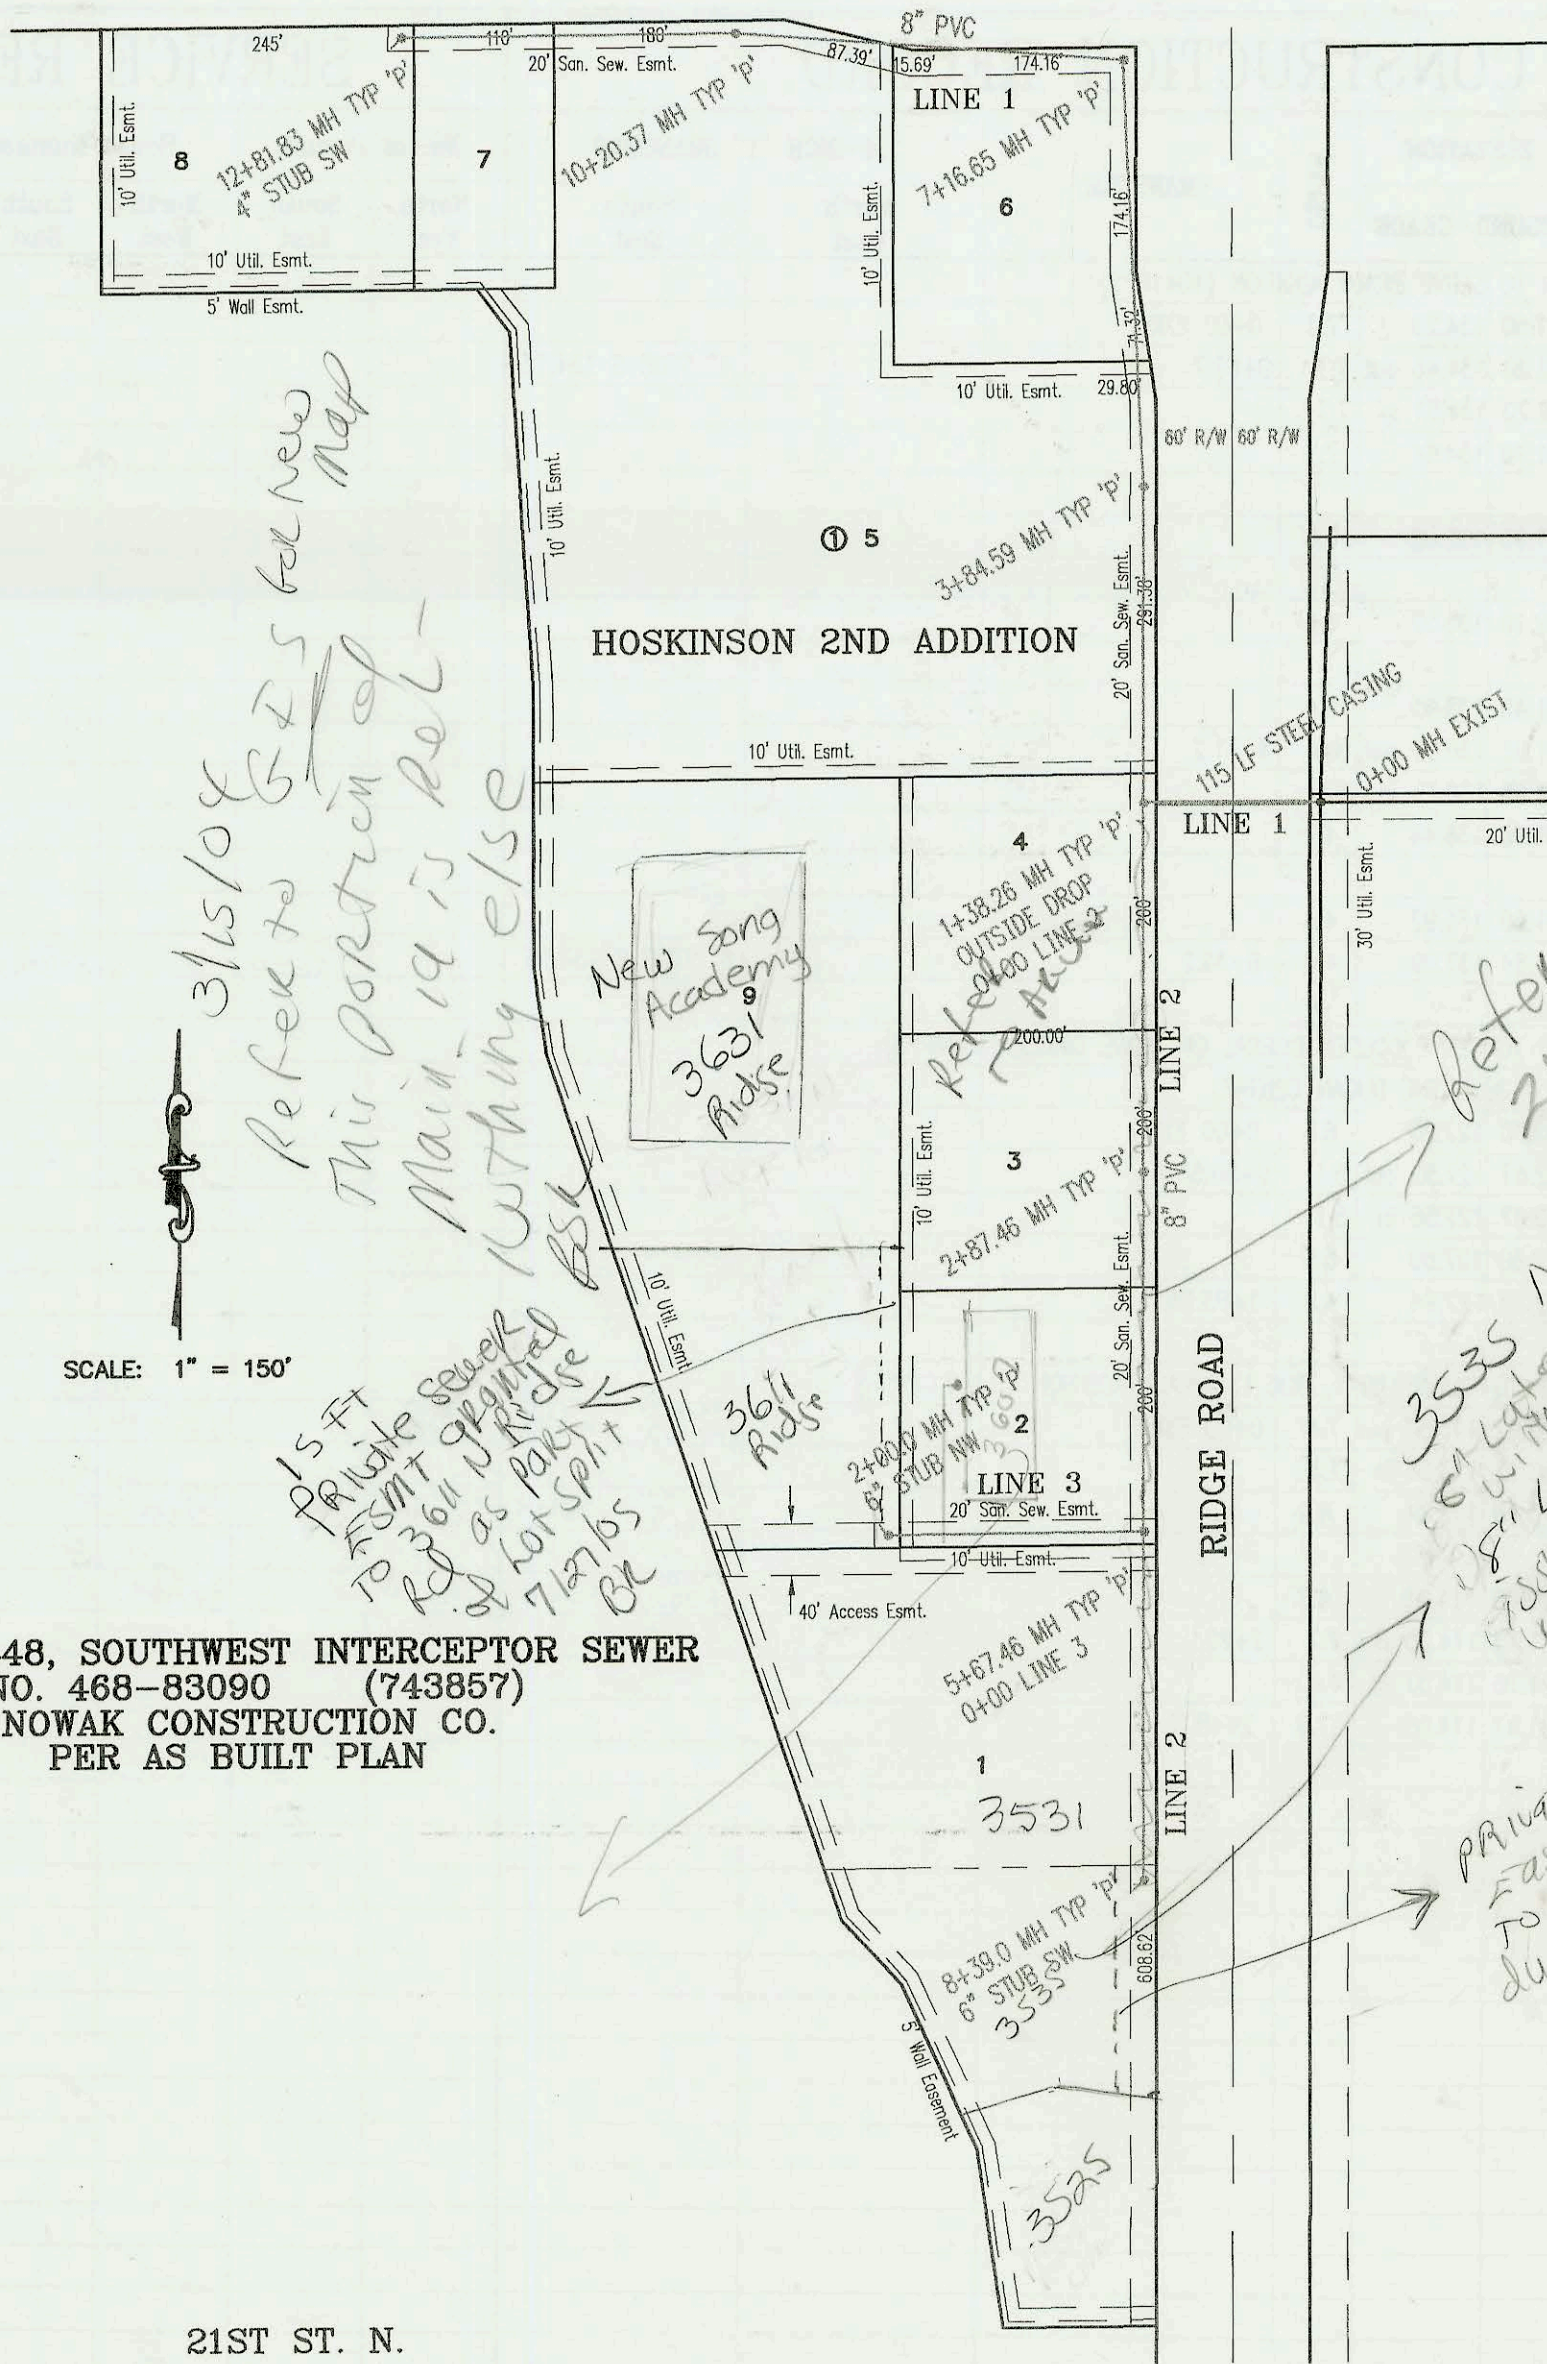

LATERAL 448, SOUTHWEST INTERCEPTOR SEWER  
 PROJECT NO. 468-83090 (743857)  
 BUILT BY NOWAK CONSTRUCTION CO.  
 2/12/01 PER AS BUILT PLAN

21ST ST. N.

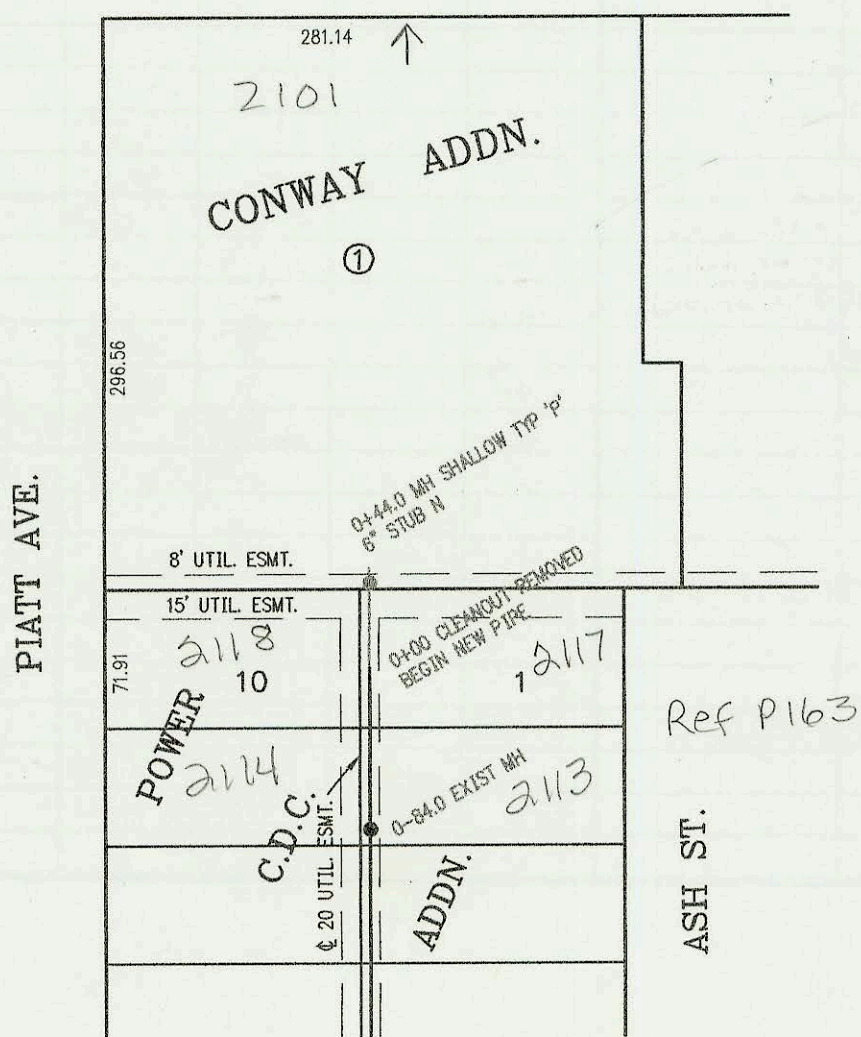

SANITARY SEWER TO SERVE  
 BLOCK 1, CONWAY ADDITION  
 PROJECT NO. 1080PPS  
 BUILT BY McCULLOUGH EXCAVATION  
 BOOKED 3/16/01 PER AS BUILT PLAN

CONSTRUCTION RECORD						SERVICE RECORD						
STATION	ELEVATION		DEPTH	MANHOLE	4-INCH "Y" BRANCHES		No. of Permit		House Number		DATE OF PERMITS	
	GROUND	GRADE			North West	South East	North West	South East	North West	South East	North West	South East
LATERAL 448, SOUTHWEST INTERCEPTOR SEWER												
0+00 L-1	141.45	130.25 out	11.2	0+00 EXIST								
	141.45	130.42 in	11.0									
1+00	143.20	131.22	12.0									
	144.15	131.53 out	12.6	1+38.26 = 0+00 L-2								
	144.15	135.17 in	9.0	OUTSIDE DROP								
2+00	147.00	135.41	11.6									
3+00	147.10	135.81	11.3		3+20 4" W 8V9H							
	147.92	136.15 out	11.8	3+84.59								
	147.92	136.25 in	11.7									
4+00	147.40	136.31	11.1									
5+00	147.30	136.71	10.6									
6+00	147.30	137.11	10.2									
7+00	147.30	137.51	9.8									
	147.78	137.58 out	10.2	7+16.65								
	147.78	137.68 in	10.1									
8+00	147.10	138.01	9.1									
9+00	147.00	138.41	8.6									
10+00	146.90	138.81	8.1									
	147.22	138.89 out	8.3	10+20.37								
	147.22	138.99 in	8.2									
11+00	146.60	139.31	7.3									
12+00	146.20	139.71	6.5									
	146.44	140.04	6.4	12+81.83		4" STUB SW 140.37						
0+00 L-2	144.15	131.63	12.5	0+00 = 1+38.26 L-1								
					0+78 4" W 11V9H							
1+00	146.80	132.03	14.8									
2+00	146.70	132.43	14.3		2+78 4" W 10V9H							
	147.14	132.78 out	14.4	2+87.46								
	147.14	132.88 in	14.3									
3+00	146.60	132.93	13.7									
4+00	146.50	133.33	13.2									
					4+78 4" W 9V9H							
5+00	146.30	133.73	12.6									
	143.71	134.00 out	9.7	5+67.46 = 0+00 L-3								
	143.71	134.10 in	9.6									
6+00	146.00	134.23	11.8									
7+00	145.40	134.63	10.8									
8+00	144.70	135.03	9.7		4" SCH 40 8+13		2006-00381 2001-00346	3611 Ridge 3531 N Ridge		1-15-06 2-27-01		
	145.21	135.19	10.0	8+39.0		6" STUB SW 135.36						
0+00 L-3	143.71	134.10	9.6	0+00 = 5+67.46 L-2								
					1+15 4" SCH 40 1+13		2001-00381	3607 Ridge				
1+00	145.80	134.50	11.3									
					4" SCH 40 1+13		2001-00319	3621 N Ridge				
2+00	145.87	134.90	11.0	2+00		6" STUB NW 135.07				2-13-01		
SANITARY SEWER TO SERVE BLK 1, CONWAY ADDITION (1080PPS)												
0-84	124.32	119.56	4.8	0-84 EXIST			2001-01795	2001-01793	214 N PIATT	2113 N ASH	7-18-01	7-18-01
0+00	125.00	119.80	5.2				2001-01794	2001-01792	2118 N PIATT	2117 N ASH	7-18-01	7-18-01
	126.00	119.98	6.0	0+44.0		6" STUB N 120.15	2001-00386		2101 E 21ST N		2-21-01	