



**SANITARY SEWER TO SERVE BRADY ADDITION**  
**PROJECT NO. 1041PPS**  
**BUILT BY MIES CONSTRUCTION CO.**  
**3/19/01 PER AS BUILT PLAN**

SCALE: 1" = 150'

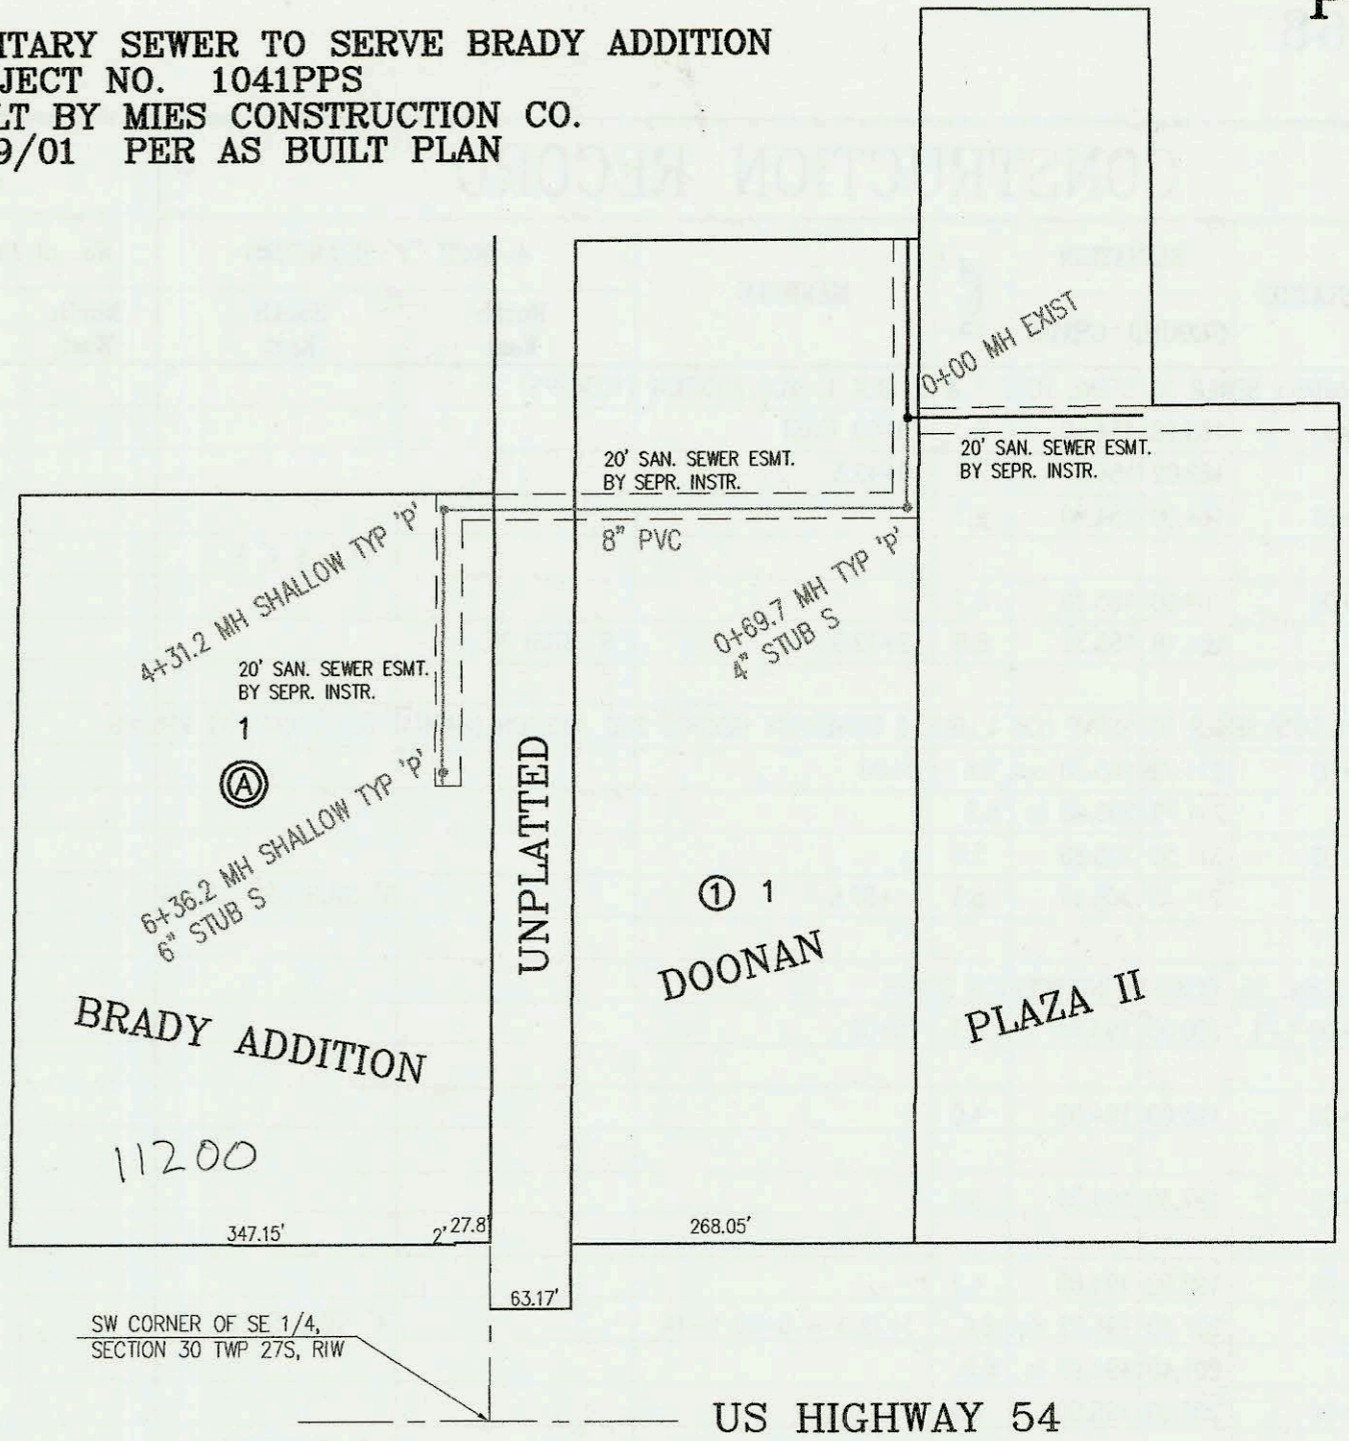


**SANITARY SEWER TO SERVE GOLDEN CORRAL ON RIDGE CIRCLE (PART OF LOTS 1 & 2 THE DUGAN CENTRE)**  
**PROJECT NO. 1004PPS**  
**BUILT BY McCULLOUGH EXCAVATION**  
**3/20/01 PER AS BUILT PLAN**

SCALE: 1" = 150'

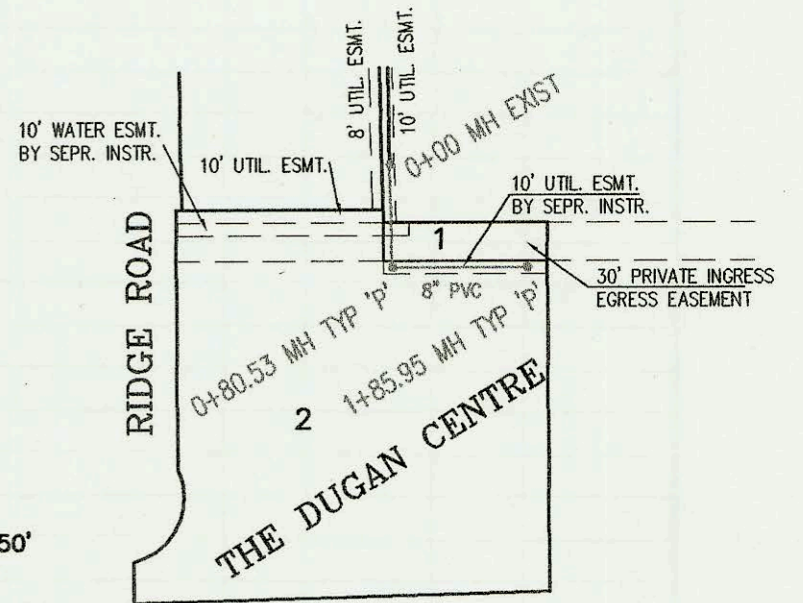

**SANITARY SEWER TO SERVE LOT 1, BLK A, DePAUL ADDITION**  
**PROJECT NO. 1082PPS**  
**BUILT BY W.B. CARTER CONSTRUCTION CO.**  
**BOOKED 3/21/01 PER AS BUILT PLAN**

SCALE: 1" = 100'

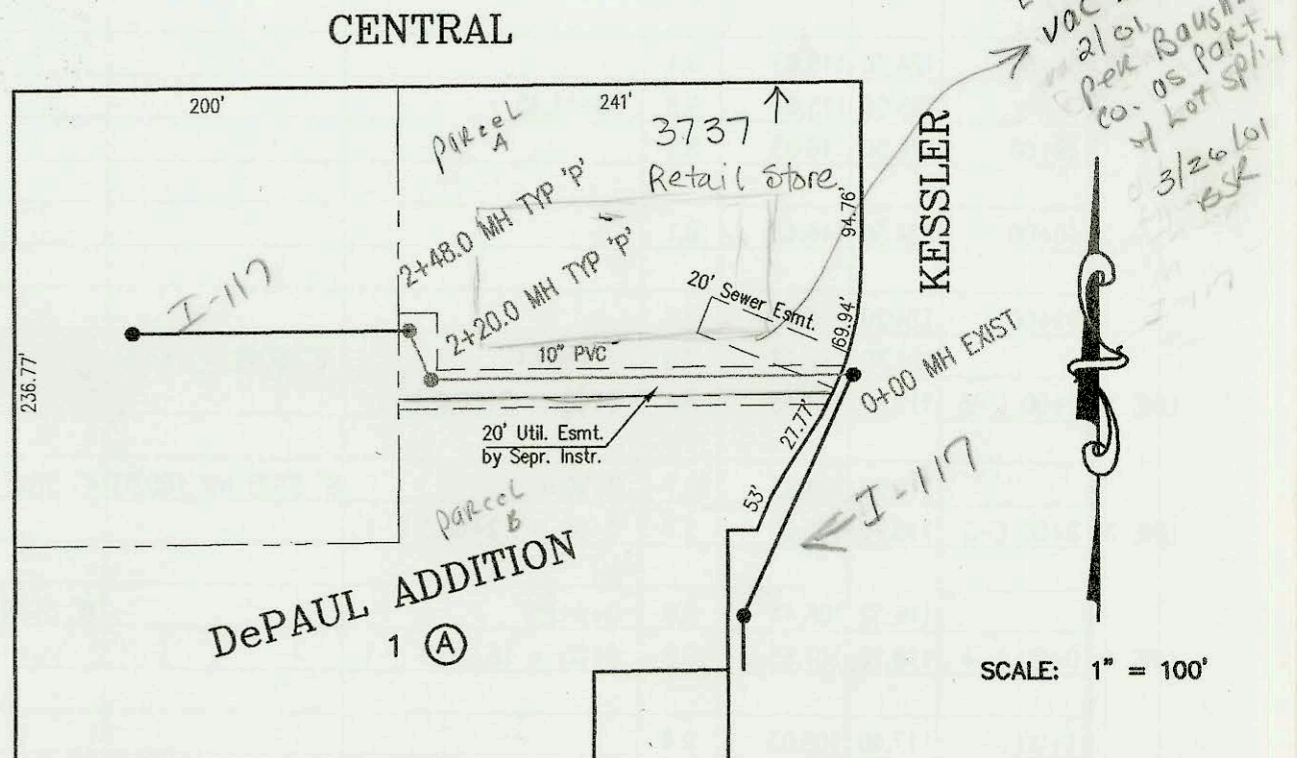

CONSTRUCTION RECORD					SERVICE RECORD							
STATION	ELEVATION		DEPTH	MANHOLE	4-INCH "Y" BRANCHES		No. of Permit		House Number		DATE OF PERMITS	
	GROUND	GRADE			North West	South East	North West	South East	North West	South East	North West	South East
SANITARY SEWER TO SERVE BRADY ADDITION (1041PPS)												
0+00	141.50	134.23	7.3	0+00 EXIST								
	142.20	134.46 out	7.7	0+69.7		4" STUB S 134.73						
	142.20	134.51 in	7.7									
1+00	141.70	134.64	7.1									
2+00	141.90	135.08	6.8									
3+00	142.10	135.52	6.6									
4+00	141.40	135.95	5.4									
	141.65	136.09 out	5.6	4+31.2								
	141.65	136.11 in	5.5									
5+00	141.10	136.44	4.7									
6+00	141.60	136.92	4.7									
	141.84	137.09	4.8	6+36.2		6" STUB S 137.15		2000-021650	11200 W Kellogg	Brady Mystery	12-4-00	
SANITARY SEWER TO SERVE GOLDEN CORRAL ON RIDGE CIRCLE (1004PPS) (PART OF LOTS 1 & 2, THE DUGAN CENTRE)												
0+00	133.70	127.20	6.5	0+00 EXIST								
	132.67	127.52 out	5.1	0+80.53								
	132.67	127.56 in	5.1									
1+00	132.60	127.60	5.0									
	132.75	127.94	4.8	1+85.95								
SANITARY SEWER TO SERVE LOT 1, BLK 1, DePAUL ADDITION (1082PPS)												
0+00	120.92	113.57 out	7.4	0+00 EXIST		4" sch 40 1+1.2 saddle	2005-00733		3737 suite central 100		4-18-01	
	120.92	113.66 in	7.3									
1+00	120.70	113.84	6.9			4" sch 40 1+56.8 saddle	2005-00935		3737 suite central 200		4-18-01	
2+00	120.70	114.01	6.7			4" sch 40 1+99.4 saddle	2005-00936		3737 suite central 300		4-18-01	
	121.70	114.05 out	7.7	2+20.0								
	121.70	114.07 in	7.6									
	121.97	114.05	7.9	2+48.0								