



K-42  
will also require payment of 5% fee plus already BR

OWNER: CESSNA AIRCRAFT CO.  
UNPLATTED

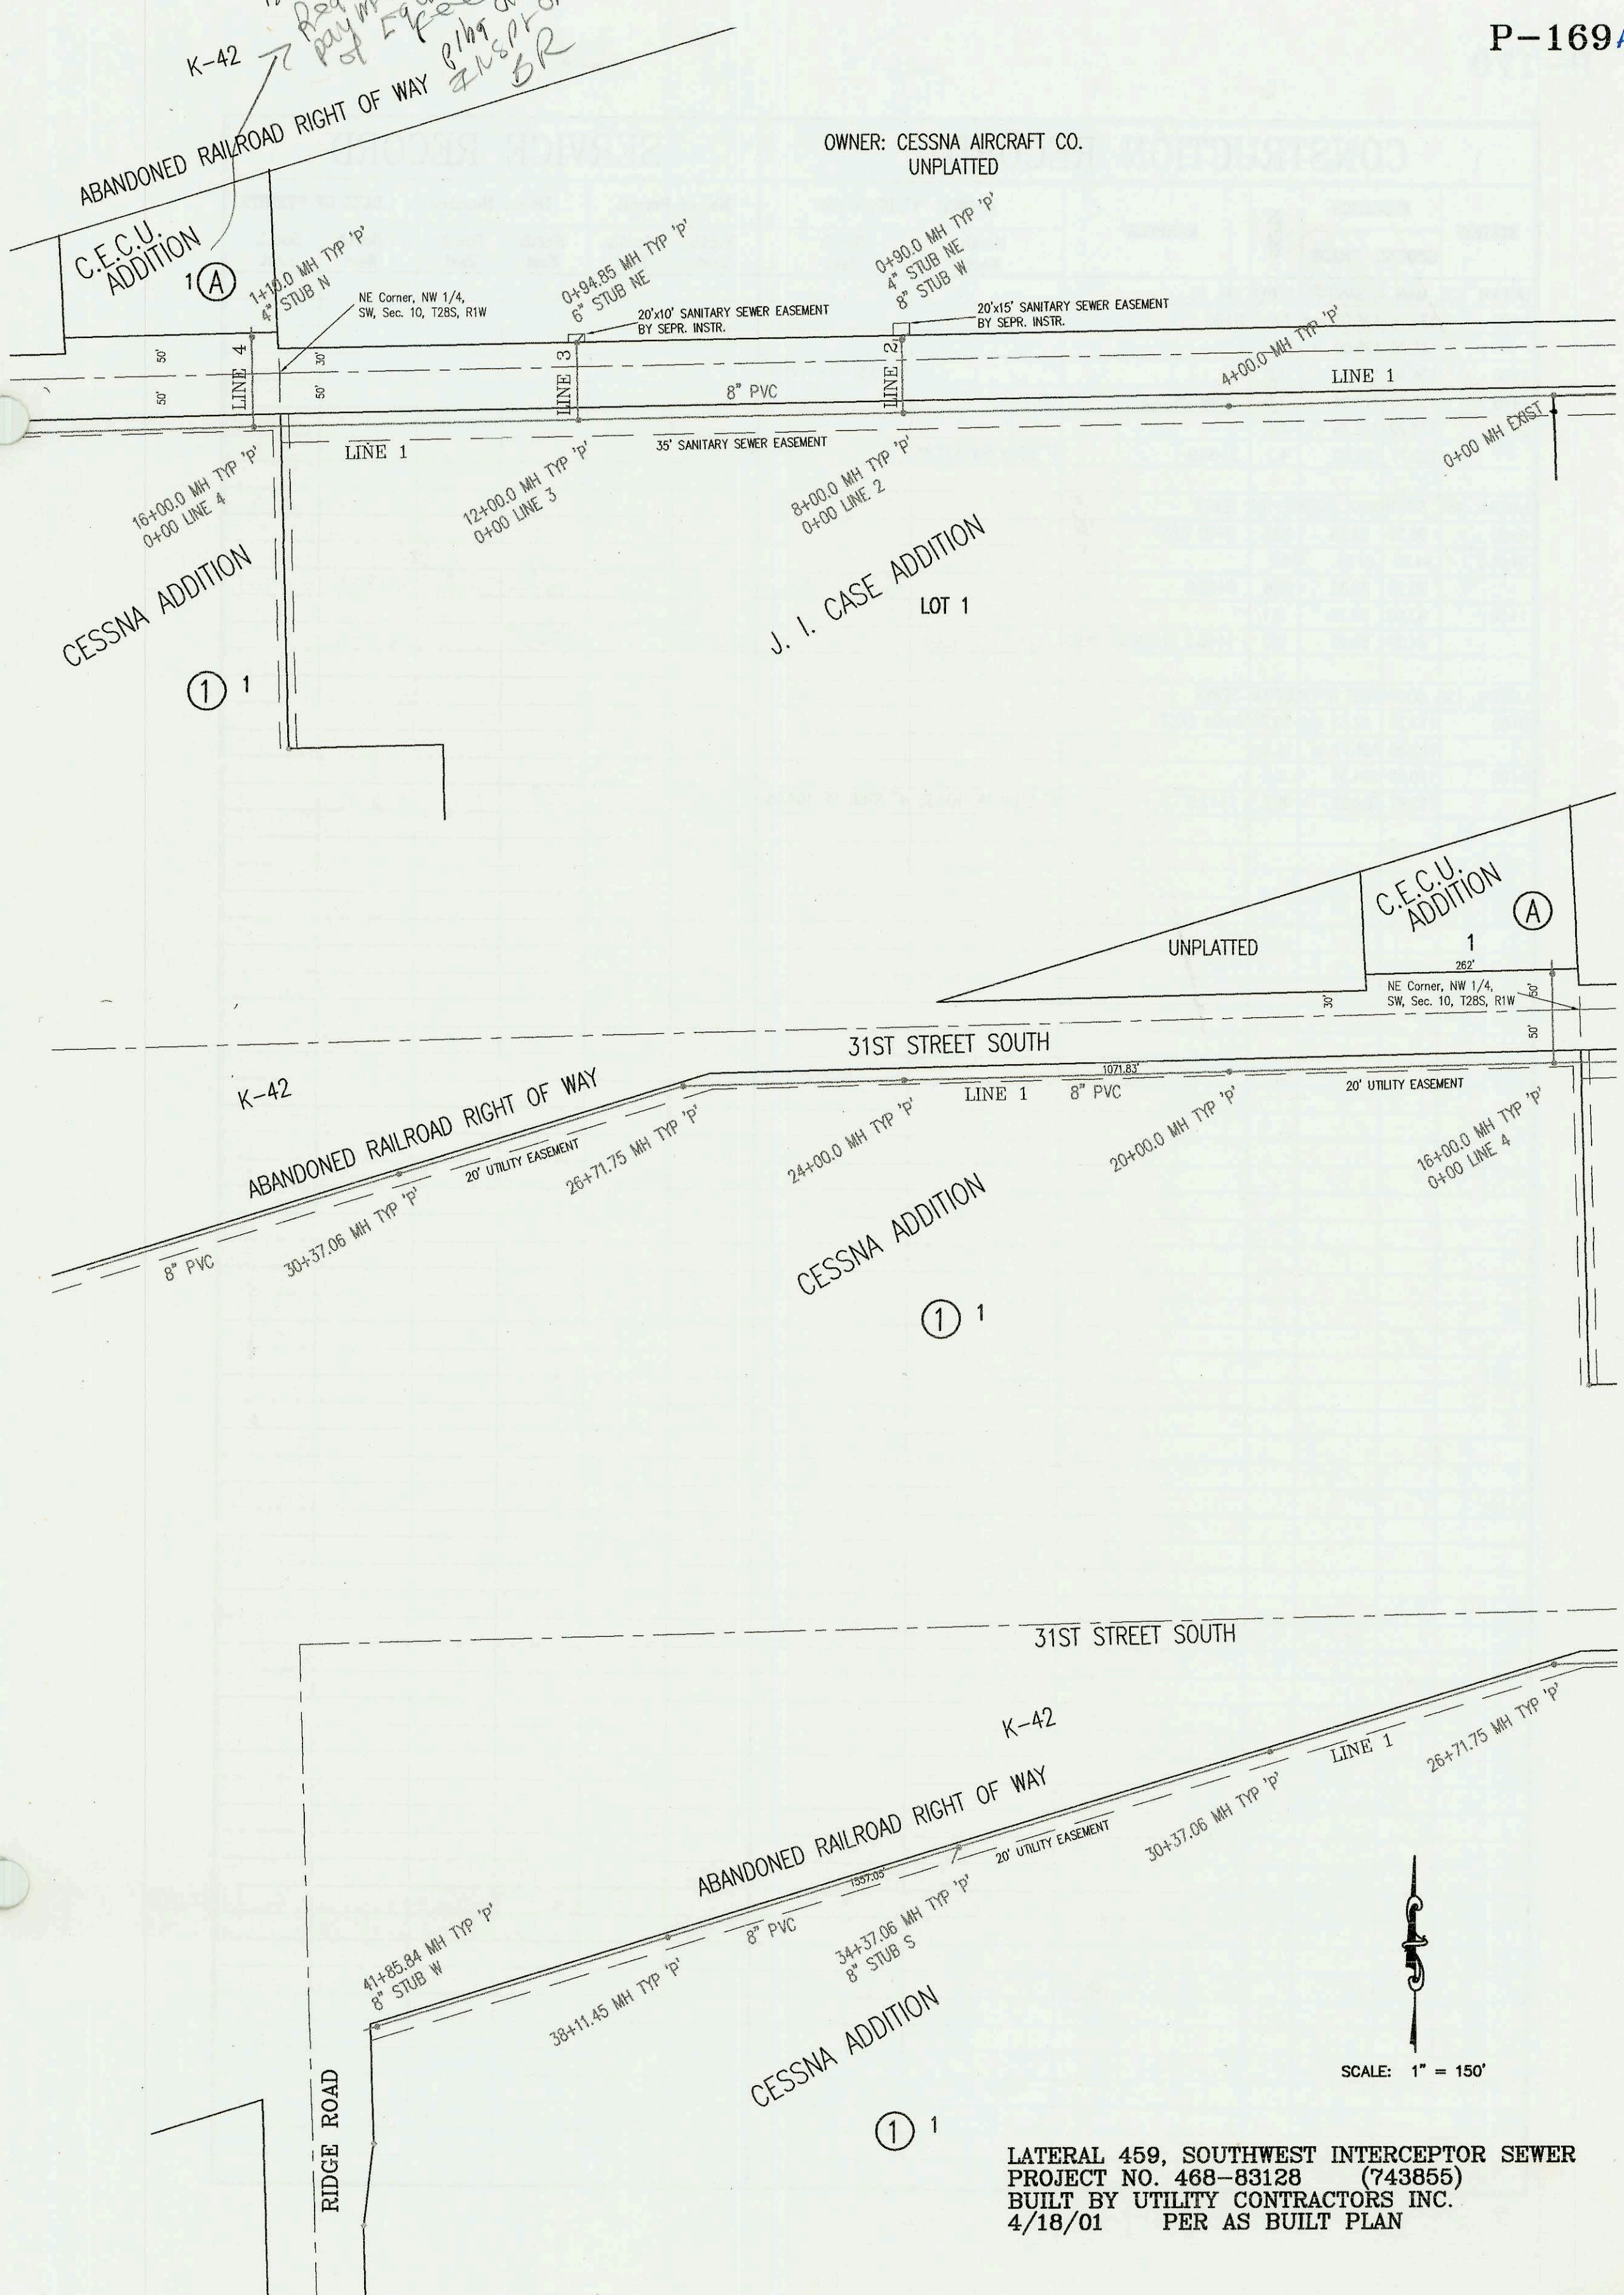

LATERAL 459, SOUTHWEST INTERCEPTOR SEWER  
PROJECT NO. 468-83128 (743855)  
BUILT BY UTILITY CONTRACTORS INC.  
4/18/01 PER AS BUILT PLAN

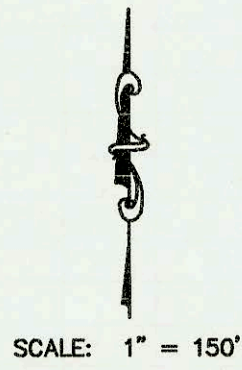

CONSTRUCTION RECORD						SERVICE RECORD						
STATION	ELEVATION		DEPTH	MANHOLE	4-INCH "Y" BRANCHES		No. of Permit		House Number		DATE OF PERMITS	
	GROUND	GRADE			North West	South East	North West	South East	North West	South East	North West	South East
LATERAL 459	SOUTHWEST INTERCEPTOR			SEWER								
LINE 1 0+00 L-1	110.30	100.45 out	9.8	0+00 EXIST								
	110.30	101.03 in	9.3									
1+00	110.20	101.43	8.8									
2+00	110.30	101.83	8.5									
3+00	110.30	102.23	8.1									
4+00	110.50	102.63	7.9	4+00.0								
5+00	110.40	103.03	7.4									
6+00	110.50	103.43	7.1									
7+00	110.50	103.83	6.7									
8+00	110.80	104.23	6.6	8+00.0 = 0+00 L-2								
9+00	110.50	104.63	5.9									
10+00	112.00	105.03	7.0									
11+00	114.50	105.43	9.1									
12+00	115.70	105.83	9.9	12+00.0 = 0+00 L-3								
13+00	117.00	106.23	10.8									
14+00	117.00	106.63	10.4									
15+00	117.50	107.03	10.5									
16+00	118.10	107.43	10.7	16+00.0 = 0+00 L-4								
17+00	117.90	107.83	10.1									
18+00	118.30	108.23	10.1									
19+00	118.90	108.63	10.3									
20+00	120.00	109.03	11.0	20+00.0								
21+00	120.30	109.43	10.9									
22+00	121.10	109.83	11.3									
23+00	121.80	110.23	11.6									
24+00	123.40	110.63	12.8	24+00.0								
25+00	124.00	111.03	13.0									
26+00	124.80	111.43	13.4									
	125.80	111.72 out	14.1	26+71.75								
	125.80	111.88 in	13.9									
27+00	126.40	111.96	14.4									
28+00	127.70	112.26	15.4									
29+00	128.00	112.56	15.4									
30+00	127.50	112.86	14.6									
	127.40	112.97	14.4	30+37.06								
31+00	126.60	113.16	13.4									
32+00	126.20	113.46	12.7									
33+00	125.60	113.76	11.8									
34+00	125.30	114.06	11.2									