



LATERAL 125, MAIN 4, SANITARY SEWER NO. 23  
PROJECT NO. 468-82272 (741447)  
BUILT BY W.B. CARTER CONSTRUCTION CO.  
BOOKED 4/26/01 PER AS BUILT PLAN

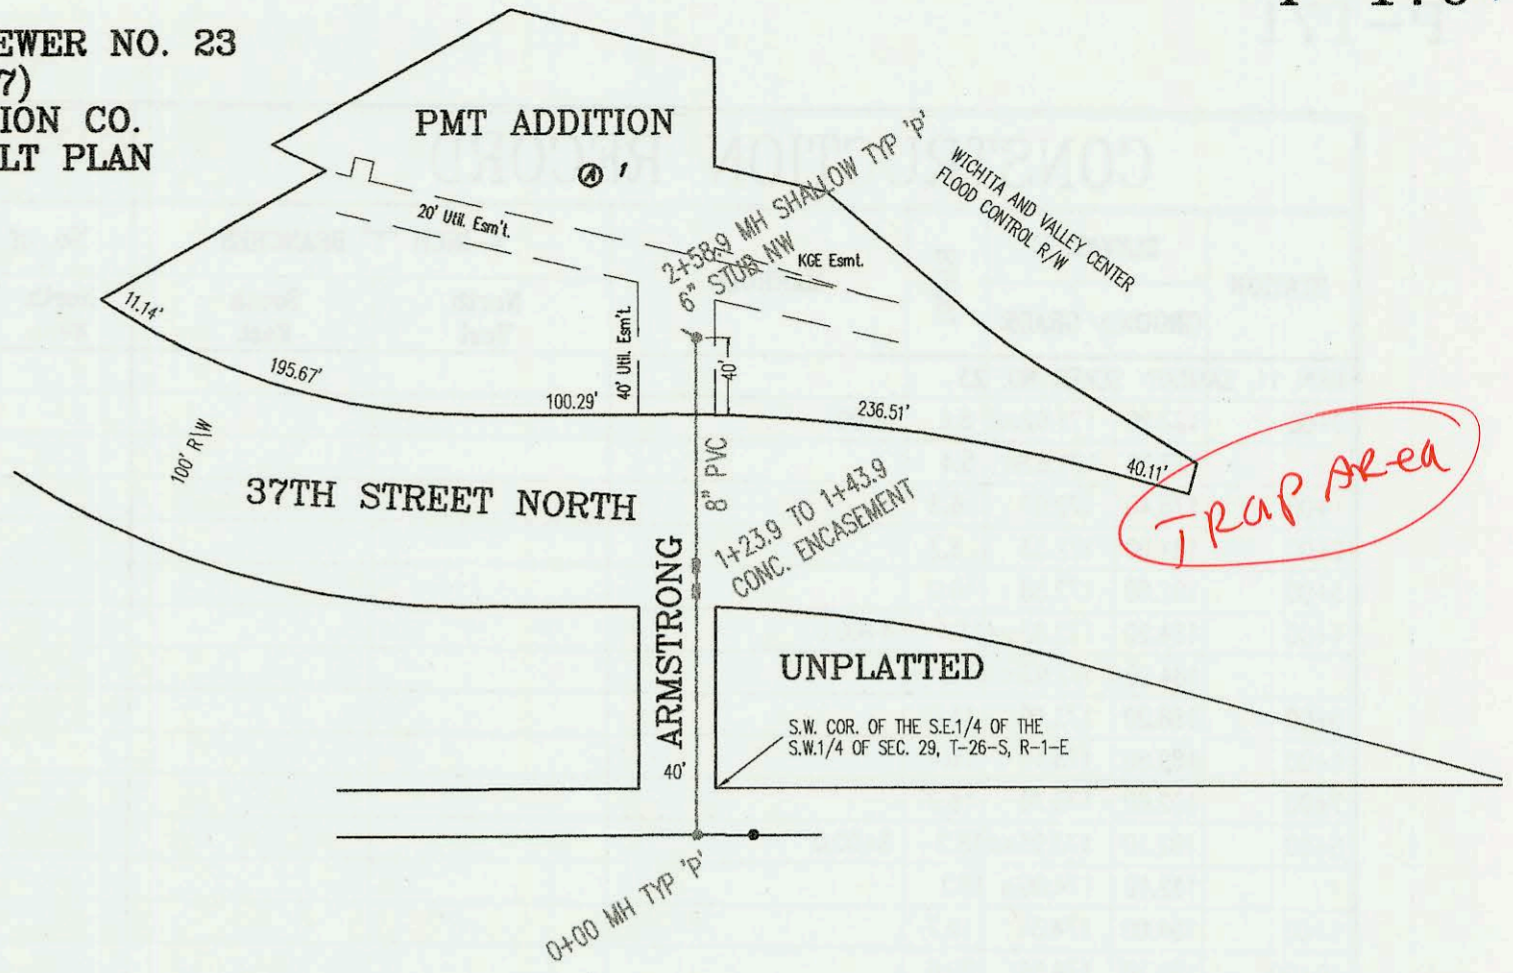


SCALE: 1" = 100'

LATERAL 457, SOUTHWEST INTERCEPTOR SEWER  
PROJECT NO. 468-83120 (743845)  
BUILT BY DONDLINGER & SONS CONSTRUCTION CO.  
BOOKED 4/30/01 PER PLAN

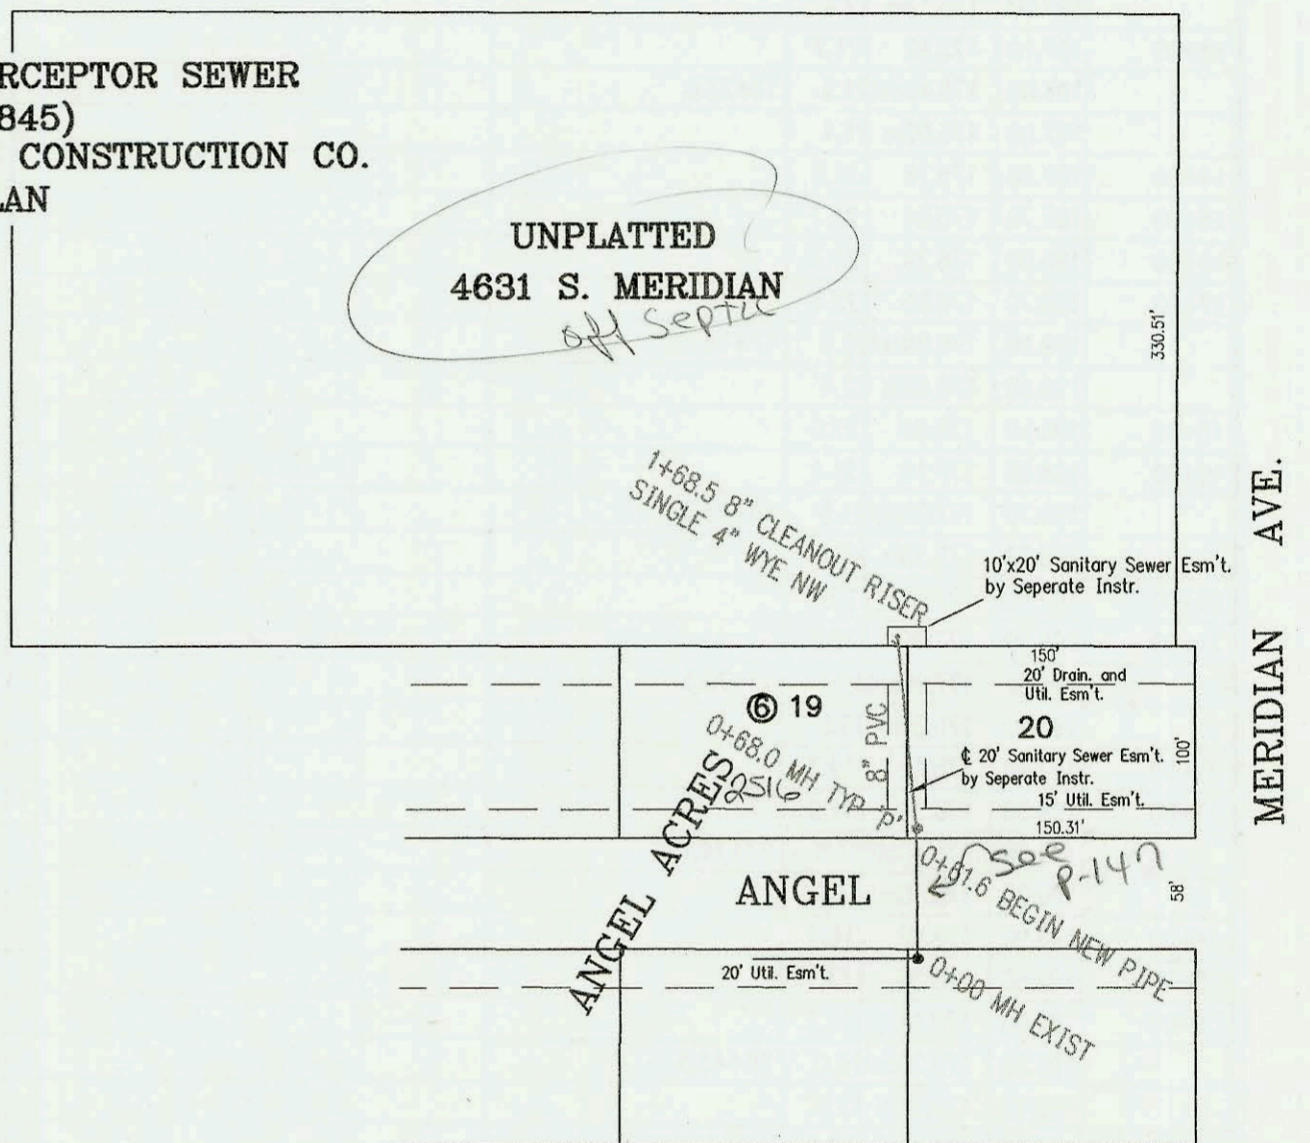

SCALE: 1" = 100'

LATERAL 458, SOUTHWEST INTERCEPTOR SEWER  
PROJECT NO. 468-83125 (743848)  
BUILT BY W.B. CARTER CONSTRUCTION CO.  
BOOKED 5/4/01 PER AS BUILT PLAN

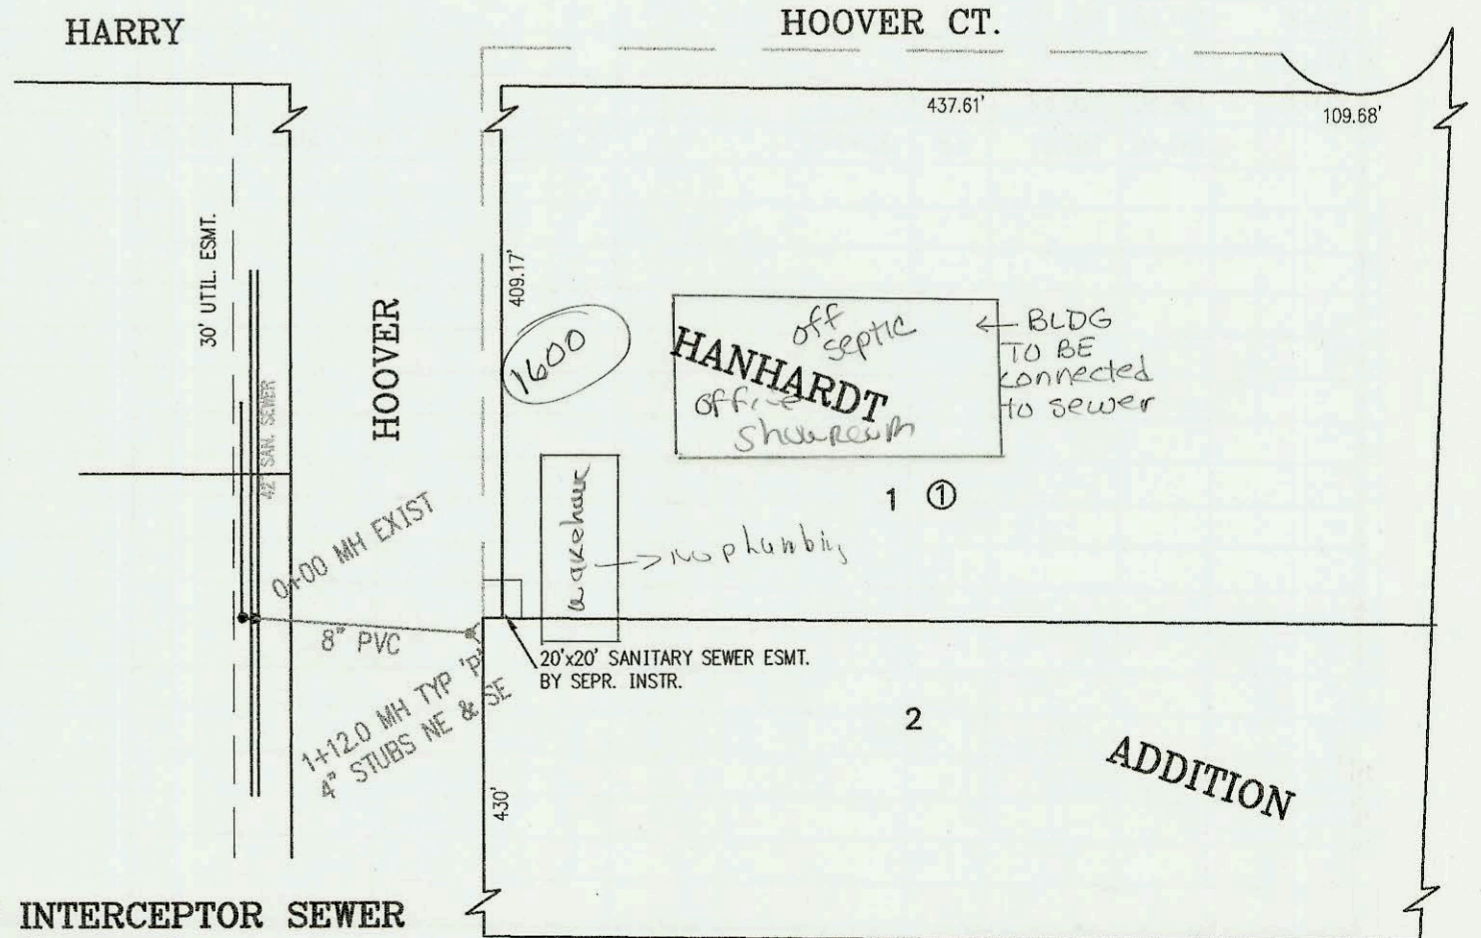

SCALE: 1" = 100'

CONSTRUCTION RECORD						SERVICE RECORD						
STATION	ELEVATION		DEPTH	MANHOLE	4-INCH "Y" BRANCHES		No. of Permit		House Number		DATE OF PERMITS	
	GROUND	GRADE			North West	South East	North West	South East	North West	South East	North West	South East
LATERAL 125, MAIN 4, SANITARY SEWER NO. 23												
0+00	133.76	126.00 out	7.8	0+00								
	133.76	126.00 in	7.8									
1+00	134.30	127.33	7.0		0+29.5 4" E 4V10H							
1+69	135.70	128.24	7.5	grade change								
2+00	134.70	128.36	6.3									
	132.71	128.60	4.1	2+58.9	6" STUB NW 127.45							
LATERAL 457, SOUTHWEST INTERCEPTOR SEWER												
0+00	95.20	84.36	10.8	0+00 EXIST								
0+61.6	94.80	84.61	10.2									
	95.20	84.63	10.6	0+68.0	4" SCH 40 DL TAP	2001-01785	2001-01507	2516 ANGEL	2505 ANGEL	7-18-01	5-25-04	
1+00	93.90	84.76	9.1									
	94.00	85.03	9.0	1+68.5 CLEANOUT RISER	4" SCH 40 WYE NW	2001-01818		H631 APPLICATOR		5-2-01		
LATERAL 458, SOUTHWEST INTERCEPTOR SEWER												
0+00	113.20	97.53 out	15.7	0+00 EXIST								
	113.20	101.71 in	11.5									
1+00	110.50	104.31	6.2									
	112.91	104.62	8.3	1+12.0	4" STUB NE 104.95 4" STUB SE 104.95	2001-01079		1605 Hoover		5-2-01		