


SANITARY SEWER TO SERVE
RIDGE PORT NORTH 2ND ADDITION
PROJECT NO. 1102PPS
BUILT BY W. B. CARTER CONSTRUCTION CO.
7/31/01 PER AS BUILT PLAN


SCALE: 1" = 150'

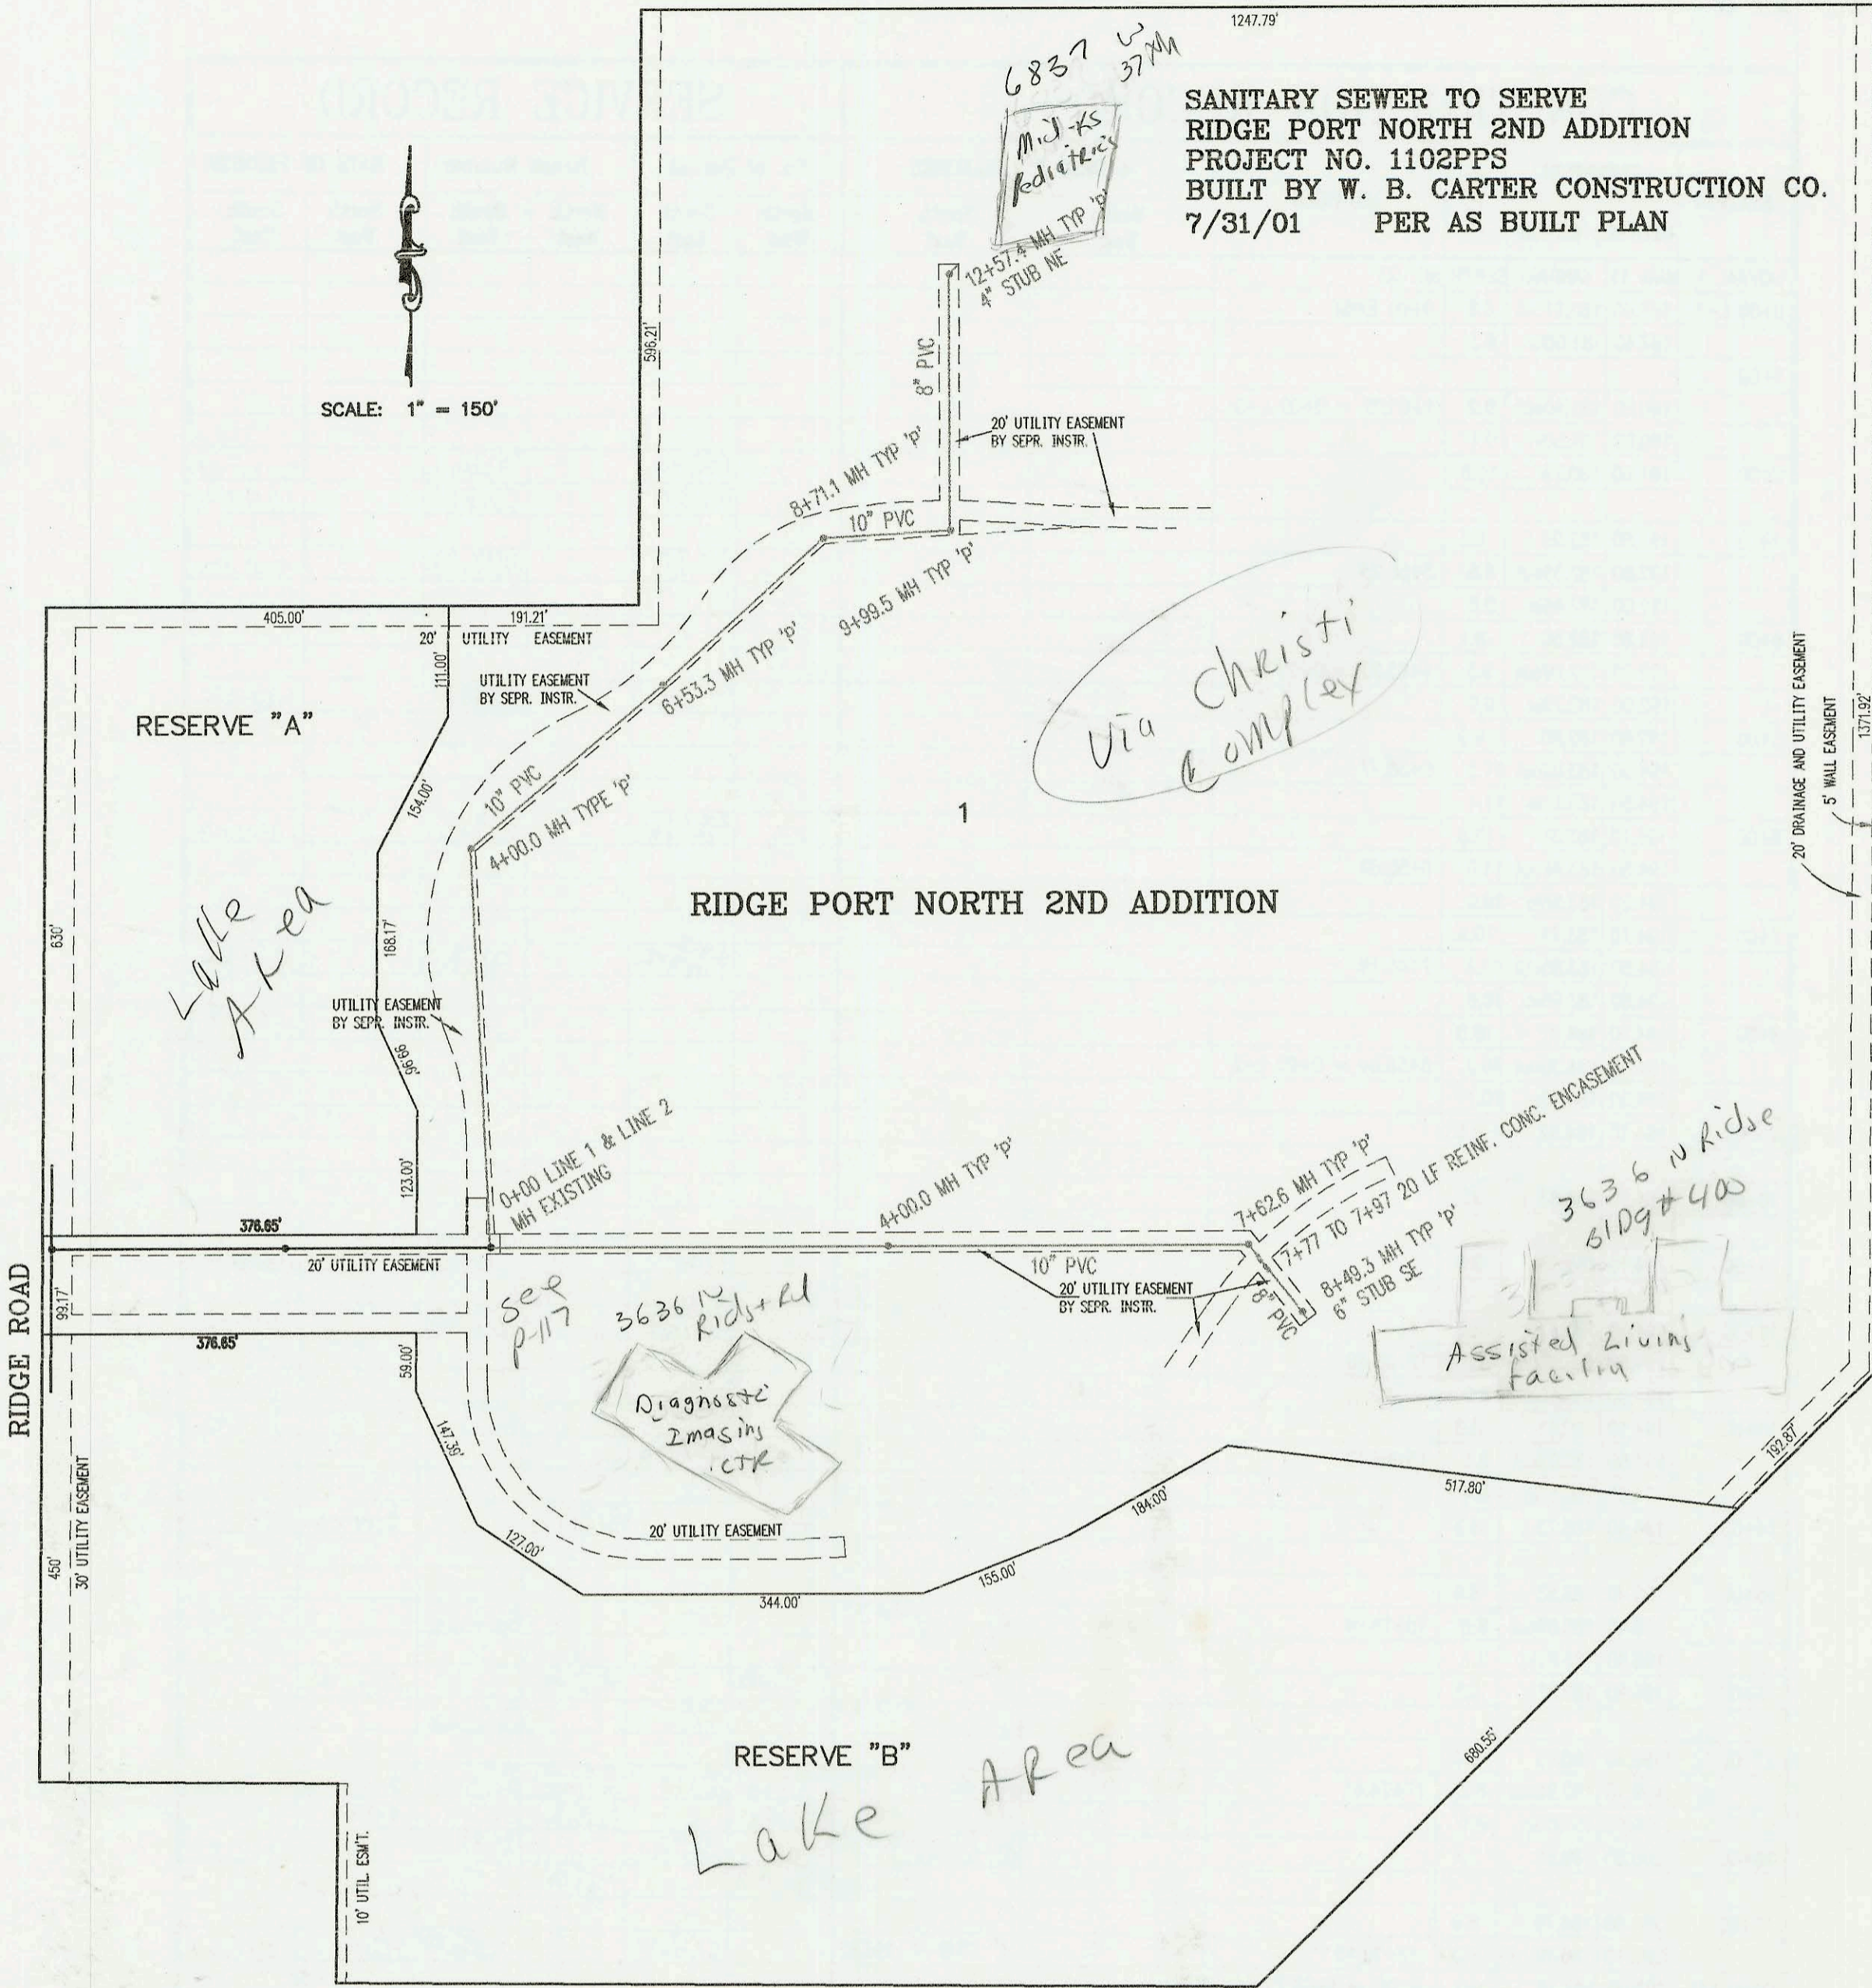

34TH STREET NORTH

SANITARY SEWER TO SERVE LOT 1, BLK 1,
SCHNIIPP 2ND ADDITION
PROJECT NO. 1088PPS
BUILT BY McCULLOUGH EXCAVATION
BOOKED 8/15/01 PER AS BUILT PLAN

SCALE: 1" = 100'

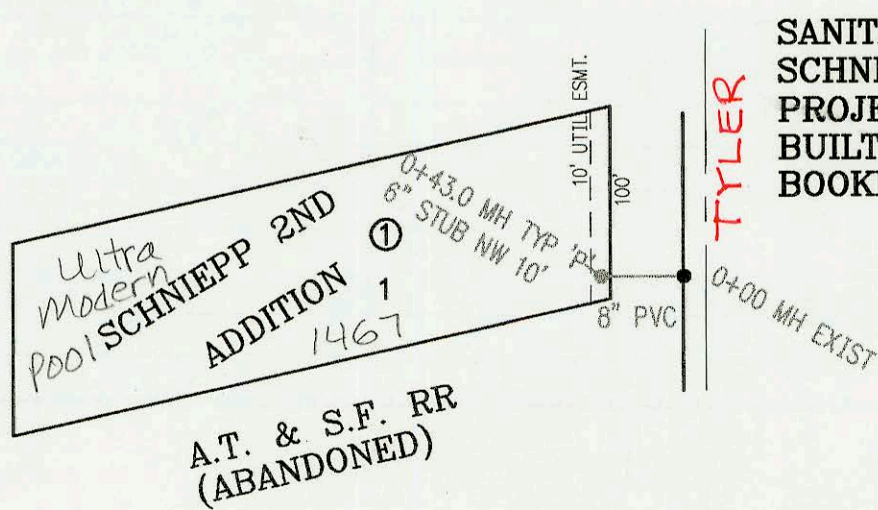

CONSTRUCTION RECORD						SERVICE RECORD						
STATION	ELEVATION		DEPTH	MANHOLE	4-INCH "Y" BRANCHES		No. of Permit		House Number		DATE OF PERMITS	
	GROUND	GRADE			North West	South East	North West	South East	North West	South East	North West	South East
SANITARY SEWER TO SERVE RIDGE PORT NORTH 2ND ADDITION (1102PPS)												
0+00 L-1	144.25	130.52	13.7	0+00 EXIST								
1+00	143.40	130.74	12.7									
2+00	144.00	130.97	13.0									
3+00	144.60	131.19	13.4									
4+00	145.57	131.41 out	14.2	4+00.0								
	145.57	131.45 in	14.1									
5+00	144.50	131.75	12.8									
6+00	144.00	132.04	12.0									
	144.05	132.20 out	11.9	6+53.3								
	144.05	132.26 in	11.8									
7+00	143.50	132.39	11.1									
8+00	144.30	132.66	11.6									
	145.20	132.86 out	12.3	8+71.1								
	145.20	132.93 in	12.3									
9+00	145.00	133.02	12.0									
	145.21	133.34 out	11.9	9+99.5								
	145.21	133.51 in	11.7									
10+00												
11+00	144.90	133.85	11.1									
12+00	145.00	134.18	10.8									
	145.42	134.37	11.1	12+57.4	4" STUB NE 134.66							
0+00 L-2	144.25	130.55	13.7	0+00 EXIST								
1+00	143.40	130.80	12.6									
2+00	143.60	131.05	12.6									
3+00	144.00	131.30	12.7									
4+00	145.05	131.55 out	13.5	4+00.0								
	145.05	131.65 in	13.4									
5+00	144.00	131.95	12.1									
6+00	143.90	132.25	11.7									
7+00	143.60	132.54	11.1									
	144.23	132.73 out	11.5	7+62.6								
	144.23	132.91 in	11.3									
8+00	143.00	133.05	10.0									
	144.68	133.23 out	11.5	8+49.3	6" STUB SE 133.40							
SANITARY SEWER TO SERVE LOT 1, BLK 1, SCHNIEPP 2ND ADDITION (1088PPS)												
0+00	140.81	130.01 out	10.8	0+00 EXIST								
	140.81	130.56 in	10.3									
	141.73	131.18	10.6	0+43.0	6" STUB NW 131.28	2001-01421		1467 S TYLER RD		6-8-01		