



SANITARY SEWER TO SERVE LOT 2, BLK 1,
BALTHROP 3RD ADDITION
PROJECT NO. 1130PPS
BUILT BY McCULLOUGH EXCAVATION
BOOKED 8/14/01 PER AS BUILT PLAN

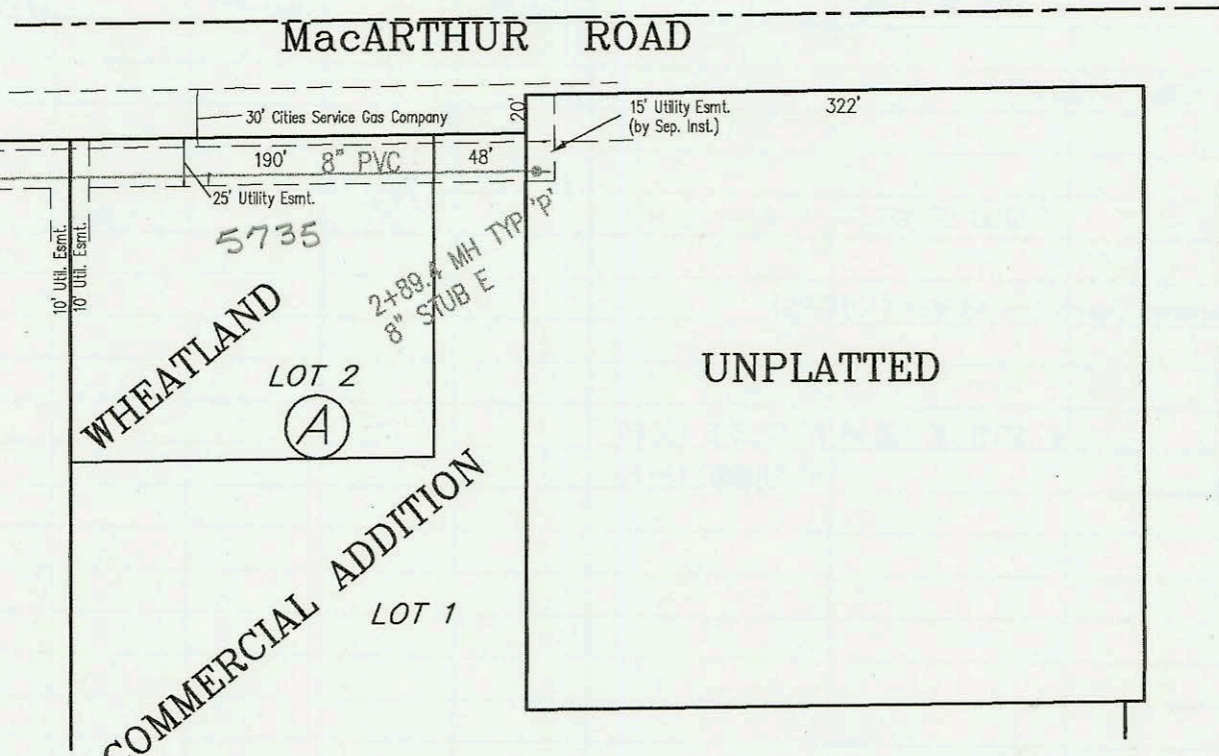

SANITARY SEWER TO SERVE LOT 2, BLK A,
WHEATLAND COMMERCIAL ADDITION & UNPLATTED TRACT
PROJECT NO. 1106PPS
BUILT BY MIES CONSTRUCTION
BOOKED 8/15/01 PER AS BUILT PLAN

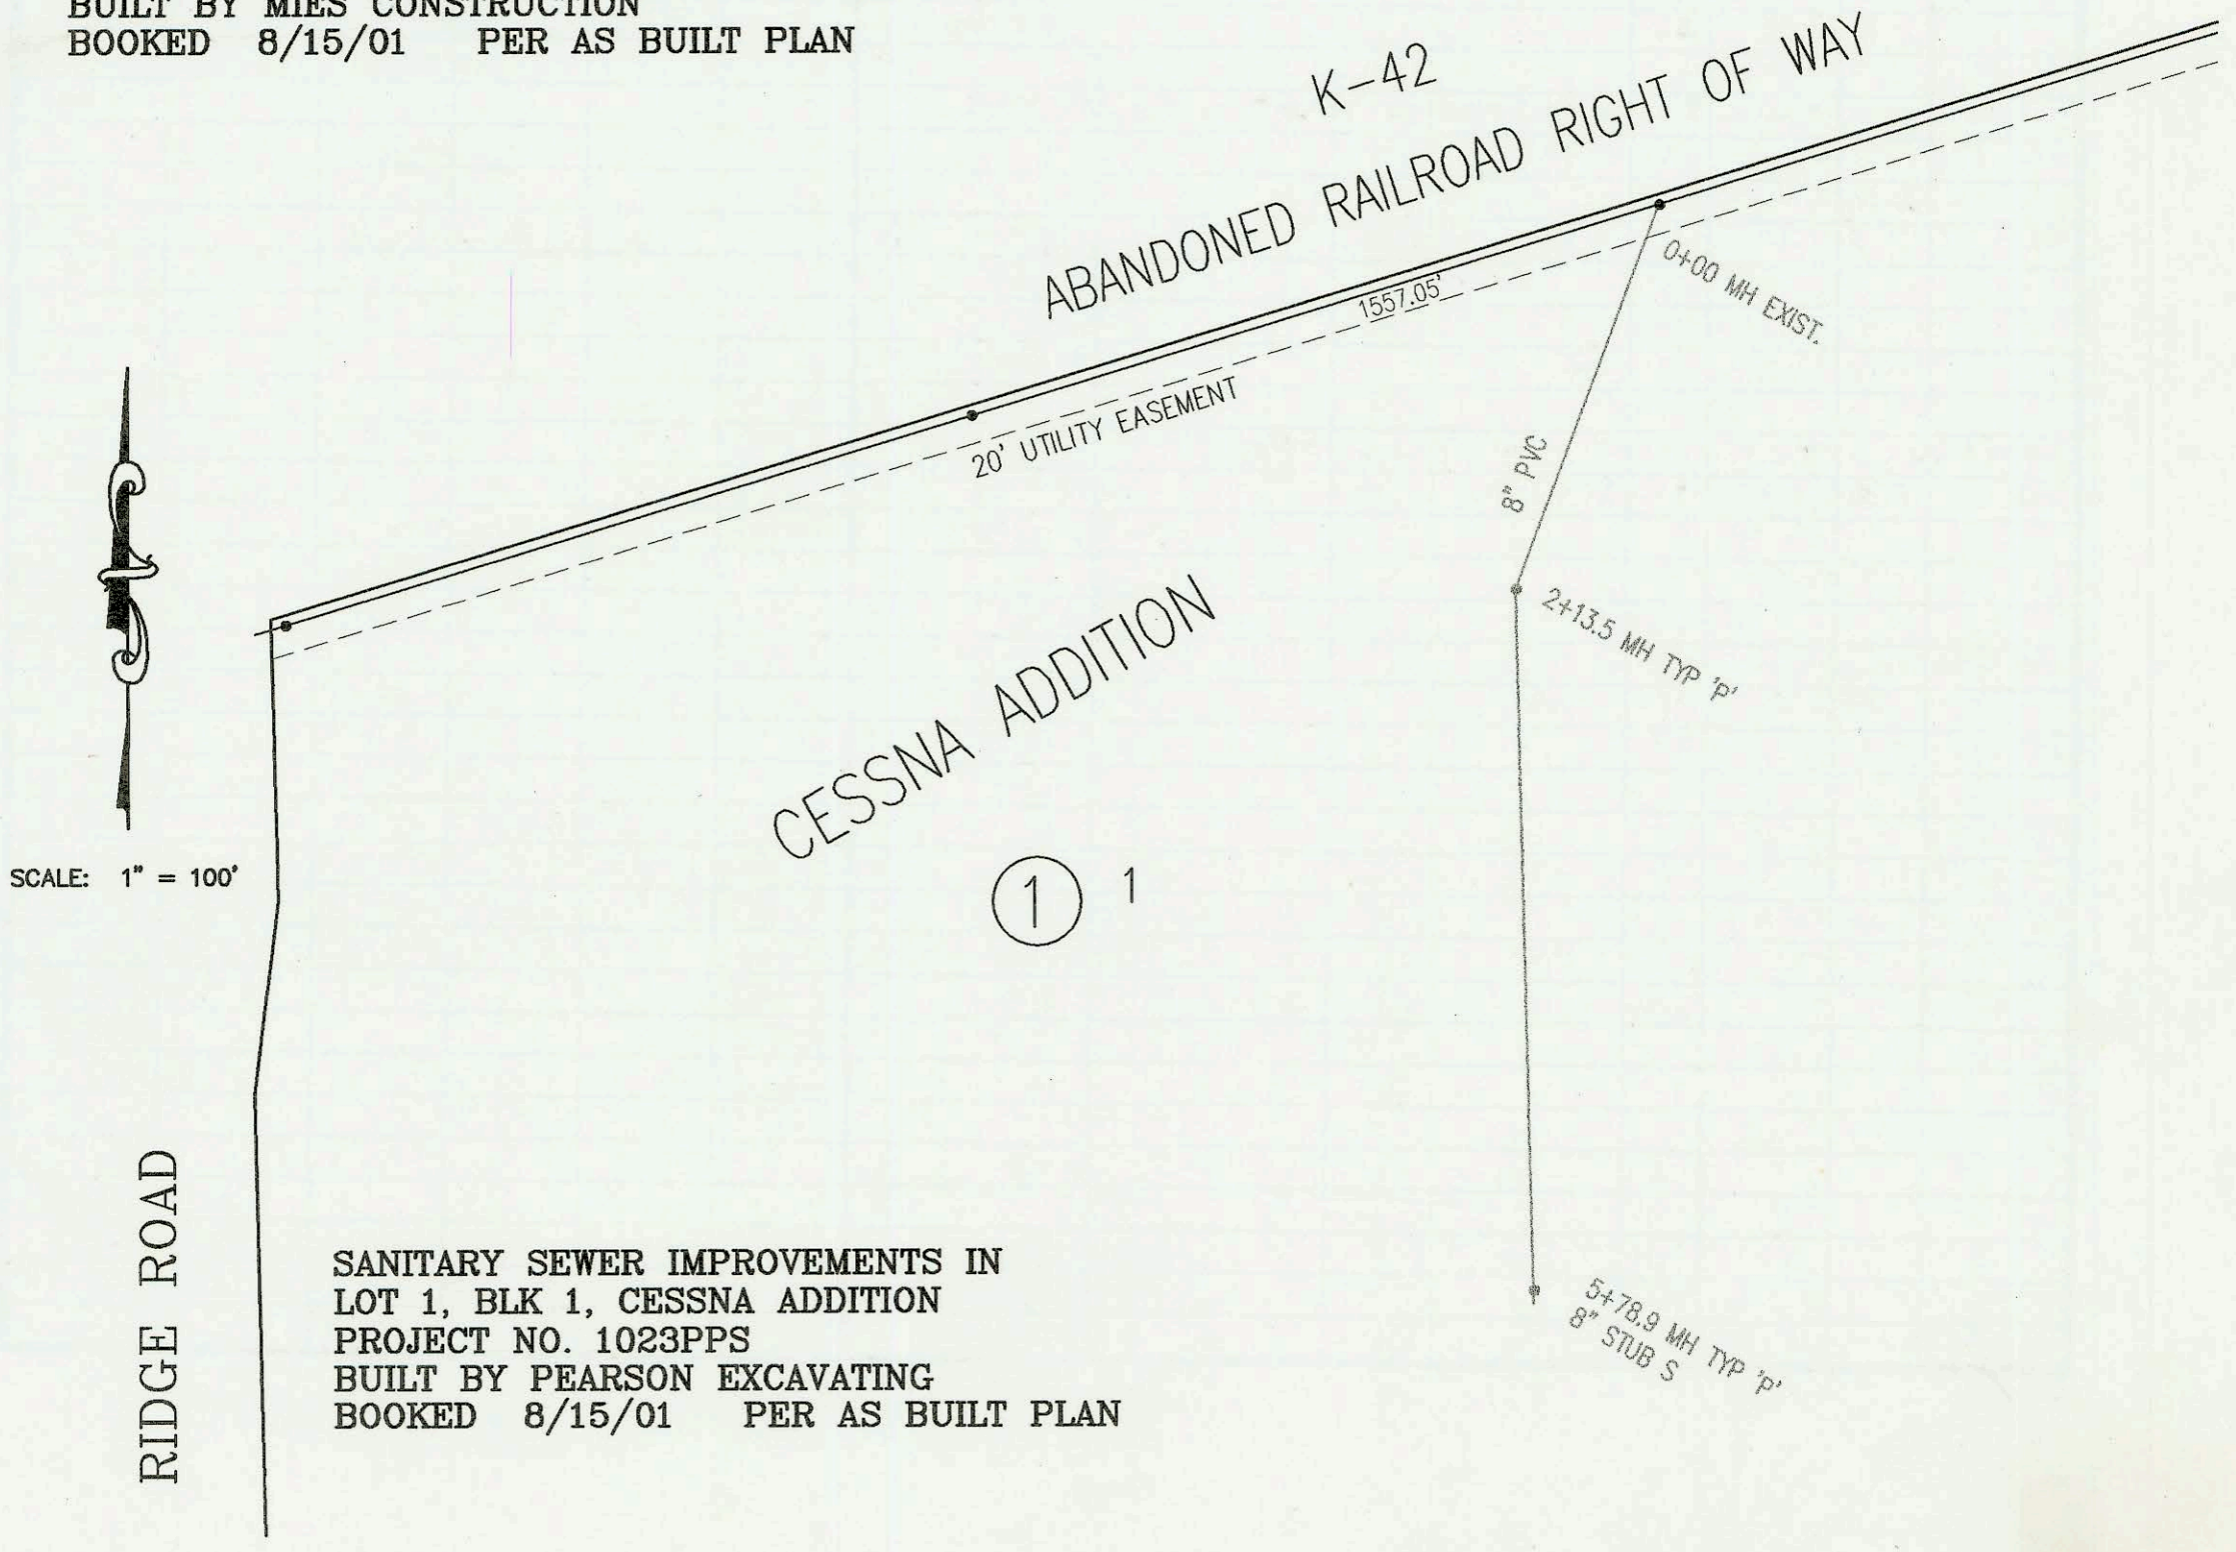

SANITARY SEWER IMPROVEMENTS IN
LOT 1, BLK 1, CESSNA ADDITION
PROJECT NO. 1023PPS
BUILT BY PEARSON EXCAVATING
BOOKED 8/15/01 PER AS BUILT PLAN

