


SANITARY SEWER TO SERVE RES. B,
BRADFORD NORTH 2ND ADDITION
PROJECT NO. 1087PPS
BUILT BY MIES CONSTRUCTION CO.
BOOKED 8/22/01 PER AS BUILT PLAN

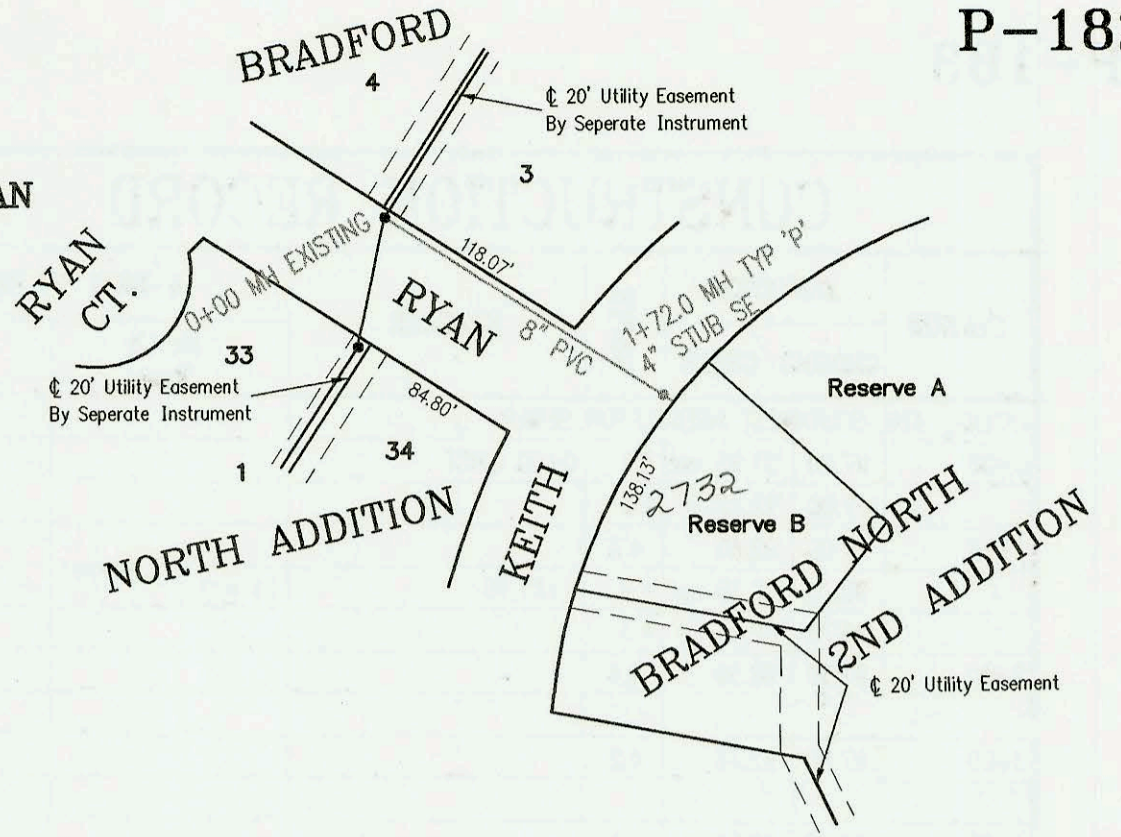


SCALE: 1" = 100'



LATERAL 49, MAIN 2, SANITARY SEWER NO. 22
PROJ. NO. 468-83266 (743875)
BUILT BY MIES CONSTRUCTION CO.
BOOKED 8/22/01 PER PLAN




SCALE: 1" = 100'

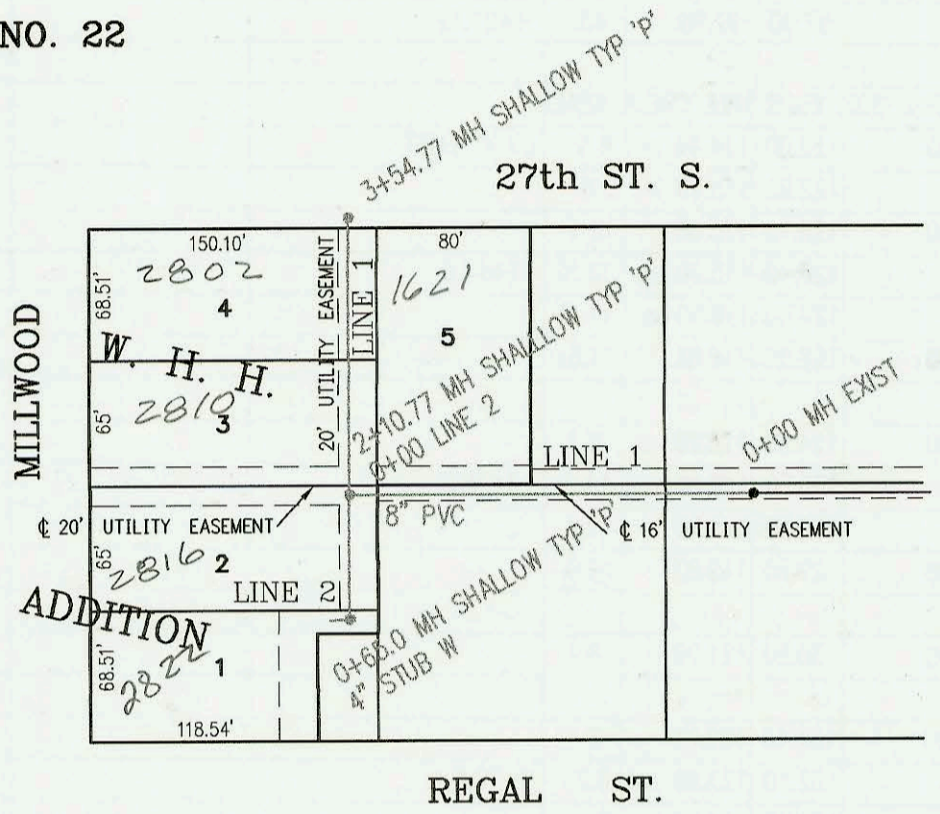

33rd Street North



SCALE: 1" = 100'

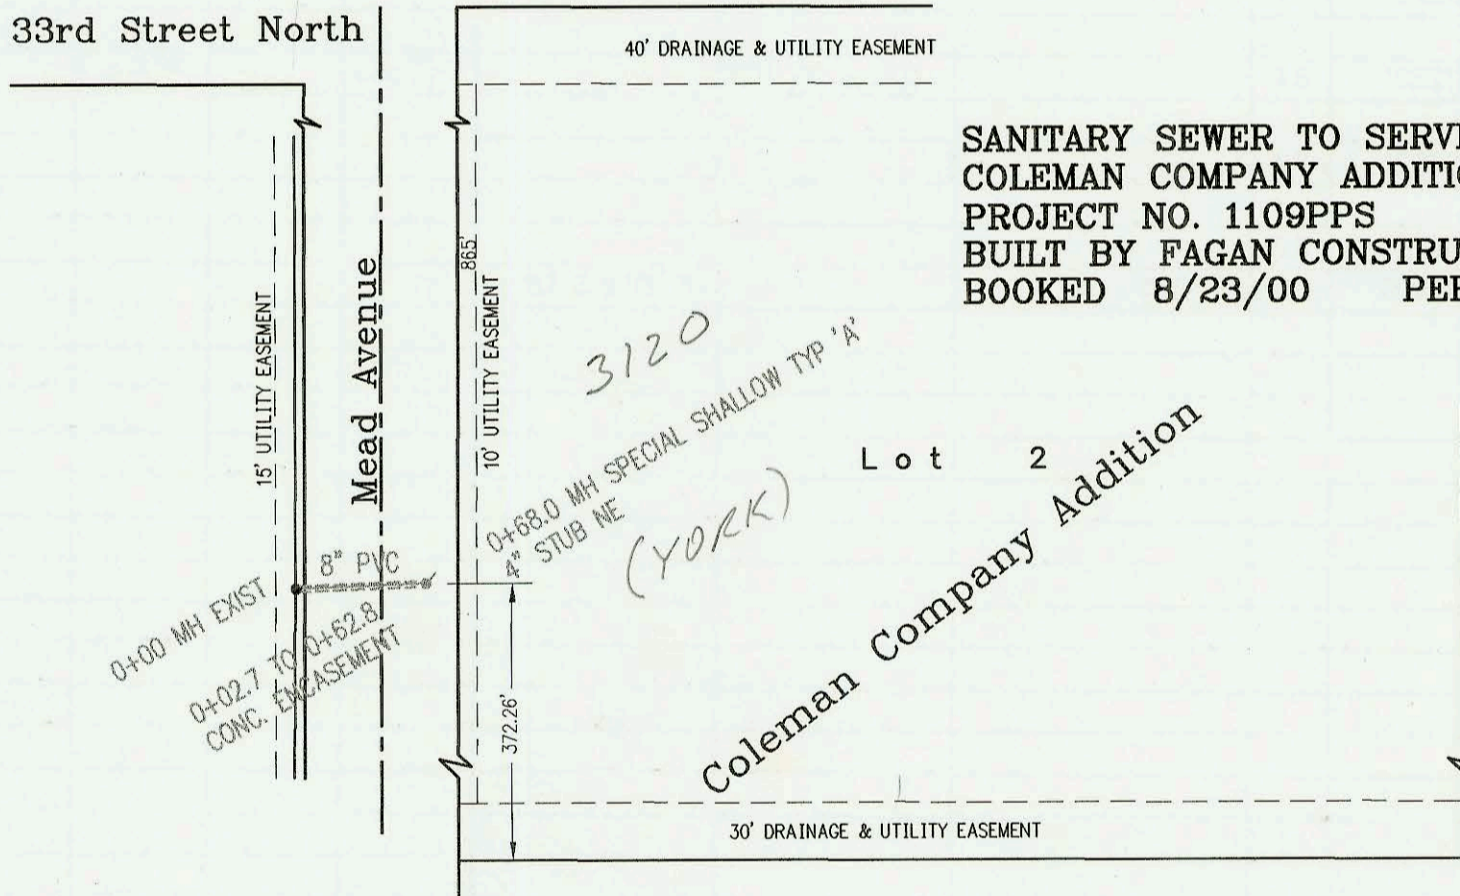


SANITARY SEWER TO SERVE LOT 2,
COLEMAN COMPANY ADDITION
PROJECT NO. 1109PPS
BUILT BY FAGAN CONSTRUCTION CO.
BOOKED 8/23/00 PER AS BUILT PLAN

SANITARY SEWER TO SERVE LOT 1, BLK A
ASCENSION LUTHERAN CHURCH 2ND ADDITION
PROJECT NO. 1075PPS BUILT BY BRAND PLUMBING
BOOKED 8/30/01 PER AS BUILT PLAN



SCALE: 1" = 100'

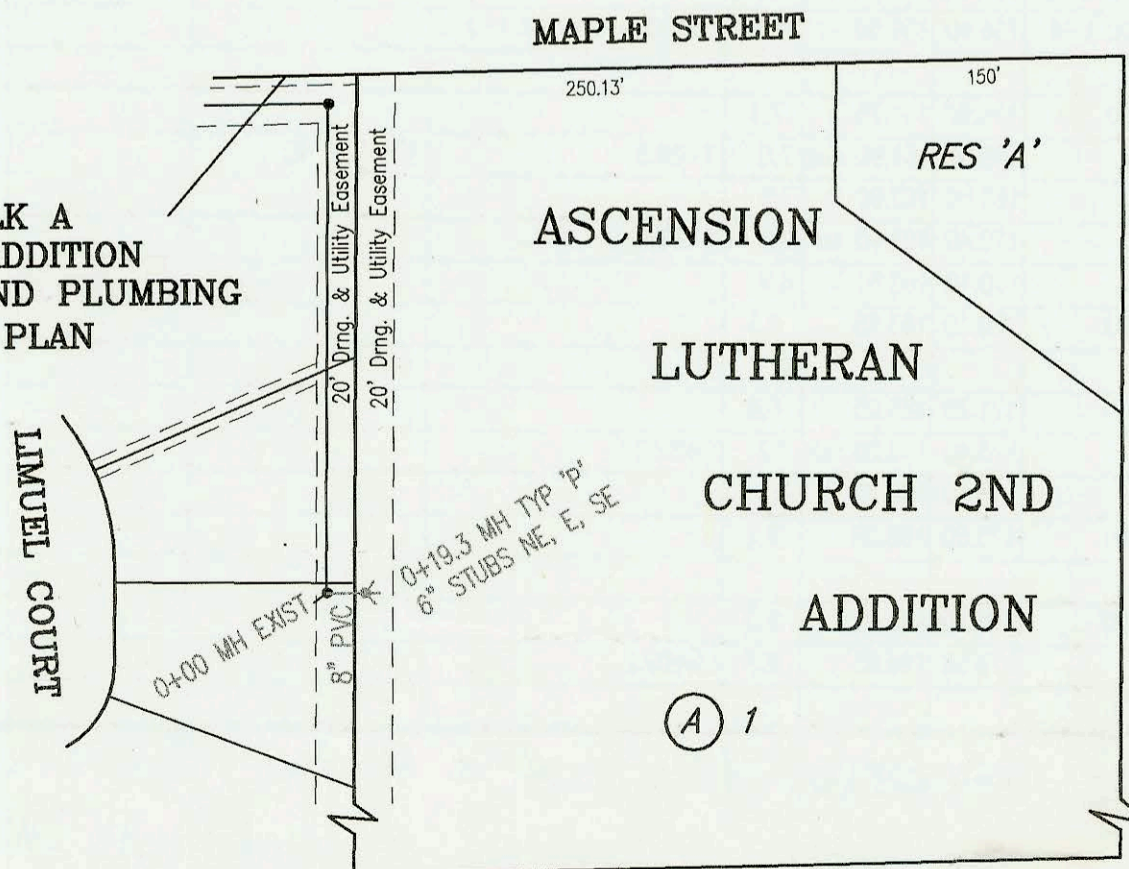

CONSTRUCTION RECORD						SERVICE RECORD						
STATION	ELEVATION		DEPTH	MANHOLE	4-INCH "Y" BRANCHES		No. of Permit		House Number		DATE OF PERMITS	
	GROUND	GRADE			North West	South East	North West	South East	North West	South East	North West	South East
Sanitary Sewer to serve Reserve "B", Bradford North 2nd Addition (1087PPS)												
0+00	167.35	156.61 out	10.7	0+00 EXIST								
	167.35	157.60 in	9.8									
1+00	167.40	159.84	7.6									
	167.83	161.45	6.4	1+72.0		4" STUB SE		2001-02096		2732N Keith St		8-22-01
LATERAL 49, MAIN 2, SANITARY SEWER NO. 22												
0+00 L-1	99.33	92.51	6.8	0+00 EXIST								
1+00	98.70	92.81	5.9									
2+00	98.00	93.11	4.9									
	98.00	93.15out	4.9	2+10.77 = 0+00 L-2				2001-02107		2810 Millwood		8/22/01
	98.00	93.25in	4.8					2001-02105		No 21 W 27th		8-22-01
3+00	97.80	93.53	4.3					2001-02106		2802 Millwood		8/22/01
	97.56	93.71	3.9	3+54.77				2001-02108		2816 Millwood		8-22-01
0+00 L-2	98.00	93.25	4.8	0+00 = 2+10.77 L-1								
	97.60	93.45	4.2	0+65.0		4" STUB W 93.78		2001-02111		2802 Millwood		11-2-01
Sanitary Sewer to serve Lot 2, Coleman Company Addition (1109PPS)												
0+00	128.70	123.85 out	4.9	0+00 EXIST								
	128.70	125.80 in	2.9									
	129.55	126.10	3.5	0+68.0		4" STUB NE-127.77 -> 4" stub NE		2001-02113		3700 Mead		8/23/01
Sanitary Sewer to serve Lot 1, Blk A, Ascension Lutheran Church 2nd Addition (1075PPS)												
0+00	144.50	135.38 out	9.1	0+00 EXIST								
	144.88	135.58	9.3	0+19.3		6" STUB NE 135.69						
						6" STUB E 135.69						
						6" STUBSE 135.69						