


LATERAL 303, FOUR MILE CREEK SEWER
PROJECT NO. 468-83233 (743865)
BUILT BY MIES CONSTRUCTION CO.
BOOKED 9/20/01 PER PLAN



SCALE: 1" = 100'

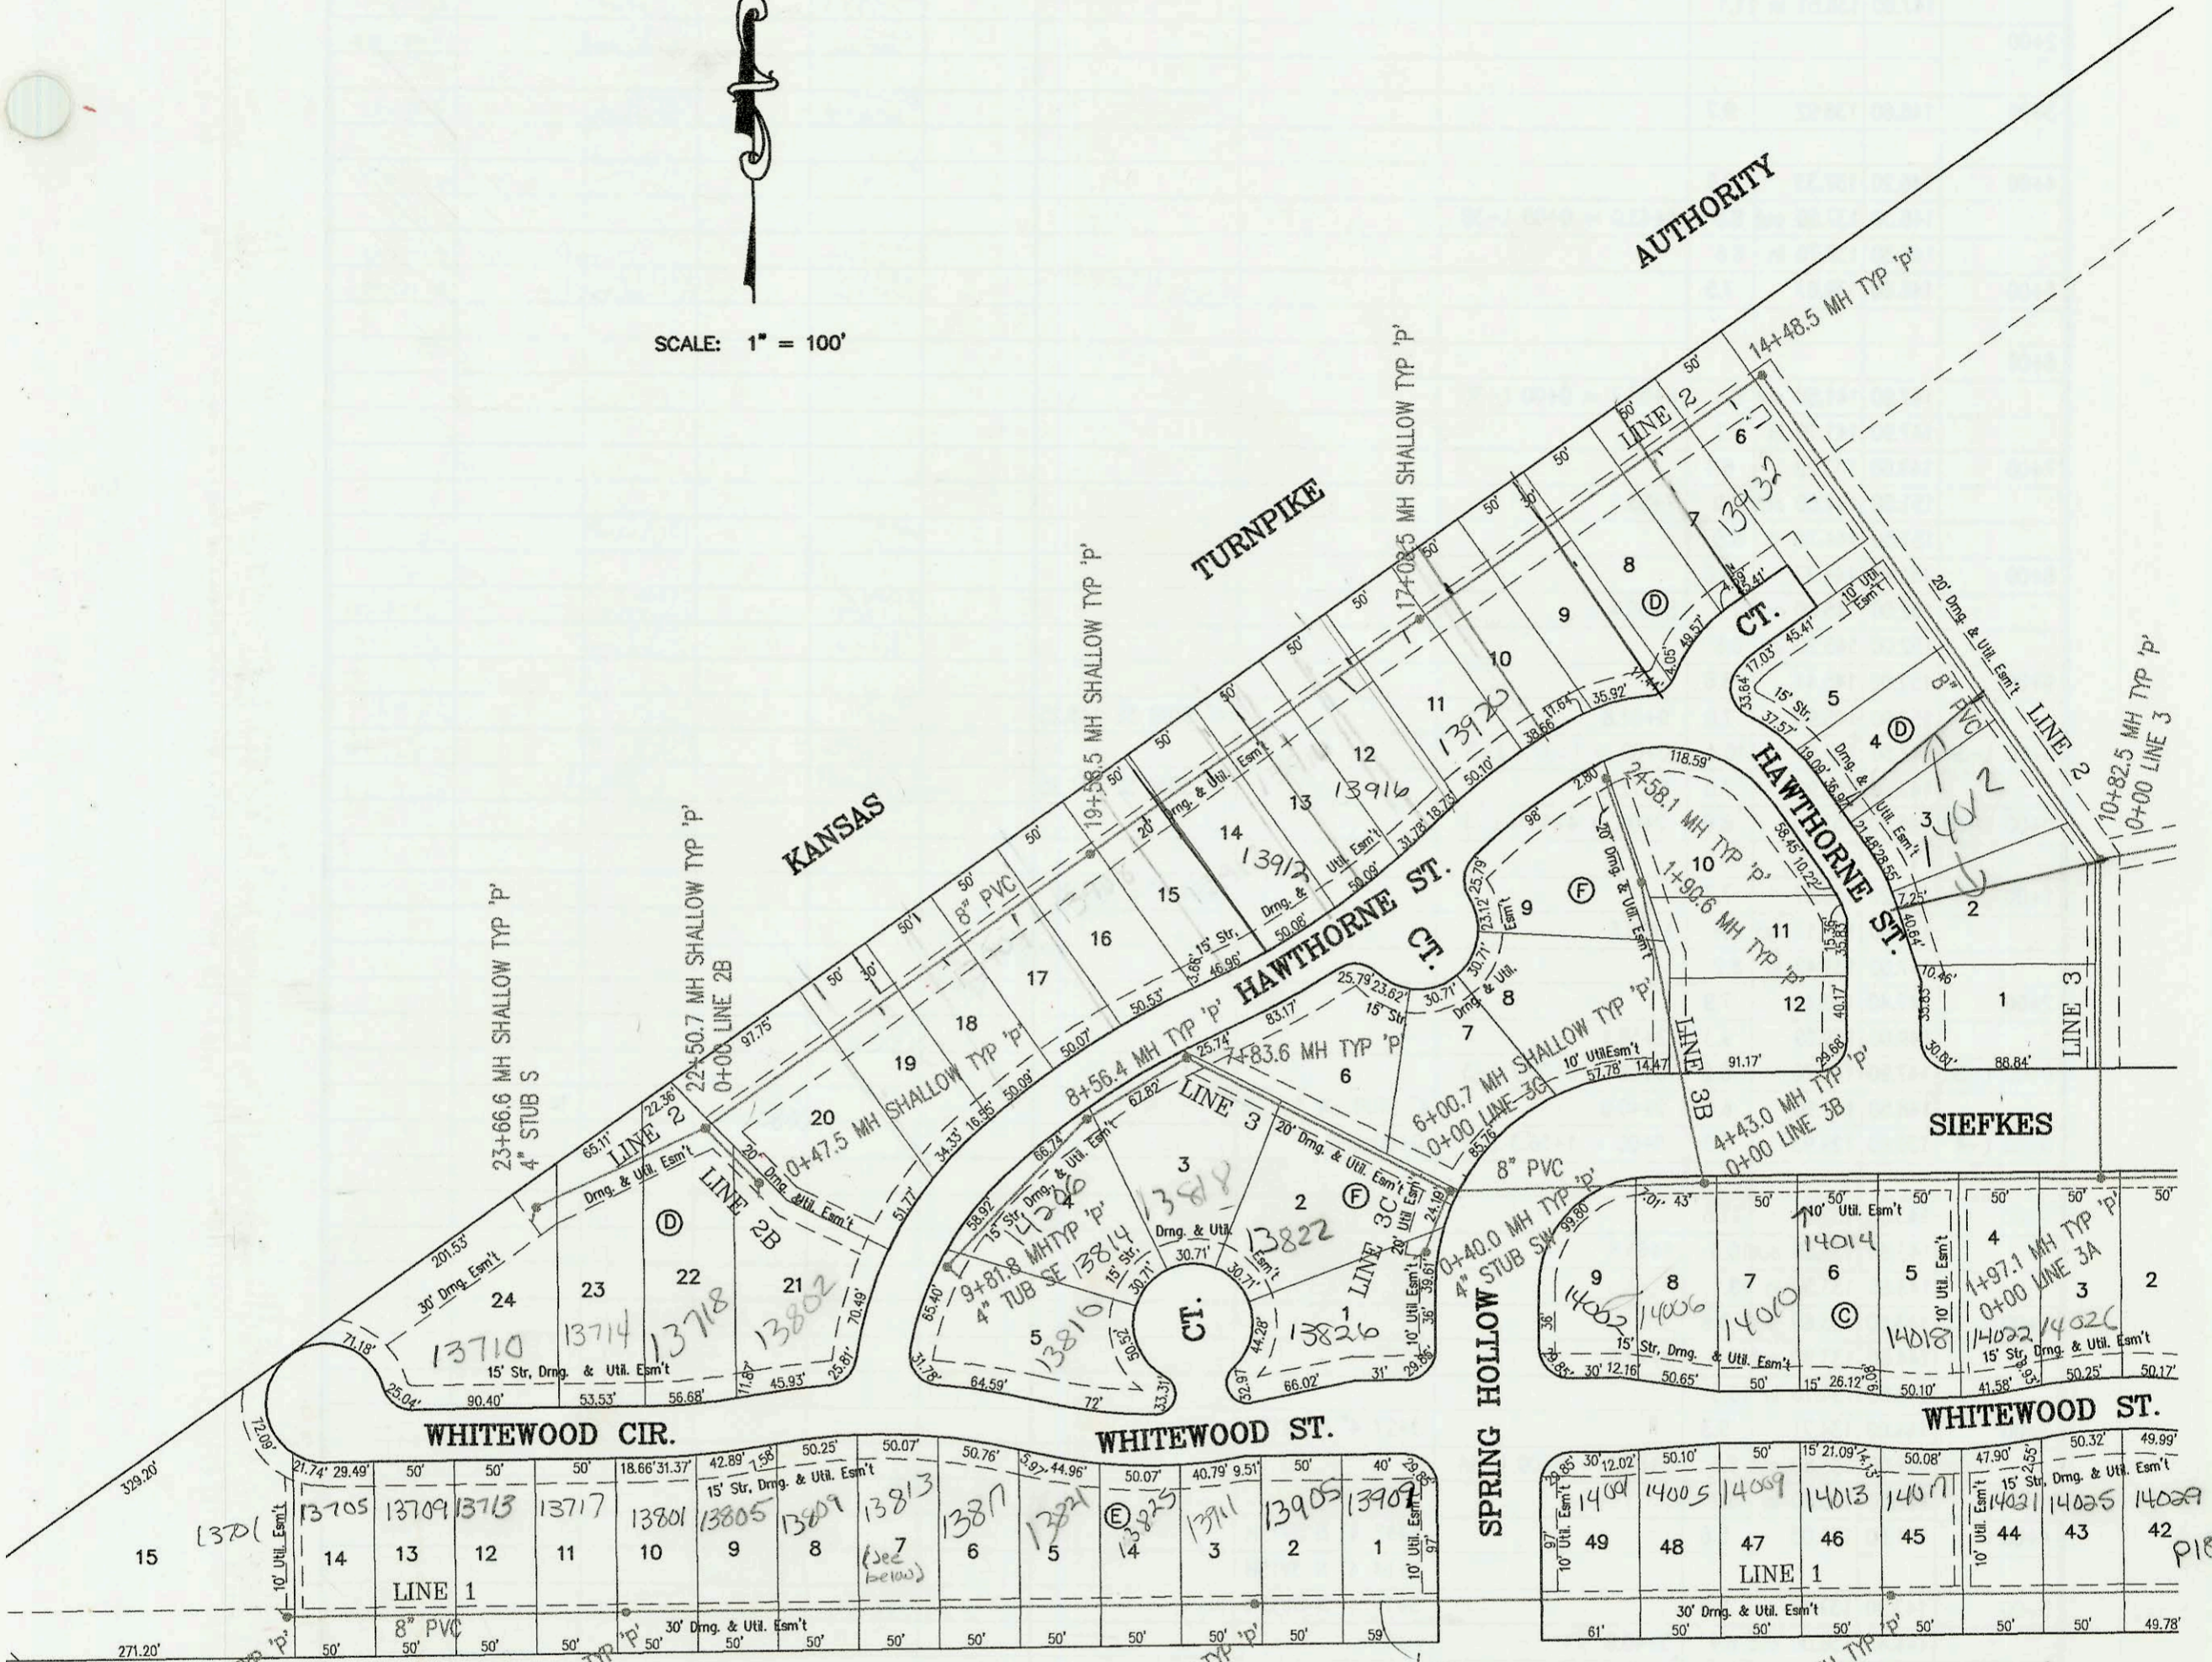

27+52.9 MH TYP 'P'
4" STUB NW
25+37.9 MH TYP 'P'
21+47.9 MH TYP 'P'
17+53.9 MH TYP 'P'
on sheet
for msmt
BLK A

2006-00017-13813 E whitewood-33' East of west Prop. line - 2/13/06 (Newfarmer)

