


KELLOGG DRIVE

119TH ST. WEST

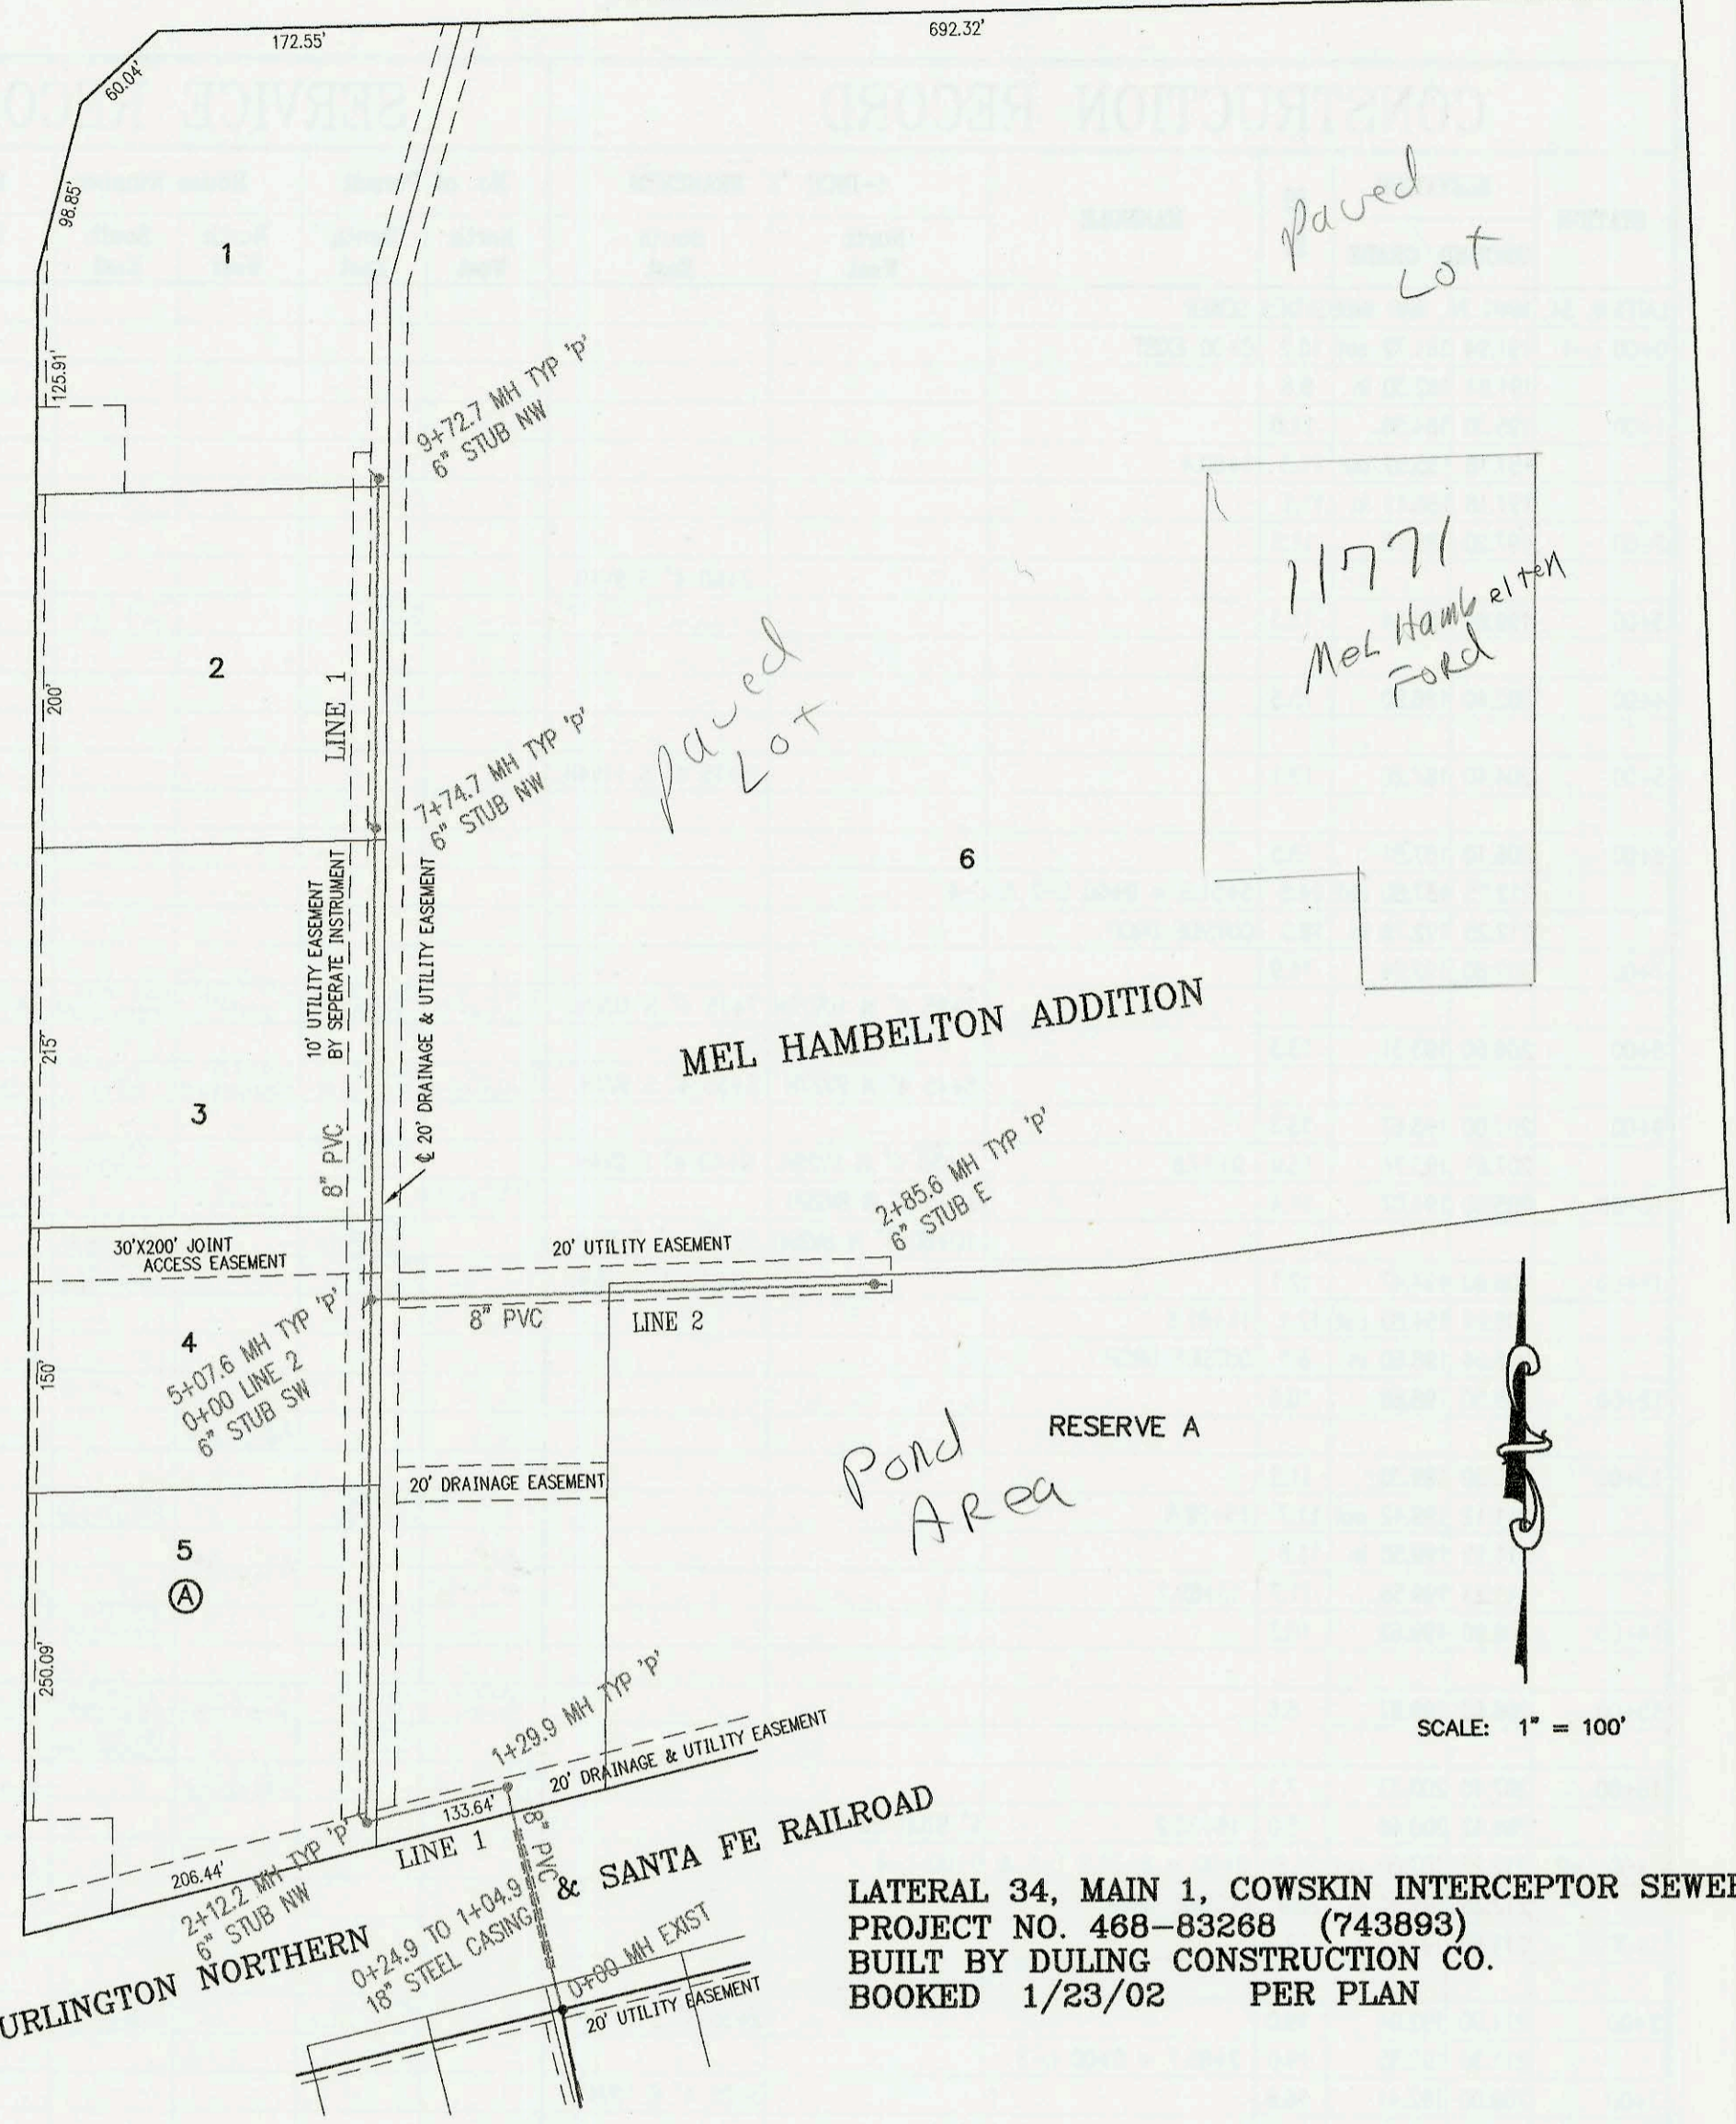

paved Lot

paved Lot

11771 Mel Hambelton Ford



SCALE: 1" = 100'

LATERAL 34, MAIN 1, COWSKIN INTERCEPTOR SEWER
 PROJECT NO. 468-83268 (743893)
 BUILT BY DULING CONSTRUCTION CO.
 BOOKED 1/23/02 PER PLAN

SANITARY SEWER TO SERVE
 PLEASANT VALLEY CHURCH OF CHRIST
 PROJECT NO. 1193PPS
 BUILT BY CLEARWATER EXCAVATING CO.
 BOOKED 3/1/02 PER AS BUILT PLAN

RUSSELL TRACTS
 LOT 12
 (PLEASANT VALLEY CHURCH OF CHRIST)
 3317 off Sertic

20'x20' UTILITY EASEMENT BY SEPARATE INSTRUMENT

0+26.4 CLEAROUT RISER ASSEMBLY

33RD ST. N.

AMIDON AVE.



SCALE: 1" = 100'

CONSTRUCTION RECORD					SERVICE RECORD							
STATION	ELEVATION		DEPTH	MANHOLE	4-INCH "Y" BRANCHES		No. of Permit		House Number		DATE OF PERMITS	
	GROUND	GRADE			North West	South East	North West	South East	North West	South East	North West	South East
LATERAL 34, MAIN 1, COWSKIN INTERCEPTOR SEWER												
0+00 L-1	144.45	132.92	11.5	0+00 EXIST								
1+00	142.50	133.92	8.6									
	143.50	134.22 out	9.3	1+29.9								
	143.50	134.32 in	9.2									
2+00	143.50	134.53	9.0									
	143.90	134.57 out	9.3	2+12.2	6" STUB NW	134.84						
	143.90	134.67 in	9.2									
3+00	143.80	134.93	8.9									
4+00	144.20	135.23	9.0									
5+00	144.50	135.54	9.0									
	144.90	135.56	9.3	5+07.6 = 0+00 L-2	6" STUB SW	135.83						
6+00	144.00	135.84	8.2									
7+00	144.10	136.14	8.0									
	144.40	136.33	8.1	7+74.7	6" STUB NW	136.53						
8+00	144.00	136.44	7.6									
9+00	144.00	136.74	7.3									
	144.50	136.95	7.6	9+72.7	6" STUB NW	137.12						
0+00 L-2	144.90	135.66	9.2	0+00 = 5+07.6 L-1								
1+00	144.20	135.96	8.2									
2+00	142.70	136.26	6.4									
	141.90	136.52	5.4	2+85.6	6" STUB E	136.69		2051 22302	11971 w Kellogg		9-13-01	
SANITARY SEWER TO SERVE PLEASANT VALLEY CHURCH OF CHRIST (1193PPS)												
0+00	131.13	117.66 out	13.5	0+00 EXIST								
	131.13	121.43 in	9.7									
	131.95	121.51	10.4	0+26.4 CLEANOUT RISER				22002 06633	3217 w. Amidon		3-11-02	