



SANITARY SEWER TO SERVE LOT 1, BLK A,
COLLEGE HILL SQUARE ADDITION
PROJECT NO. 1201PPS
BUILT BY CLEARWATER EXCAVATING
BOOKED 6/14/02 PER AS BUILT PLAN

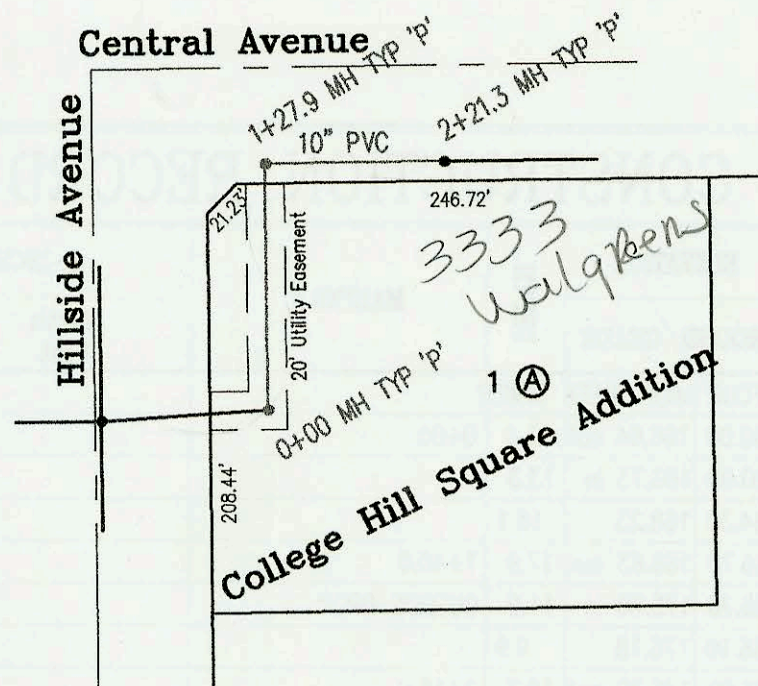

SCALE: 1" = 100'


SANITARY SEWER TO SERVE VILM GARDENS
SECOND ADDITION, LOTS 1-3, & 10-12, BLK B
PROJECT NO. 1239PPS
BUILT BY MIES CONSTRUCTION CO. BOOKED
6/24/02 PER AS BUILT PLAN

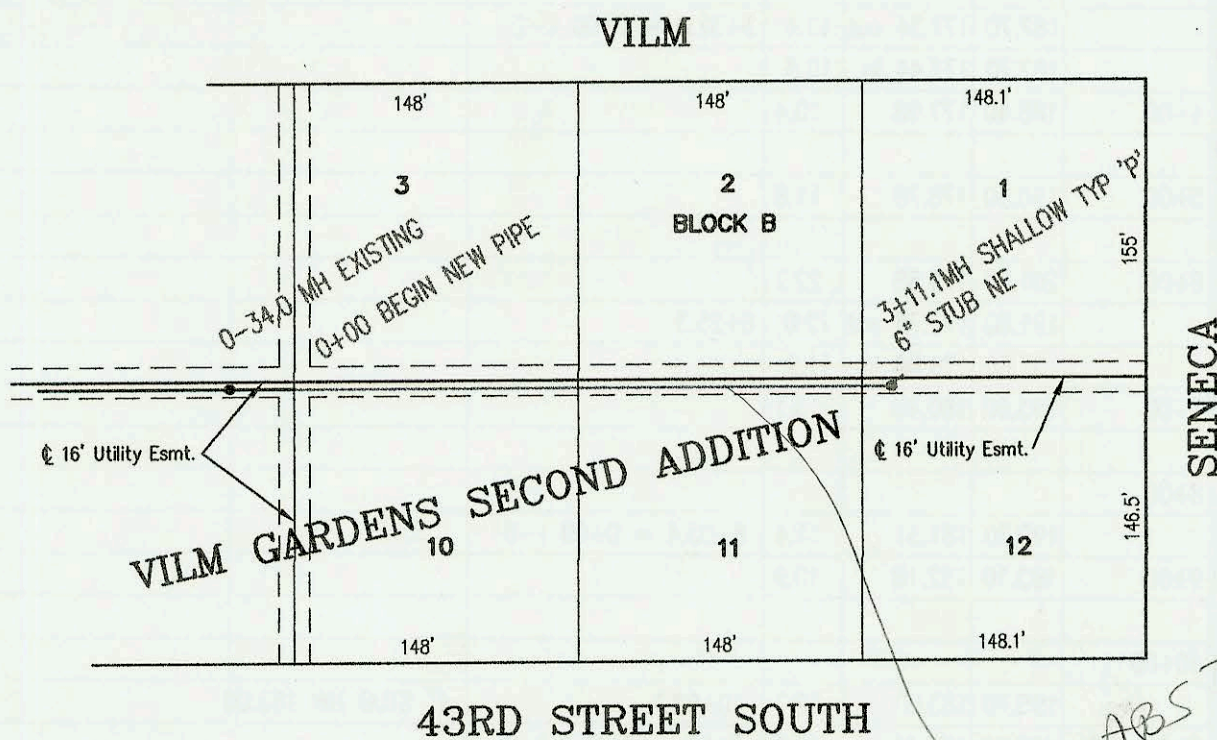


SCALE: 1" = 100'

*8" ABS TRUSS
sewer main
DU MUST
make for*

SANITARY SEWER TO SERVE WOODBRIDGE 2ND
ADDITION, LOTS 46-49, BLK 1
PROJECT NO. 1226PPS
BUILT BY MIES CONSTRUCTION CO.
BOOKED 6/25/02 PER AS BUILT PLAN

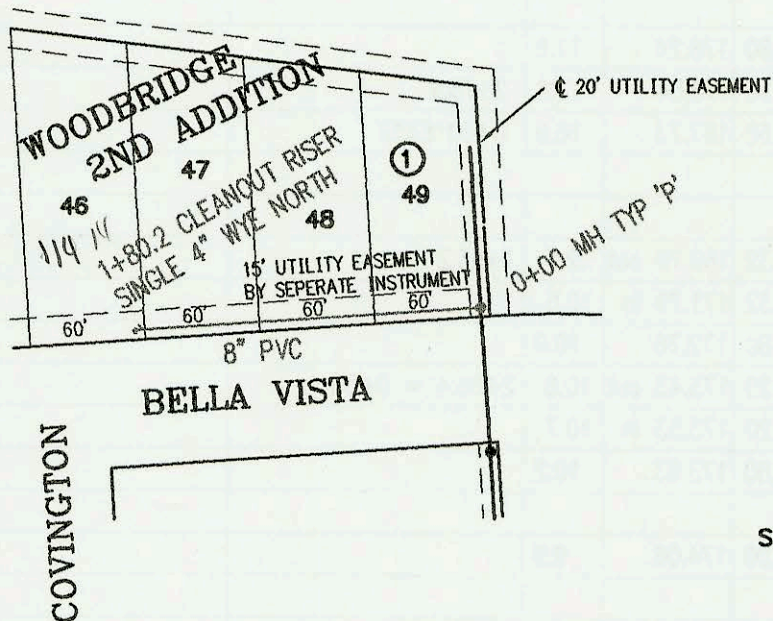

SCALE: 1" = 100'

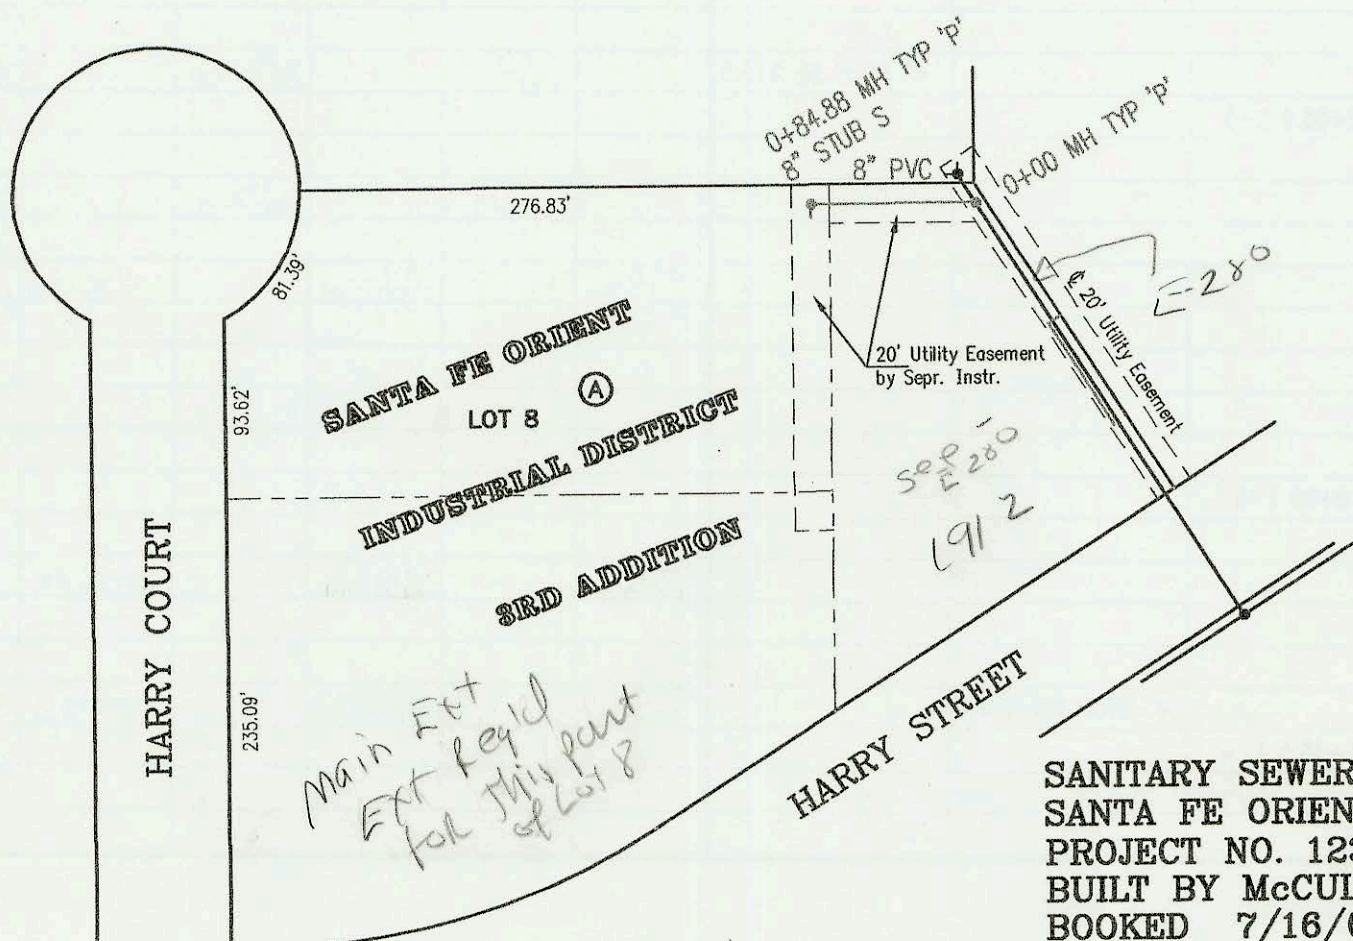

SCALE: 1" = 100'

SANITARY SEWER TO SERVE LOT 8, BLOCK A,
SANTA FE ORIENT INDUSTRIAL DISTRICT 3RD ADDITION
PROJECT NO. 1237PPS
BUILT BY McCULLOUGH EXCAVATING
BOOKED 7/16/02 PER AS BUILT PLAN

*Main Ext
Ext Reg'd
for this part
of Lot 8*

CONSTRUCTION RECORD					SERVICE RECORD							
STATION	ELEVATION		DEPTH	MANHOLE	4-INCH "Y" BRANCHES		No. of Permit		House Number		DATE OF PERMITS	
	GROUND	GRADE			North West	South East	North West	South East	North West	South East	North West	South East
SS to serve	Lot 1, Blk A, College Hill Square Addition (1201PPS)											
0+00	141.80	130.70	11.1	0+00								
1+00	142.60	130.91	11.7									
	143.55	130.97 out	12.6	1+27.9								
	143.55	131.04 in	12.5					1061 02038	3353 CENTRAL		11-26-02	
2+00	143.20	131.24	12.0									
	143.22	131.30	11.9	2+21.3 EXISTING								
SANITARY SEWER TO	SERVE VILM GARDENS SECOND ADDITION, LOTS 1-3 & 10-12, BLK B (1239PPS)											
0-34.0	88.60	82.33	6.3	0-34.0 MH EXIST.								
0+00	88.50	82.53	6.0									
1+00	88.30	82.84	5.5									
2+00	88.00	83.15	4.8									
3+00	89.50	83.47	6.0									
	89.34	83.50	5.8	3+11.1	6" STUB NE 83.67							
SANITARY TO	SERVE WOODBRIDGE 2ND ADDITION, LOTS 46-49, BLK 1 (1226PPS)											
0+00	160.30	144.26 out	16.0	0+00								
	160.30	144.54 in	15.8									
1+00	159.50	146.77	12.7									
	159.87	148.56	11.3	1+80.2 CLEANOUT RISER								
				4" SINGLE WYE NORTH								
SS to serve	Lot 8, Blk A, Santa Fe Orient Industrial District 3rd Addition (1237PPS)											
0+00	106.31	96.01	10.3	0+00								
	107.04	96.35	10.7	0+84.88	8" STUB S 96.45							
LATERAL 326, FOUR MILE CREEK SEWER (CONT. FROM P-227)												
	196.10	182.13 out	14.0	1+66.8								
	196.10	182.23 in	13.9					2003 03175	1102 Bedford		12-4-03	
2+00	194.10	182.56	11.5									
	196.00	182.81	13.2	2+24.6	4" STUB S 183.15			2003 03222	1098 Bedford		12-17-03	
0+00 L-6	192.70	181.41	11.3	0+00 = 8+03.4 L-1				2003 02806	1031 Bedford		10-29-03	
1+00	192.10	183.41	8.7									
	191.90	184.00	7.9	1+29.5	4" STUB S 184.35			2003 03043	1037 Bedford		1-9-03	