


Highland Springs

2nd Addition

LATERAL 23, COWSKIN INTERCEPTOR SEWER  
PROJECT NO. 468-83028 (743902)  
BUILT BY K. C. EXCAVATING  
BOOKED 7/18/02 PER PLAN

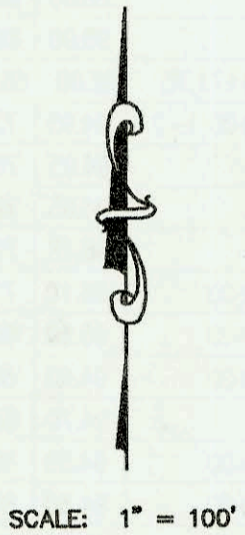

SCALE: 1" = 100'

See on computer

