


LATERAL 310, FOUR MILE CREEK SEWER
PROJECT NO. 468-83282 OCA NO. 743915
BUILT BY MIES CONSTRUCTION CO.
BOOKED 8/9/02 PER PLAN

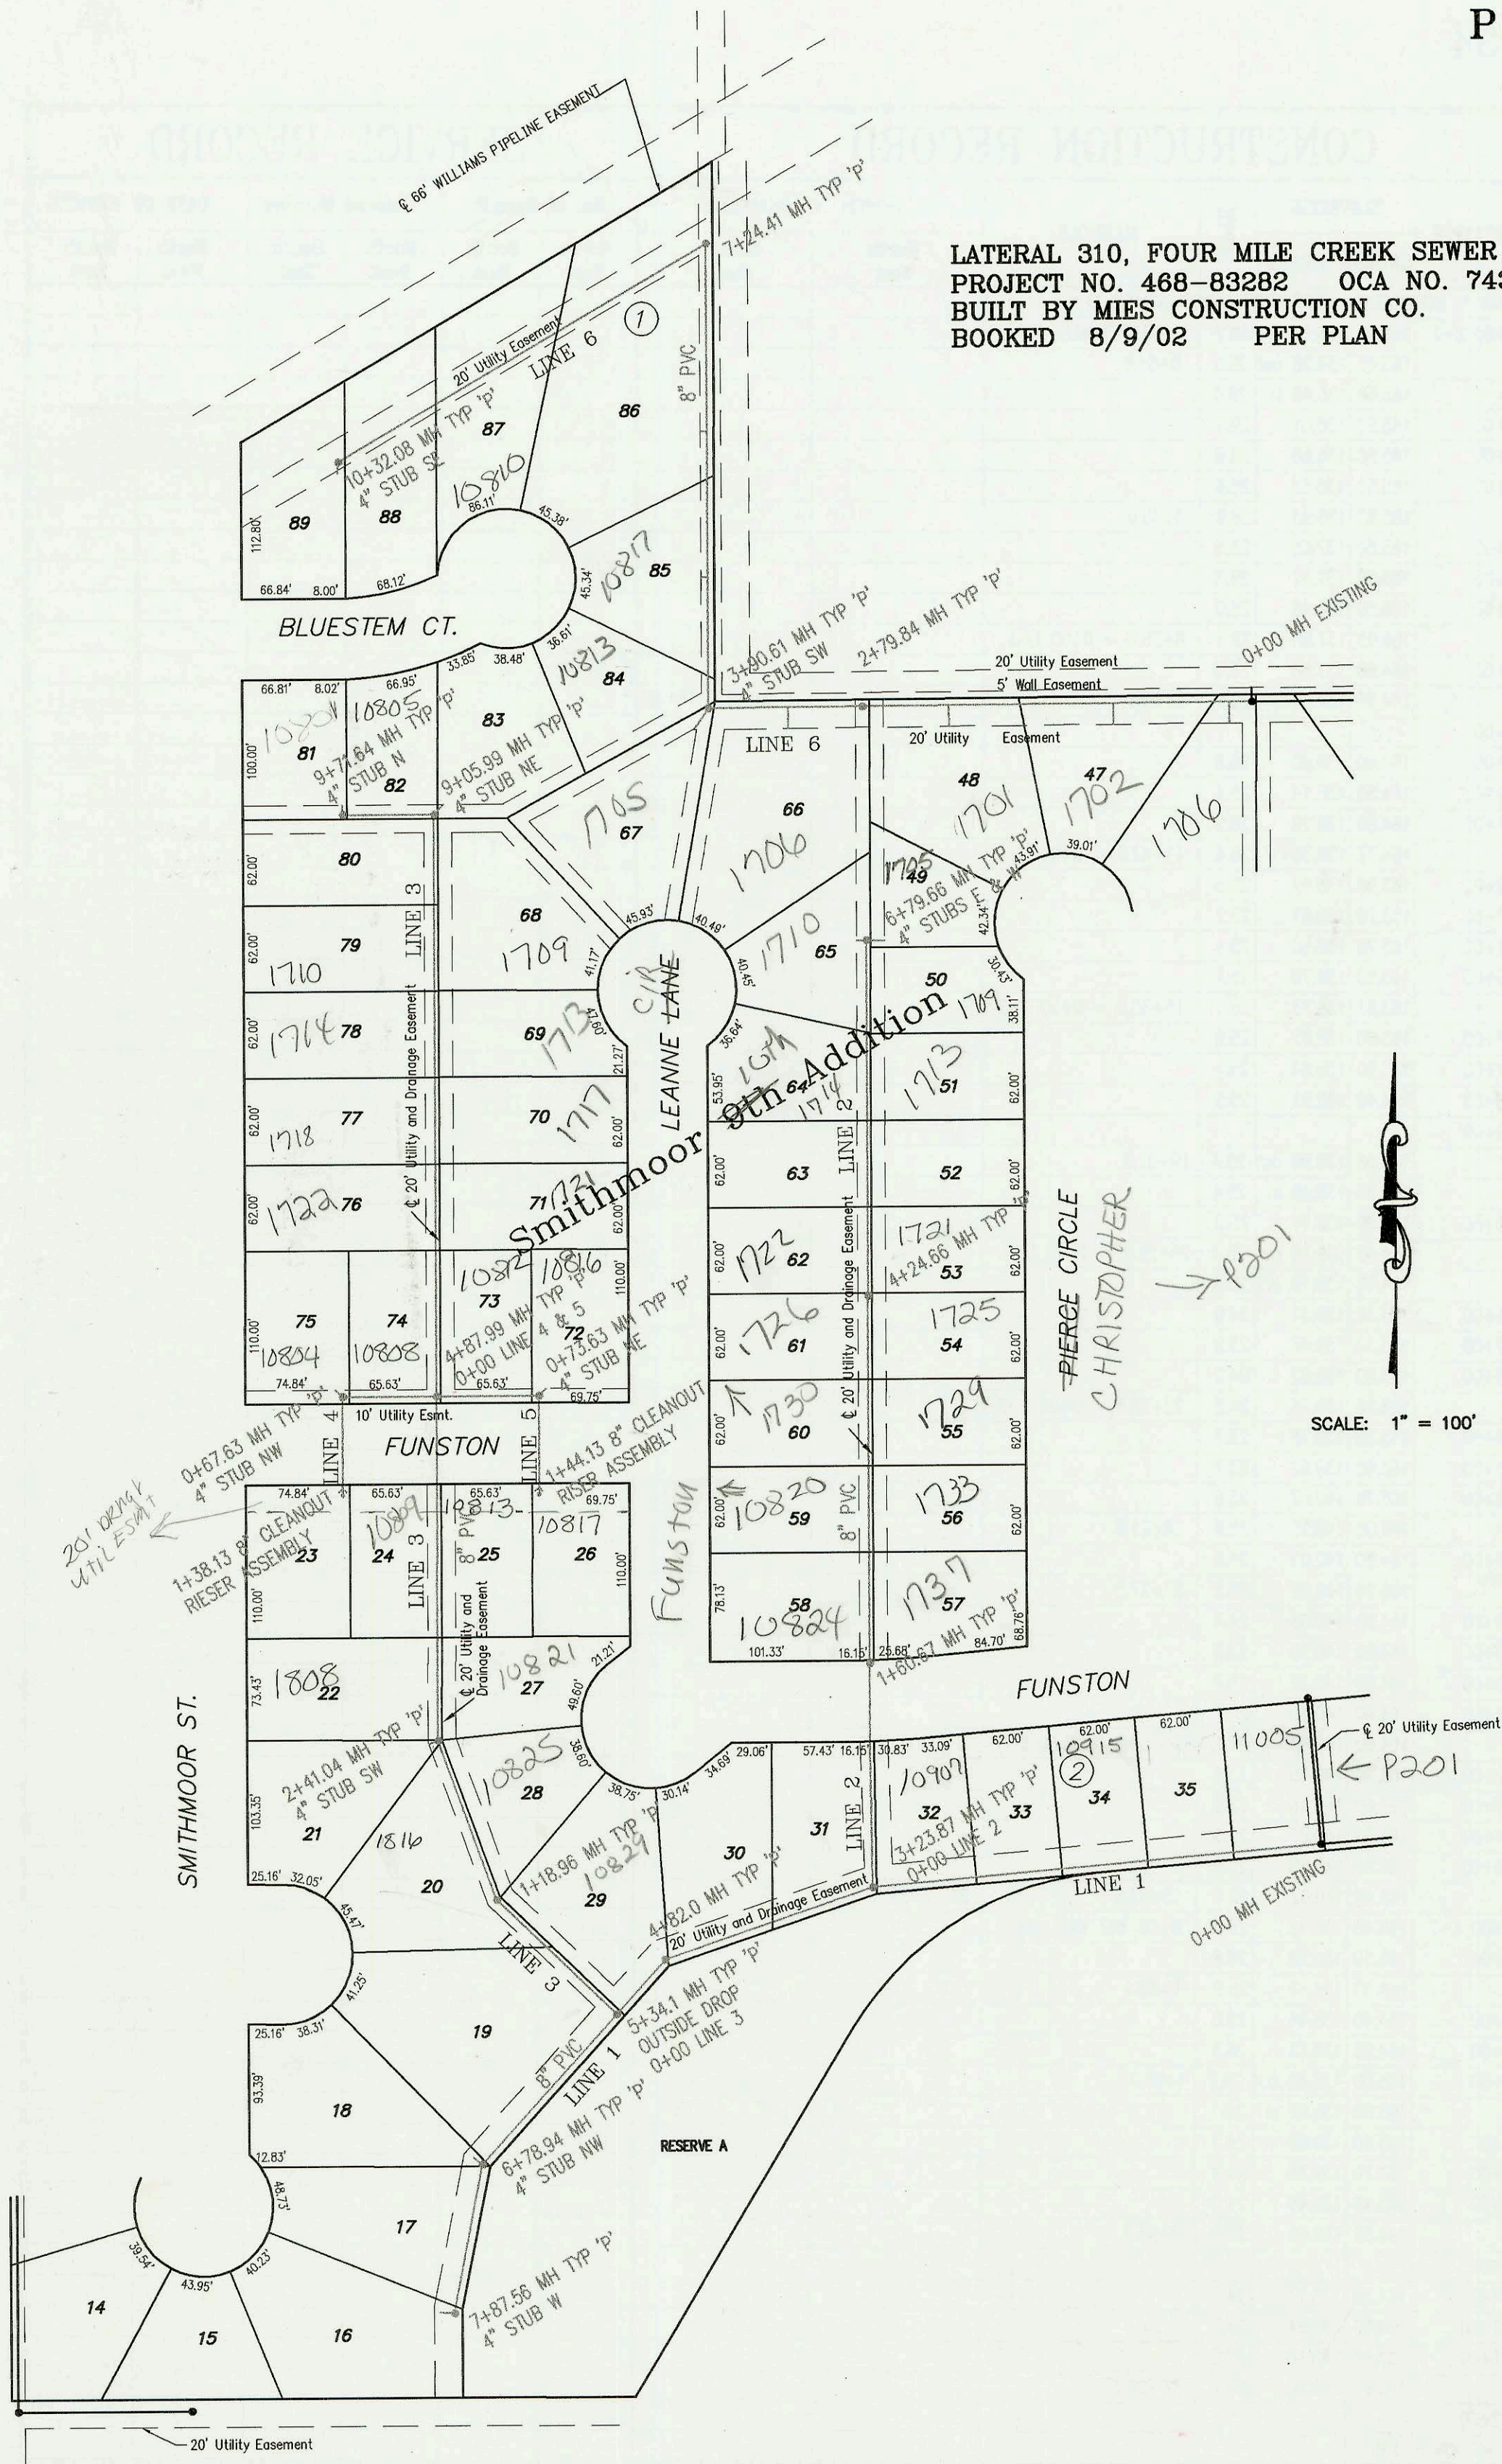

CONSTRUCTION RECORD					SERVICE RECORD								
STATION	ELEVATION		DEPTH	MANHOLE	4-INCH "Y" BRANCHES		No. of Permit		House Number		DATE OF PERMITS		
	GROUND	GRADE			North West	South East	North West	South East	North West	South East	North West	South East	
LATERAL 310, FOUR MILE CREEK			SEWER										
0+00 L-1	157.50	146.95	10.6	0+00 EXIST			2003-21079		11005 Funston			4-21-03	
1+00	157.30	147.35	10.0										
2+00	157.60	147.75	9.8				2003-00679		10915 Funston			3-19-03	
3+00	158.80	148.15	10.7				2003-02065		10907 Funston			9-29-04	
	159.60	148.25 out	11.3	3+23.87 = 0+00 L-2									
	159.60	148.35 in	11.3										
4+00	159.10	149.13	10.0										
	159.60	149.98 out	9.6	4+82.00									
	159.60	150.08 in	9.5										
5+00	159.10	150.15	9.0										
	159.70	150.39 out	9.3	5+34.09 = 0+00 L-3									
	159.70	154.39 in	5.3	OUTSIDE DROP									
6+00	160.90	150.88	10.0										
	163.66	157.68 out	6.0	6+78.94	4" STUB NW 158.11								
	163.66	157.78 in	5.9										
7+00	163.10	157.91	5.2										
	163.80	158.21	5.6	7+87.56	4" STUB W 158.54								
0+00 L-2	159.60	148.35	11.3	0+00 = 3+23.87 L-1									
1+00	158.60	148.75	9.8										
	159.20	148.99 out	10.2	1+60.67			2003-02608		10824 Funston			3-18-02	
	159.20	149.09 in	10.1										
2+00	159.10	150.51	8.6				2003-02355		10830 Funston			12-2-02	
3+00	160.80	151.58	9.2				2003-02225	2003-02007	1730 Leanne	1729 Christopher		8-25-03	11-2-02
							2003-01602	2003-02217	1720 Leanne	1725 Christopher		6-24-03	8-14-02
4+00	161.70	152.65	9.0										
	162.48	152.91 out	9.6	4+24.66									
	162.48	153.01 in	9.5					2003-02872	1721 Christopher			8-18-02	
5+00	162.70	153.81	8.9					2003-00412	1715 Christopher			2-14-03	
6+00	163.60	154.88	8.7				2003-00077	2003-02033	1709 Christopher	1705 Christopher		3-19-03	
	164.90	155.74	9.2	6+79.66	4" STUB W 156.07 4" STUB E 156.07		2003-01808		1710 Leanne			7-22-03	8-4-03
0+00 L-3	159.60	150.39	9.2	0+00 = 5+34.09 L-1									
1+00	160.10	150.79	9.3					2003-01375	10829 Funston			5-22-03	
	160.80	150.86 out	9.9	1+18.96									
	160.80	150.96 in	9.8		4" 4" SCH 40 PVC 1+91.6 tap		2003-02969	2003-00521	1810 Smithmor	10825 Funston		12-19-05	3-27-03
2+00	161.10	151.29	9.8					2003-01899	1801 Smithmor	10821 Funston		7-22-03	
	162.02	151.45 out	10.6	2+41.04	4" STUB SW 151.78		2004-00451		1808 Smithmor			2-20-04	
	162.02	151.55 in	10.5				2003-02303	2003-00678	10804 Funston	10813 E Funston		9-3-03	3-19-03
3+00	162.10	151.79	10.3										
4+00	164.20	152.19	12.0				2003-02749		10808 Funston			10-22-03	
	164.66	152.54 out	12.1	4+87.99 = 0+00 L-4 & L-5									
	164.66	152.64 in	12.0										
5+00	164.20	152.69	11.5				2004-00175	2002-03342	1722 Smithmor	1721 Leanne		11-20-04	12-1-02
6+00	163.20	153.09	10.1				2004-01243	2002-02499	1718 Smithmor	1717 Leanne		5-3-04	9-11-02
7+00	164.20	153.49	10.7				2003-00412	2003-01431	1714 Smithmor	1713 Leanne		2-24-05	5-21-03
8+00	165.20	153.89	11.3				2004-01683		1710 Smithmor			6-10-04	
9+00	165.90	154.29	11.6					2003-00676	17095 Leanne			3-19-03	
	166.40	154.31 out	12.1	9+05.99	4" STUB NE 154.72								
	166.40	154.41 in	12.0				2003-02464		10805 Bluestem			9-23-03	
	165.30	154.67	10.6	9+71.64	4" STUB N 154.98								
0+00 L-4	164.66	152.64	12.0	0+00 = 4+87.99 L-3									
	166.11	154.07 out	12.0	0+67.63	4" STUB NW 154.40								
	166.11	154.17 in	11.9										
1+00	165.50	154.45	11.1	1+38.13 8" CLEANOUT RISER									
0+00 L-5	164.66	152.64	12.0	0+00 = 4+87.99 L-3									
	163.09	152.93 out	10.2	0+73.63	4" STUB NE 153.26		2003-01791		10810 Funston			7-9-03	
	163.09	153.03 in	10.1										
1+00	162.70	153.31	9.4	1+44.13 8" CLEANOUT RISER									