


MAIN 1, PUMP STATION & FORCE MAIN (PART A),  
NORTHWEST INTERCEPTOR SEWER  
PROJECT NO. 468-83130 (624058)  
BUILT BY WILDCAT CONSTRUCTION CO.  
8/21/02 PER AS BUILT PLAN



SCALE: 1" = 150'

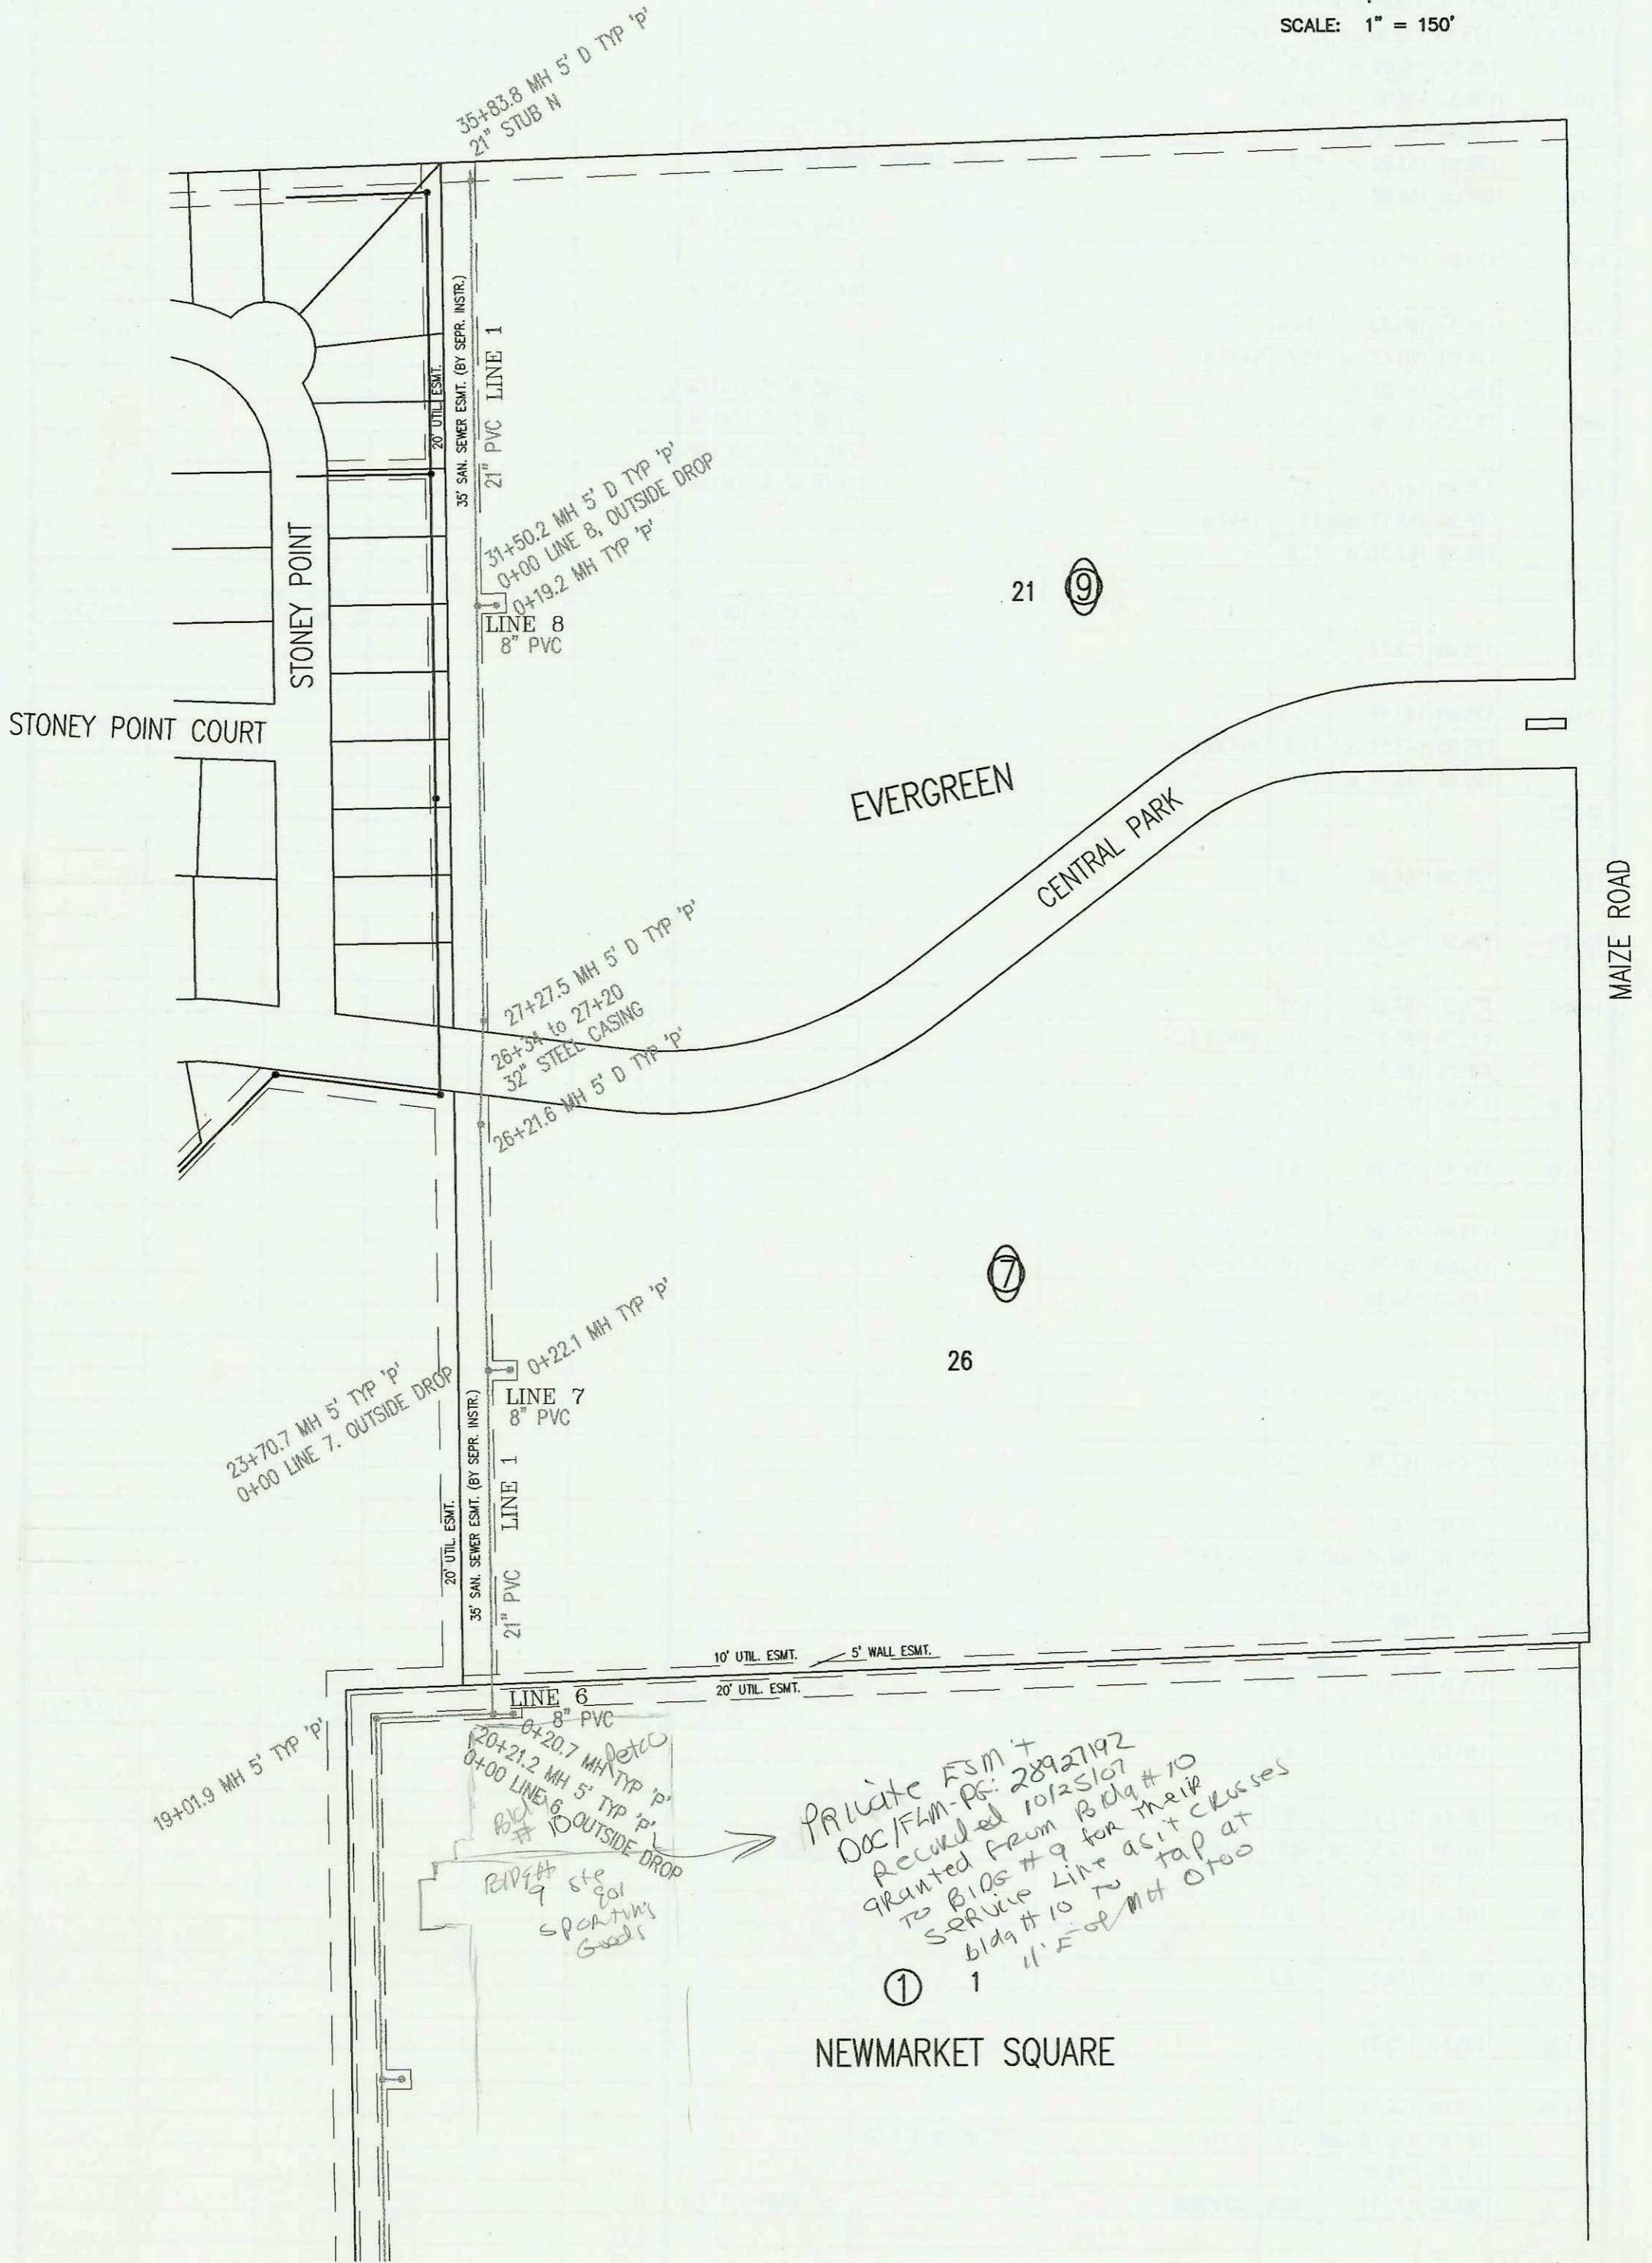

CONSTRUCTION RECORD					SERVICE RECORD							
STATION	ELEVATION		DEPTH	MANHOLE	4-INCH "Y" BRANCHES		No. of Permit		House Number		DATE OF PERMITS	
	GROUND	GRADE			North West	South East	North West	South East	North West	South East	North West	South East
MAIN 1, NORTHWEST INTERCEPTOR SEWER (PHASE A) CONT. FROM P-234												
13+00	163.60	140.38	23.2									
	164.21	140.46	23.8	13+62.2		15" STUB E 140.49						
0+00 L-3	166.03	137.53 out	28.5	0+00 = 6+25.6 L-1								
	166.03	142.50 in	23.5	OUTSIDE DROP								
1+00	162.60	142.79	19.8									
2+00	162.60	143.09	19.5									
3+00	162.60	143.38	19.2									
4+00	163.60	143.68	19.9									
	165.10	143.80	21.3	4+42.5 EXIST MH		8" E 152.00						
0+00 L-4	164.77	138.39 out	26.4	0+00 = 11+67.9 L-1								
	164.77	156.88 in	7.9	OUTSIDE DROP								
	166.27	157.17	9.1	0+27.4	6" STUB E 157.46	6" STUB SE 157.20						
0+00 L-5	163.83	138.73 out	25.1	0+00 = 15+36.8 L-1								
	163.83	156.63 in	7.2	OUTSIDE DROP								
	165.47	157.23	8.2	0+27.6	6" STUB NE 157.47	6" STUB SE 157.48						
0+00 L-6	164.49	139.18 out	25.3	0+00 = 20+21.2 L-1								
	164.49	151.64 in	12.9	OUTSIDE DROP								
	164.51	151.85	12.7	0+20.7								
0+00 L-7	163.96	139.74 out	24.2	0+00 = 23+70.7 L-1								
	163.96	151.16 in	12.8	OUTSIDE DROP								
	163.96	151.31	12.7	0+22.1								
0+00 L-8	164.55	140.49 out	24.1	0+00 = 31+54.9 L-1								
	164.55	151.73 in	12.8	OUTSIDE DROP								
	164.74	152.04	12.7	0+20.0								
0+00 L-9	162.90	158.50	4.4									
0+52.52	165.00	158.50	6.5	45 Degree BEND								
1+00	164.80	158.61	6.2									
2+00	164.40	158.72	5.7									
3+00	164.30	158.84	5.5									
3+95.61	165.00	158.94	6.1	45 Degree BEND								
4+00	165.00	158.95	6.1									
4+44.09	165.40	161.29	4.1	GATE VALVE								
4+49.59	166.00	161.29	4.7	TIE IN MANHOLE								