



BURLINGTON NORTHERN AND SANTA FE RAILROAD RIGHT-OF-WAY

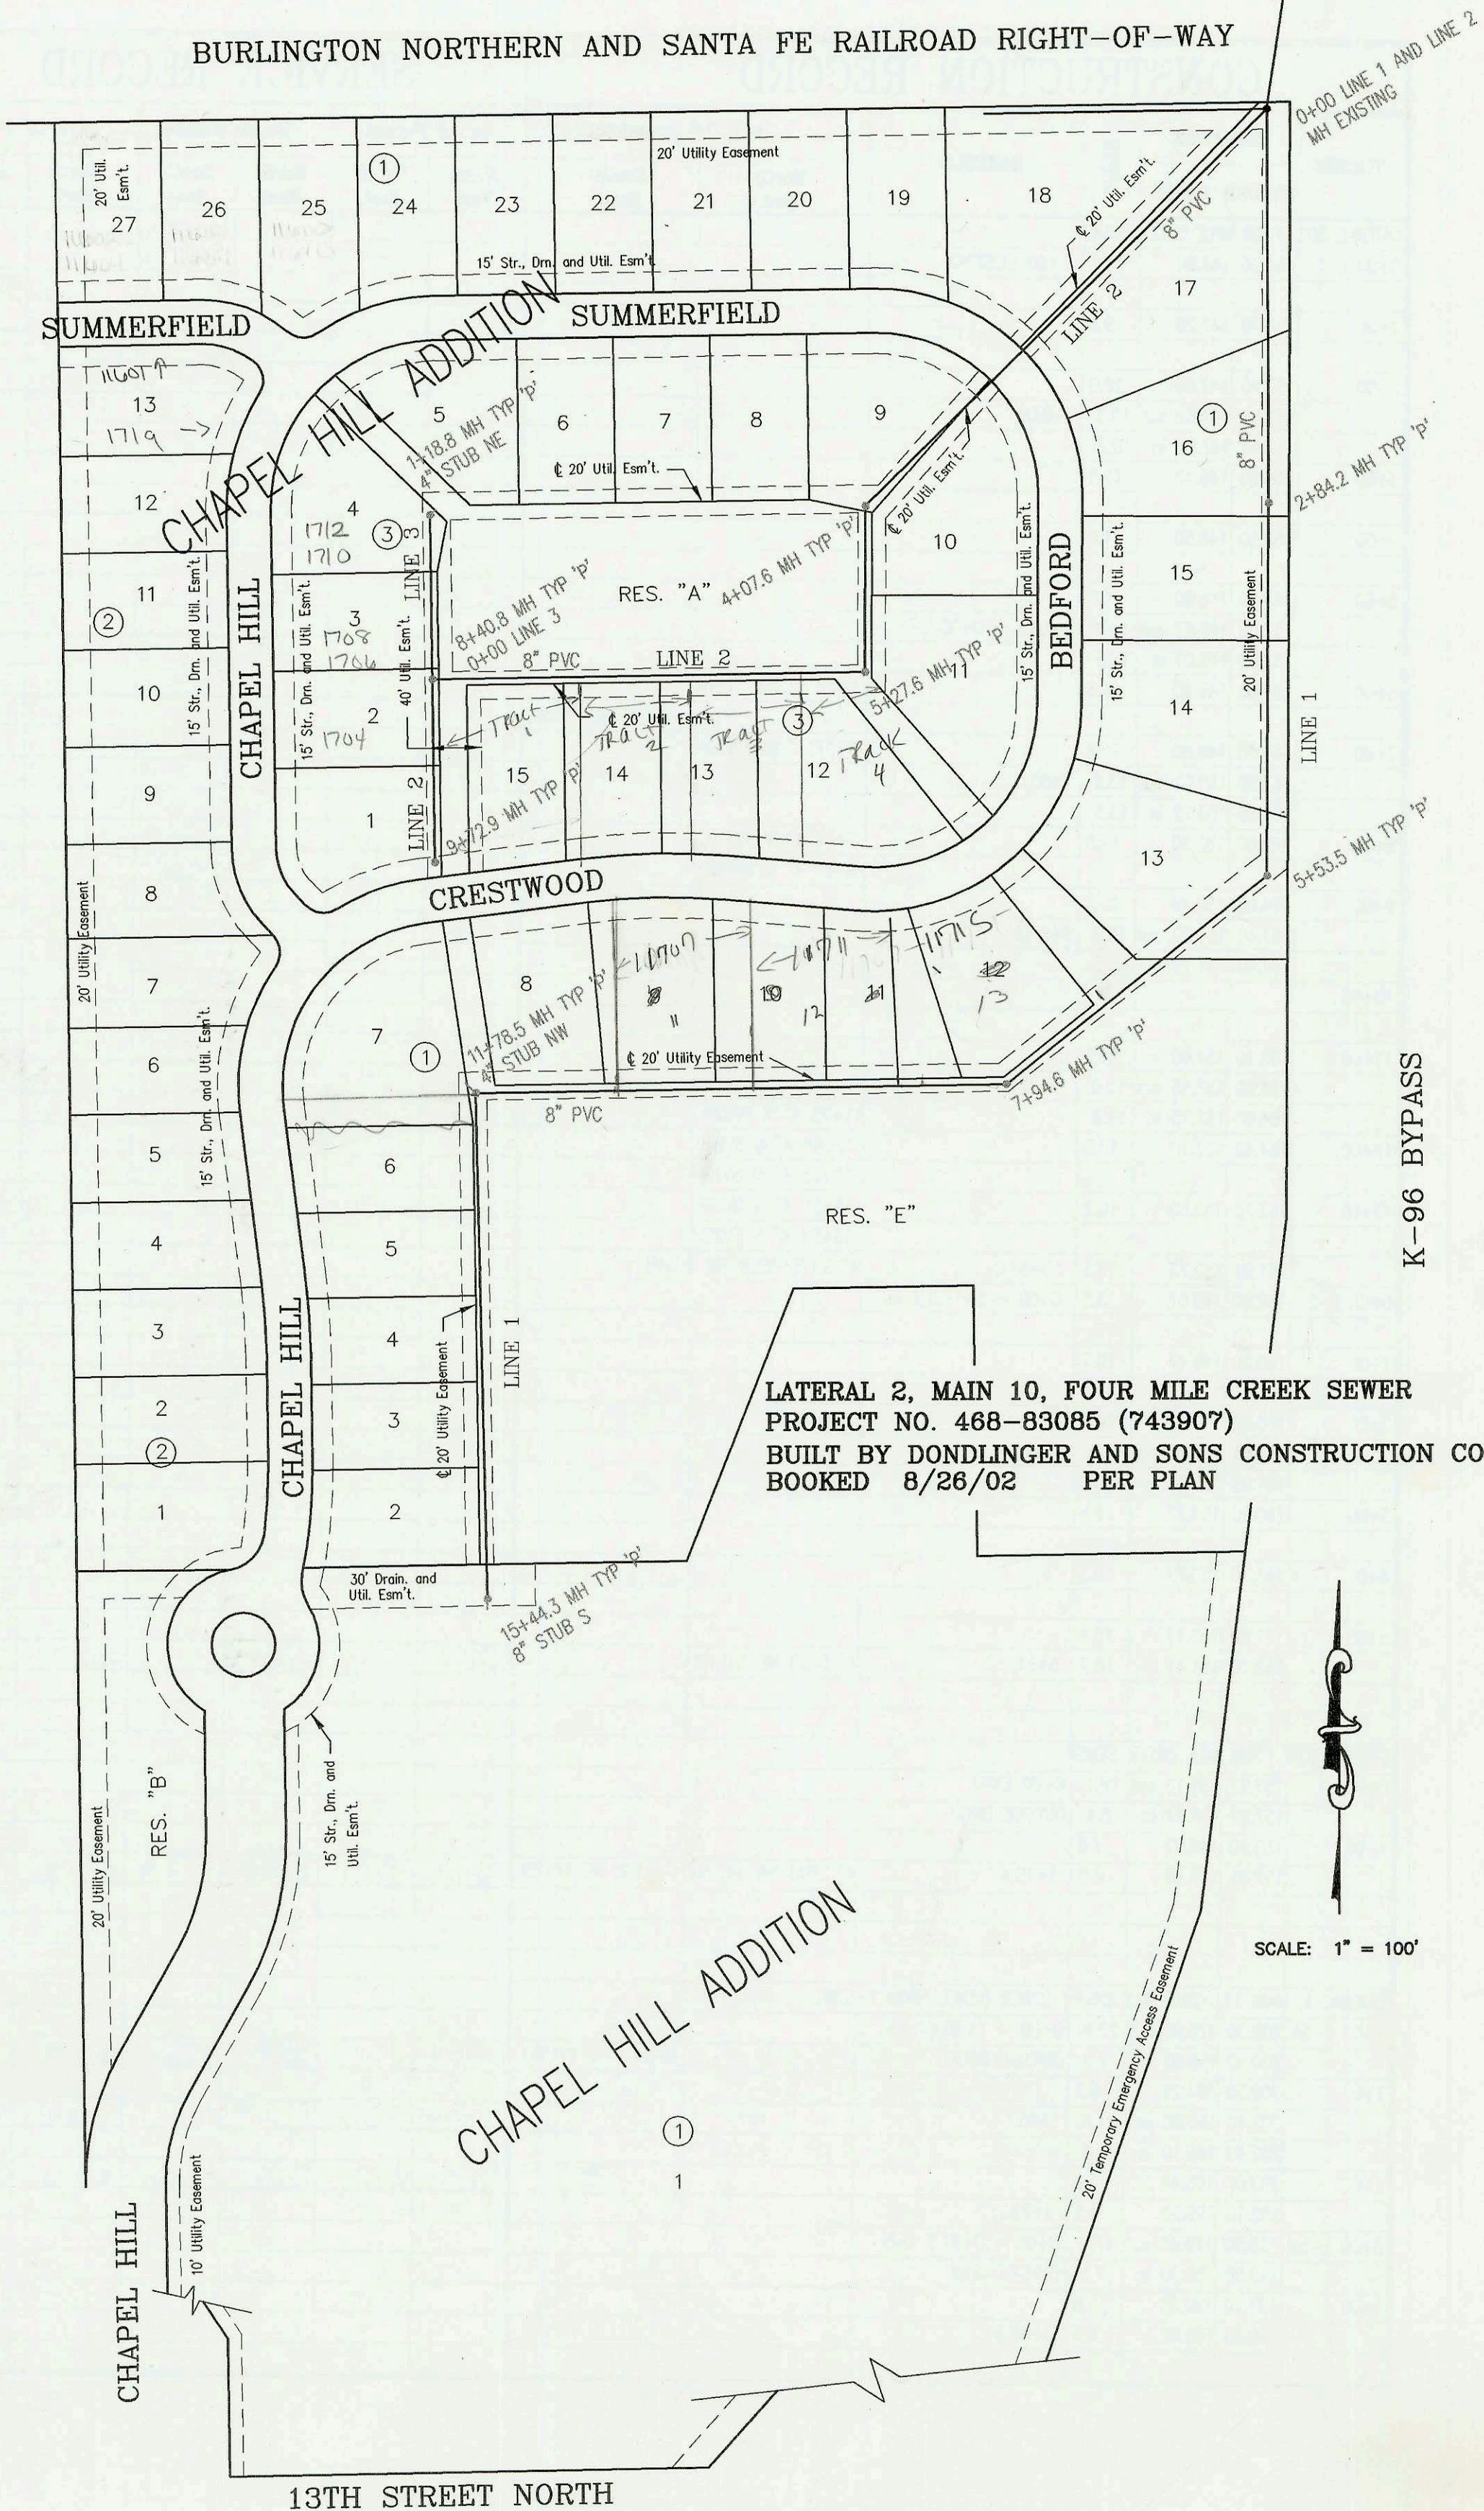

LATERAL 2, MAIN 10, FOUR MILE CREEK SEWER  
 PROJECT NO. 468-83085 (743907)  
 BUILT BY DONDLINGER AND SONS CONSTRUCTION CO.  
 BOOKED 8/26/02 PER PLAN

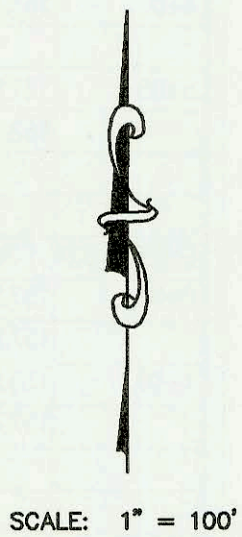

SCALE: 1" = 100'

K-96 BYPASS

CONSTRUCTION RECORD						SERVICE RECORD						
STATION	ELEVATION		DEPTH	MANHOLE	4-INCH "Y" BRANCHES		No. of Permit		House Number		DATE OF PERMITS	
	GROUND	GRADE			North West	South East	North West	South East	North West	South East	North West	South East
LATERAL 2, MAIN 10, FOUR MILE CREEK SEWER												
0+00 L-1	176.90	159.66	17.2	0+00 EXIST = 0+00 L-2								
					0+80 4" W 11V5H							
1+00	174.60	160.06	14.5									
2+00	175.00	160.46	14.5		2+25 4" W 10V4H							
	175.70	160.80 out	14.9	2+84.2								
	175.70	161.00 in	14.7									
3+00	175.30	161.06	14.2									
					3+35 4" W 10V4H							
4+00	174.50	161.46	13.0									
					4+40 4" W 9V3H							
5+00	173.80	161.86	11.9									
	173.80	162.07 out	11.7	5+53.5								
	173.80	162.27 in	11.5									
6+00	173.60	162.46	11.1									
7+00	174.40	162.86	11.5									
	174.70	163.24 out	11.5	7+94.6								
	174.70	163.44 in	11.3									
8+00	174.30	163.46	10.8									
9+00	174.50	163.86	10.6									
10+00	174.40	164.26	10.1									
11+00	174.30	164.66	9.6									
	175.20	164.97 out	10.2	11+78.5	4" STUB NW 165.30							
	175.20	165.17 in	10.0									
12+00	174.60	165.26	9.3									
13+00	174.40	165.66	8.7									
14+00	174.40	166.06	8.3									
15+00	174.60	166.46	8.1									
	176.20	166.64	9.6	15+44.3	8" STUB S 166.84							
0+00 L-2	176.90	159.46 out	17.4	0+00 EXIST = 0+00 L-1								
	176.90	162.96 in	13.9									
1+00	177.50	163.36	14.1									
2+00	178.40	163.76	14.6									
3+00	178.80	164.16	14.6									
4+00	180.50	164.56	15.9									
	181.10	164.59 out	16.5	4+07.6								
	181.10	164.79 in	16.3									
5+00	180.00	165.16	14.8									
	180.20	165.27 out	14.9	5+27.6								
	180.20	165.47 in	14.7									
6+00	180.10	165.76	14.3									
7+00	179.90	166.16	13.7									
8+00	179.90	166.56	13.3									
	180.40	166.72 out	13.7	8+40.8 = 0+00 L-3								
	180.40	166.92 in	13.5									
9+00	179.00	167.16	11.8									
	177.10	167.45	9.7	9+72.9								
0+00 L-3	180.40	166.92	13.5	0+00 = 8+40.8 L-2								
1+00	181.00	167.32	13.7									
	181.40	167.40	14.0	1+18.8	4" STUB NE 167.73							