


# SANITARY SEWER EXTENSION to serve LEGACY 3RD ADDITION PHASE 4 CITY OF WICHITA, KANSAS

Gary Janzen, P.E. City Engineer  
Project Number 468-2020-024507  
O.C.A. NO. 810124

McCullough - Contractor  
K. Kerns - City of Wichita, Field Project Engineer  
S. Strippling - City of Wichita, Inspector  
As-built  
Release Date: n/a  
Completion Date: 4/8/2021  
pdf: apr 2/11/2022

E0088  
47263020

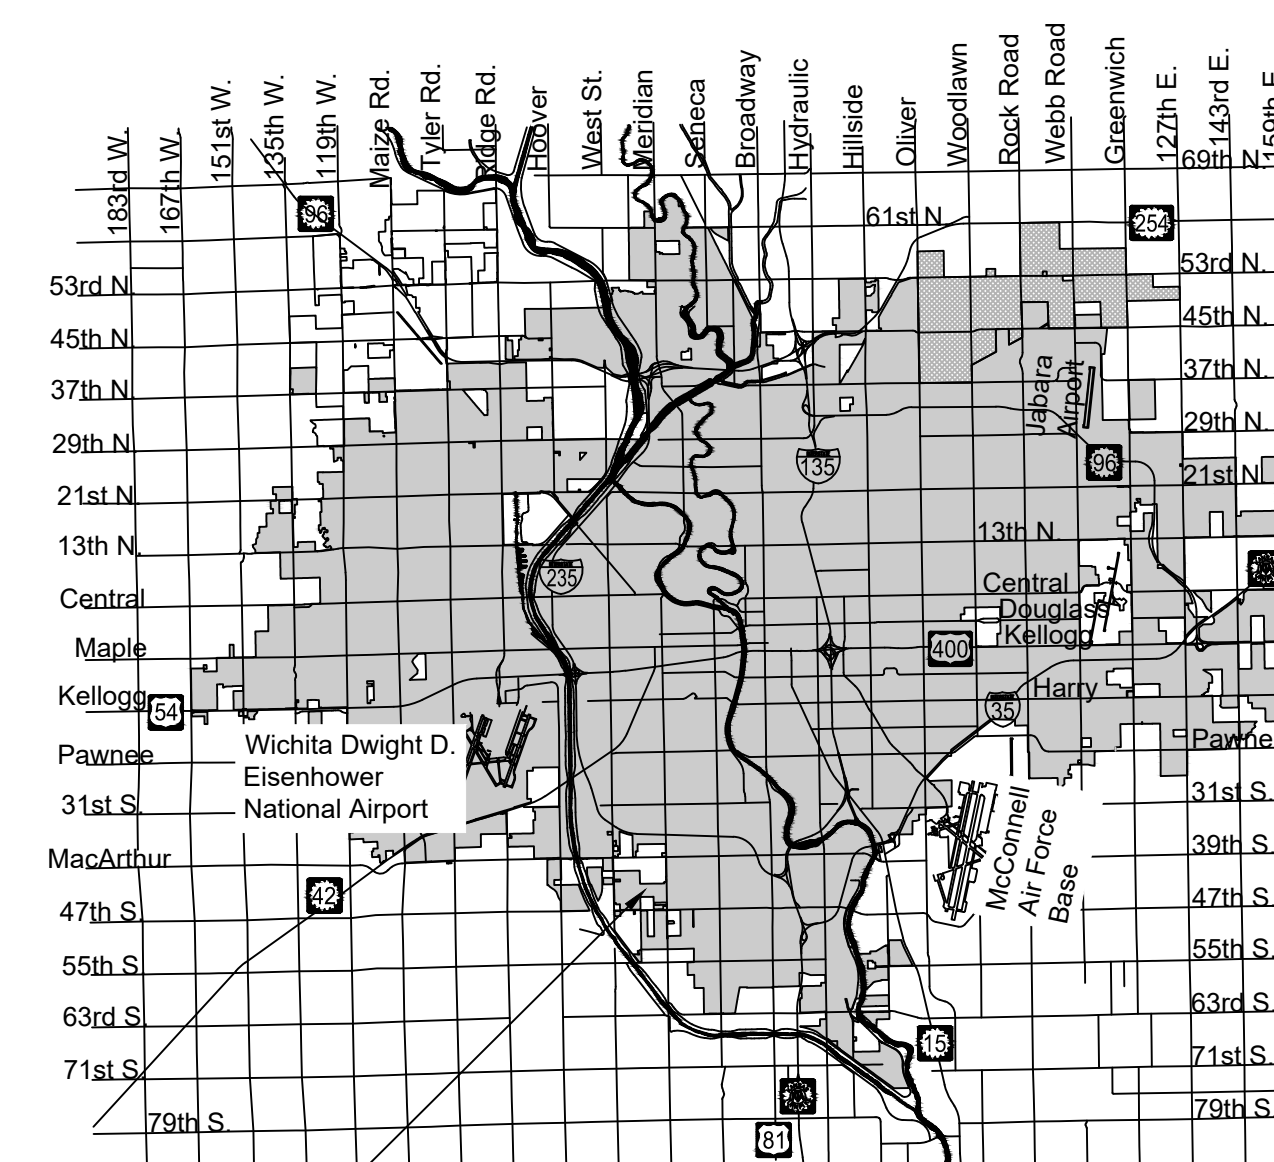



© 2020 GARVER, LLC  
 THIS DOCUMENT, ALONG WITH THE IDEAS AND DESIGNS CONVEYED HEREIN, SHALL BE CONSIDERED INSTRUMENTS OF PROFESSIONAL SERVICE AND ARE PROPERTY OF GARVER, LLC. ANY USE, REPRODUCTION, OR DISTRIBUTION OF THIS DOCUMENT, ALONG WITH THE IDEAS AND DESIGN CONTAINED HEREIN, IS PROHIBITED UNLESS AUTHORIZED IN WRITING BY GARVER, LLC OR EXPLICITLY ALLOWED IN THE GOVERNING PROFESSIONAL SERVICES AGREEMENT FOR THIS WORK.

8535 E. 21st Street N.  
 Suite 130  
 Wichita, KS 67206  
 (316) 264-8008



REV.	DATE	DESCRIPTION	BY



CITY OF WICHITA  
 WICHITA, KANSAS

LEGACY 3RD  
 ADDITION  
 SANITARY SEWER




SS 1

JOB NO.: 20T41006  
 DATE: Dec 2020  
 DESIGNED BY: #  
 DRAWN BY: #

BAR IS ONE INCH ON ORIGINAL DRAWING  
 IF NOT ONE INCH ON THIS SHEET, ADJUST SCALES ACCORDINGLY.




DRAWING NUMBER

SHEET NUMBER **4** OF **16**

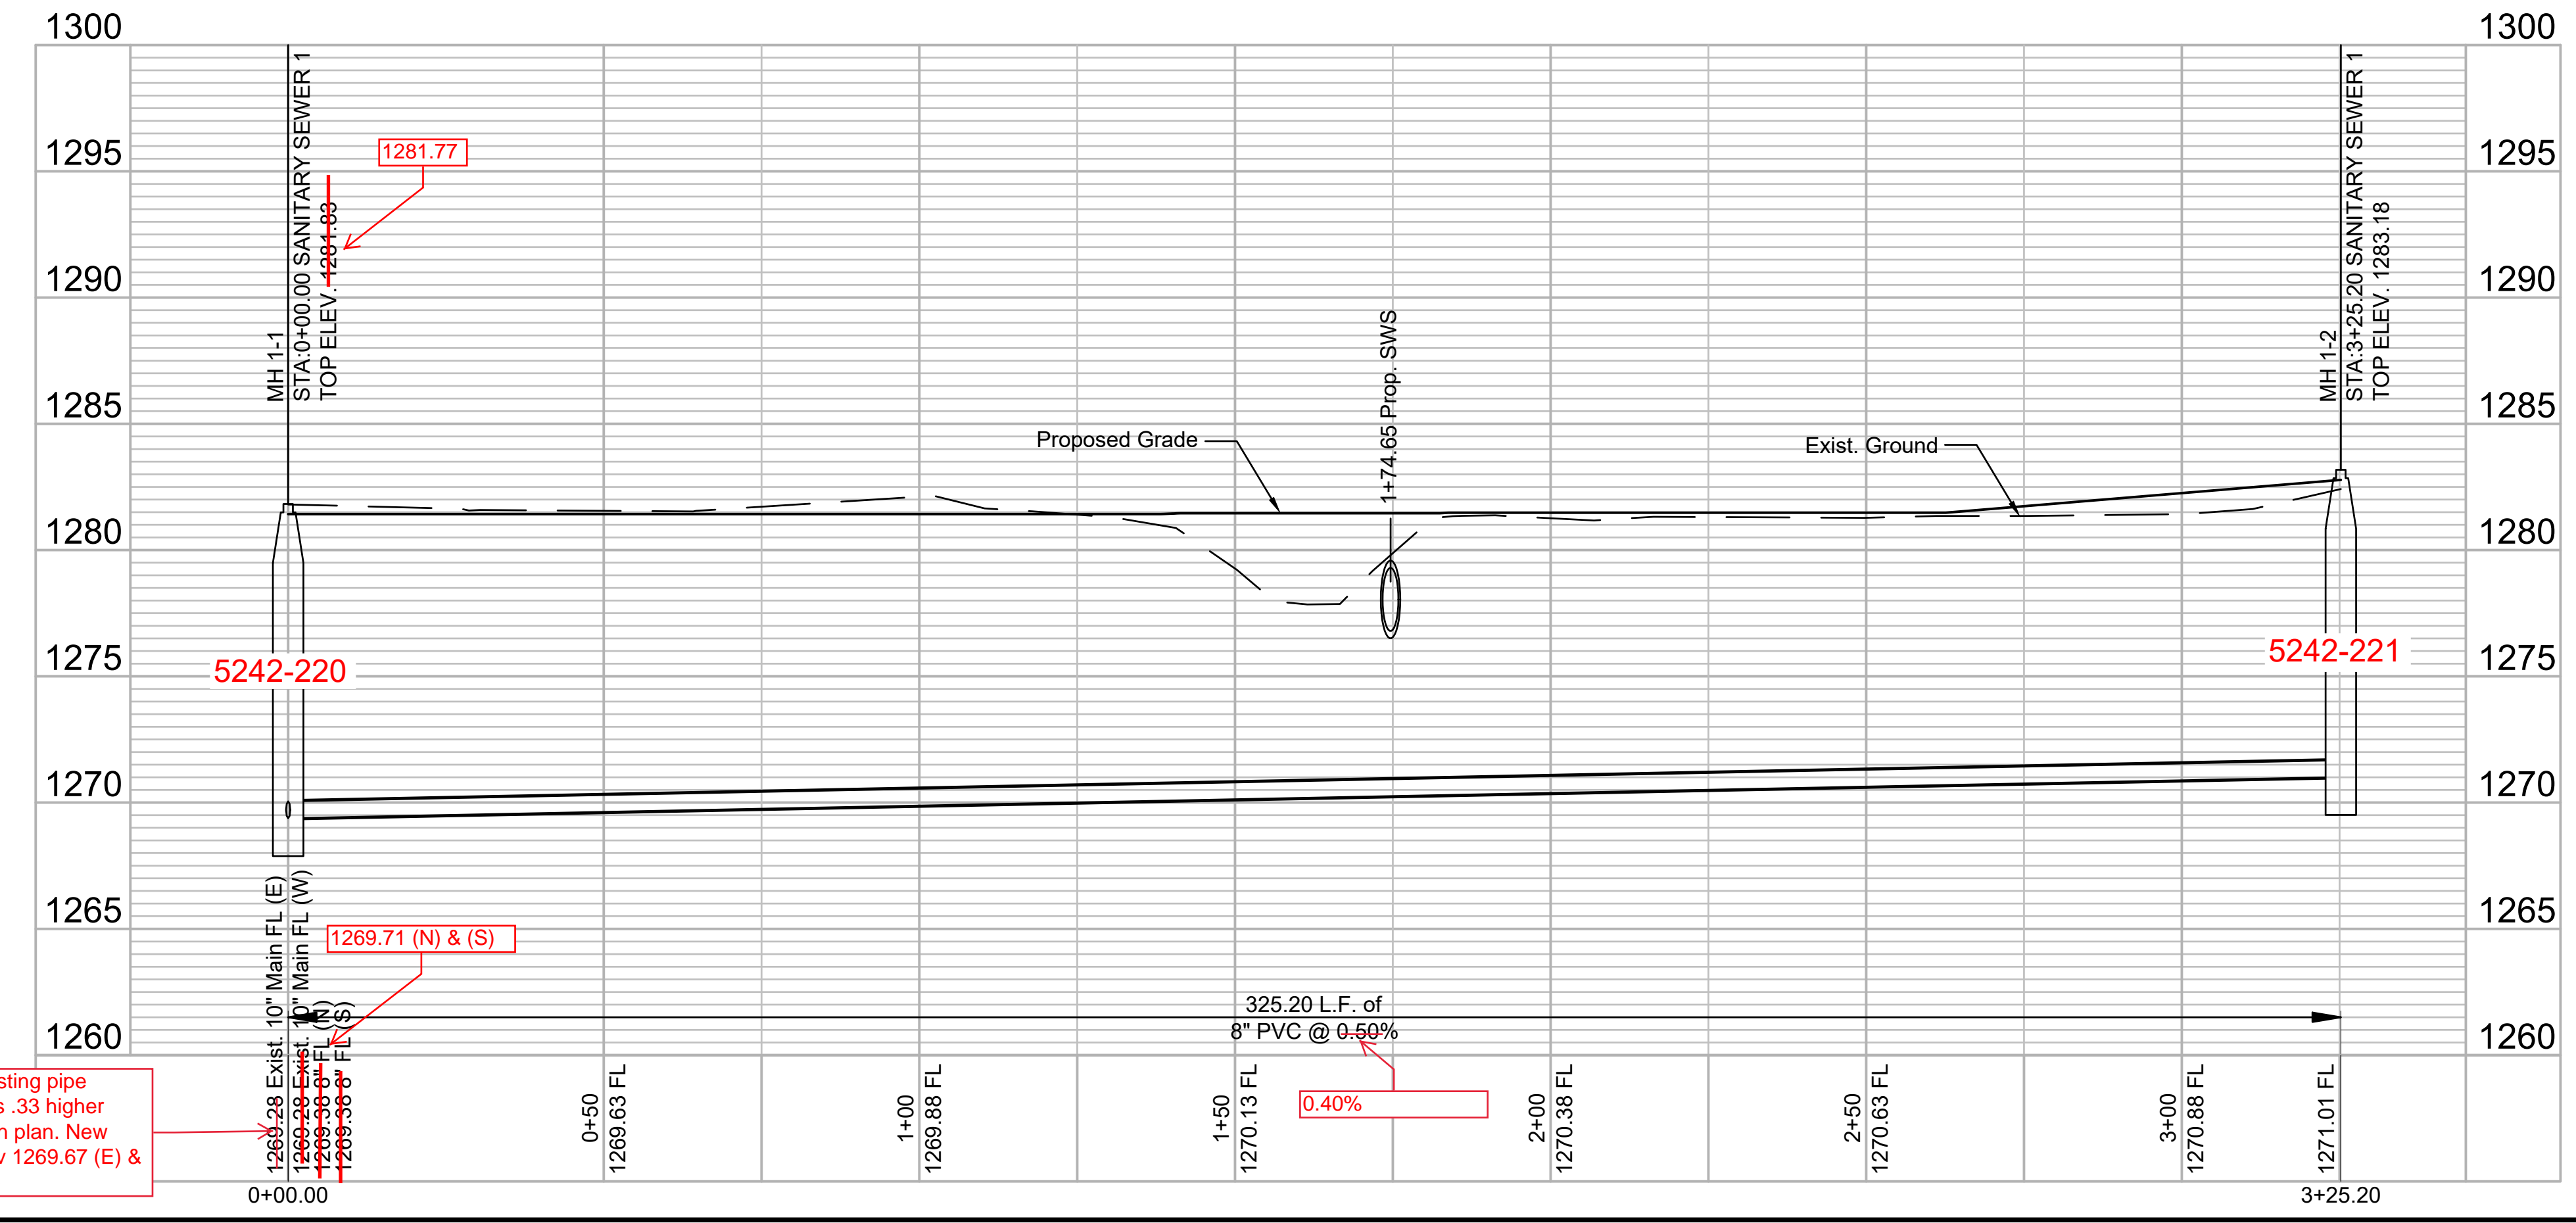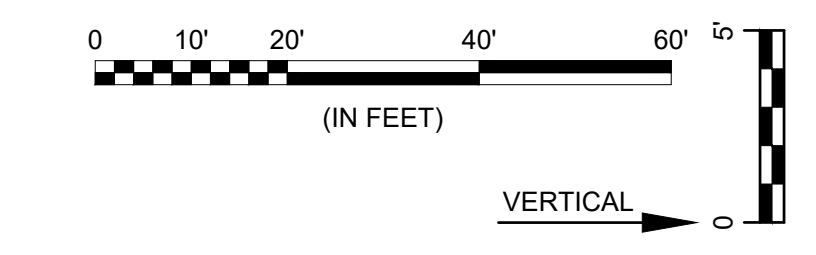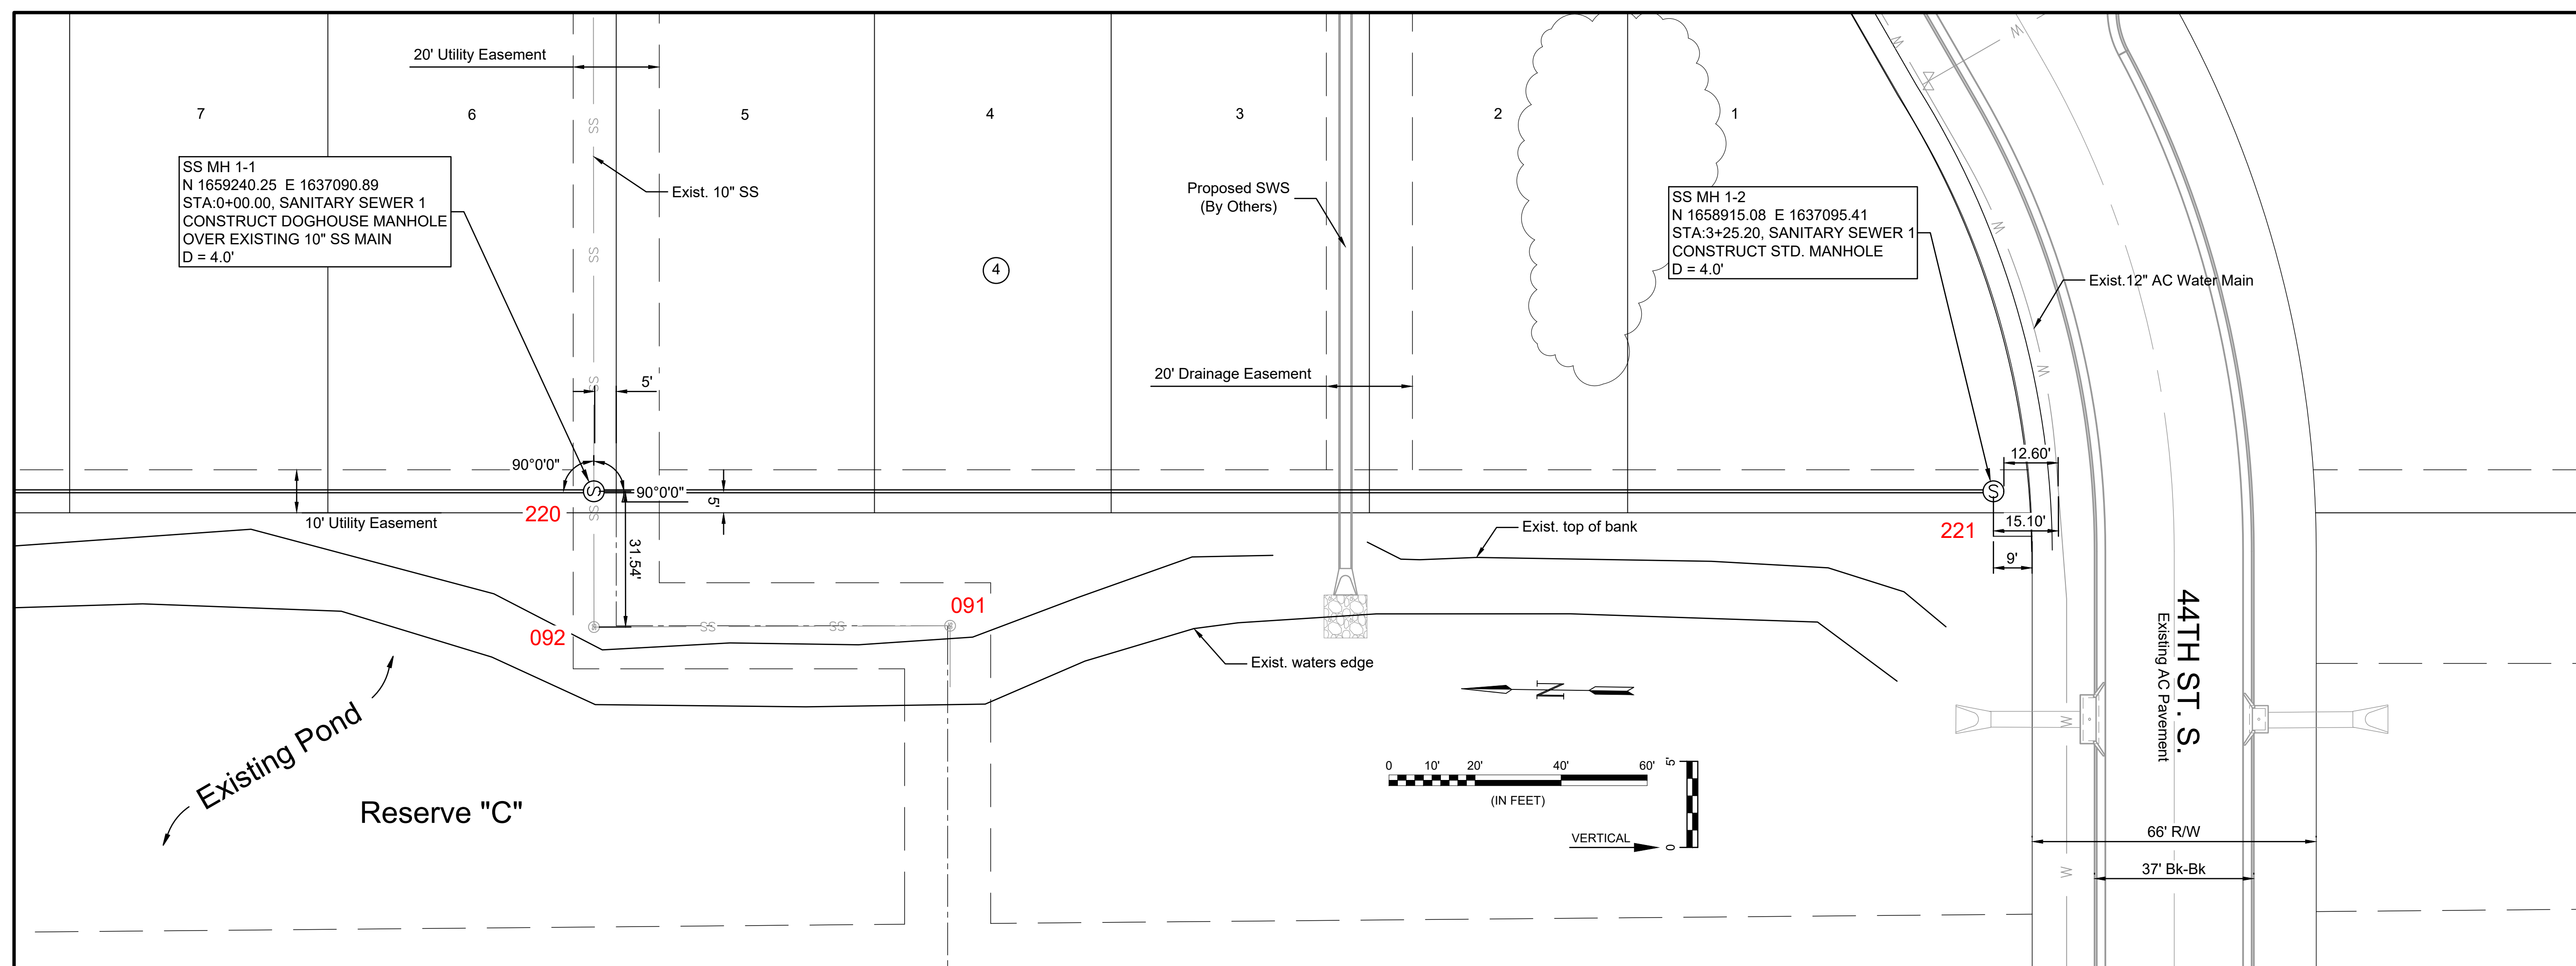

File: L:\2020\20T41006 - Legacy 3rd Addition Imp Last Phase\Drawings\C3D\Sanitary Sewer Sheets\20T41006 SS 1.dwg Last Save: 12/21/2020 2:32 PM Last saved by: MCarreraPiedra  
 Last plotted by: Carrera-Piedra, Mariela Plot Style: ---- Plot Scale: 1:2,984.9 Plot Date: 12/21/2020 2:44 PM Plotter used: None

File: L:\2020\20T41006 - Legacy 3rd Addition Imp Last Phase\Drawings\C3D\Sanitary Sewer Sheets\20T41006 SS 2.dwg Last Save: 12/21/2020 2:30 PM Last saved by: McCarreraPiedra  
 Last plotted by: Carrera-Piedra, Mariela Plot Date: 12/21/2020 2:44 PM Plotter used: None

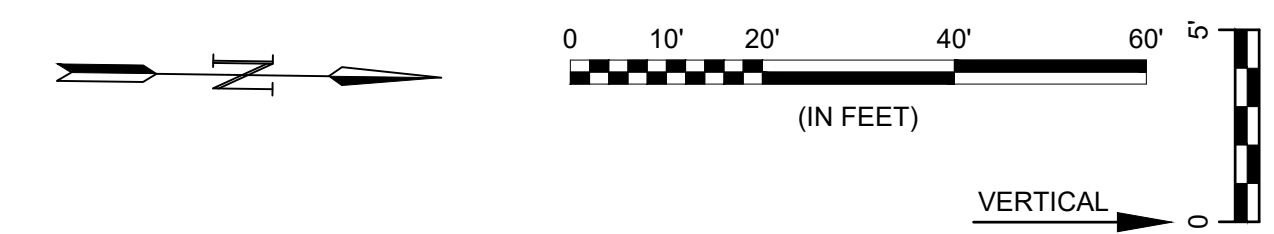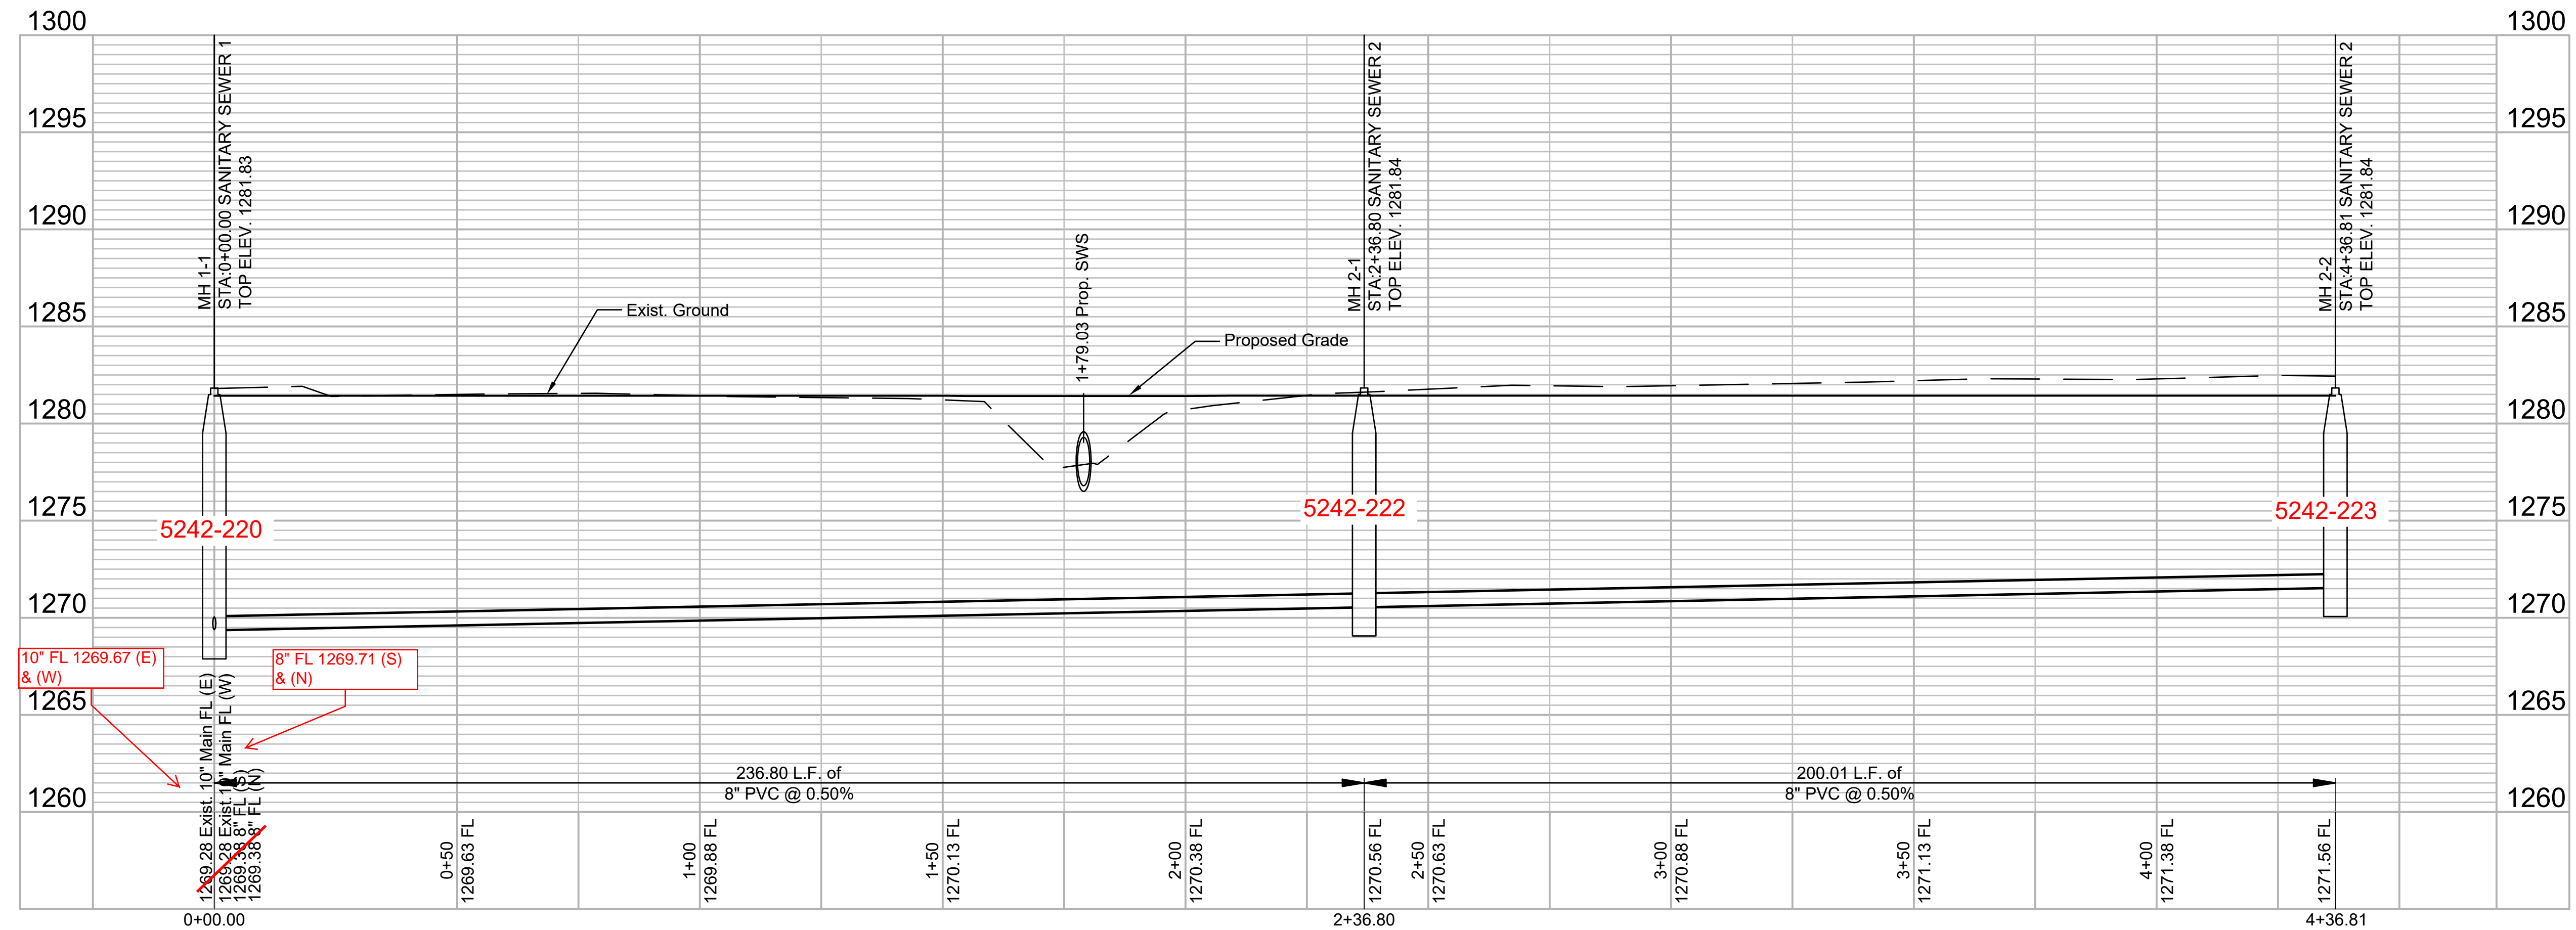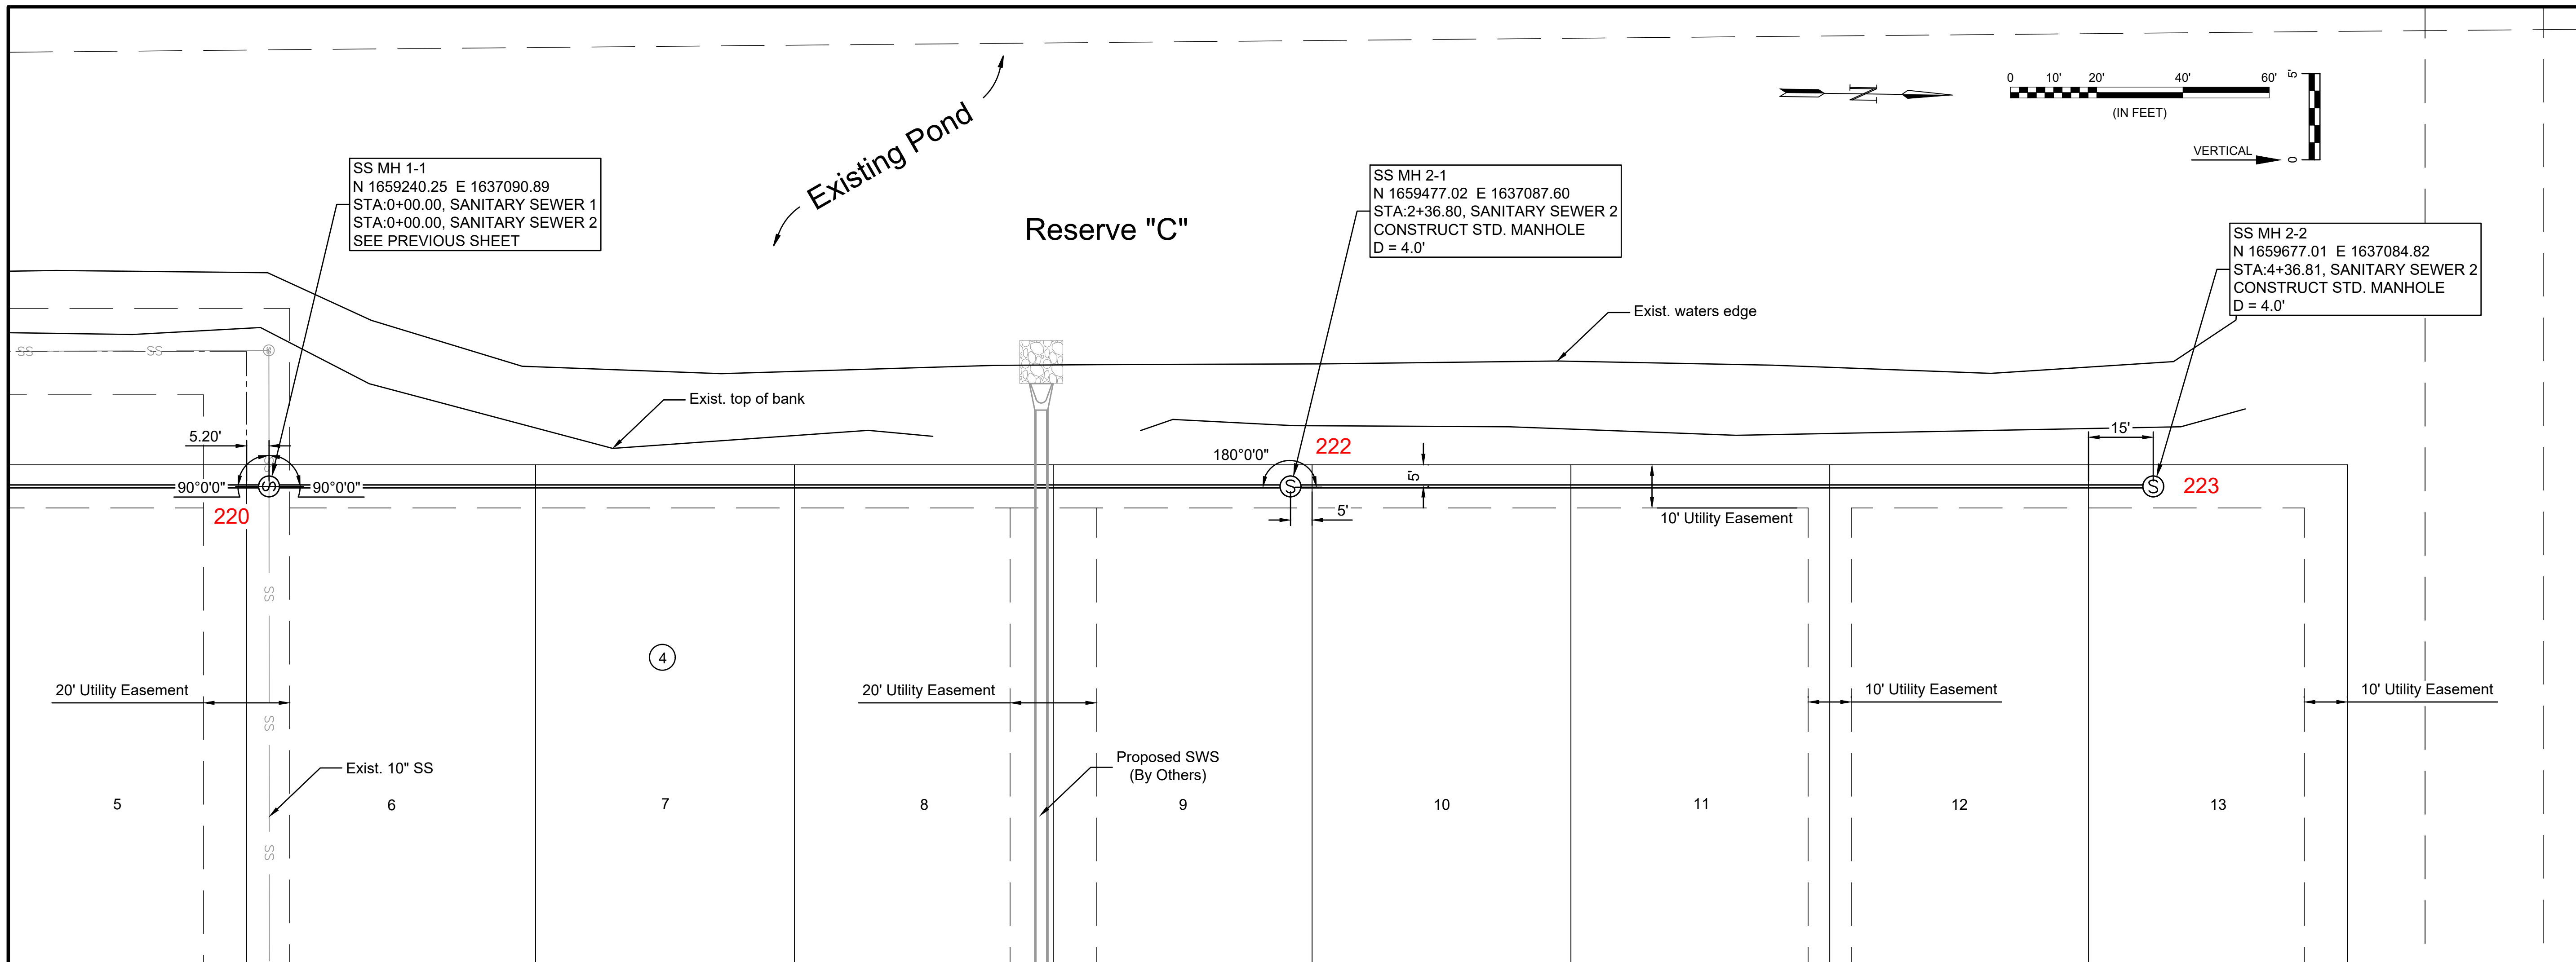

© 2020 GARVER, LLC  
 THIS DOCUMENT, ALONG WITH THE IDEAS AND DESIGNS CONVEYED HEREIN, SHALL BE CONSIDERED INSTRUMENTS OF PROFESSIONAL SERVICE AND ARE PROPERTY OF GARVER, LLC. ANY USE, REPRODUCTION, OR DISTRIBUTION OF THIS DOCUMENT, ALONG WITH THE IDEAS AND DESIGN CONTAINED HEREIN, IS PROHIBITED UNLESS AUTHORIZED IN WRITING BY GARVER, LLC OR EXPLICITLY ALLOWED IN THE GOVERNING PROFESSIONAL SERVICES AGREEMENT FOR THIS WORK.

8535 E. 21st Street N.  
 Suite 130  
 Wichita, KS 67206  
 (316) 264-8008



REV.	DATE	DESCRIPTION	BY



LEGACY 3RD ADDITION SANITARY SEWER




SS 2

JOB NO.: 20T41006  
 DATE: Dec 2020  
 DESIGNED BY: #  
 DRAWN BY: #

BAR IS ONE INCH ON ORIGINAL DRAWING  
 IF NOT ONE INCH ON THIS SHEET, ADJUST SCALES ACCORDINGLY.

DRAWING NUMBER  
 SHEET NUMBER **5** OF **16**

File: L:\2020\20T41006 - Legacy 3rd Addition Imp Last Phase\Drawings\C3D\Sanitary Sewer Sheets\20T41006 SS 3.dwg Last Save: 12/21/2020 7:51 AM Last saved by: MCarrera\Pledra  
 Last plotted by: Carrera-Pledra, Mariela Plot Date: 12/21/2020 2:45 PM Plotter used: None

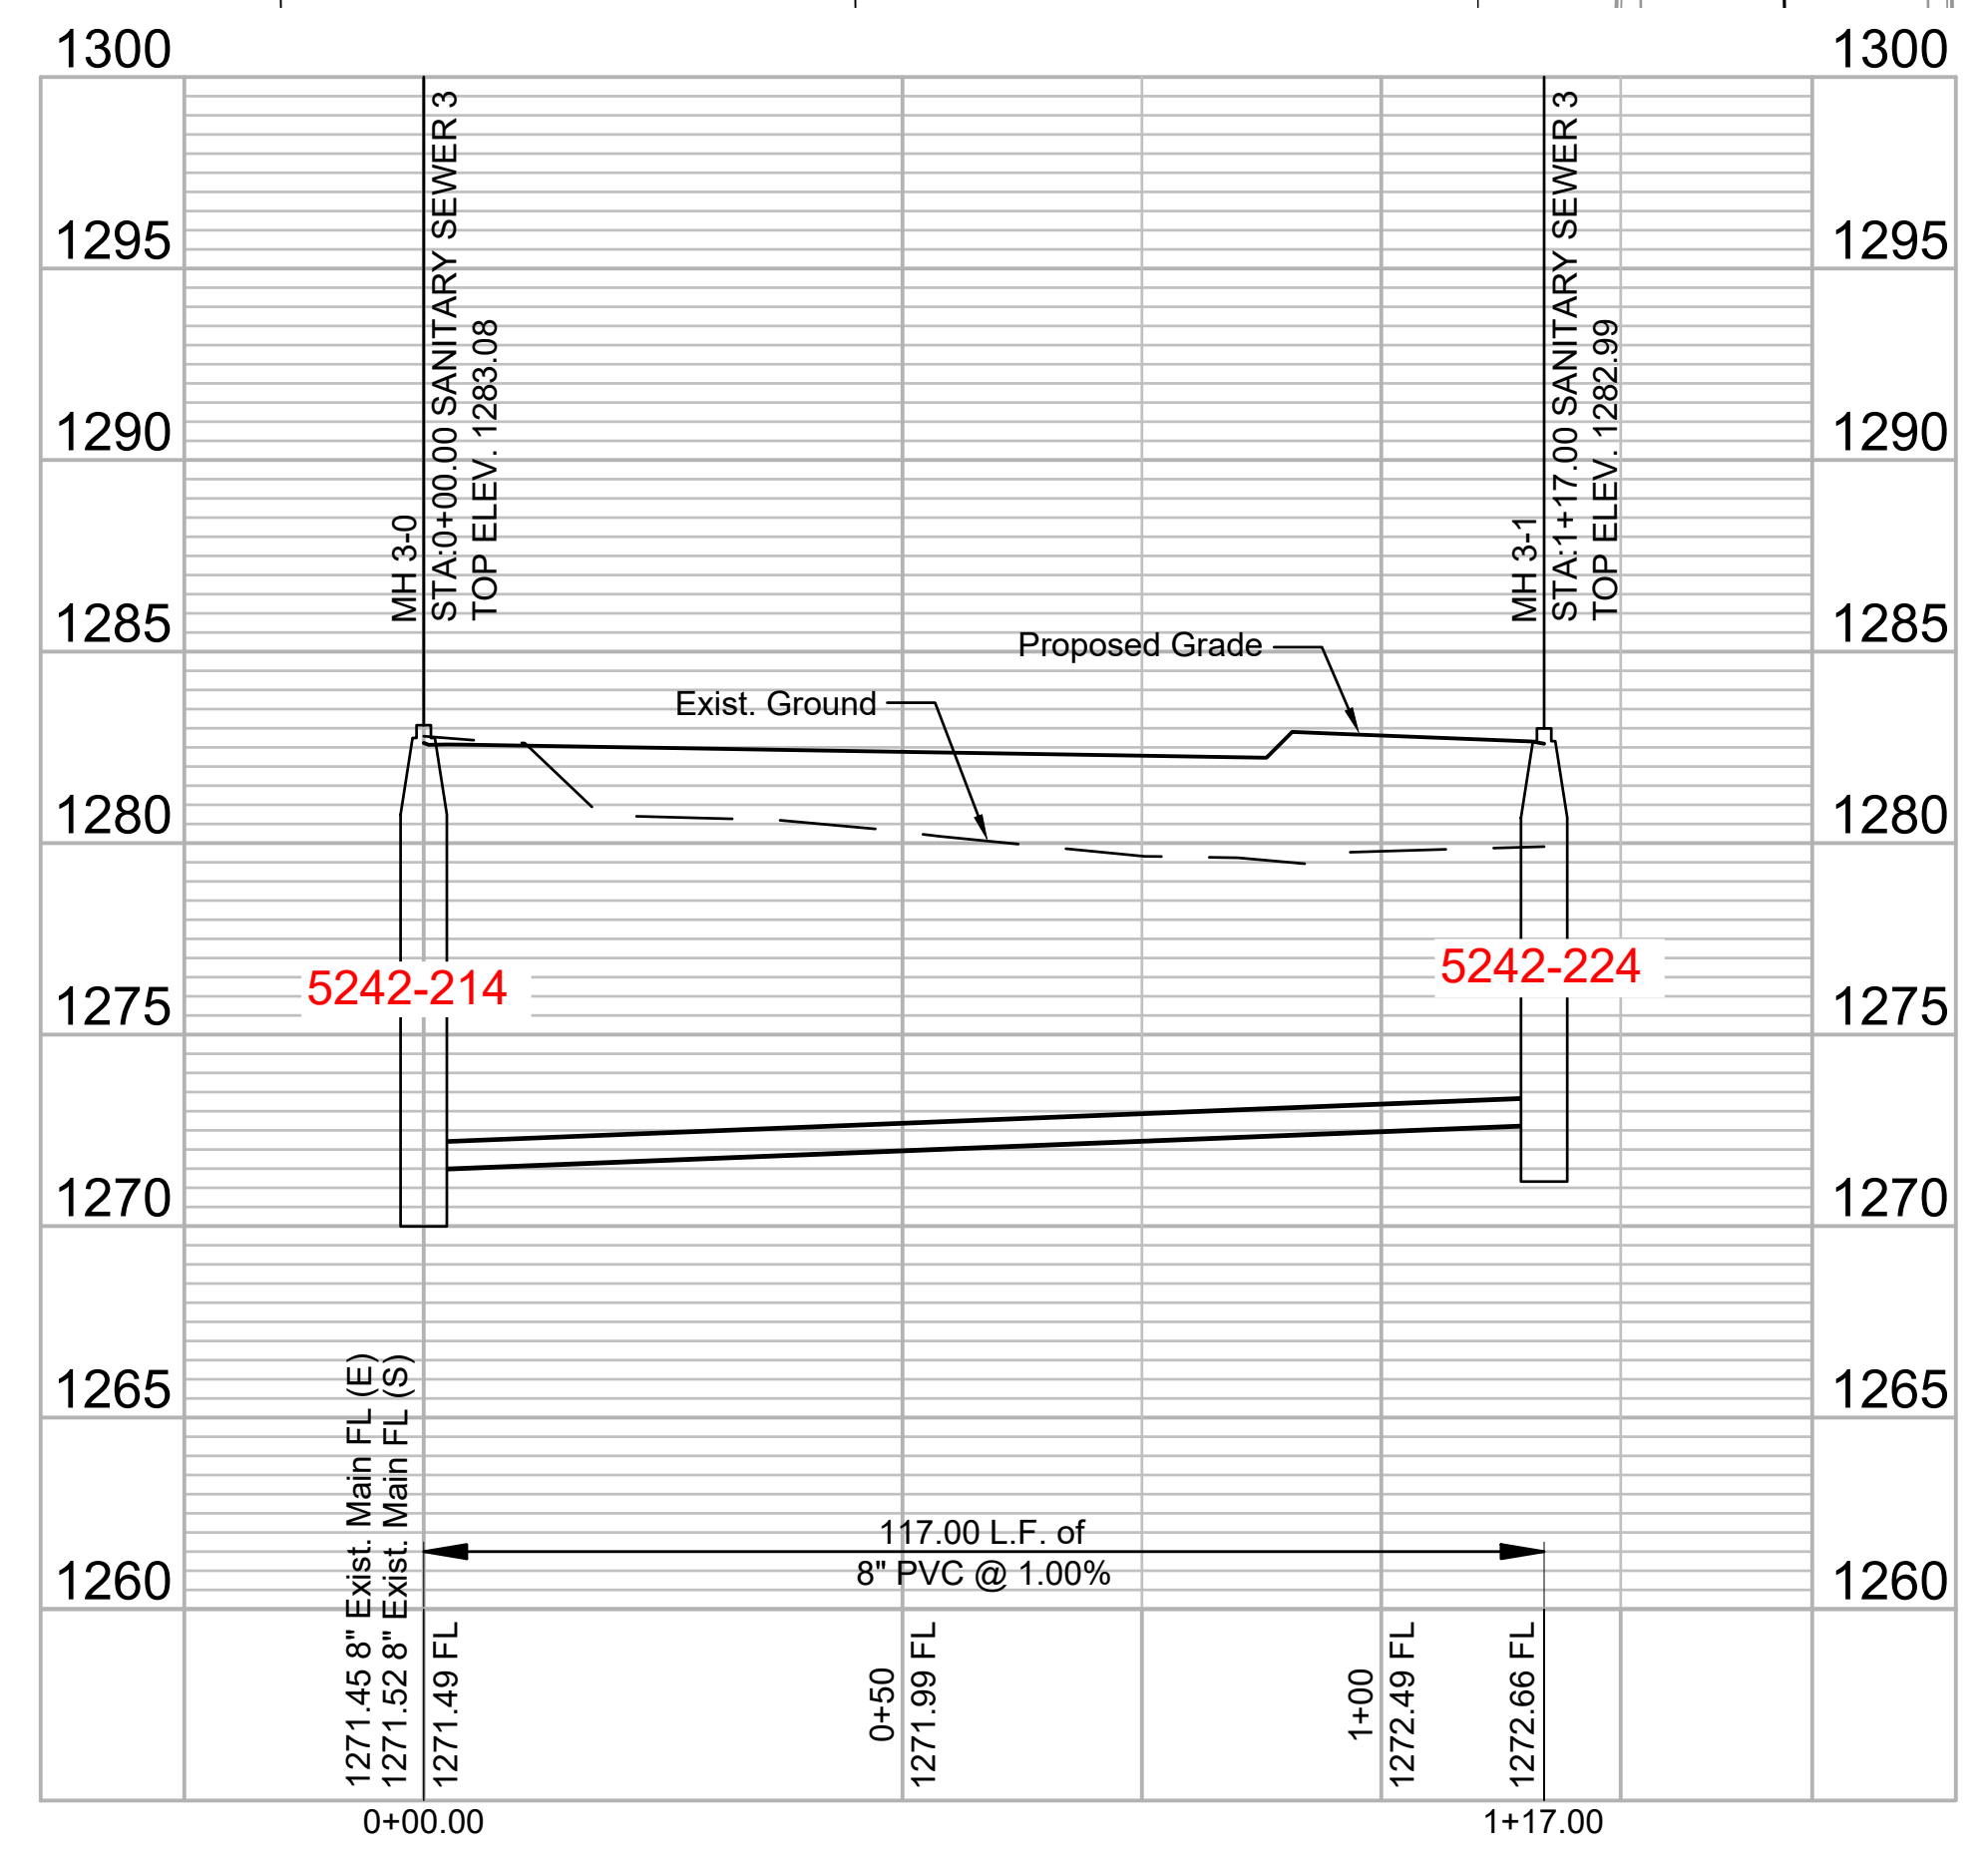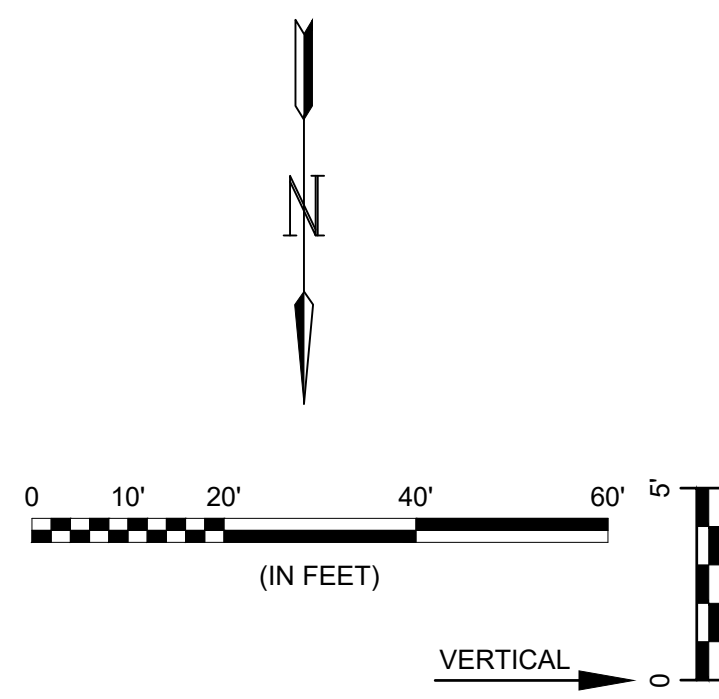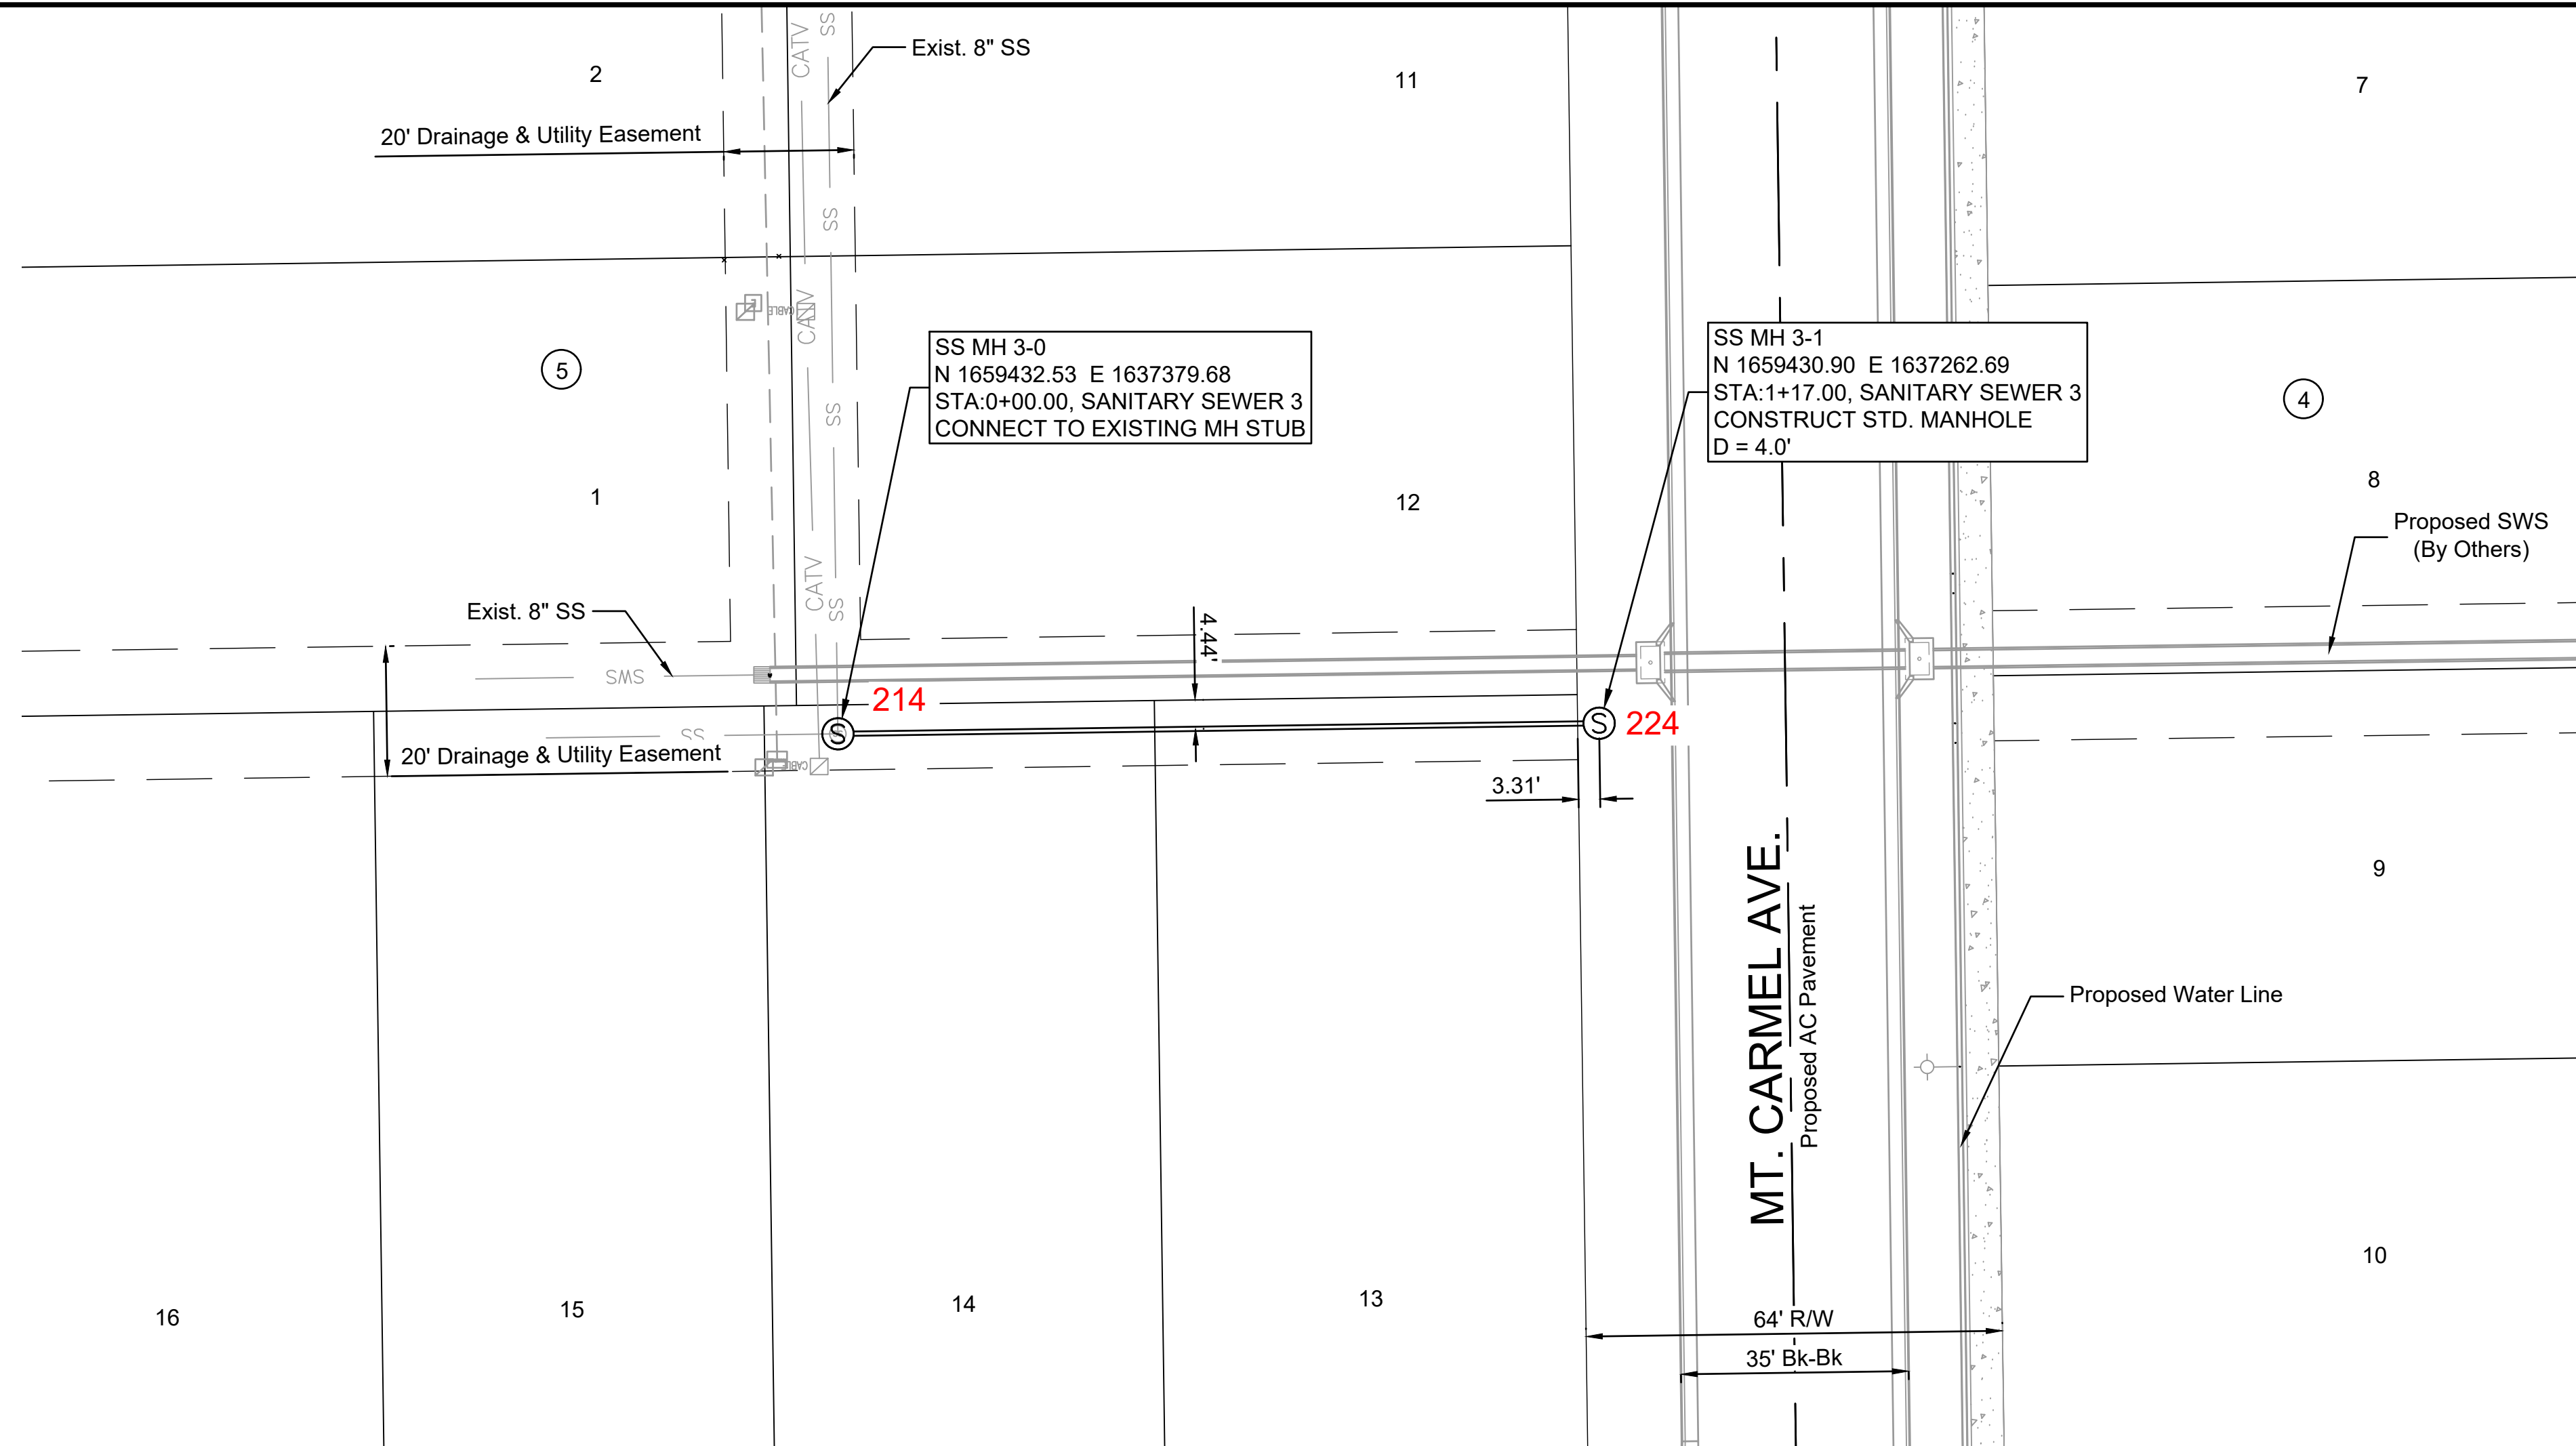

**GARVER**  
 © 2020 GARVER, LLC  
 THIS DOCUMENT, ALONG WITH THE IDEAS AND DESIGNS CONVEYED HEREIN, SHALL BE CONSIDERED INSTRUMENTS OF PROFESSIONAL SERVICE AND ARE PROPERTY OF GARVER, LLC. ANY USE, REPRODUCTION, OR DISTRIBUTION OF THIS DOCUMENT, ALONG WITH THE IDEAS AND DESIGN CONTAINED HEREIN, IS PROHIBITED UNLESS AUTHORIZED IN WRITING BY GARVER, LLC OR EXPLICITLY ALLOWED IN THE GOVERNING PROFESSIONAL SERVICES AGREEMENT FOR THIS WORK.

8535 E. 21st Street N.  
 Suite 130  
 Wichita, KS 67206  
 (316) 264-8008



REV.	DATE	DESCRIPTION	BY



CITY OF WICHITA  
 WICHITA, KANSAS  
 LEGACY 3RD  
 ADDITION  
 SANITARY SEWER

SS 3




JOB NO.: 20T41006  
 DATE: Dec 2020  
 DESIGNED BY: #  
 DRAWN BY: #

BAR IS ONE INCH ON ORIGINAL DRAWING  
 IF NOT ONE INCH ON THIS SHEET, ADJUST SCALES ACCORDINGLY.

DRAWING NUMBER

SHEET NUMBER **6** OF **16**

File: L:\2020\20141006 - Legacy 3rd Addition Imp Last Phase\Drawings\C3D\Sanitary Sewer Sheets\20141006 SS 4.dwg Last Save: 12/21/2020 2:42 PM Last saved by: MCarreraPiedra  
 Last plotted by: Carrera-Piedra, Mariela Plot Style: ---- Plot Scale: 1:2,984.9 Plot Date: 12/21/2020 2:45 PM Plotter used: None

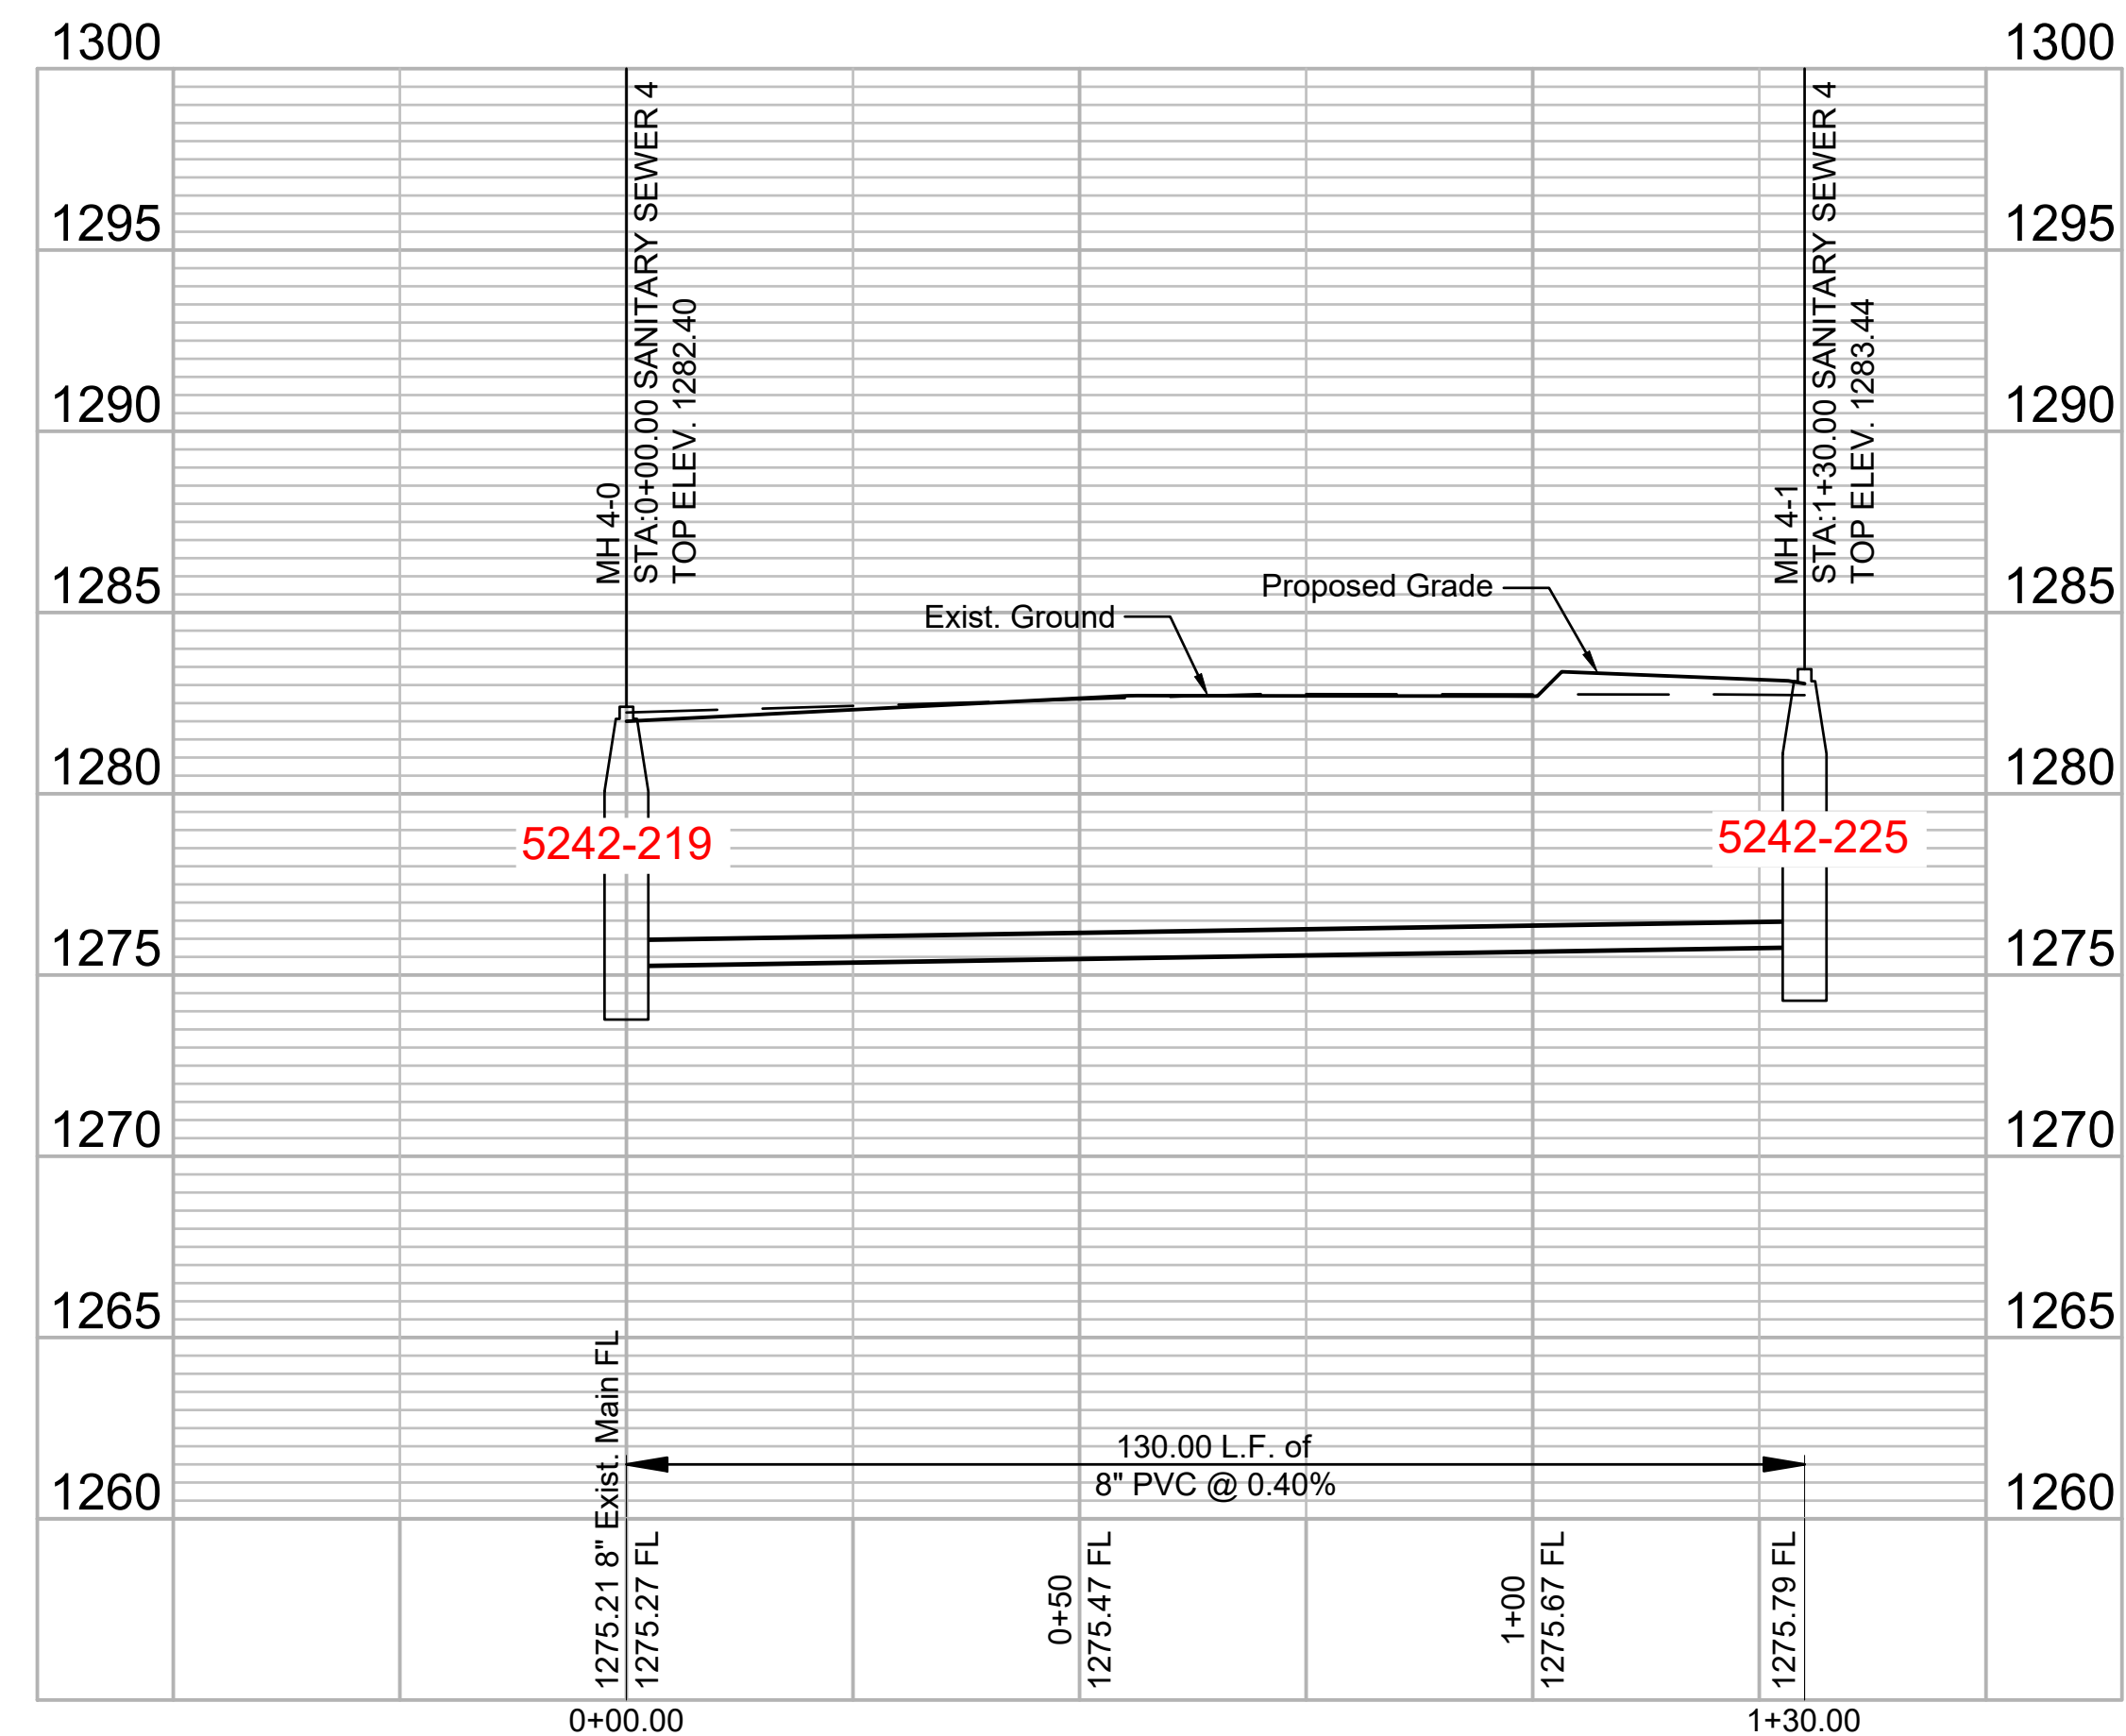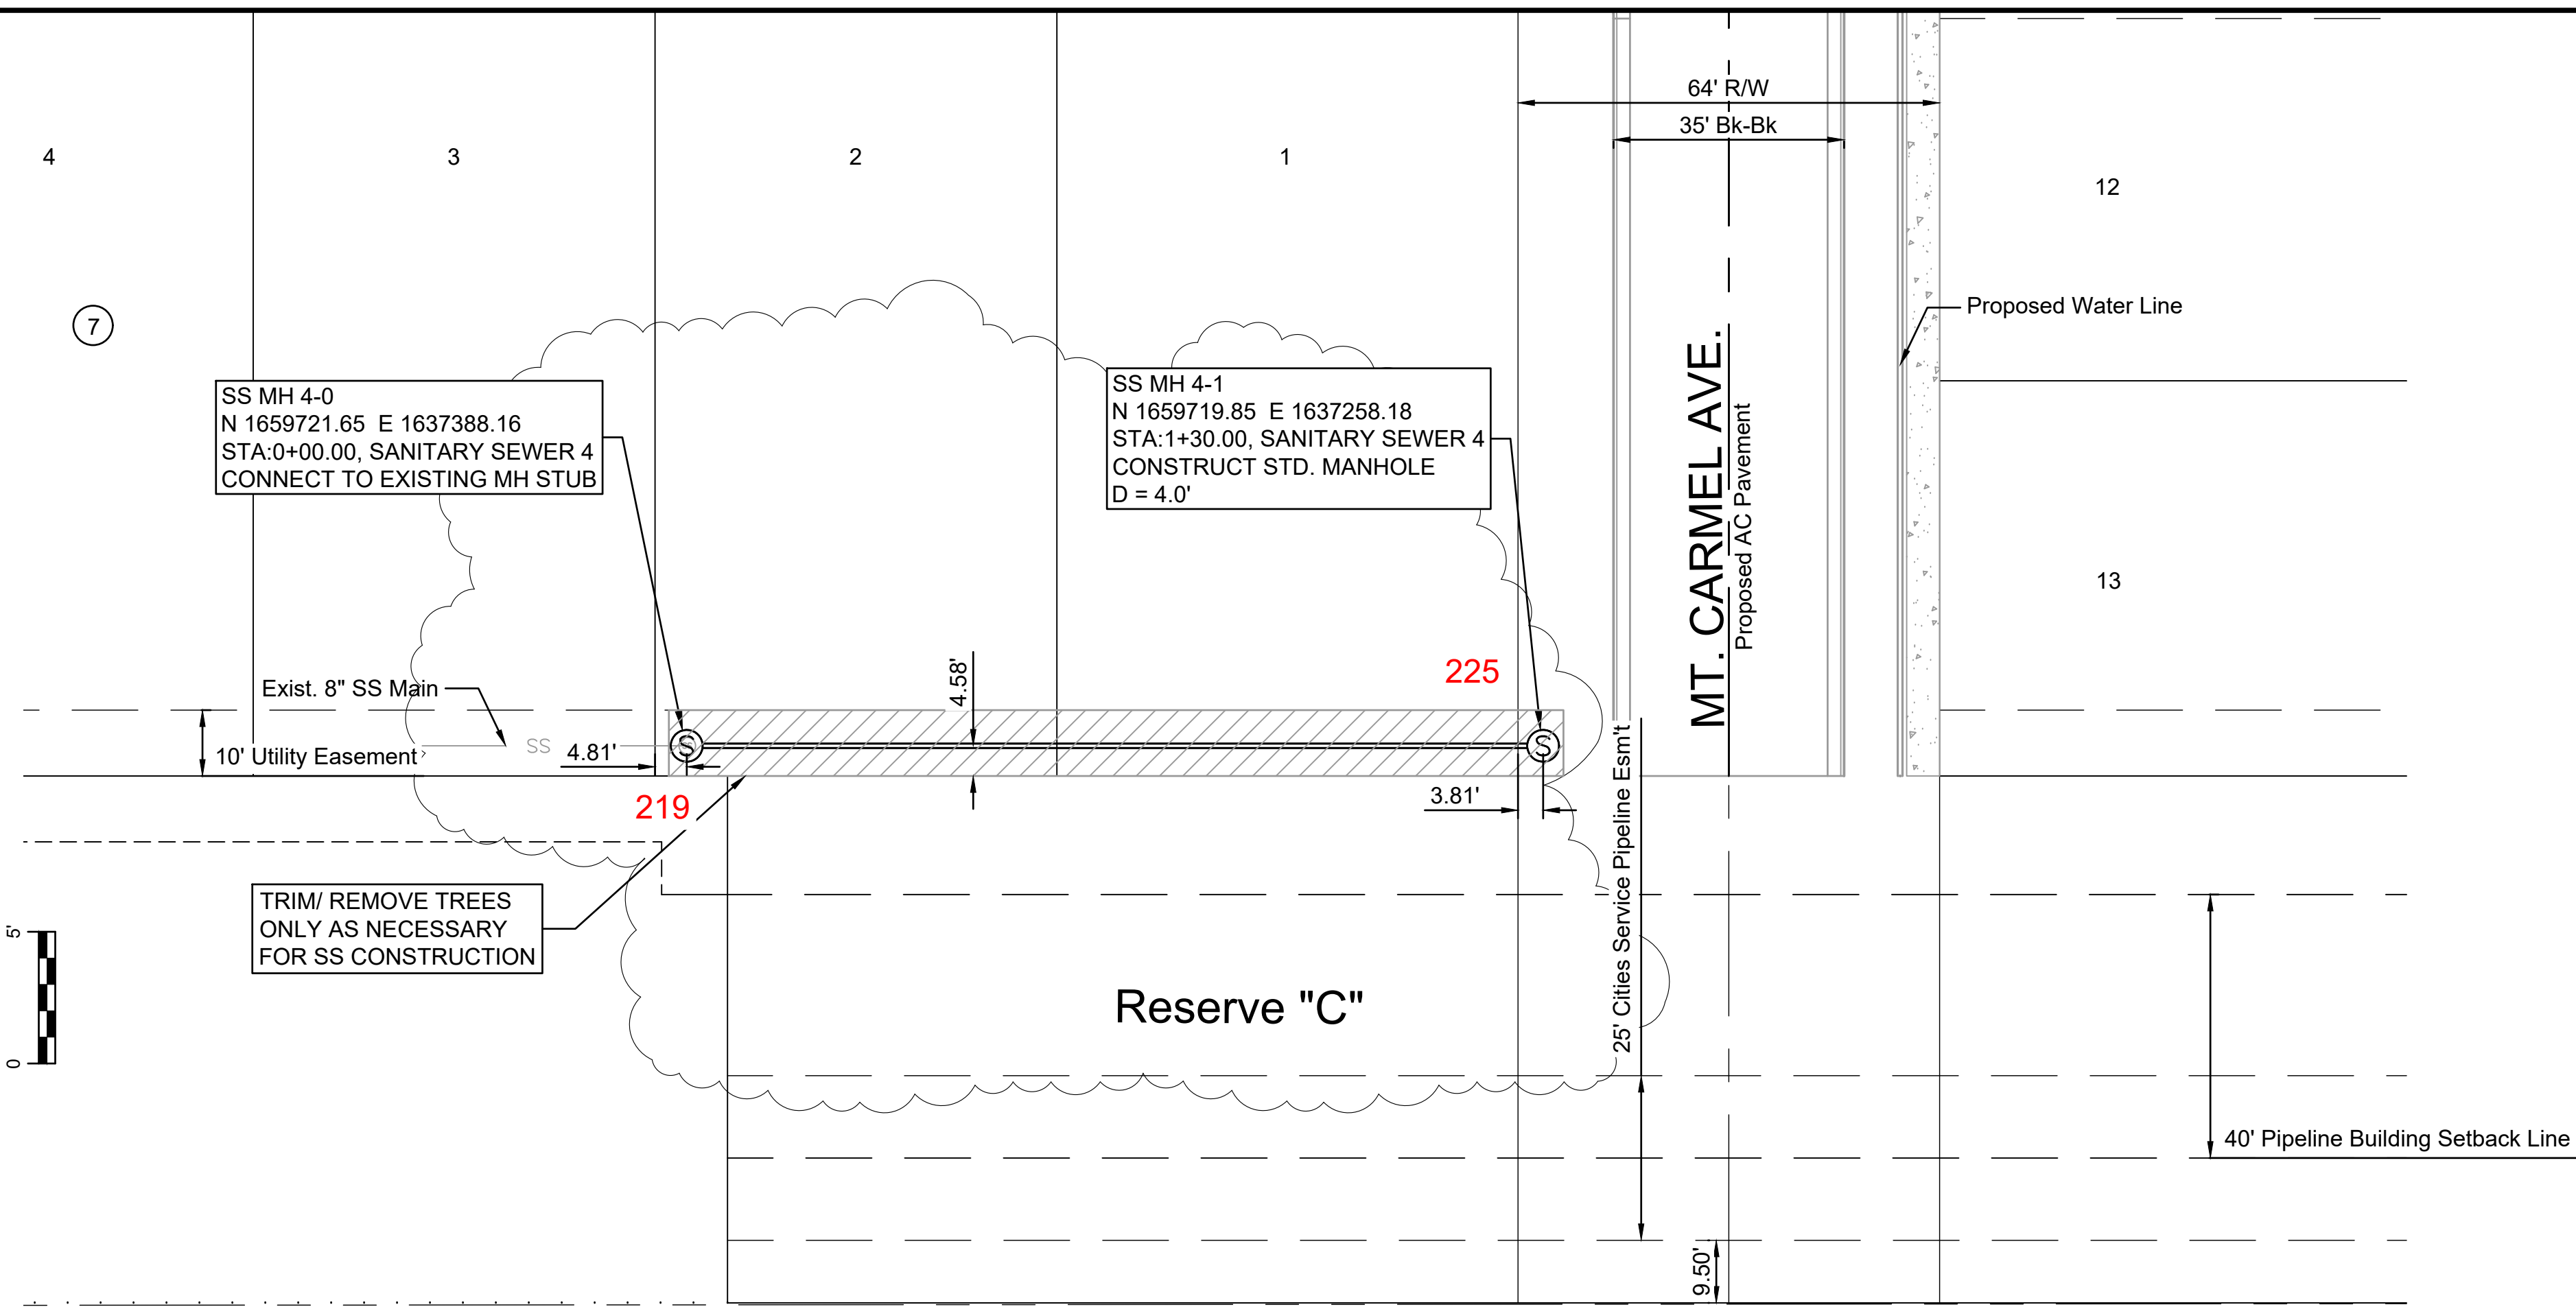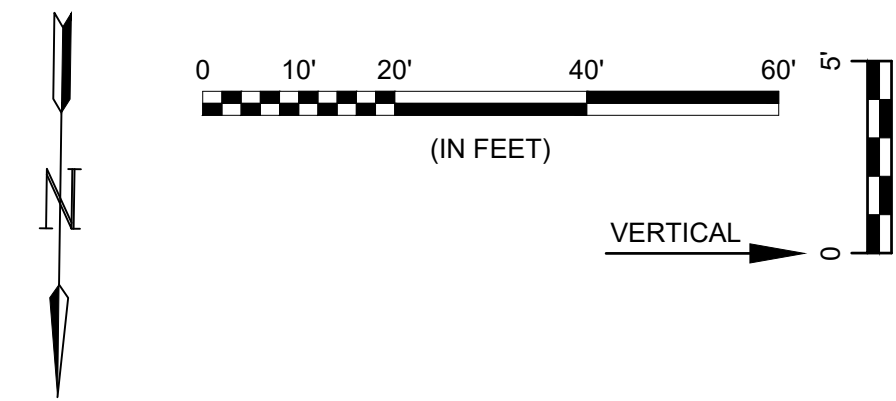

© 2020 GARVER, LLC  
 THIS DOCUMENT, ALONG WITH THE IDEAS AND DESIGNS CONVEYED HEREIN, SHALL BE CONSIDERED INSTRUMENTS OF PROFESSIONAL SERVICE AND ARE PROPERTY OF GARVER, LLC. ANY USE, REPRODUCTION, OR DISTRIBUTION OF THIS DOCUMENT, ALONG WITH THE IDEAS AND DESIGN CONTAINED HEREIN, IS PROHIBITED UNLESS AUTHORIZED IN WRITING BY GARVER, LLC OR EXPLICITLY ALLOWED IN THE GOVERNING PROFESSIONAL SERVICES AGREEMENT FOR THIS WORK.

8535 E. 21st Street N.  
 Suite 130  
 Wichita, KS 67206  
 (316) 264-8008



REV.	DATE	DESCRIPTION	BY



CITY OF WICHITA  
 WICHITA, KANSAS  
 LEGACY 3RD  
 ADDITION  
 SANITARY SEWER

SS 4

JOB NO.: 20T41006  
 DATE: Dec 2020  
 DESIGNED BY: #  
 DRAWN BY: #

BAR IS ONE INCH ON ORIGINAL DRAWING  
 IF NOT ONE INCH ON THIS SHEET, ADJUST SCALES ACCORDINGLY.

DRAWING NUMBER

SHEET NUMBER **7** OF **16**