



WATERLINE NO. 1

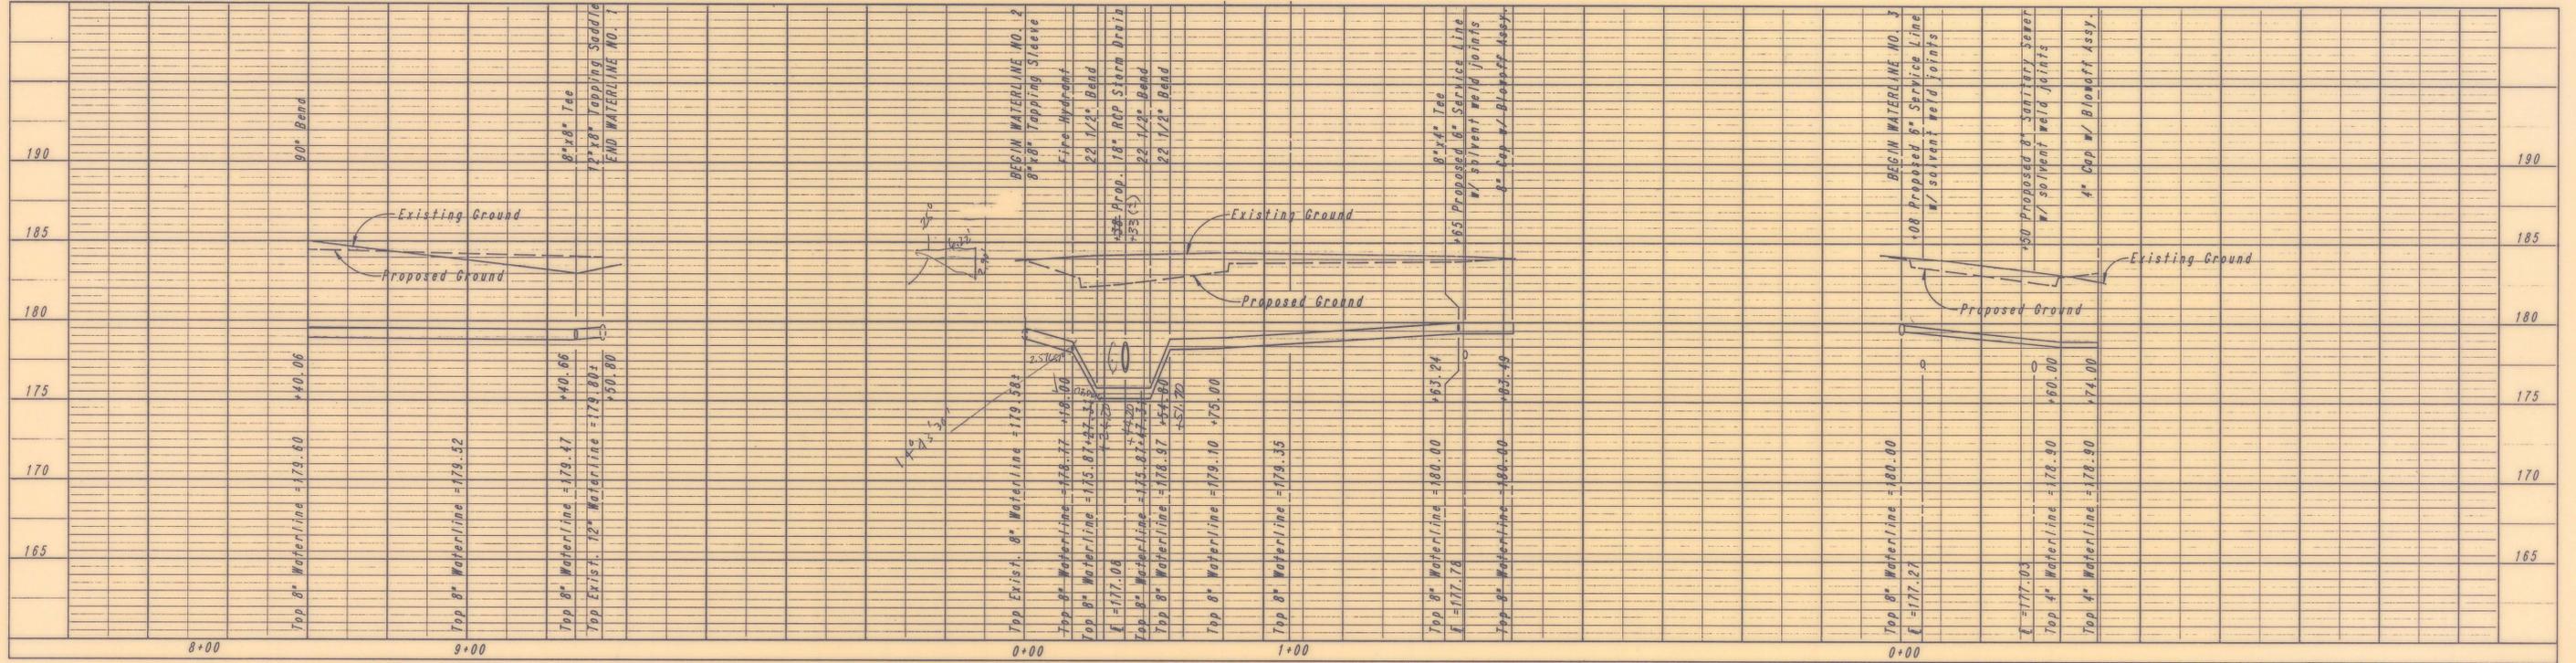

WATERLINE NO. 2

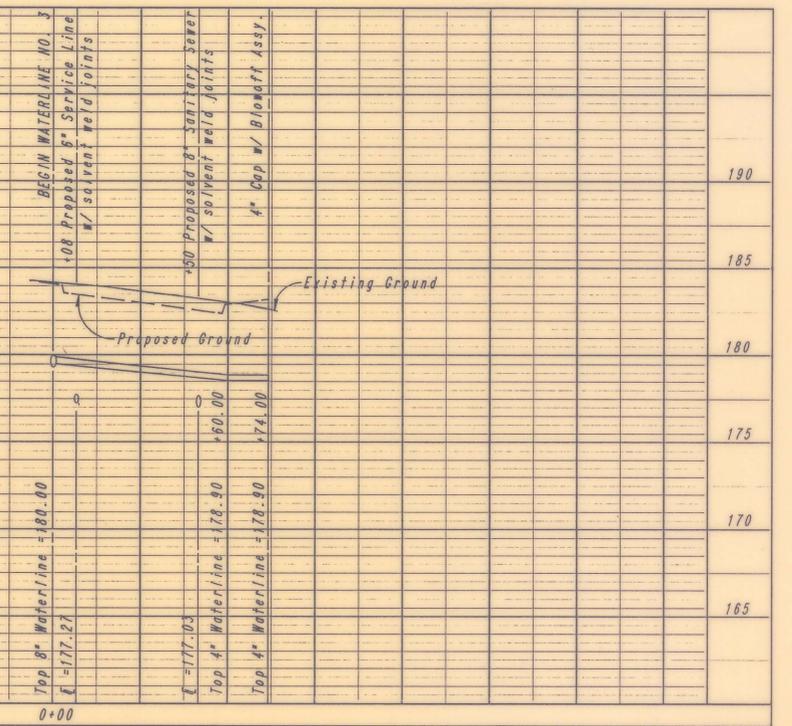

WATERLINE NO. 3

| | | | |
|--|----------|---------------|------------|
| Revised as built (Baughman Co.) | | CR | 1-15-90 |
| No. | Revision | By | Date |
| POLO CLUB OFFICE PARK | | | |
| WATERLINE PROFILE | | | |
| INDEX CODE 218PPW607853 | | | |
| PROFESSIONAL ENGINEERING CONSULTANTS, P.A. ENGINEERS WICHITA, KANSAS | | | |
| Designed by | CRY, GM | Job No. | 34-89283 |
| Drawn by | DMW, GM | Date | July, 1989 |
| | | Sht. 20 of 23 | |