

4MC-092

AS BUILT

SANITARY SEWER SYSTEM

CRESTVIEW COUNTRY CLUB ESTATES

SOUTHERN VILLAGE ADDITION

REISS AND GOODNESS ENGINEERS

2160 E. DOUGLAS WICHITA-KANSAS


1973

4mc-092


REISS & GOODNESS ENGINEERS
Consulting Engineers
2160 E. DOUGLAS ST.
WICHITA, KANSAS 67203

AS BUILT
CRESTVIEW
SOUTHERN VILLAGE
SANITARY SEWER SYSTEM
COUNTRY CLUB ESTATES
ADDITION

DATE: 2-28-73
SHEET NO. 1
OF 5 SHEETS

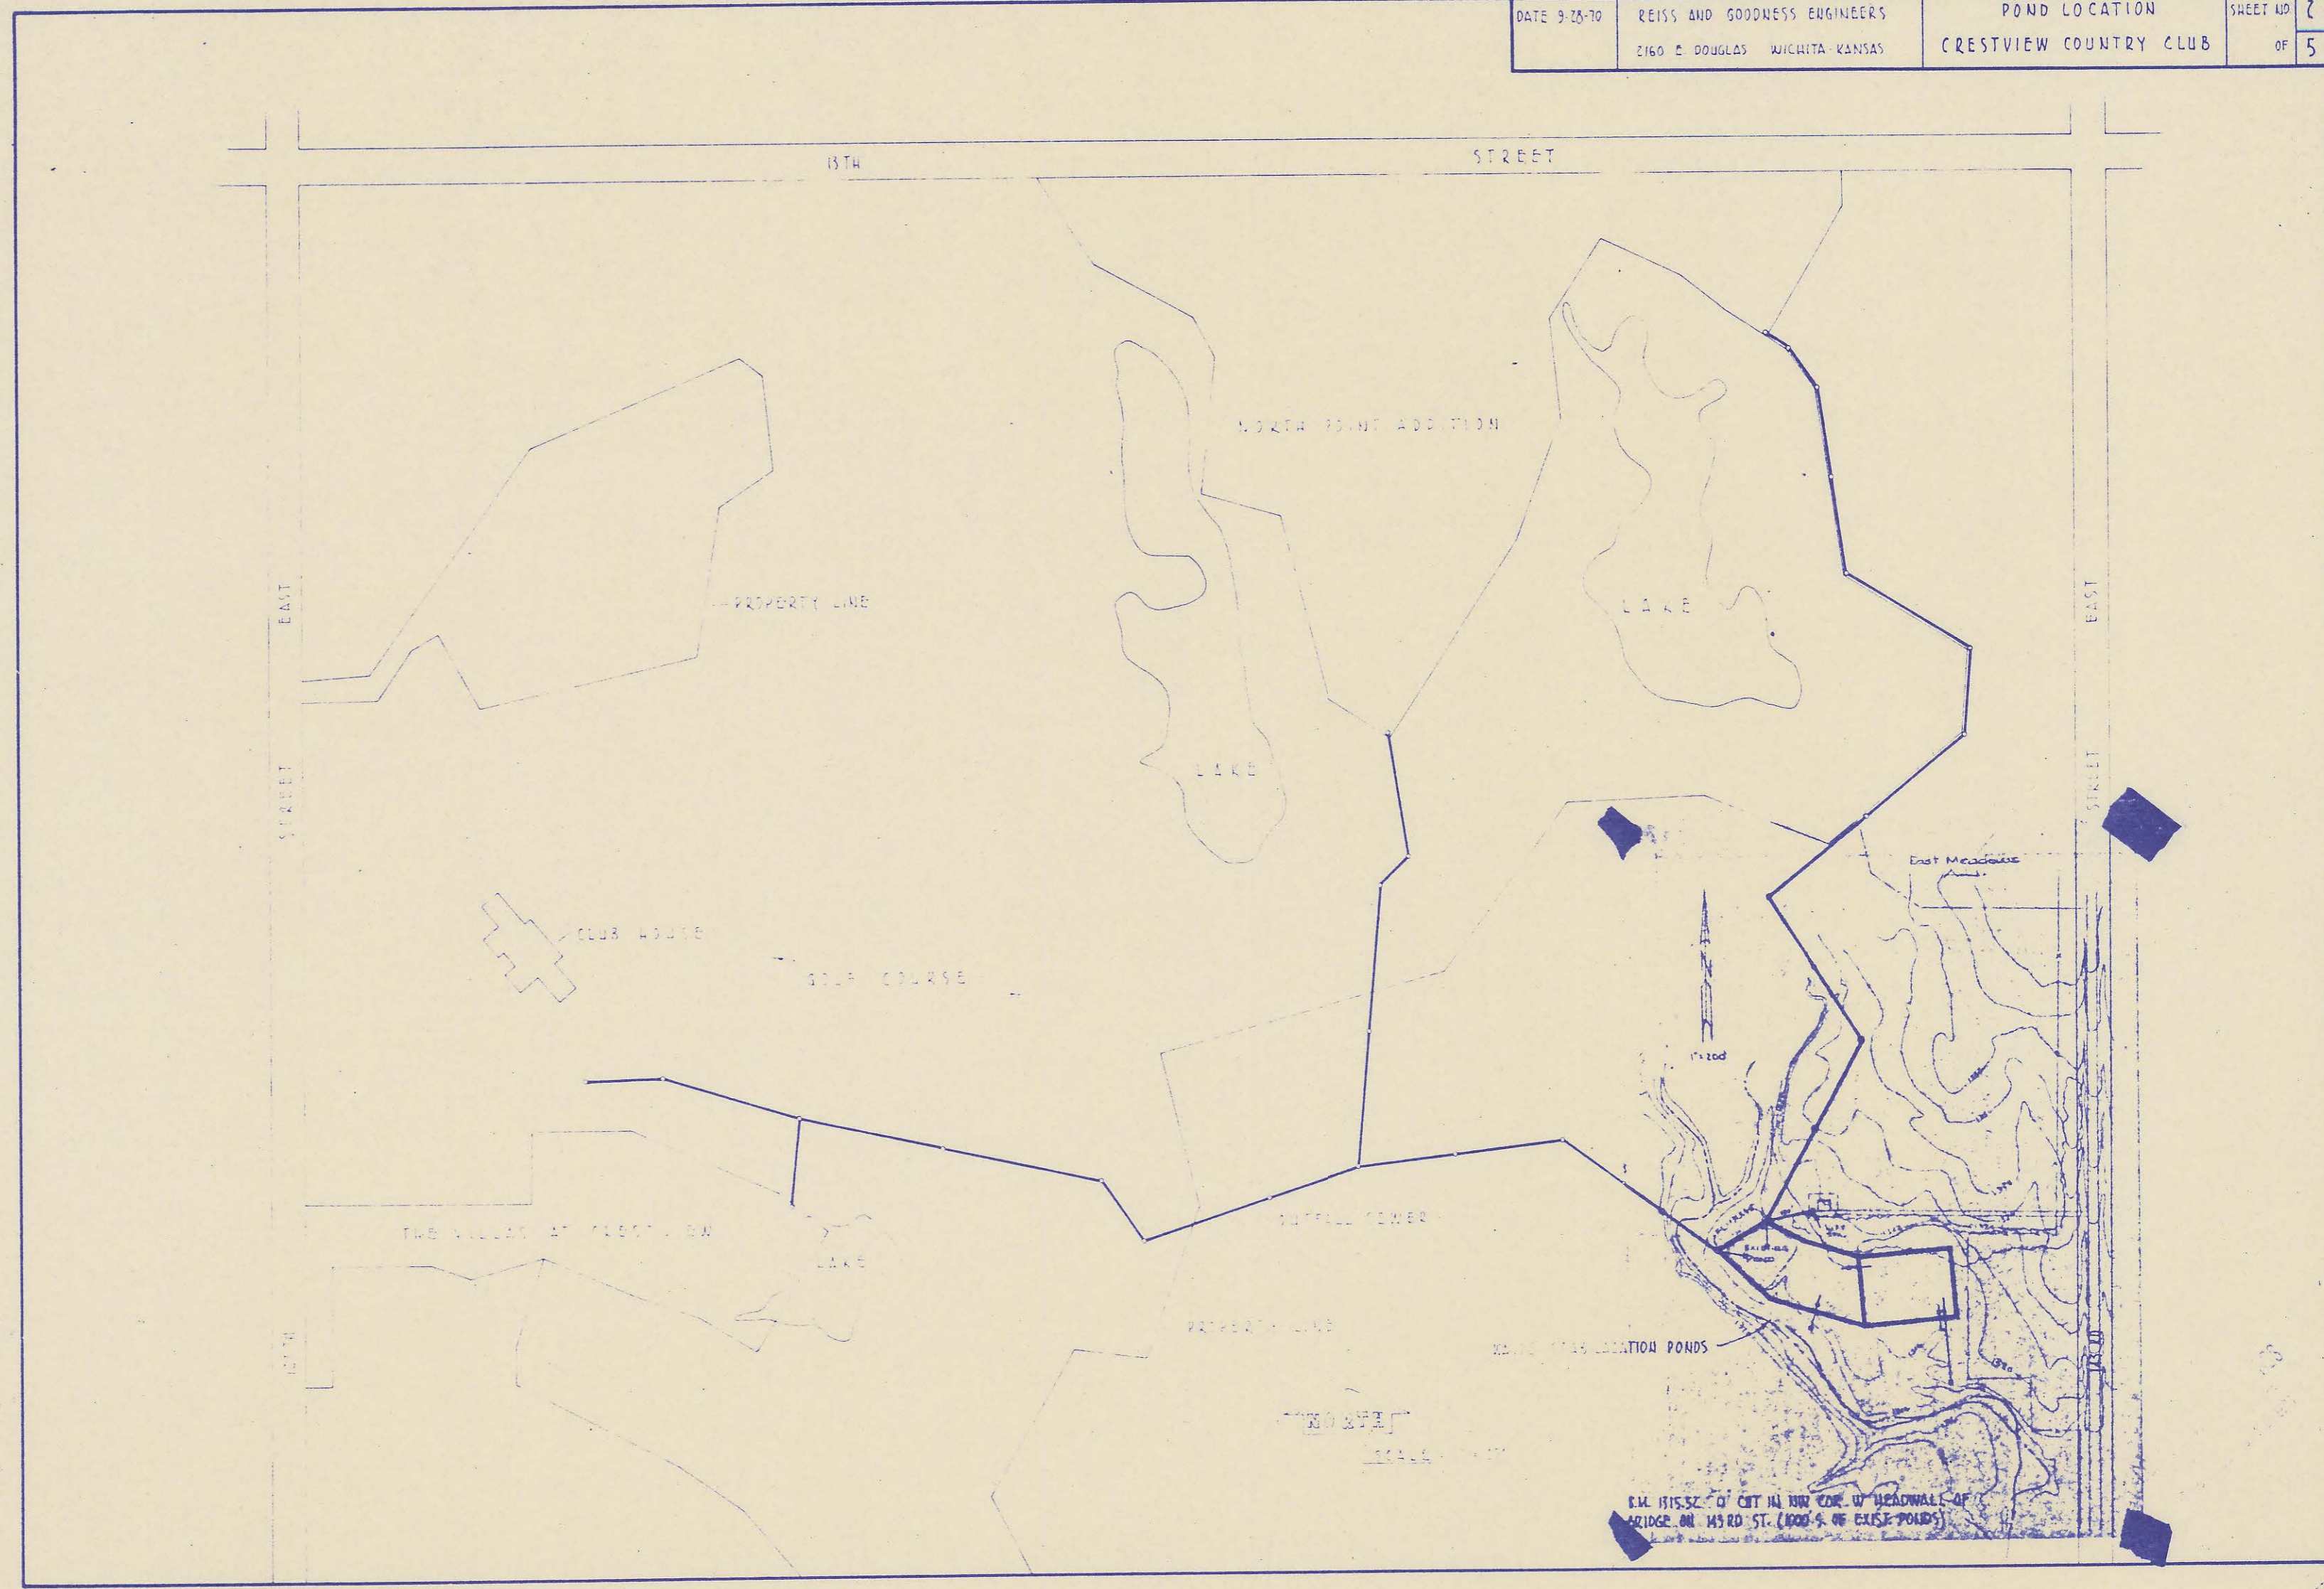

GOLF COURSE

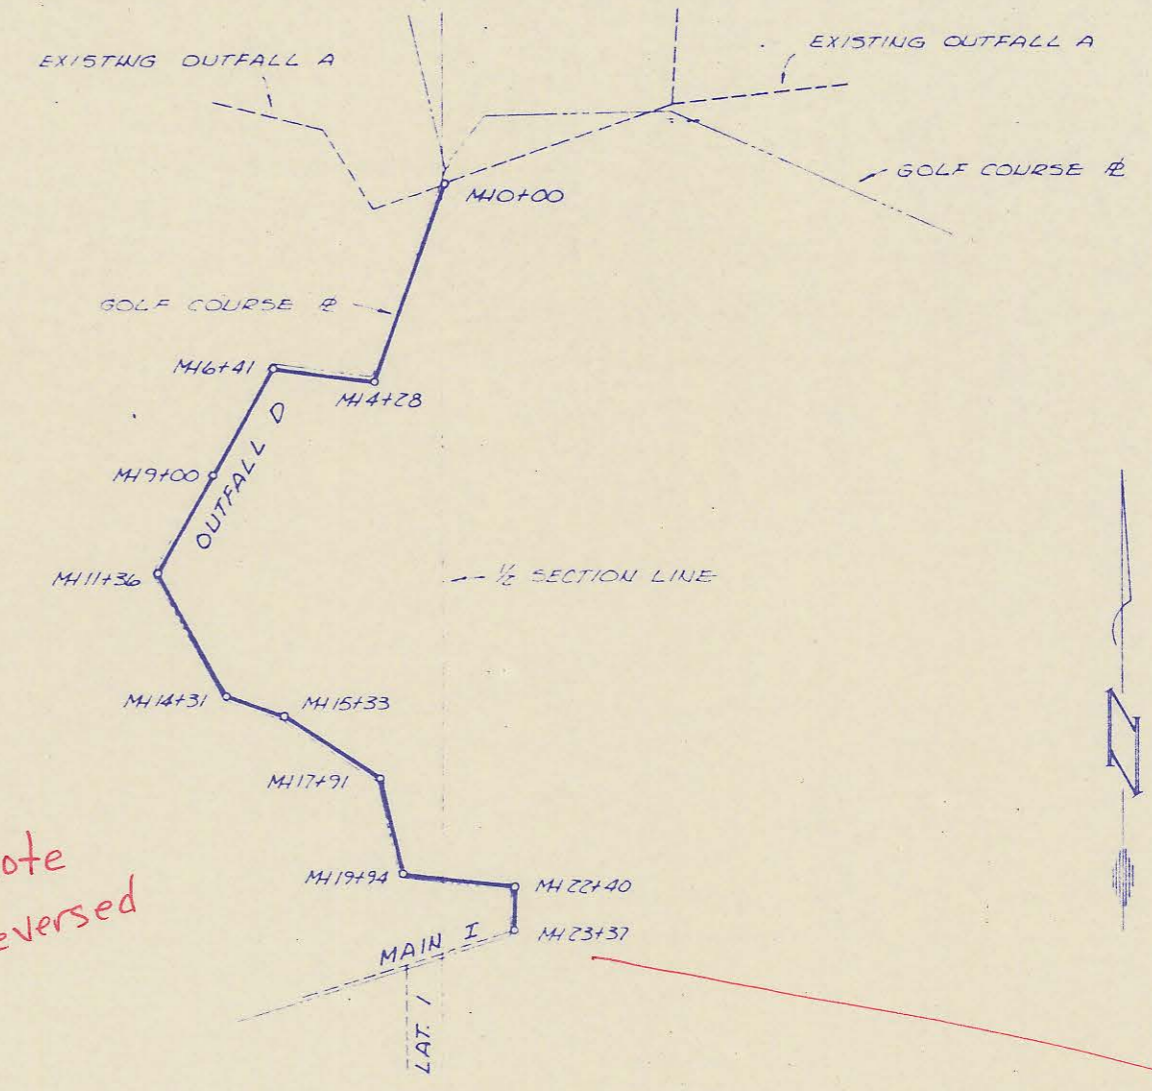


* Note Reversed


SCALE - PLAN 1"=200'
PROFILE - HORIZ 1"=100'
VERT 1"=4'

REISS & BOONER ENGINEERS
Consulting Engineers
1000 N. GULF BLVD.
SUITE 200
DALLAS, TEXAS 75201
PH: 972-443-1111
FAX: 972-443-1112
WWW.REISS-BOONER.COM

AS BUILT
SANITARY SEWER SYSTEM
SOUTHERN VILLAGE ADDITION

DATE: 2-28-73
SCALE:
SHEET NO. 3
OF 5 SHEETS

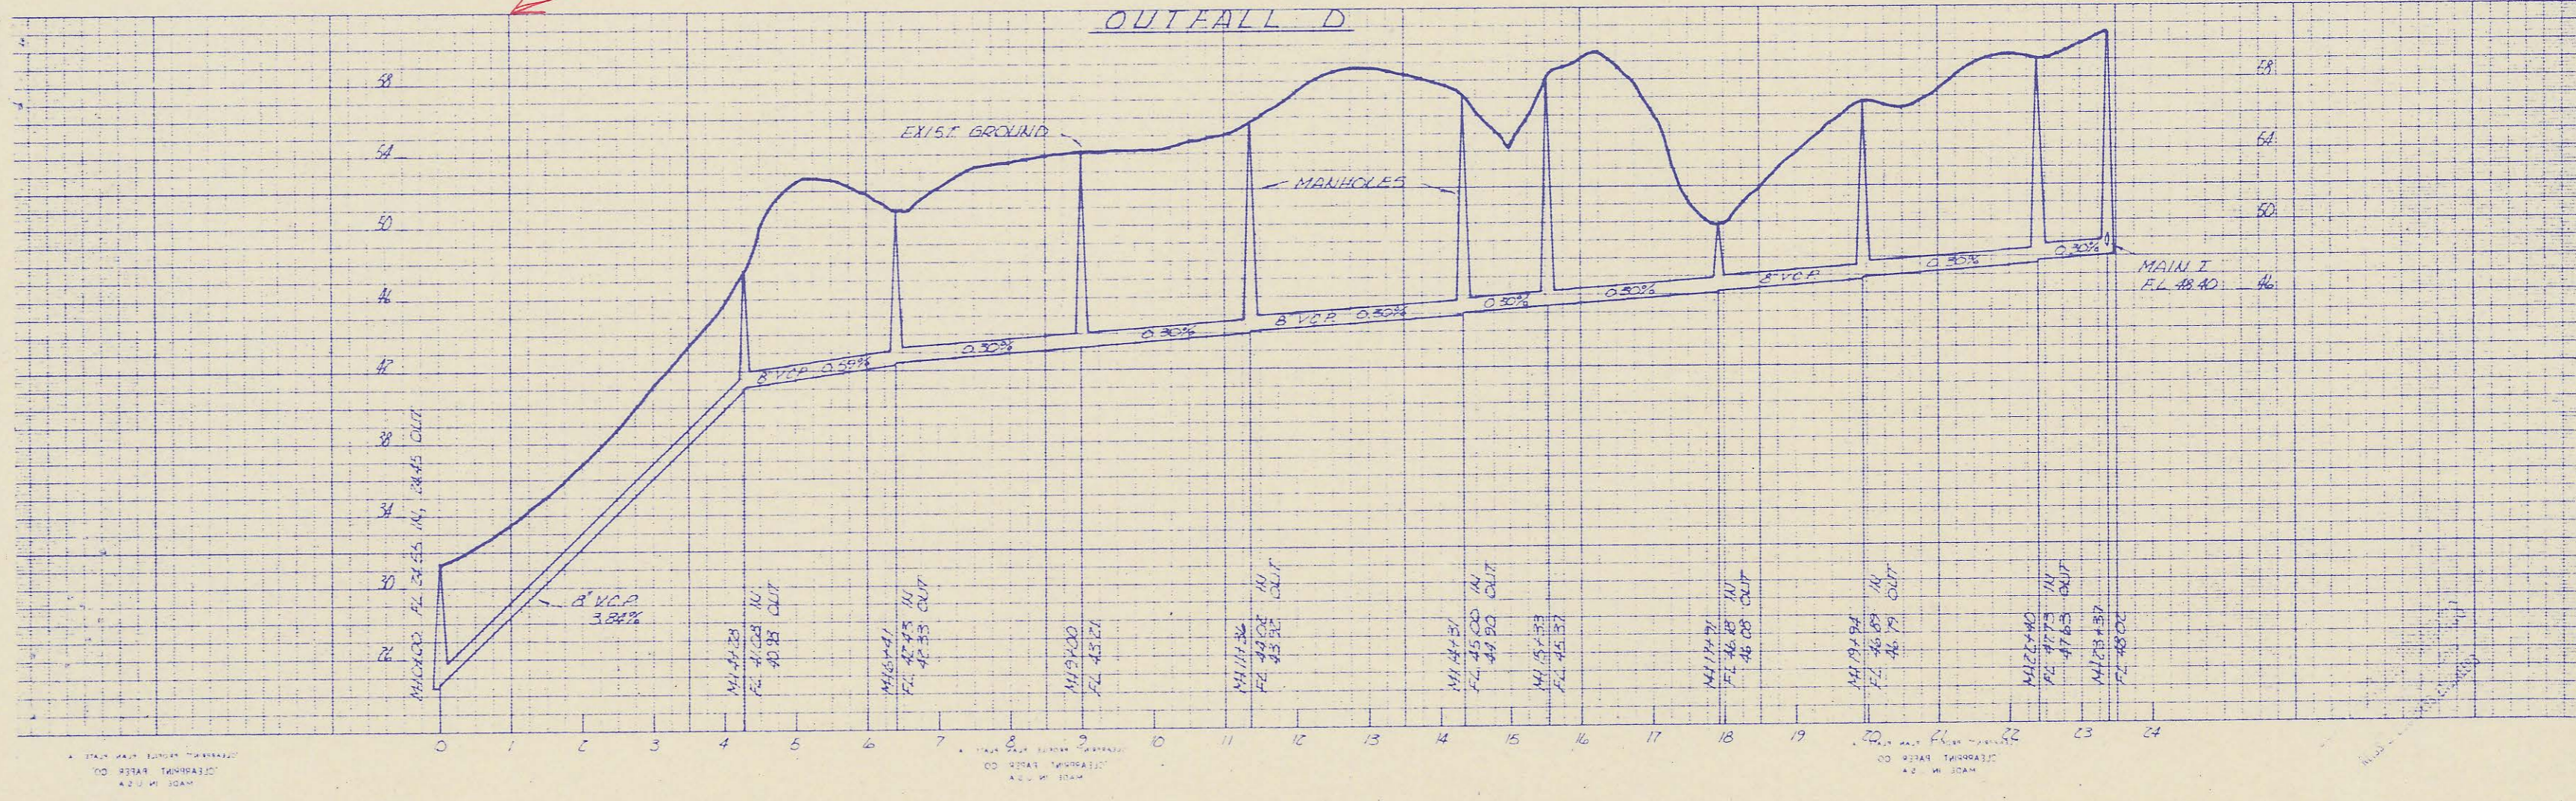

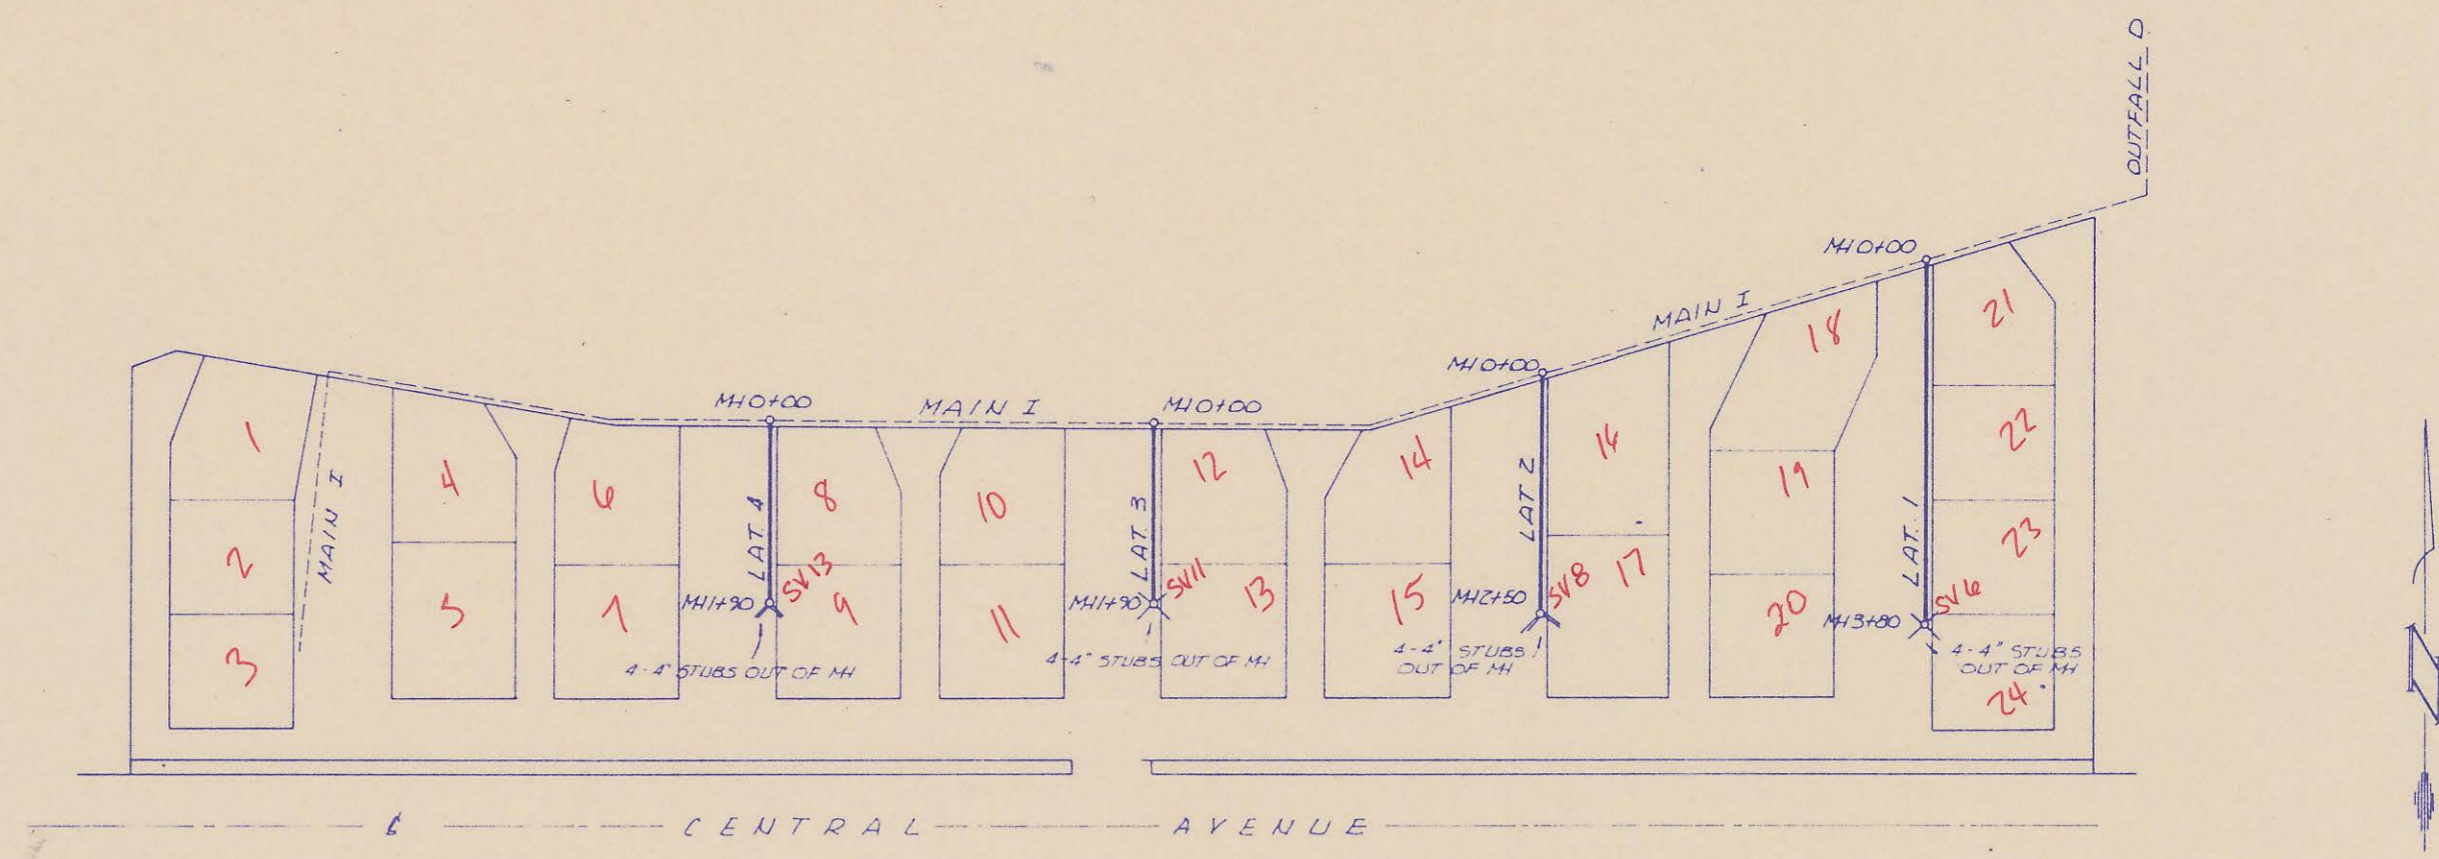

* Note Reversed

SCALE - PLAN 1"=100'
 PROFILE - HORIZ 1"=100'
 VERT 1"=4'

