

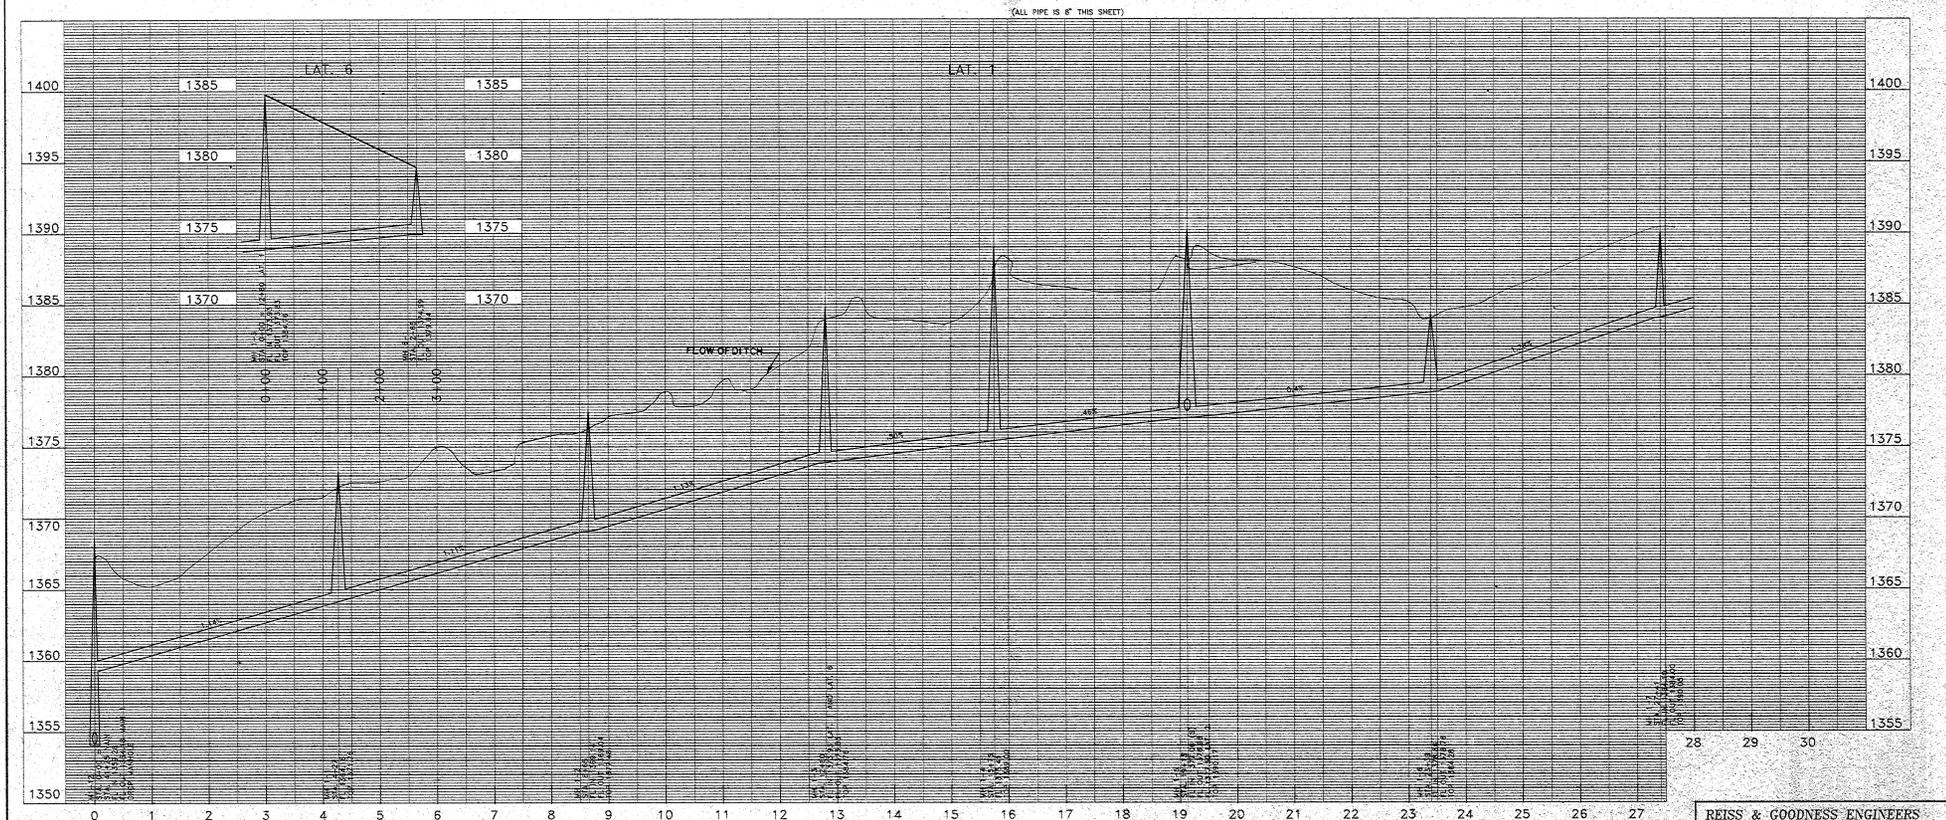


SCALE:
 PLAN 1" = 100'
 PROFILES 1" = 100'
 HORIZ. 1" = 100'
 VERT. 1" = 4'

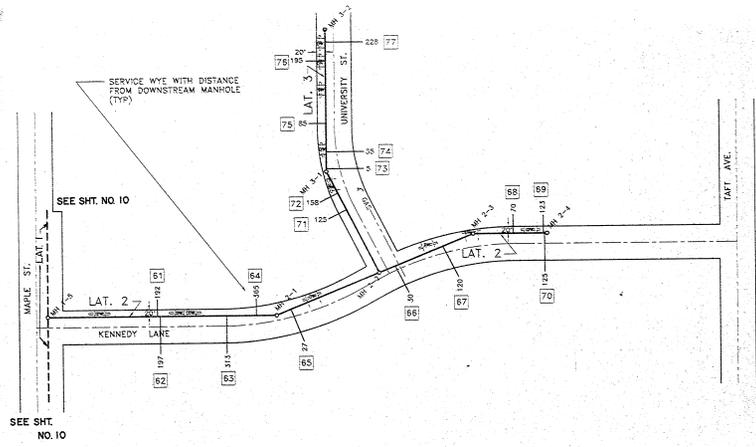


REVISION	DIRECTORY	DRAWN BY	FILE NAME	CHECKED BY	DESIGNED BY	PROJECT	CUSTOMER	SCALE: NOTED	PROJECT NO. SE0885
1-23		DM				SANITARY SEWER EXTENSIONS	W. SEDGWICK CO. SEWER DISTRICT	DATE: 6-20-88	SHEET 10 OF 23

REISS & GOODNESS ENGINEERS
 2165 WEST 21st STREET
 WICHITA, KANSAS 67205
 (316) 532-0215

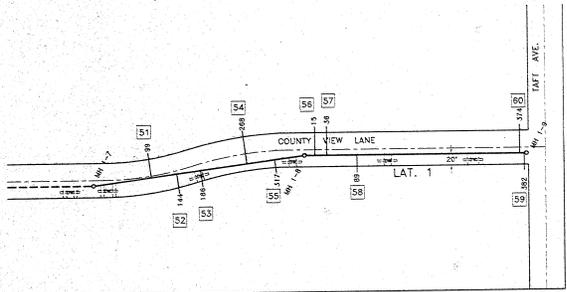

(ALL PIPE IS 8" THIS SHEET)


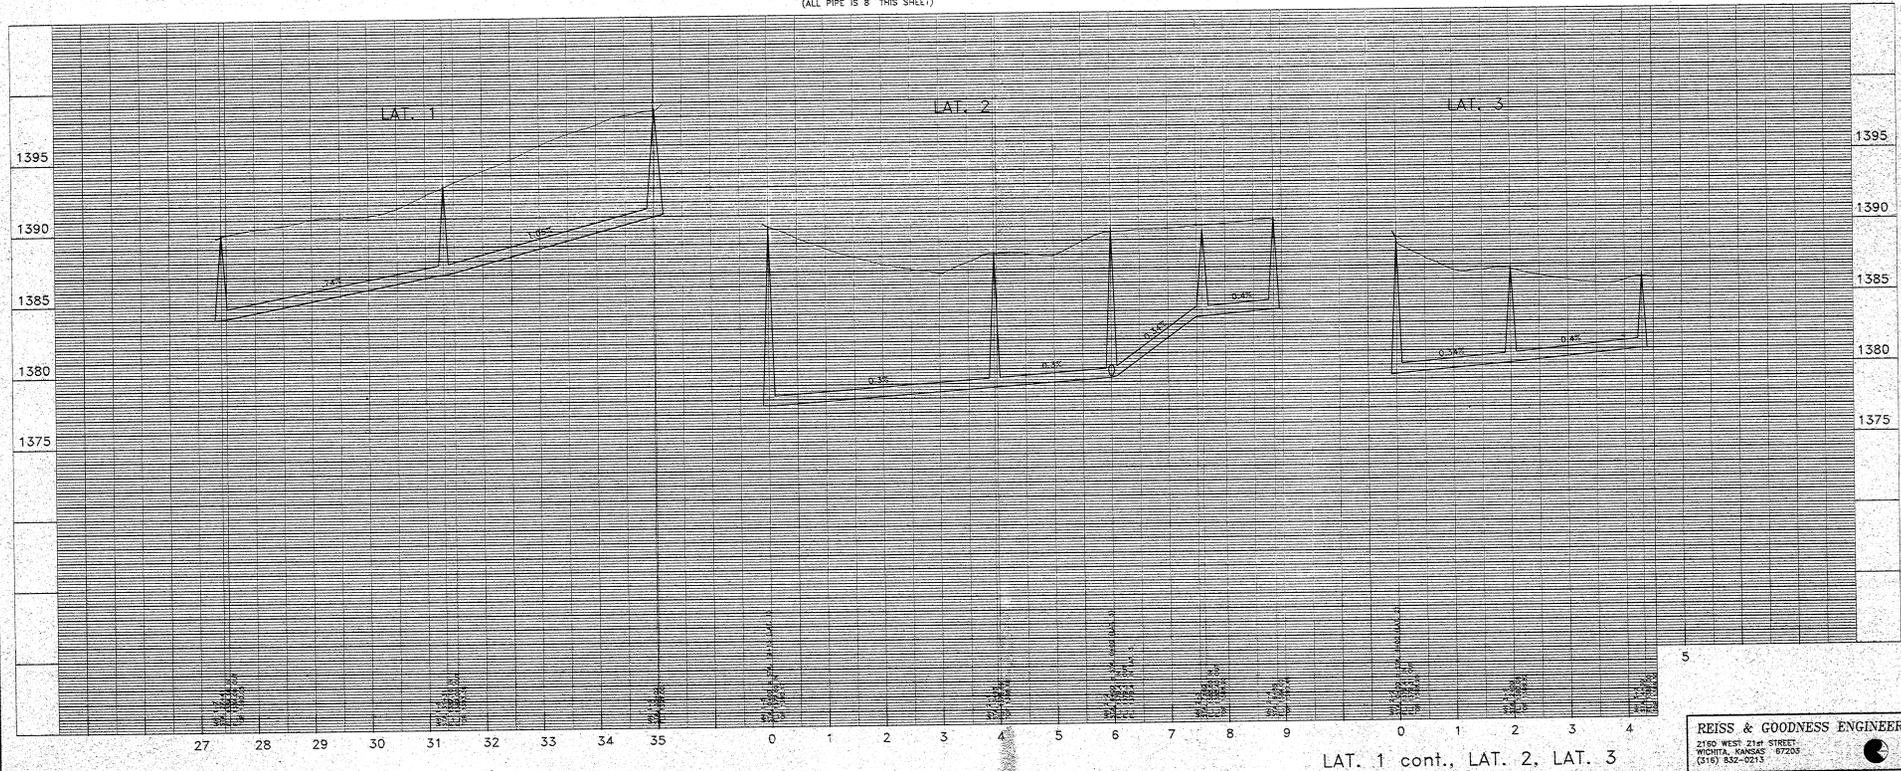


REISS & GOODNESS ENGINEERS
 2150 WEST 21st STREET
 WICHITA, KANSAS 67205
 (316) 532-0213

REVISION	DRAWN BY	CHECKED BY	DESIGNED BY	PROJECT	CUSTOMER	SCALE: NOTED	PROJECT NO. SE0385
1-93	JKM			SANITARY SEWER EXTENSIONS	W. SEDGWICK CO. SEWER DISTRICT	DATE: 6-20-88	SHEET: 11 OF 23

SCALE
 PLAN: 1" = 100'
 PROFILE: HORIZ. 1" = 100'
 VERT. 1" = 4'

** SEE AS BUILT
 ON PJ COVER SHEET **

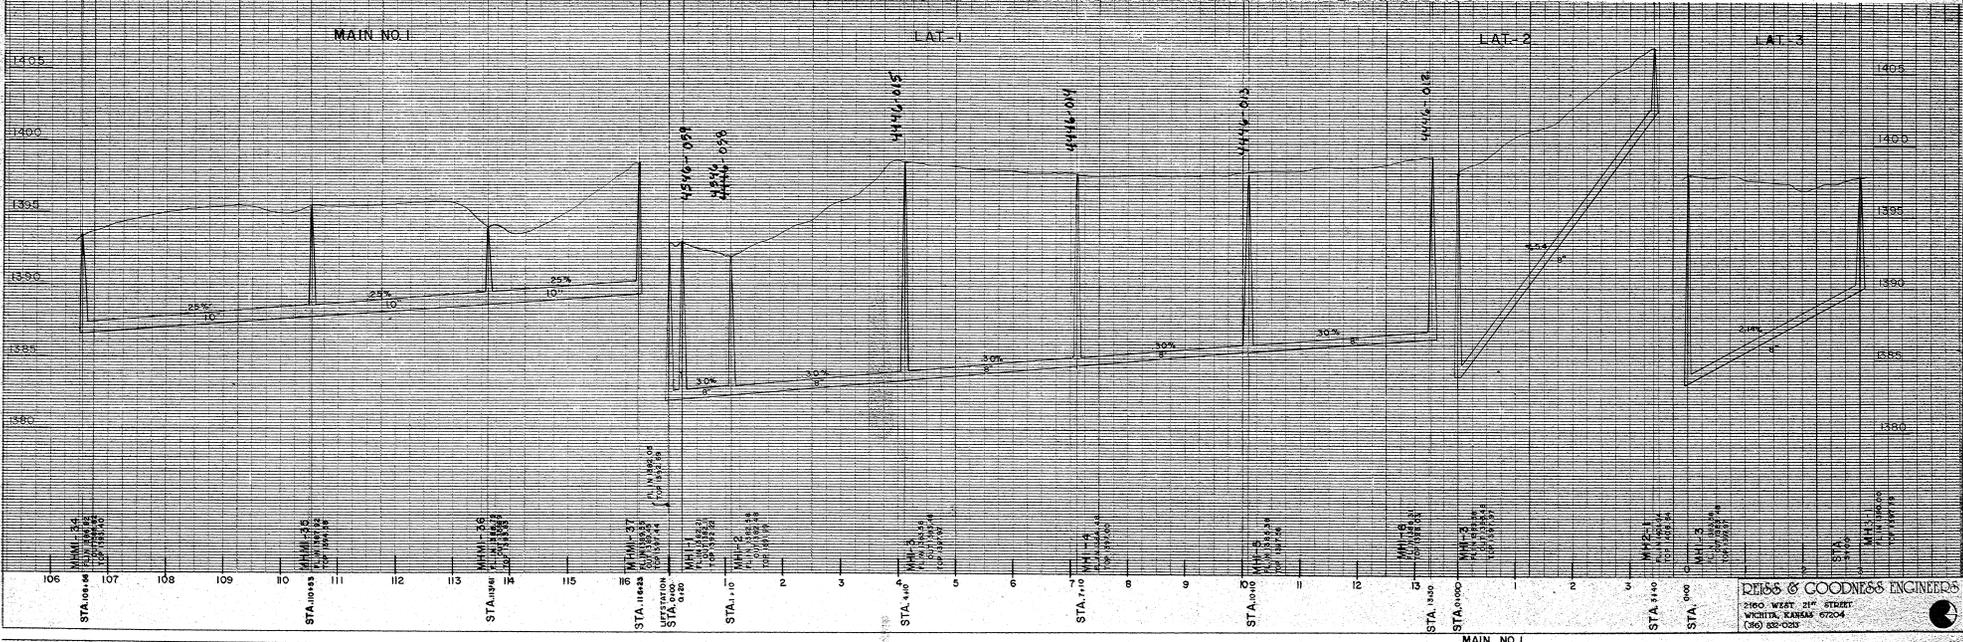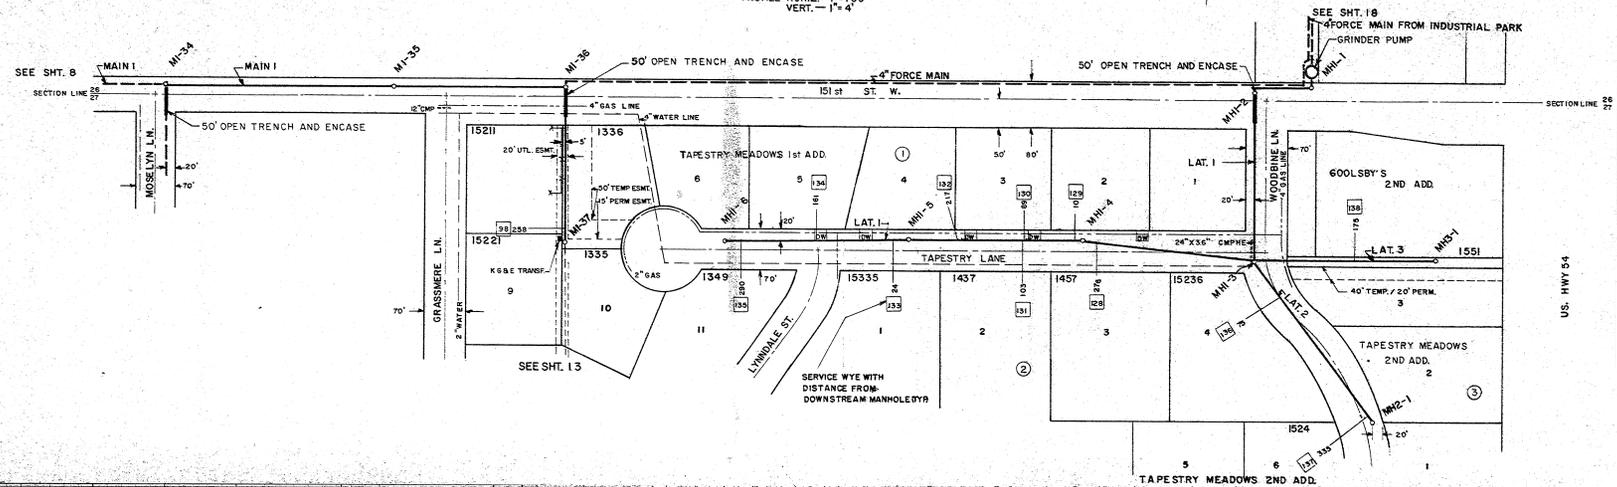







REVISION	DRAWN BY	CHECKED BY	DESIGNED BY	PROJECT
1-98	REDAW	DEJ	C. B.	
4-98				

SANITARY SEWER EXTENSIONS

W. SEDGWICK COUNTY SEWER DISTRICT

DMSS & GOODNESS ENGINEERS
 2300 WEST 21ST STREET
 WICHITA, KANSAS 67204
 (316) 835-0200

SCALE: 25' = 1" (VERT.)
 DATE: 6-25-98 SHEET 12 OF 23

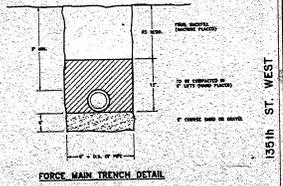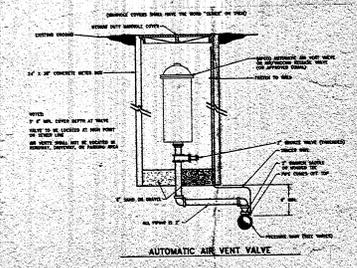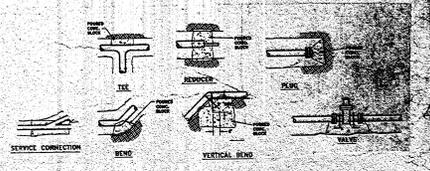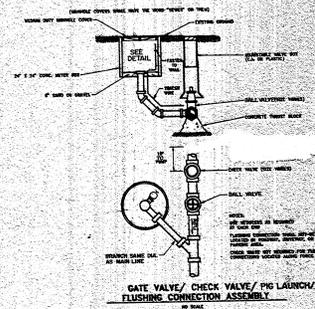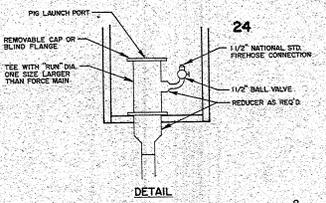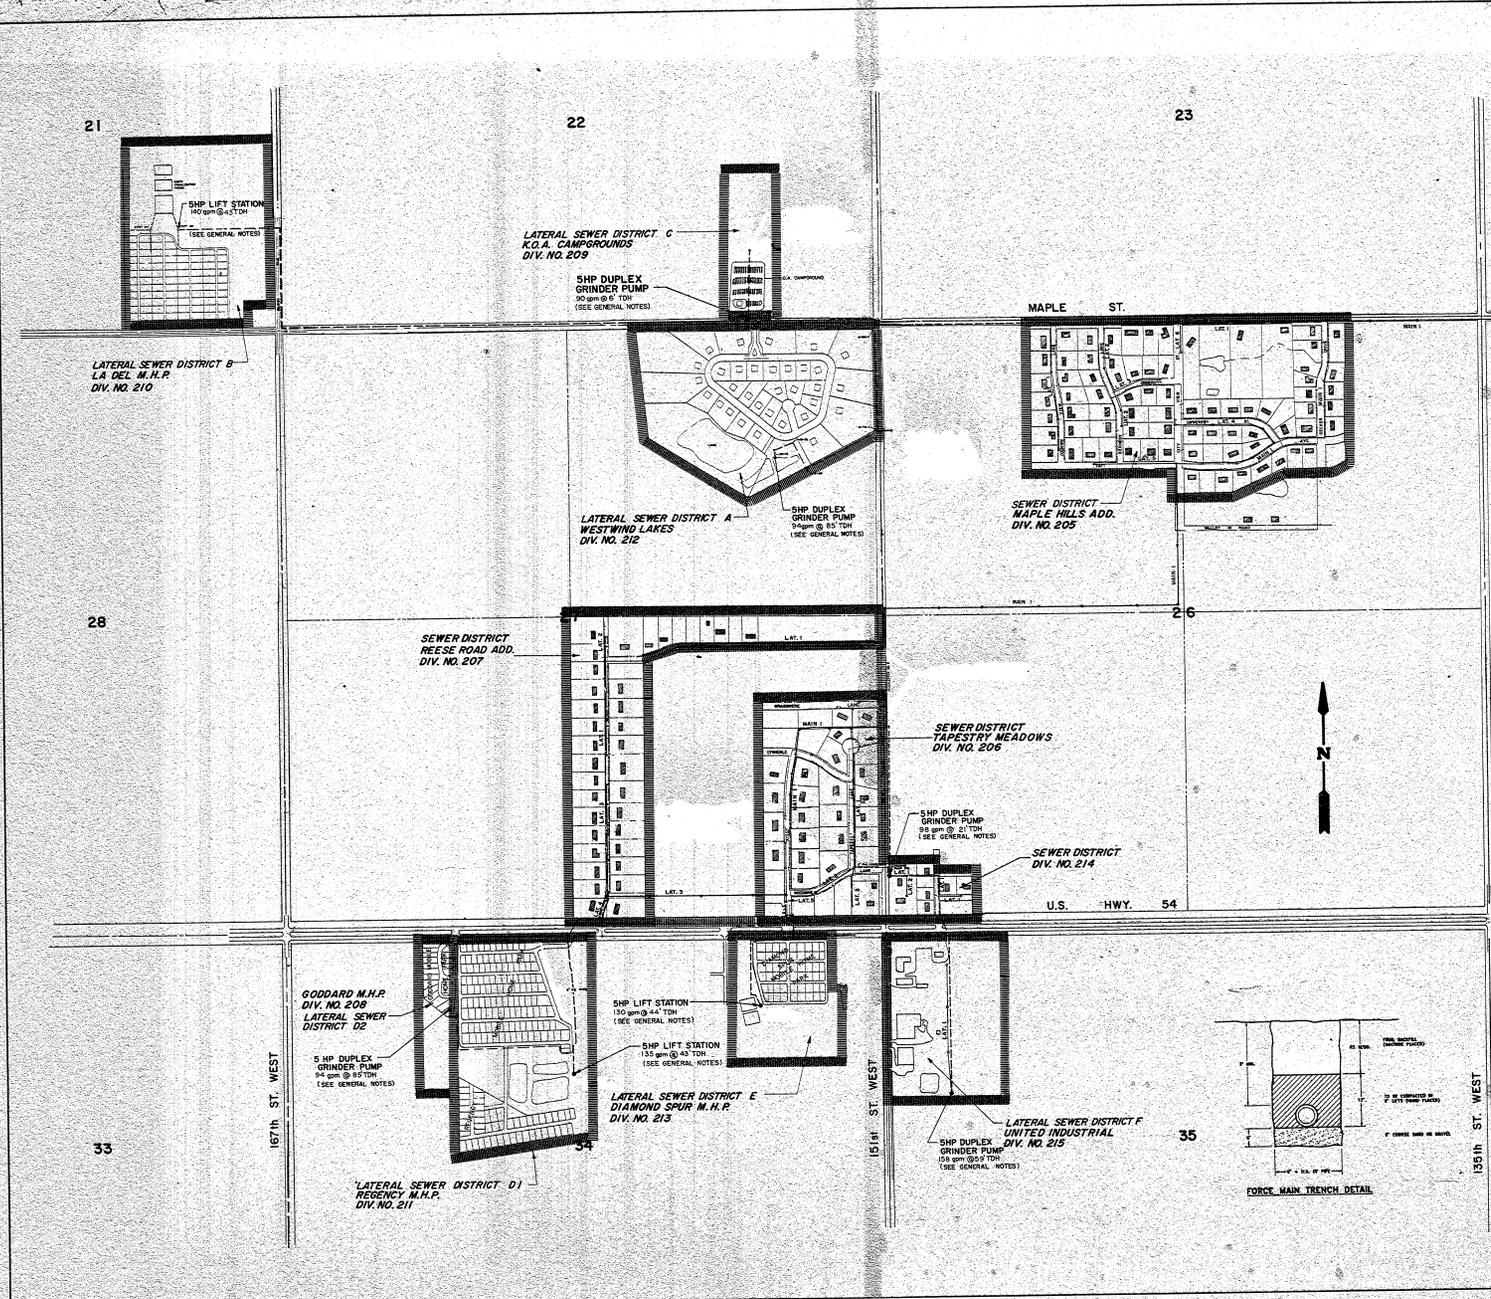


REV. 8/10/89, 10/15/90
REISS & GOODNESS ENGINEERS
 3800 WEST 21ST STREET
 WICHITA, KANSAS 67203
 (316) 262-0281

DATE	DRAWN BY	CHECKED BY	DESIGNED BY	PROJECT
1-1990	C.E.		CG	
2/2/92	DEL			


SANITARY SEWER SYSTEM



CUSTOMER: **W. SEDGWICK COUNTY SEWER DISTRICT**

SCALE	PROJECT NO.
1" = 20'-00"	20-036
DATE: 6-20-88	SHEET 14 OF 23

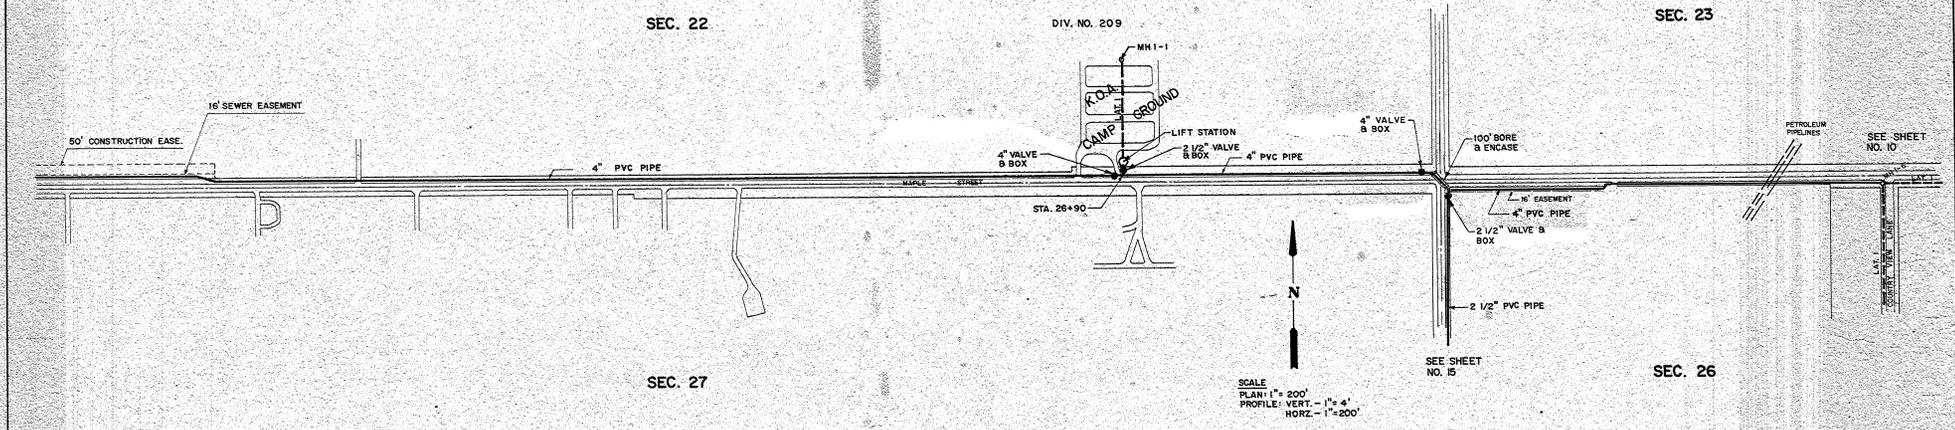

FORCE MAIN "A" (FORCE MAIN ON MAPLE STREET)





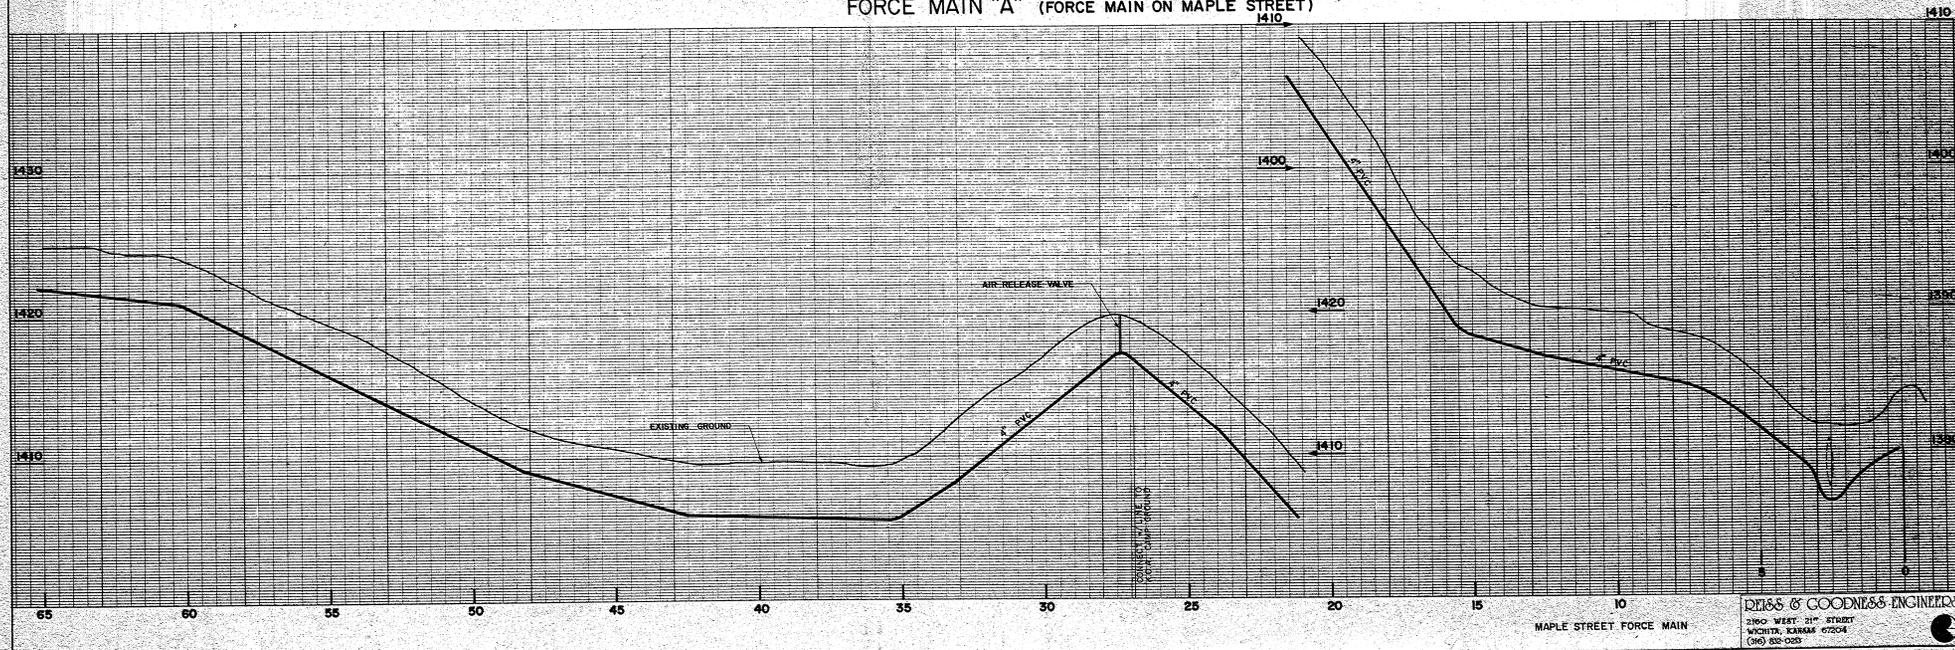


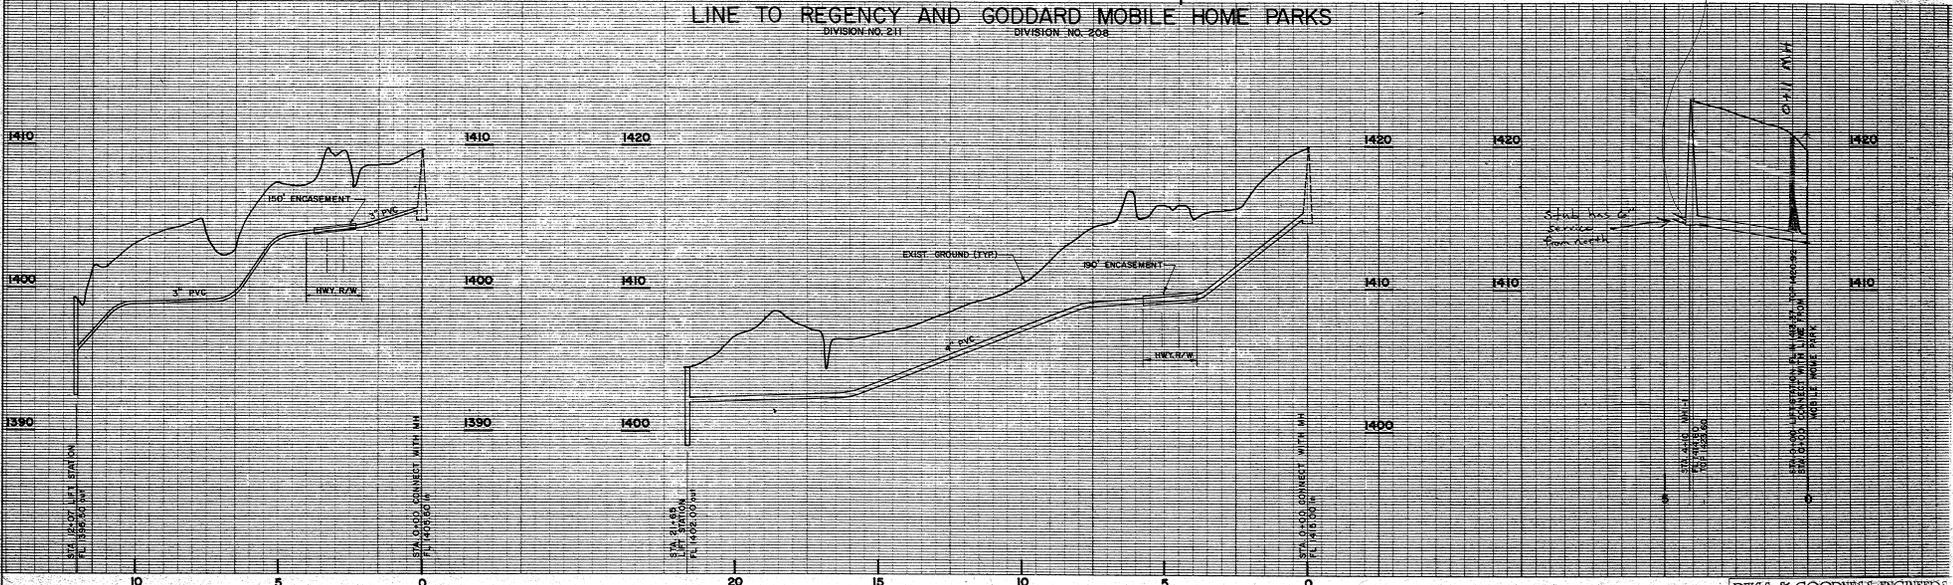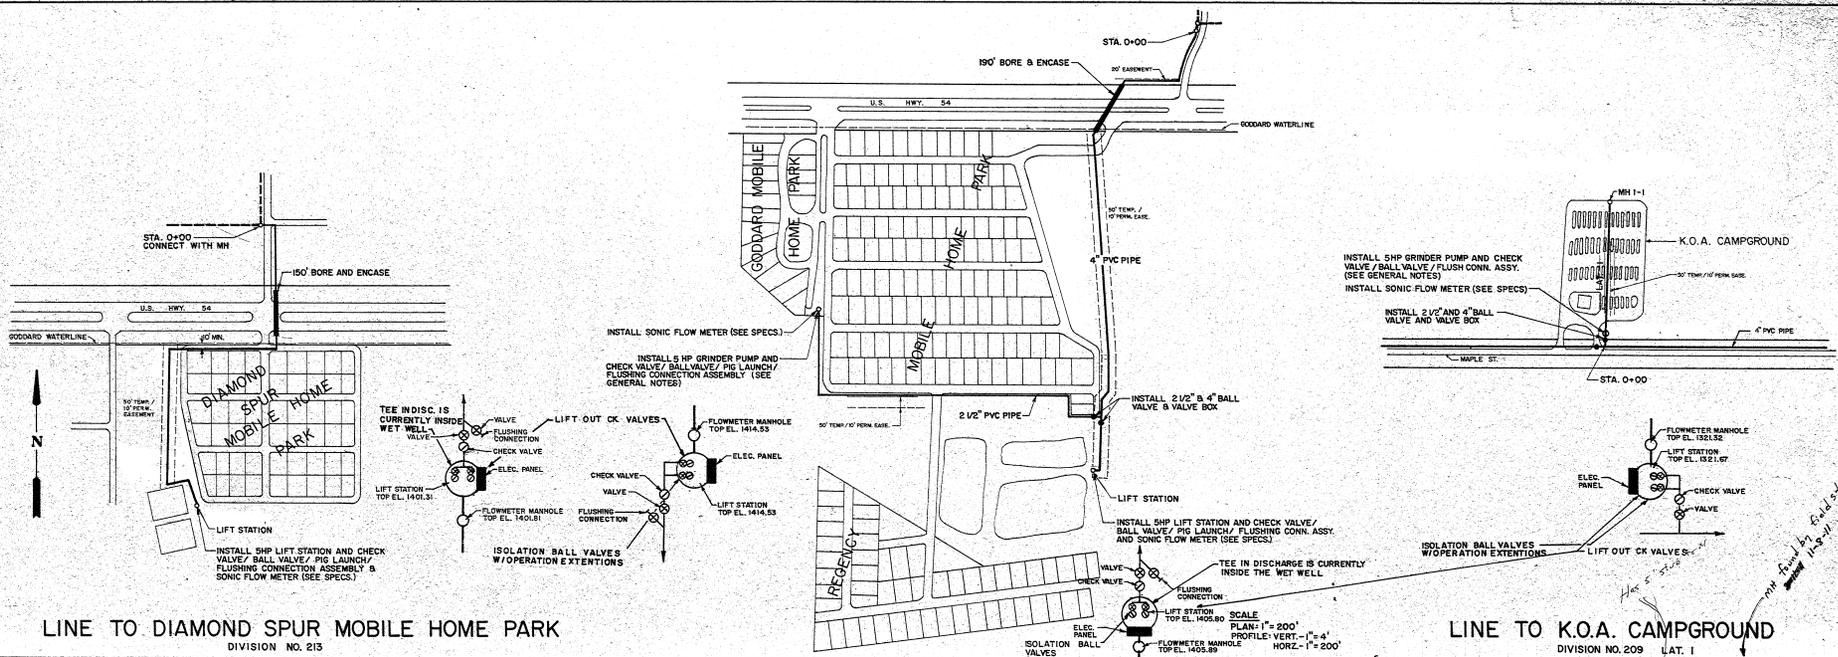



U.S. HWY 54

SERVICE WYE WITH DISTANCE FROM DOWNSTREAM MANHOLE

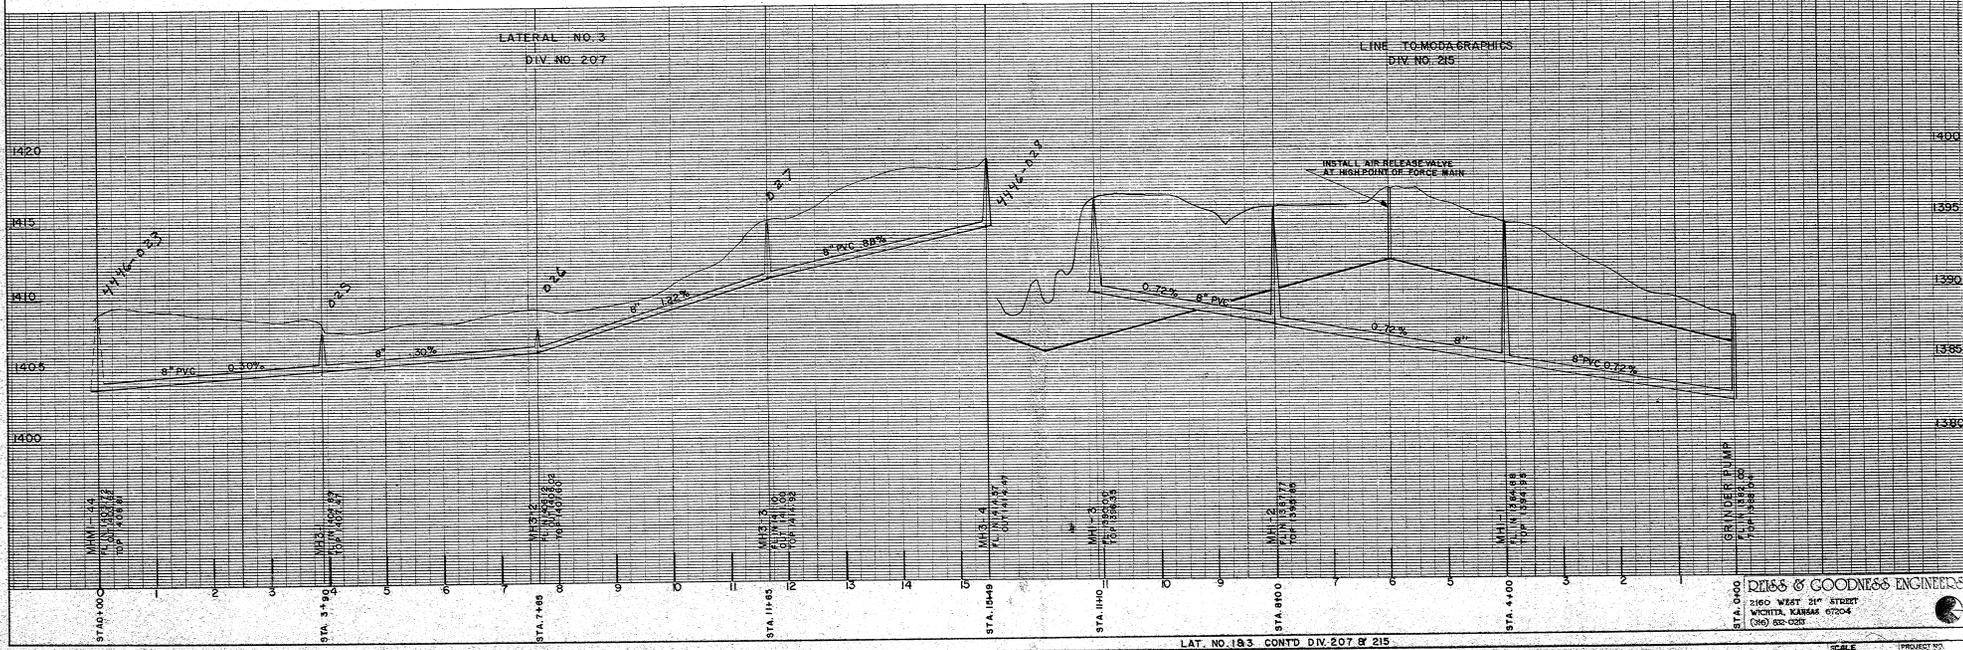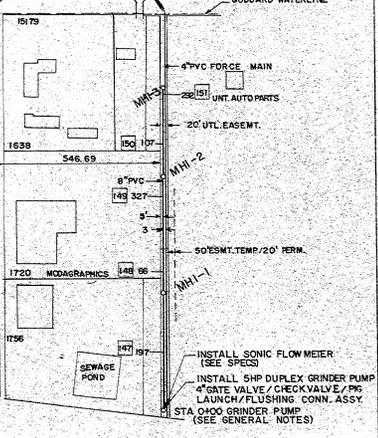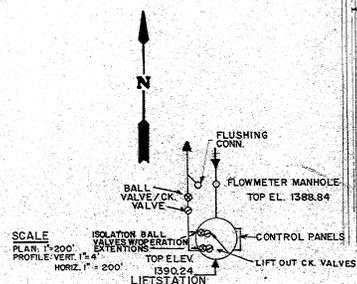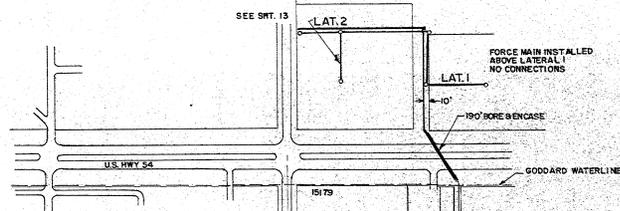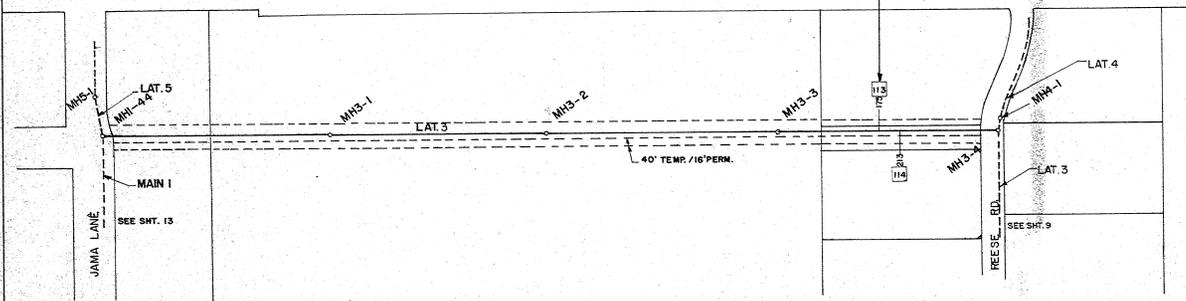

REVISION: _____ DRAWN BY: _____ CHECKED BY: _____ DESIGNED BY: _____ PROJECT: **SEWAGE COLLECTION SYSTEM** CUSTOMER: **W. SEDGWICK COUNTY SEWER DISTRICT**

DEISS & GOODNESS ENGINEERS
2160 WEST 21ST STREET
WICHITA, KANSAS 67204
(316) 832-0281

SCALE: _____
DATE: 6.20.88 SHEET: 18 OF 25