

GENERAL NOTES:

1. The Contractor shall comply with all applicable safety regulations. All construction shall be completed following current City Standard Specifications and Special Provisions.

2. Contractor will be required to provide notice to utility companies a minimum of seventy-two (72) hours prior to any excavation, as follows:

Kansas One-Call 687-2470

The Contractor must notify the following in case of an emergency:

A&T 1-800-246-8464
Black Hills Energy 1-800-634-8889
City of Wichita Water & Sewer 1-316-219-8921
City of Wichita Stormwater 1-316-268-4090
City of Wichita Traffic 1-316-268-4034
Cox Communications 1-888-249-3530
Kansas Gas Service 1-888-482-4950
Energy 1-800-544-4857

3. Utility service lines, poles, etc. are to be adjusted as necessary by others prior to construction unless the plans specifically call for their adjustment. By the Contractor or unless the plans specifically identify a utility to be adjusted by its owner during construction. Existing utilities and their location, as shown on the plans, represent the best information obtainable for design. The Contractor will be required to work around existing utilities within the right-of-way which do not conflict with proposed construction.

4. Rubble from the removal of miscellaneous structures and excess excavation which is to be wasted shall be disposed of on sites to be provided by the Contractor. These sites shall be approved by the Engineer as to suitability, appearance and site location. Locations, in the opinion of the Engineer, that will leave an unsightly appearance will not be approved. All disposal sites must be approved by the Kansas Department of Health and Environment. Material either stockpiled or disposed of in a flood plain will require a Kansas State Board of Agriculture permit. Any material dumped in waters of the United States or wetlands is subject to U.S. Corps of Engineers permitting regulations. Any material buried or stockpiled beyond approved construction limits will require additional archaeological investigations unless buried in a previously approved borrow location.

5. Trees and shrubs in public right-of-way which are in direct conflict with proposed new construction shall be removed by the Contractor with the City Engineer's approval. Trees and shrubs which are not in direct conflict with proposed new construction shall be saved and protected from damage.

6. The Contractor shall give all property owners and/or tenants of developed property abutting the construction of this project a minimum of ten (10) days notice prior to start of construction.

7. The Contractor shall be responsible for preserving property lines. The Contractor will be required to re-establish any property lines which are damaged or destroyed by his construction operations. Such lines shall be re-established by a licensed land surveyor in accordance with state laws.

8. The Engineering Division shall field locate water valve one time during construction when requested by the Contractor. It shall be the Contractor's responsibility to preserve such field locations during the construction process. Water valves, valve boxes or fire hydrants damaged during construction shall be repaired by Contractor at his own expense. Valve boxes and water meters within the project limits shall be adjusted to match field grades by the contractor.

9. The Contractor shall notify the consultant engineer and Dominika Reinhardt at 316-650-0740 with the City of Wichita with the anticipated construction start date and notify them of project completion. Staking and inspection for this project will be the responsibility of the Contractor.

10. If traffic will be impacted by construction, a traffic control plan must be submitted and approved by the City Traffic Engineer at traffic@wichita.gov before construction can begin. The Contractor shall be responsible for all traffic control measures to facilitate construction. All construction zone markings and signage shall conform to the latest version of Manual on Uniform Traffic Control Devices (MUTCD) as published by the US Dept. of Transportation, Federal Highway Administration. All costs associated with construction markings and signage shall be the Contractor's responsibility.

11. All elevations shown are NAVD88.

12. All areas disturbed during construction that will not be under proposed pavement shall be restored to match existing conditions per City specifications.

13. All applicable fees (tap, equity, in lieu of & main benefit) must be paid before any connections can be made on this project. Quotes can be obtained on fees by calling 316-268-4641.

14. City Maintenance of sanitary sewer mains ends at last structure within easement.

15. All stubs and capped pipes shall be located with green plastic tape in the same manner as risers.

16. Connecting to Existing Manholes: Prior to laying sewer lines using existing stubs in existing manholes, the Contractor shall expose and verify the elevation, grade and alignment of existing stubs and notify the Engineer of any deviation from the plans. Where the stub is unusable due to elevation grade or alignment, the Contractor shall remove the stub and plug the hole, and reshape the existing manhole invert to provide smooth flow. Where connection to an existing manhole that does not have an existing stub, the Contractor shall core cut into existing manhole wall to make connection using approved water stop gasket, and reshape the existing manhole invert to provide smooth flow. The cost of connect to existing manholes is incidental to the project.

17. Contractor shall limit the extent of trench open overnight and weekends to less than 50 feet.

18. Contractor shall provide positive drainage away from all manhole covers.

19. The Contractor shall prevent any construction debris from entering the existing sanitary sewer during construction.

20. The Contractor shall be responsible for maintaining continuous flow of sewage through construction. Contractors proposed method for maintaining sewage flow shall be submitted and approved by the Sewer Maintenance Division (316-268-4073) prior to starting and by-passing of sewage flows.

21. Any over excavation from manhole and pipe removal shall be backfilled with AB-3 compacted to 90-95% ASTM D698.

22. The Contractor shall protect from damage and support existing utilities through construction as approved by the utility owner and the Engineer at the contractor's expense.

23. All areas disturbed during construction are to be seeded as follows:

Seed -- Rye grass; 5 lbs./1000 Sq. Ft.

All costs associated with seeding including mobilization, preparation of ground, seeding, fertilizing, mulching, etc. shall be included in the L.S. bid item "Seeding".

24. All existing and proposed erosion control measures including silt fencing, erosion control mat, straw bales, inlet barriers, and const. entrance shall be maintained throughout construction by the contractor and until project is accepted by the City of Wichita. The on-site engineer shall complete weekly reports on the status of erosion control measures. The contractor shall be required to comply with maintenance and/or replacement of erosion control measures as determined by the on-site engineer until project is accepted by City of Wichita. Maintenance and/or replacement of erosion control measures to be incidental to the project.

25. The Contractor shall not begin work on the project until the Project Inspector is assigned and on site. Any work completed without inspection will be required to be uncovered for inspection at the Contractor's expense.

AS-BUILT PLANS

PRIVATE PROJECT SANITARY SEWER

to serve

2000 E 37th Street

Wichita, Kansas

Paul Gunzelman P.E. City Engineer

Project Number:

2023-034722PPS

(53030982)

5652C
SS23-08

8" PVC pipe = Northern Pipe = 570 LF.
Structures = Wichita Concrete Pipe.
Frame/Lids = Deeter.



BEGAN: 01/03/2024
ENDED: 02/01/2024

Vicinity Map

Sheet Index

Title Sheet	1
Line 1	2
Manhole Detail	3
Manhole Lid Detail	4
Erosion Control Plan	5

*Current Stormwater Control Details are available at City of Wichita website at <http://www.wichita.gov/PWU/StandardsConstruction/Forms/WebPage/StandardsConstruction.aspx>

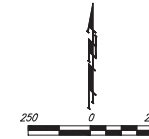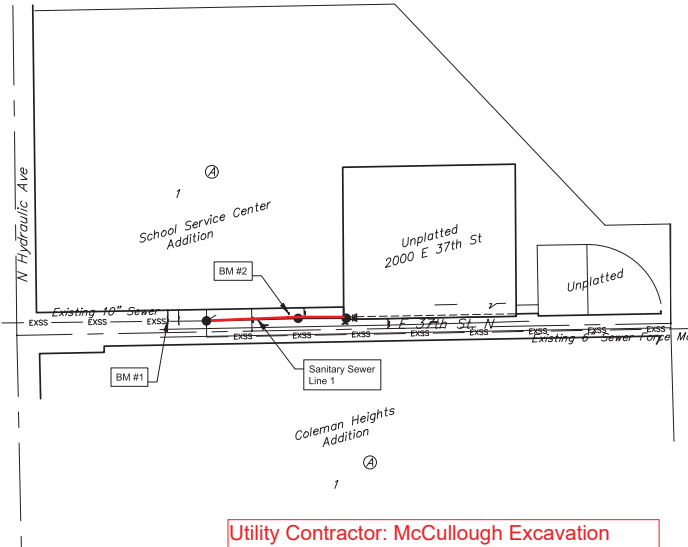

Utility Contractor: McCullough Excavation
Superintendent = Rob Gray
Inspection: Baughman Co, PA
Staking: Baughman Co, PA
Inspector: Beau Gibler
As-Built Plans by: B. Gibler, 02/02/24

Benchmarks

SITE BENCHMARK #1
Chiselled square on Top of Curb
westside of the south drive entrance for
3550 N Hydraulic Ave, Wichita, KS 67219
Elevation=1328.00 (NAVD88)

SITE BENCHMARK #2
Chiselled square on Top of Headwall
Approximately 221' west and 25' north of
the southwest property corner of
2000 E 37th St., Wichita, KS 67219
Elevation=1333.58 (NAVD88)



APPROVED AS NOTED
BY WICHITA PUBLIC WORKS
ENGINEERING DIVISION

Engineering approved by Shawn Melles on 12/21/2023

Utilities approved by Deb Ary on 12/21/2023

NOTE TO CONTRACTORS

Inspection and testing for this project is to be provided by a Licensed Consulting Engineering Firm under contract with the Owner/Developer. Said inspection to be in accordance with the City of Wichita standard construction engineering practices and certified by a Licensed Professional Engineer in the state of Kansas. No work shall be performed by the Contractor without such inspection nor shall any work be commenced without written authorization by City Engineering. All Construction and Materials shall comply with the current City of Wichita Specifications and Standards and Special Provisions (on file and available at Wichita.gov).

An approved copy of these plans signed by City staff are required on-site.

Baughman # 23-09-E591

BAUGHMAN COMPANY
315 Ellis St. Wichita, KS 67211 316-262-7271
BaughmanCo.com

Dec. 21, 2023

SITE BENCHMARK #1
Chiseled square on Top of Curb
westside of the south drive entrance for
3850 N Hydraulic Ave, Wichita, KS 67219
Elevation=1329.00 (NAVD88)

SITE BENCHMARK #2
Chiseled square on Top of Headwall
Approximately 221' west and 25' north of
the southwest property corner of
2000 E 37th St., Wichita, KS 67219
Elevation=1333.58 (NAVD88)

SS MH: 45' North of CL 37th
and 131' East of CL of 3850 N
Hydraulic Ave Driveway*

Sta. 0+00.0, Line 1
Connect to existing pipe stub.
Contractor to verify condition
of existing pipe. If existing
condition is compromised
Contractor to remove stub,
install new pipe, grout and
seal new pipe penetration.
Reshape invert if necessary.
Top Elev. = 1328.20
N. 1,709,817.44
E. 1,654,976.20

Top Elev. = 1328.69
N: 1,709,817.47
E: 1,654,976.21

~~If 2.5" force main is in conflict with new sanitary, remove from existing manhole at STA 0+00 and connect to new manhole at STA 5+62. Repair pipe penetration in existing manhole with brick and non-shrink grout.~~

3850 N Hydraulic Ave
Wichita, KS 67219
Owner: USD 259
903 S Edgemoor St
Wichita, KS 67211

SS MH: 47' North of CL 37th
and 500' East of CL of 3850 N
Hydraulic Ave Driveway*

Sta. 3+69.0, Line 1
Const. Standard Manhole
Top Elev. = 1333.10
N: 1,709,827.70
E: 1,655,345.06

Top Elev. = 1333.29
N: 1,709,828.27
E: 1,655,345.01

SS MH: 46' North of CL 37th
and 696' East of CL of 3850 N
Hydraulic Ave Driveway*

Sta. 5+62.2, Line 1
Const. Standard Manhole
1-4" Stub (NE)
~~Top Elev. = 1337.70~~
~~N: 1,709,828.19~~
~~E: 1,655,538.29~~
Top Elev. = 1338.04
N: 1709828.16
E: 1655538.30


--	--

2000 E 37th St N
Wichita, KS 67219
Owner: HAZF LLC
625 E 1st St
Wichita, KS 67202

40 0 40 5 0


Scale: 1" = 40' Horizontal
1" = 5' Vertical
= Iron

NOTE:
SS Line 1 Installed
on Plan Alignment.

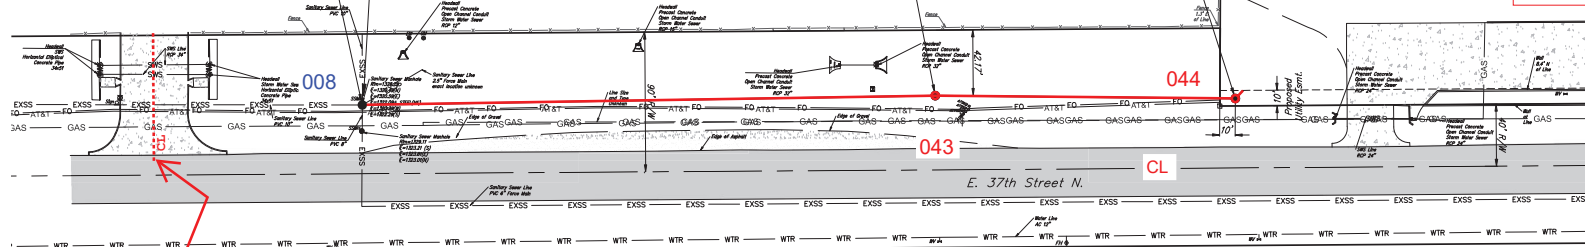

* Centerline of Driveway
for 3850 N. Hydraulic
Ave. Service Entrance

3600 N Hydraulic Ave
Wichita, KS 67219
Owner: Coleman
Company Inc
PO Box 54467
Lexington, KY 40555

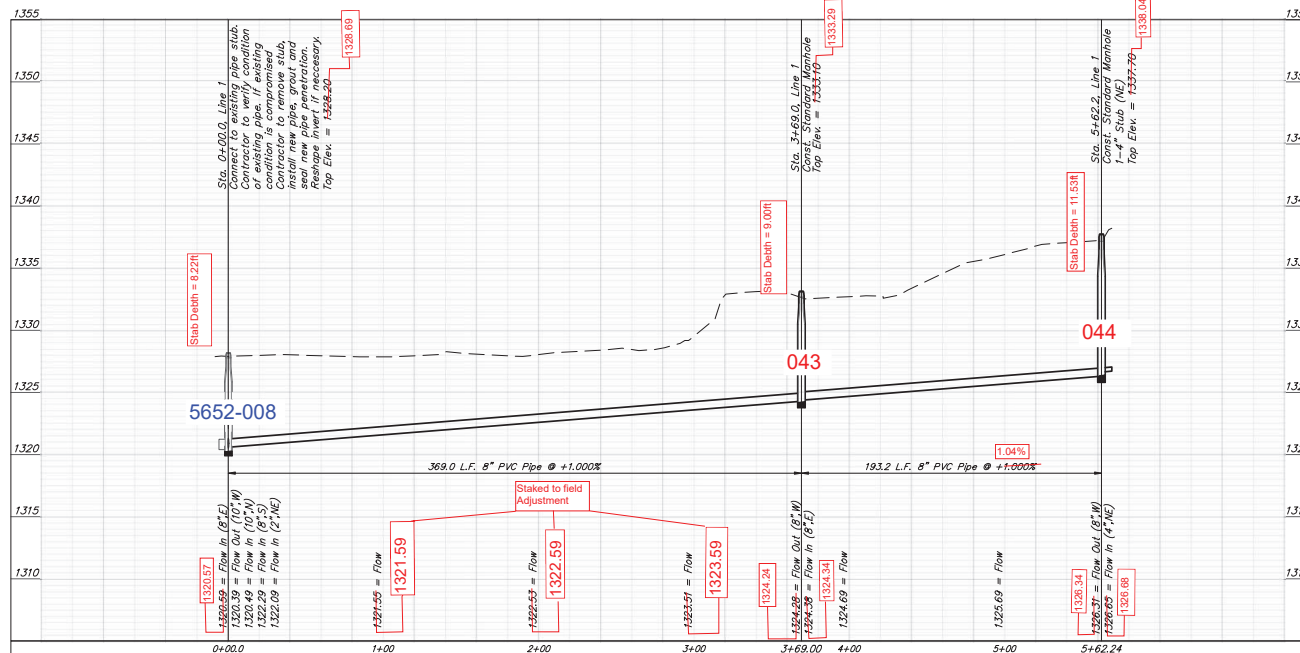BAUGHMAN
COMPANY

315 Ellis St.
Wichita, KS 67211
316-262-7271
BaughmanCo.com

2000 E 37th St

Line 1

Sanitary Sewer Improvements

PROJECT NUMBER:

DESIGN: PDM DRAWN: PDM

SHEET OF

2 OF 5

le: E:\Projects\2000 E 37th St N Sanitary_23-09-E591\Engineering\Phase 1\PPSPS.dwg