



THE MOORINGS PLAZA FOURTH ADDITION



SANITARY SEWER

PHASE 1

SS LINE 1

PROJECT NO. 468-2023-011804
 SCALE H-1"=40' V-1"=5'
 DRAWN BY: [Name]
 CHECKED BY: [Name]
 BWS DFL SFE

SHEET NO. 05 OF 13

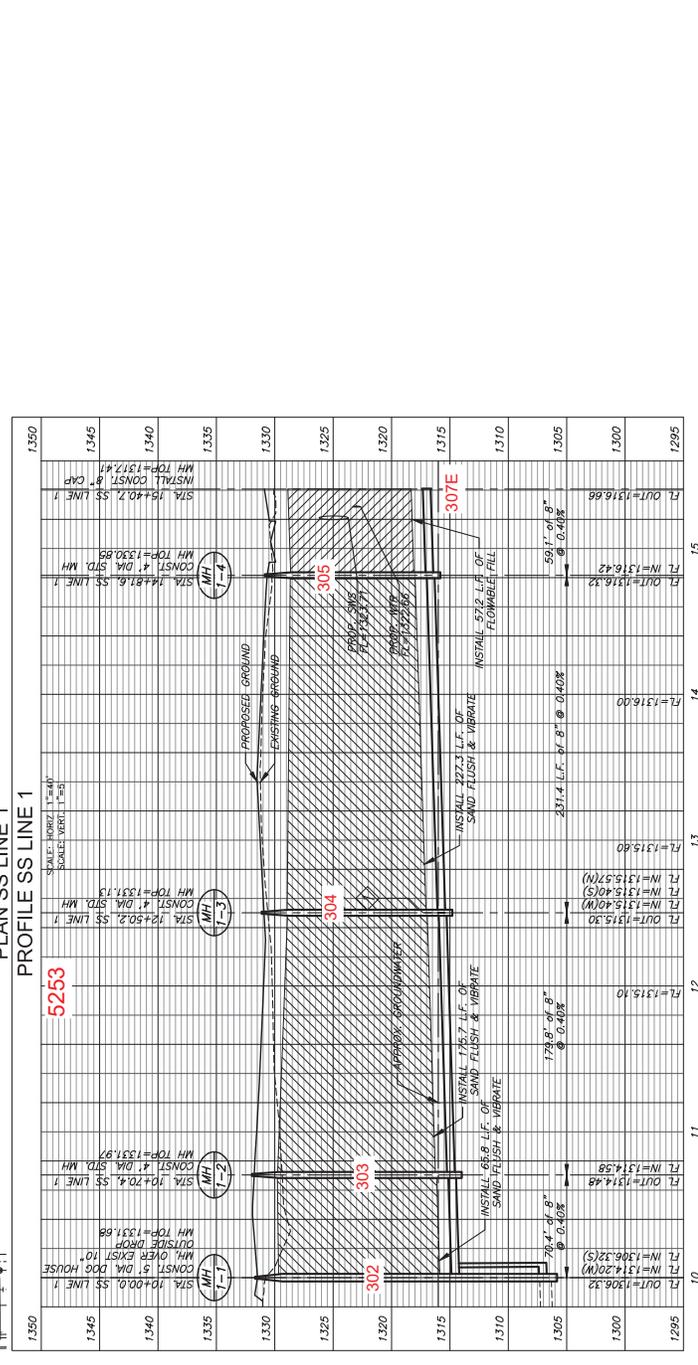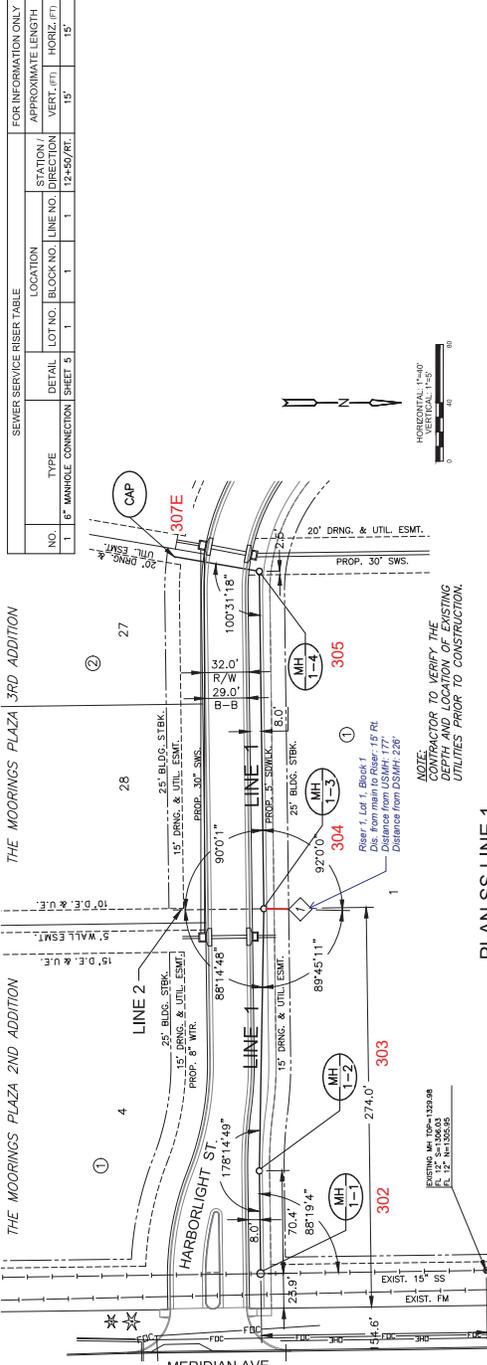




THE MOORINGS PLAZA FOURTH ADDITION
 SANITARY SEWER
 PHASE 1

PROJECT NO.	468-2025-011804
SCALE	1"=40'
OWNER	CHICAGO CD
DESIGNER	BWS DFL SFE
DATE	

EVERY ATTEMPT HAS BEEN MADE TO INSURE ALL COORDINATE VALUES SHOWN ARE AN ACCURATE AND TRUE REPRESENTATION OF THE CURRENT PLANS. ALL VALUES ARE TO BE CONFIRMED WITH THE FINAL SIGNED PLAN SET BEFORE USE.

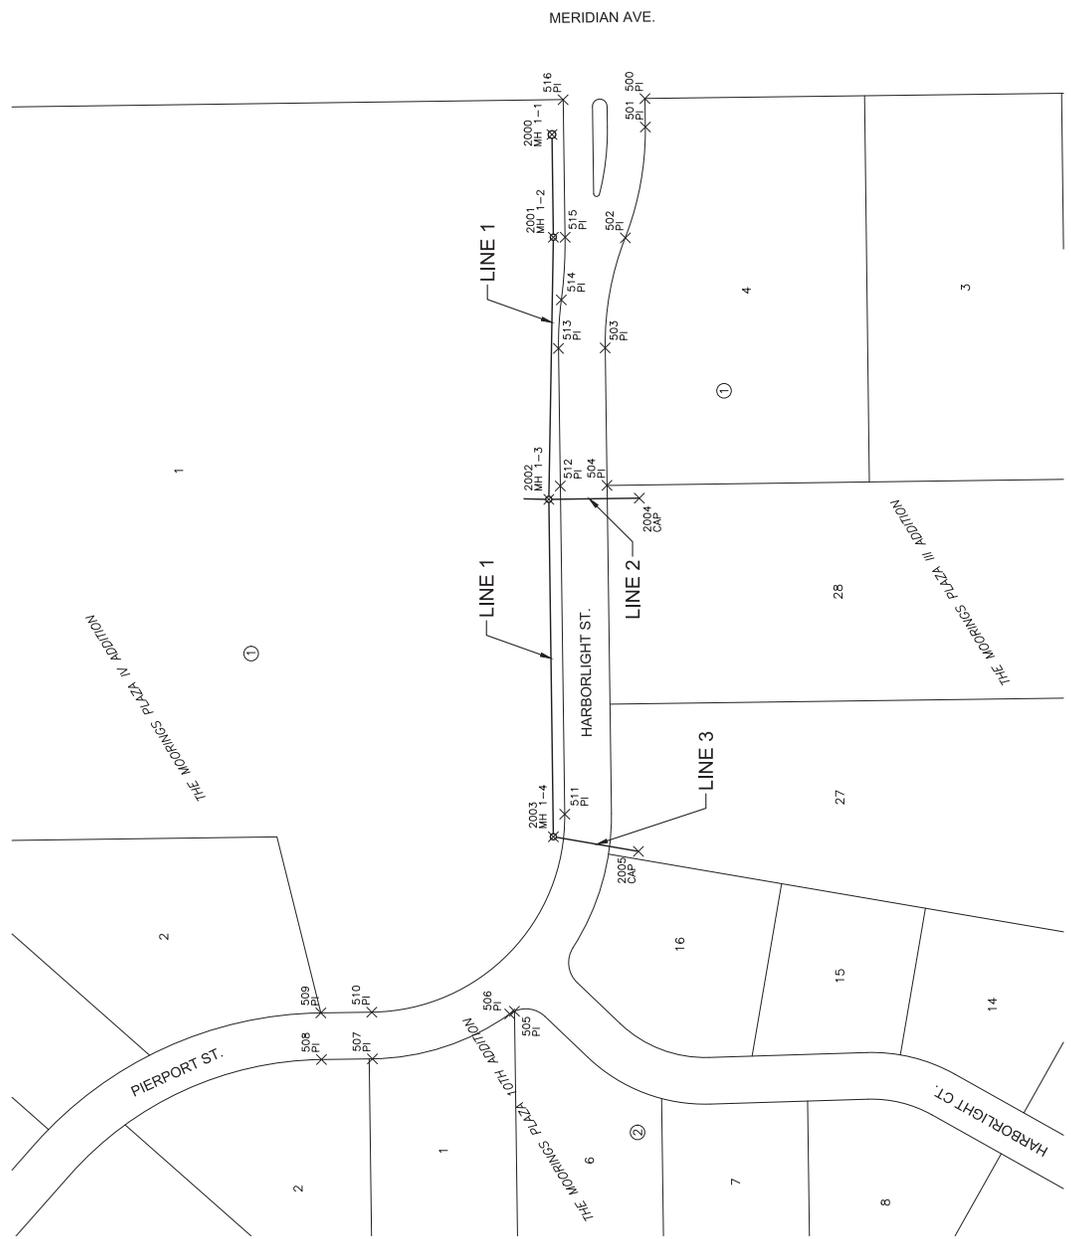

PLAT POINTS			
Point #	Northing	Eastng	Desc.
500	1717786.60	1638532.44	PI
501	1717786.29	1638512.96	PI
502	1717800.02	1638436.96	PI
503	1717813.86	1638361.48	PI
504	1717812.60	1638267.23	PI
505	1717876.00	1637906.61	PI
506	1717879.21	1637904.76	PI
507	1717973.31	1637873.97	PI
508	1718008.23	1637873.50	PI
509	1718008.66	1637905.50	PI
510	1717973.74	1637905.97	PI
511	1717841.55	1638041.75	PI
512	1717844.61	1638286.81	PI
513	1717845.64	1638361.15	PI
514	1717843.87	1638394.42	PI
515	1717841.25	1638437.41	PI
516	1717842.67	1638531.69	PI

SANITARY POINTS			
Point #	Northing	Eastng	Desc.
2000	1717850.29	1638507.81	MH 1-1
2001	1717849.35	1638437.39	MH 1-2
2002	1717852.44	1638257.63	MH 1-3
2003	1717846.34	1638026.27	MH 1-4
2004	1717790.43	1638258.46	CAP
2005	1717791.05	1638016.25	CAP

