

**GENERAL NOTES**

- THE CONTRACTOR SHALL COMPLY WITH ALL APPLICABLE SAFETY REGULATIONS. ALL CONSTRUCTION SHALL BE COMPLETED FOLLOWING CURRENT CITY STANDARD SPECIFICATIONS AND SPECIAL PROVISIONS.
- CONTRACTOR WILL BE REQUIRED TO PROVIDE NOTICE TO UTILITY COMPANIES A MINIMUM OF SEVENTY-TWO (72) HOURS PRIOR TO ANY EXCAVATION, AS FOLLOWS:  
 KANSAS ONE-CALL 687-2470  
 THE CONTRACTOR MUST NOTIFY THE FOLLOWING IN CASE OF AN EMERGENCY:  
 AT&T 1-800-246-8464  
 BLACK HILLS ENERGY (GAS) 1-800-294-2899  
 CITY OF WICHITA WATER & SEWER 1-316-219-6971  
 CITY OF WICHITA STORMWATER 1-316-268-4050  
 CITY OF WICHITA TRAFFIC 1-316-268-4038  
 COX COMMUNICATIONS 1-888-249-3530  
 KANSAS GAS SERVICE 1-888-422-6950  
 EVERGY 1-800-544-4857
- UTILITY SERVICE LINES, POLES, ETC. ARE TO BE ADJUSTED AS NECESSARY BY OTHERS PRIOR TO CONSTRUCTION. THE PLANS SPECIFICALLY CALL FOR THEIR ADJUSTMENT BY THE CONTRACTOR OR OTHERS. THE PLANS SPECIFICALLY IDENTIFY A UTILITY TO BE ADJUSTED BY ITS OWNER DURING CONSTRUCTION. EXISTING UTILITIES AND THEIR LOCATION, AS SHOWN ON THE PLANS, REPRESENT THE BEST INFORMATION OBTAINABLE FOR DESIGN. THE CONTRACTOR WILL BE REQUIRED TO WORK AROUND EXISTING UTILITIES WITH THE RIGHT-OF-WAY WHICH DO NOT CONFLICT WITH PROPOSED CONSTRUCTION.
- RUBBLE FROM THE REMOVAL OF MISCELLANEOUS STRUCTURES AND EXCESS EXCAVATION WHICH IS TO BE WASTED SHALL BE DEPOSITED ON SITES TO BE PROVIDED BY THE CONTRACTOR. THESE SITES SHALL BE APPROVED BY THE ENGINEER AS TO SUITABILITY, APPEARANCE AND SITE LOCATION. LOCATIONS, IN THE OPINION OF THE ENGINEER, THAT WILL LEAVE AN UNSIGHTLY APPEARANCE WILL NOT BE APPROVED. ALL DISPOSAL SITES MUST BE APPROVED BY THE KANSAS DEPARTMENT OF HEALTH AND ENVIRONMENT. MATERIAL, EITHER STOCKPILED OR DEPOSITED ON IN A FLOOD PLAIN, WILL REQUIRE A KANSAS STATE BOARD OF AGRICULTURE PERMIT. ANY MATERIAL DUMPED IN WATERS OF THE UNITED STATES OR WETLANDS IS SUBJECT TO U.S. CORPS OF ENGINEERS PERMITTING REGULATIONS. ANY MATERIAL BURIED OR STOCKPILED BEYOND APPROVED CONSTRUCTION LIMITS WILL REQUIRE ADDITIONAL ARCHAEOLOGICAL INVESTIGATIONS UNLESS BURIED IN A PREVIOUSLY APPROVED BURIAL LOCATION.
- TREES AND SHRUBS IN PUBLIC RIGHT-OF-WAY WHICH ARE IN DIRECT CONFLICT WITH PROPOSED NEW CONSTRUCTION SHALL BE REMOVED BY THE CONTRACTOR WITH THE CITY ENGINEER'S APPROVAL. TREES AND SHRUBS WHICH ARE NOT IN DIRECT CONFLICT WITH PROPOSED NEW CONSTRUCTION SHALL BE SAVED AND PROTECTED FROM DAMAGE.
- THE CONTRACTOR SHALL GIVE ALL PROPERTY OWNERS AND/OR TENANTS OF DEVELOPED PROPERTY ADJUTING THE CONSTRUCTION OF THIS PROJECT A MINIMUM OF TEN (10) DAYS NOTICE PRIOR TO START OF CONSTRUCTION.
- THE CONTRACTOR SHALL BE RESPONSIBLE FOR PRESERVING PROPERTY BORDERS. THE CONTRACTOR WILL BE REQUIRED TO RE-ESTABLISH ANY PROPERTY BORDERS WHICH ARE DAMAGED OR DESTROYED BY HIS CONSTRUCTION OPERATIONS. SUCH RONS SHALL BE RE-ESTABLISHED BY A LICENSED LAND SURVEYOR IN ACCORDANCE WITH STATE LAWS.
- THE ENGINEERING DIVISION SHALL FIELD LOCATE WATER VALVES ONE TIME DURING CONSTRUCTION WHEN REQUESTED BY THE CONTRACTOR. IT SHALL BE THE CONTRACTOR'S RESPONSIBILITY TO PRESERVE SUCH FIELD LOCATIONS DURING THE CONSTRUCTION PROCESS, WATER VALVES, VALVE BOXES OR FIRE HYDRANTS DAMAGED DURING CONSTRUCTION SHALL BE REPAIRED BY CONTRACTOR AT HIS OWN EXPENSE. VALVE BOXES AND WATER METERS WITHIN THE PROJECT LIMITS SHALL BE ADJUSTED TO MATCH FIELD GRADERS BY THE CONTRACTOR.
- THE CONTRACTOR SHALL NOTIFY THE INSPECTING ENGINEER AND DAMITA REINHARDT AT 605240 WITH THE CITY OF WICHITA WITH THE ANTICIPATED CONSTRUCTION START DATE AND NOTIFY THEM OF PROJECT COMPLETION, STAGING AND INSPECTION FOR THIS PROJECT WILL BE THE RESPONSIBILITY OF THE CONTRACTOR.
- IF TRAFFIC WILL BE IMPACTED BY CONSTRUCTION, A TRAFFIC CONTROL PLAN MUST BE SUBMITTED AND APPROVED BY THE CITY TRAFFIC ENGINEER AT [traffic@cityofwichita.gov](mailto:traffic@cityofwichita.gov) BEFORE CONSTRUCTION CAN BEGIN. THE CONTRACTOR SHALL BE RESPONSIBLE FOR ALL TRAFFIC CONTROL MEASURES TO FACILITATE CONSTRUCTION. ALL CONSTRUCTION ZONE MARKINGS AND SIGNAGE SHALL CONFORM TO THE LATEST VERSION OF THE MANUAL ON UNIFORM TRAFFIC CONTROL DEVICES (MUTCD) AS PUBLISHED BY THE US DEPT. OF TRANSPORTATION. HIGHWAY ADMINISTRATIVE ALL COSTS ASSOCIATED WITH CONSTRUCTION MARKINGS AND SIGNAGE SHALL BE THE CONTRACTOR'S RESPONSIBILITY.
- ALL ELEVATIONS SHOWN ARE NAVD 88.
- ALL AREAS DISTURBED DURING CONSTRUCTION THAT WILL NOT BE UNDER PROPOSED PAVEMENT SHALL BE RESTORED TO MATCH EXISTING CONDITIONS.
- ANY SIDEWALK, DRIVE APPROACH, CURB, OR STREET PAVEMENT REQUIRED TO CONSTRUCT PROJECT MUST HAVE A PAVEMENT CUT PERMIT AND BE REPLACED BY CITY CONTRACTOR. PERMITS CAN BE OBTAINED BY CALLING 316-268-4511 OR 316-268-4480.
- ALL APPLICABLE FEES (TAP, EQUITY, IN LIEU OF & MAIN BENEFIT) MUST BE PAID BEFORE ANY CONNECTIONS CAN BE MADE ON THIS PROJECT. QUOTES CAN BE OBTAINED ON FEES BY CALLING 316-268-4555.
- CITY MAINTENANCE OF SANITARY SEWER MAINS ENDS AT THE LAST STRUCTURE WITHIN THE EASEMENT OR RIGHT-OF-WAY.
- FOLLOW THE LINK BELOW FOR CONSTRUCTION DETAILS ON SPECIFIC CITY OF WICHITA STANDARD DETAILS: <https://www.wichita.gov/3162684555>
- CONTRACTOR SHALL LIMIT THE EXTENT OF TRENCH OPEN OVERNIGHT AND WEEKENDS TO LESS THAN 50 FEET.
- EXISTING UTILITIES AND THEIR LOCATION, AS SHOWN ON THE PLANS REPRESENT THE BEST INFORMATION OBTAINABLE FOR DESIGN. LOCATION INFORMATION HAS BEEN OBTAINED FROM THE VARIOUS COMPANIES AND IS EITHER FROM COMPANY UTILITY DRAWINGS OR COMPANY PROVIDED FIELD LOCATIONS. THE PLAN LOCATIONS SHOWN ARE NOT GUARANTEED. ADDITIONAL EXISTING UTILITIES MAY ALSO BE ENCOUNTERED.
- A PORTION OF EXCESS EXCAVATED MATERIAL SHALL BE MOUNDING AROUND MANHOLES WHICH EXTEND MORE THAN ONE (1) FOOT ABOVE THE EXISTING GROUND. SUCH MOUND SHALL BE CONSTRUCTED WITH NEW DEVELOPMENT A SIX (6) FOOT DIAMETER FLAT TOP WITH 4:1 SIDE SLOPES DOWN TO THE ORIGINAL GROUND. THE ELEVATION OF THE FLAT TOP OF THE MOUND SHALL BE 0.4 FOOT BELOW THE TOP OF THE MANHOLE.
- ALL STUBS AND PUGHED PIPES SHALL BE LOCATED WITH GREEN PLASTIC TAPE IN THE SAME MANNER AS RISERS.
- CONNECTING TO EXISTING MANHOLES:  
 PRIOR TO LAYING SEWER LINES USING EXISTING STUBS IN EXISTING MANHOLES, THE CONTRACTOR SHALL EXPOSE AND VERIFY THE ELEVATION, GRADE AND ALIGNMENT OF EXISTING STUBS AND NOTIFY THE ENGINEER OF ANY DEVIATION FROM THE PLANS, WHERE CONNECTION TO AN EXISTING MANHOLE THAT DOES NOT HAVE AN EXISTING STUB OR THE STUB IS UNSUITABLE DUE TO ELEVATION, GRADE OR ALIGNMENT. THE CONTRACTOR SHALL BORE CUT INTO EXISTING MANHOLE WALL TO MAKE CONNECTION USING APPROVED WATER STOP GASKET, AND RESHAPE THE EXISTING MANHOLE INVERT TO PROVIDE SMOOTH FLOW. THE COST TO CONNECTING TO EXISTING MANHOLES IS INCIDENTAL TO THE PROJECT.
- CONTRACTOR SHALL PROVIDE POSITIVE DRAINAGE AWAY FROM ALL MANHOLE COVERS.
- THE CONTRACTOR SHALL PREVENT ANY CONSTRUCTION DEBRIS FROM ENTERING THE EXISTING SANITARY SEWER DURING CONSTRUCTION.
- THE CONTRACTOR SHALL BE RESPONSIBLE FOR MAINTAINING CONTINUOUS FLOW OF SEWAGE THROUGH CONSTRUCTION. CONTRACTOR'S PROPOSED METHOD FOR MAINTAINING SEWAGE FLOW SHALL BE SUBMITTED AND APPROVED BY THE SEWER MAINTENANCE DIVISION (316-268-4073) PRIOR TO STARTING AND 51-PASSING OF SEWAGE FLOWS.
- ANY OVER EXCAVATION FROM MANHOLE AND PIPE REMOVAL SHALL BE BACKFILLED WITH A-B-3 COMPACTED TO 90-95% ASTM D958.
- WORK DONE UNDER THIS PROJECT IS SUBJECT TO THE CITY OF WICHITA REQUIREMENTS FOR "CONSTRUCTION OF INFRASTRUCTURE IMPROVEMENTS BY PRIVATE CONTRACT". THE CONTRACTOR SHALL BE FAMILIAR AND COMPLY WITH ALL OF THE REQUIREMENTS FOR INSPECTION, TESTING, NOTIFICATION, PROVIDING AS-BUILT DRAWINGS, PAYING FOR ALL NECESSARY CONNECTIONS, AND/OR STREET REPAIR FEES AND PROVIDING PIPE MATERIAL AND OTHER CERTIFICATES.
- THE CONTRACTOR SHALL PROTECT FROM DAMAGE AND SUPPORT EXISTING UTILITIES THROUGH CONSTRUCTION AS APPROVED BY THE UTILITY OWNER AND THE ENGINEER AT THE CONTRACTOR'S EXPENSE.
- DEVELOPER FOR THIS PROJECT IS:  
 HIGHSIDE COMPANIES  
 7801 E. LINCOLN AVE., SUITE 910  
 DENVER, CO 80237  
 CASEY GEMINGER  
 (314) 330-6907


**AS BUILT PLANS**  
**CONTRACTOR: MIES CONSTRUCTION**  
**SUPERINTENDENT: DALLAS MIES**  
**FOREMAN: JUAN PERALTA**  
**CLIENT: CITY OF WICHITA**  
**INSPECTOR: ROSS POWERS**  
**INSPECTION FIRM: SCHWAB-EATON, PA.**  
**PDF BY: RJP 10/11/2024**

PRIVATE SANITARY SEWER  
 TO SERVE **8133 E. Thorn Dr.**  
**EVERHOME SUITES**

THE CITY OF WICHITA, KANSAS  
 PAUL GUNZELMAN, P.E. - CITY ENGINEER  
 PROJECT NO. 2024-007980PPS  
 ORG CODE 53030982

6052C  
 SS23-06

**D. Reinhardt - City of Wichita, Inspector**  
**Riser**  
 Release Date: 11/1/2024  
 apr 2/6/2025

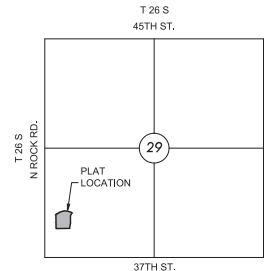


VICINITY MAP  
 No Scale

**INDEX TO DRAWINGS**

SHEET NO.	DESCRIPTION
01	TITLE SHEET
02-04	DETAILS
05	LINE 1
06	BMP SHEETS

**CONTROL POINTS**

- CP-1 (BASE): Plus "+\* Cut in Southwest corner of Storm Sewer Curb Inlet located on the South side of East Thorn Drive 108.67 feet South and 334.51 feet West of the Northeast corner of Lot 2, Block 1, Rent-A-Center Addition. N=1170734.3596 E=1676686.2814 Elevation=1385.71 (NAVD88)
- CP-2: Plus "+\* Cut on top of curb located 20.59 feet North and 63.25 feet East of the intersection of East Thorn Drive and North Rock Road. N=1170332.9965 E=1675497.2619 Elevation=1389.50 (NAVD88)
- BM-1: Square Cut on top of curb located 19.65 feet West and 28.13 feet North of the Northeast corner of Lot 1, Block 1, Rent-A-Center Addition. N=1170965.4648 E=1675963.6337 Elevation=1390.09 (NAVD88)
- BM-2: Plus "+\* Cut on North Rim of Sanitary Sewer Manhole located 75.15 feet East and 6.80 feet North of the Southeast corner of Lot 2, Block 2, Hi-Tech Industrial Park Second Addition. N=1170333.8746 E=1677633.5530 Elevation=1405.38 (NAVD88)
- BM-3: Square Cut with center plus "+\* cut in the Northeast corner of Storm Sewer Curb Inlet located 91.33 feet South and 67.68 feet East of the center of the North Comata Street Cui-De-Sac East side of Lot 6, Block 1, Hi-Tech Industrial Park Second Addition. N=1171144.6791 E=1677507.5644 Elevation=1399.42 (NAVD88)

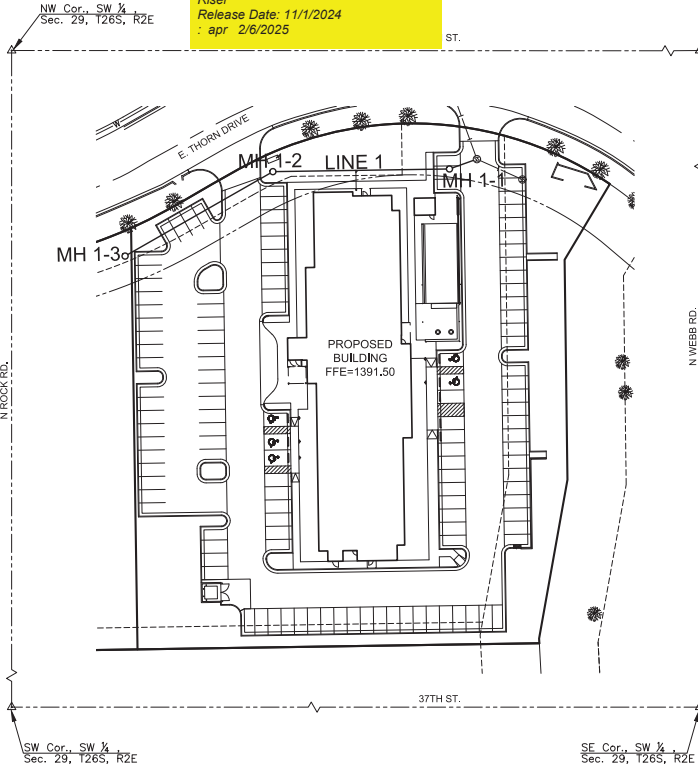

**LOT 1 LEGAL DESCRIPTION**

LOT 1, BLOCK 1, RENT-A-CENTER ADDITION, AN ADDITION TO WICHITA, SEDGWICK COUNTY, KANSAS

APPROVED AS NOTED BY WICHITA PUBLIC WORKS ENGINEERING DIVISION

Engineering approved by Shawn Mellies on this day the 3rd day of June, 2024

Utilities approved by Scott Macey on this day the 3rd day of June, 2024

NOTE TO CONTRACTORS

Public Property:  
 Inspection and testing for this project is to be provided by a Licensed Consulting Engineering Firm under contract with the Owner/Developer. Said inspection to be in accordance with the City of Wichita standard construction engineering practices and certified by a Licensed Professional Engineer in the state of Kansas. No work shall be performed by the Contractor without such inspection nor shall any work be commenced without written authorization by City Engineering. All Construction and Materials shall comply with the current City of Wichita Specifications and Standards and Special Provisions. (on file and available at Wichita.gov).

An approved copy of these plans signed by City staff is required on-site.



PRIVATE PROJECT SANITARY PLANS FOR  
**EVERHOME SUITES**  
 WICHITA, KS

0204  
 MKEC Engineering  
 All Rights Reserved  
 www.mkec.com  
 These drawings and their contents, including but not limited to all copyright notices, shall remain the intellectual property of MKEC Engineering (MKEC), and may not be used or reproduced in any way without the express consent of MKEC.



**PPS TITLE SHEET**

PROJECT NO.	2024-007980PPS	
DATE	06-03-24	
SCALE	1"=40'	
DESIGNED	DRAWN	CHECKED
MKB	BUL	SPE
NO.	REVISION	DATE

SANITARY POINTS			
Point #	Northing	Easting	MH/CO
2000	1710954.11	1675892.40	1-0
2001	1710947.41	1675873.67	1-1
2002	1710945.56	1675753.28	1-2
2003	1710888.00	1675652.52	1-3

**BUILT PER PLAN  
EXCEPT AS NOTED**


NO.	TYPE	SEWER SERVICE RISER TABLE				FOR INFORMATION ONLY	
		LOT NO.	BLOCK NO.	LINE NO.	STATION	DIRECTION	APPROXIMATE LENGTH
1	8" TEE	N/A	N/A	1	10+82.3/LT.	S	VERTICAL (FT) [6.0] HORIZONTAL (FT) [13.0]

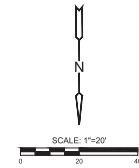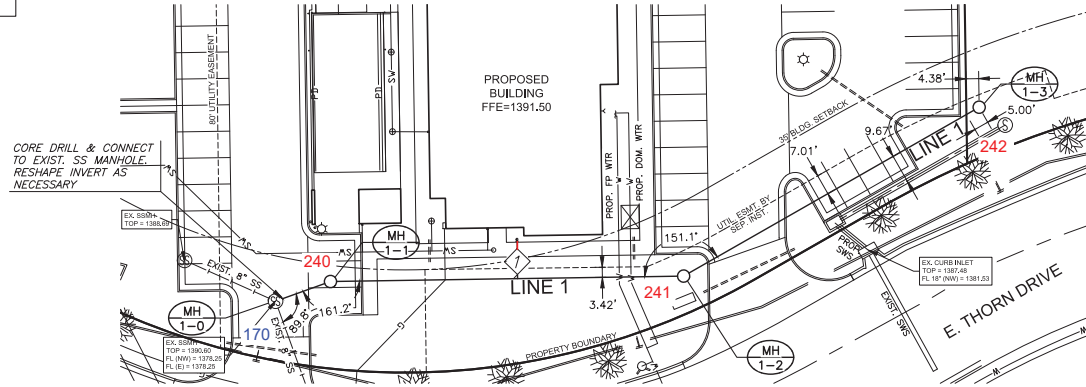

**NOTE:**  
CONTRACTOR TO VERIFY THE DEPTH AND LOCATION OF EXISTING UTILITIES PRIOR TO CONSTRUCTION.

**PLAN SAN LINE 1  
PROFILE SAN LINE 1**

SUMMARY TABLE			
ITEM	TYPE	MANUFACTURER	QTY
4' DIA STD MH	PRECAST	WCP	3 EA
8" SDR35 PVC	D3034	NORTHERN PIPE	264 LF

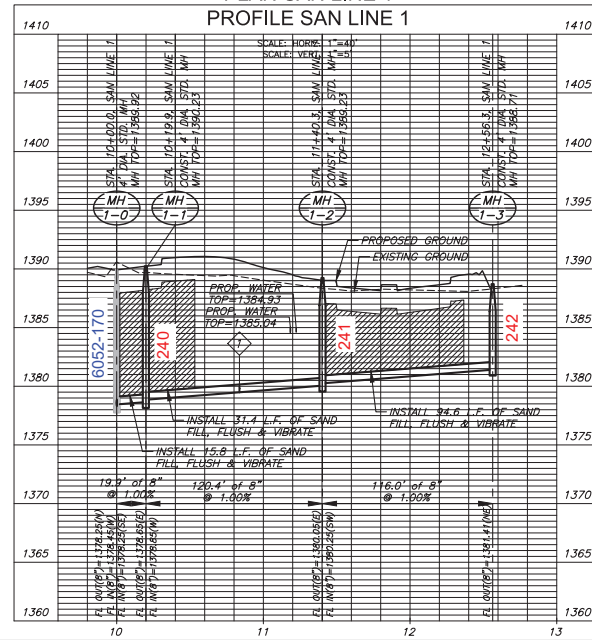

PRIVATE PROJECT SANITARY PLANS FOR  
**EVERHOME SUITES**  
WICHITA, KS

©2024  
MKEC Engineering  
All Rights Reserved  
www.mkec.com  
These drawings and their contents, including but not limited to, all copyright, design, & trade mark are the intellectual property of MKEC Engineering (MKEC), and may not be used or reproduced in any way without the express consent of MKEC.

SAN LINE 1		
PROJECT NO.	2024-007980PPS	
DATE	06-03-24	
SCALE	1"=20'	
DESIGNED	DRAWN	
MKB	BJL	
CHECKED	SPE	
NO.	REVISION	DATE
SHEET NO.		
05 OF 10		