



REV	DATE	DESCRIPTION
1	04/16/24	RFI & CITY COMMENTS
0	03/07/24	ISSUING




SUNDATA MARCELIN  
ENGINEER  
KS # 291546



**MAC MERIDIAN ADDITION**  
WEST MACARTHUR ROAD  
WICHITA, KANSAS 67217

**SANITARY SEWER IMPROVEMENTS**  
GENERAL LAYOUT SHEET


DESIGNER	CSM
CHECKED	CSM
DATE	02/19/24
SHEET	02
PROJECT	189975-QLS

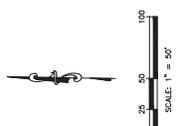

- PROPOSED LEGEND**
- 2 LOT NUMBER
  - ◇ PROJECT CONTROL POINT
  - ◇ SANITARY SEWER MANHOLE IDENTIFIER
  - ◇-◇ STORM SEWER STRUCTURE IDENTIFIER (BY SEPARATE PLANS)
  - S SANITARY SEWER MAIN
  - W WATER MAIN (BY SEPARATE PLANS)

**COORDINATE TABLE**

POINT #	NORTHING	EASTING
1	1622250.00	1462071.00
2	1616194.25	1462081.77
3	1616189.00	1439744.87
4	1616189.77	1439741.13
5	1622253.95	1439724.44

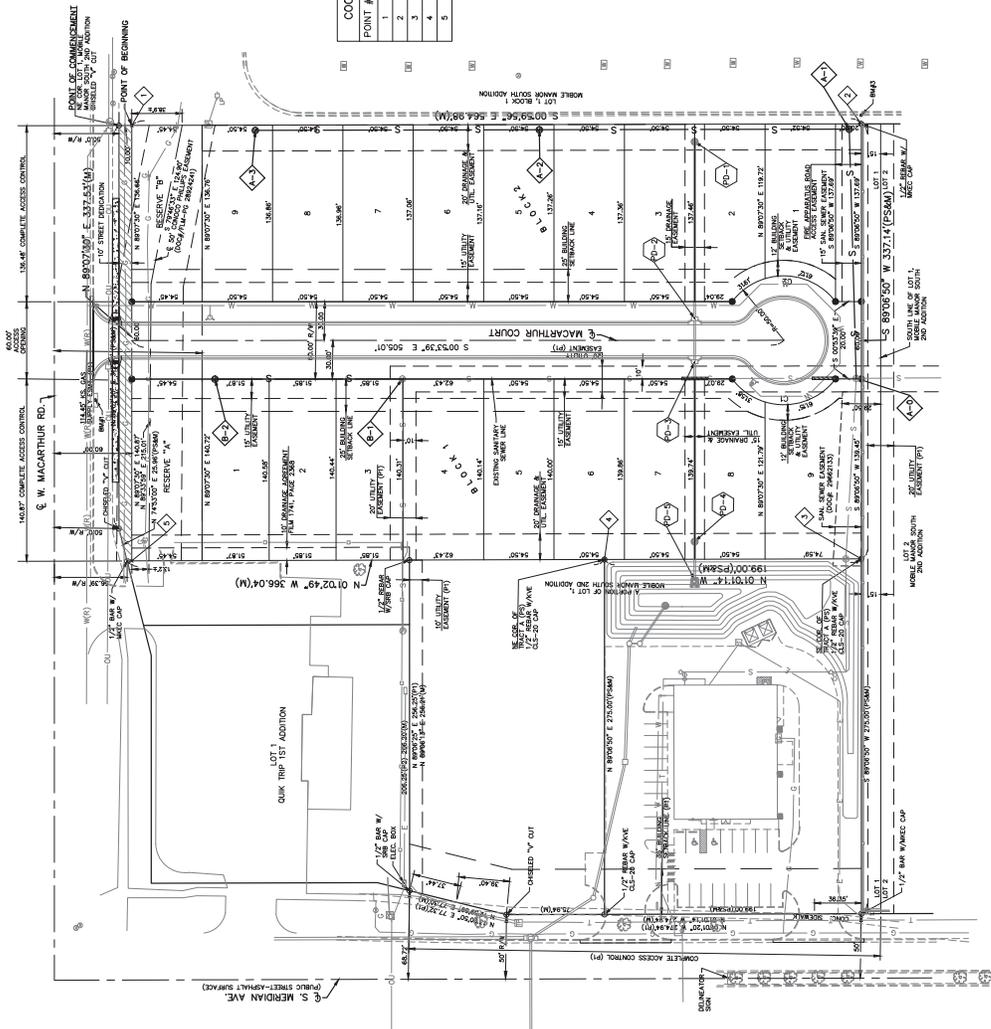

THIS DRAWING SHALL NOT BE UTILIZED BY ANY PERSON, FIRM, OR CORPORATION IN WHOLE OR IN PART WITHOUT THE SPECIFIC PERMISSION OF KAW VALLEY ENGINEERING, INC.


REV	DATE	DESCRIPTION
1	04/16/24	RFI & CITY COMMENTS
0	03/01/24	ISSUING



**KAW VALLEY ENGINEERING**  
 9139 E. 37TH STREET NORTH  
 WICHITA, KANSAS 67226  
 PH: (316) 440-4500  
 WWW.KAWVALLEYENGINEERING.COM

**MAC MERIDIAN ADDITION**  
 WEST MACARTHUR ROAD  
 WICHITA, KANSAS 67217

PROJECT NO.	2401087
DESIGNER	SAVAN BY
CHECKED	SMM
DATE	1/19/24
SHEET	03
REV.	1

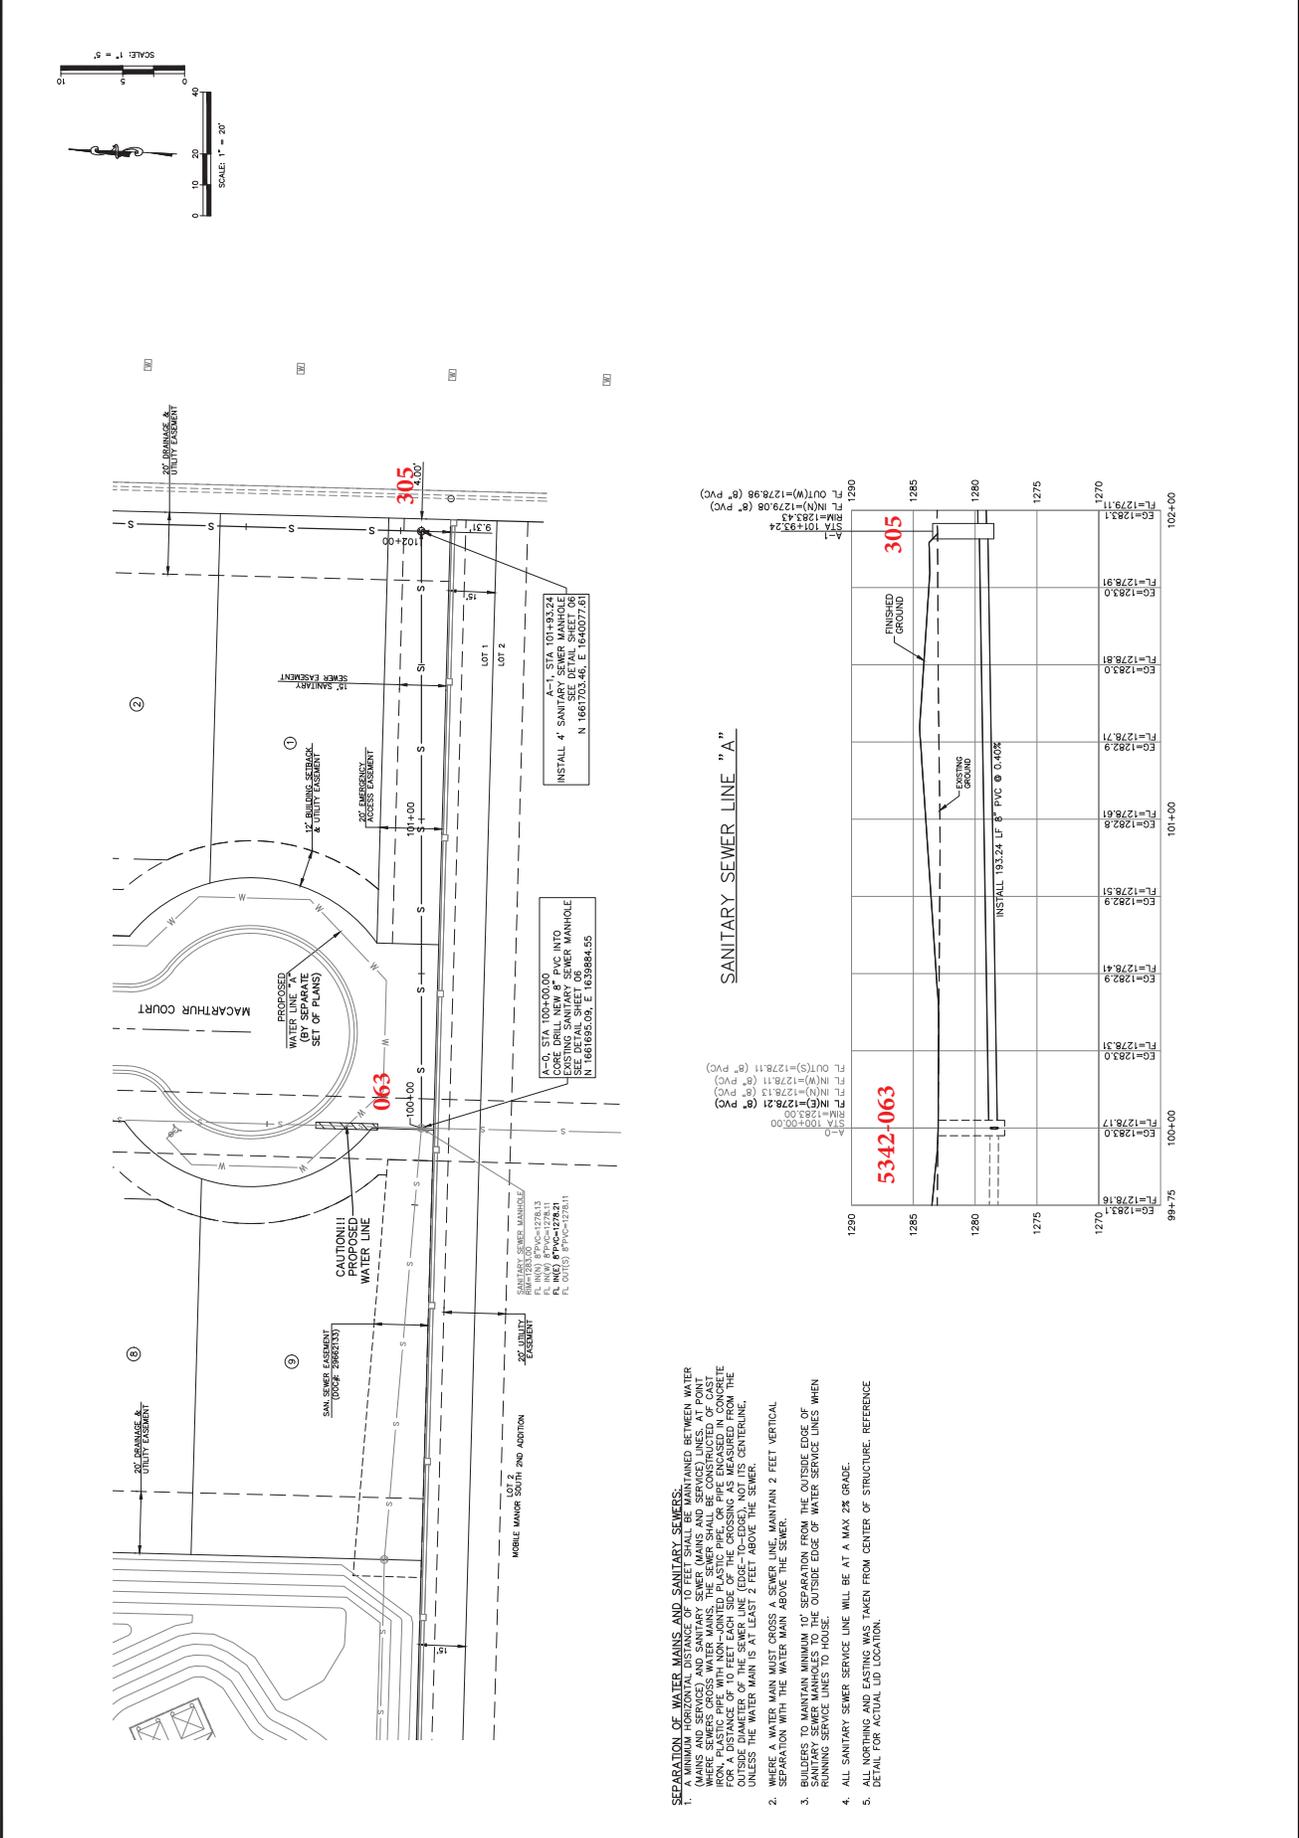


REV	DATE	DESCRIPTION
1	04/16/24	RFI & CITY COMMENTS
0	03/07/24	BIDDING

SHONDITA MARCELIN  
ENGINEER  
KS # 251546

KAW VALLEY ENGINEERING  
1919 E. 37TH STREET NORTH  
WICHITA, KANSAS 67208  
PH (316) 440-4300  
WWW.KAVE.COM

MAC MERIDIAN ADDITION  
WEST MCARTHUR ROAD  
WICHITA, KANSAS 67217  
SANITARY SEWER IMPROVEMENTS  
PLAN & PROFILE

PROJECT NO.	2024088
DESIGNED BY	SM
CHECKED BY	SM
DATE	04/16/24
SHEET	04
REV.	1

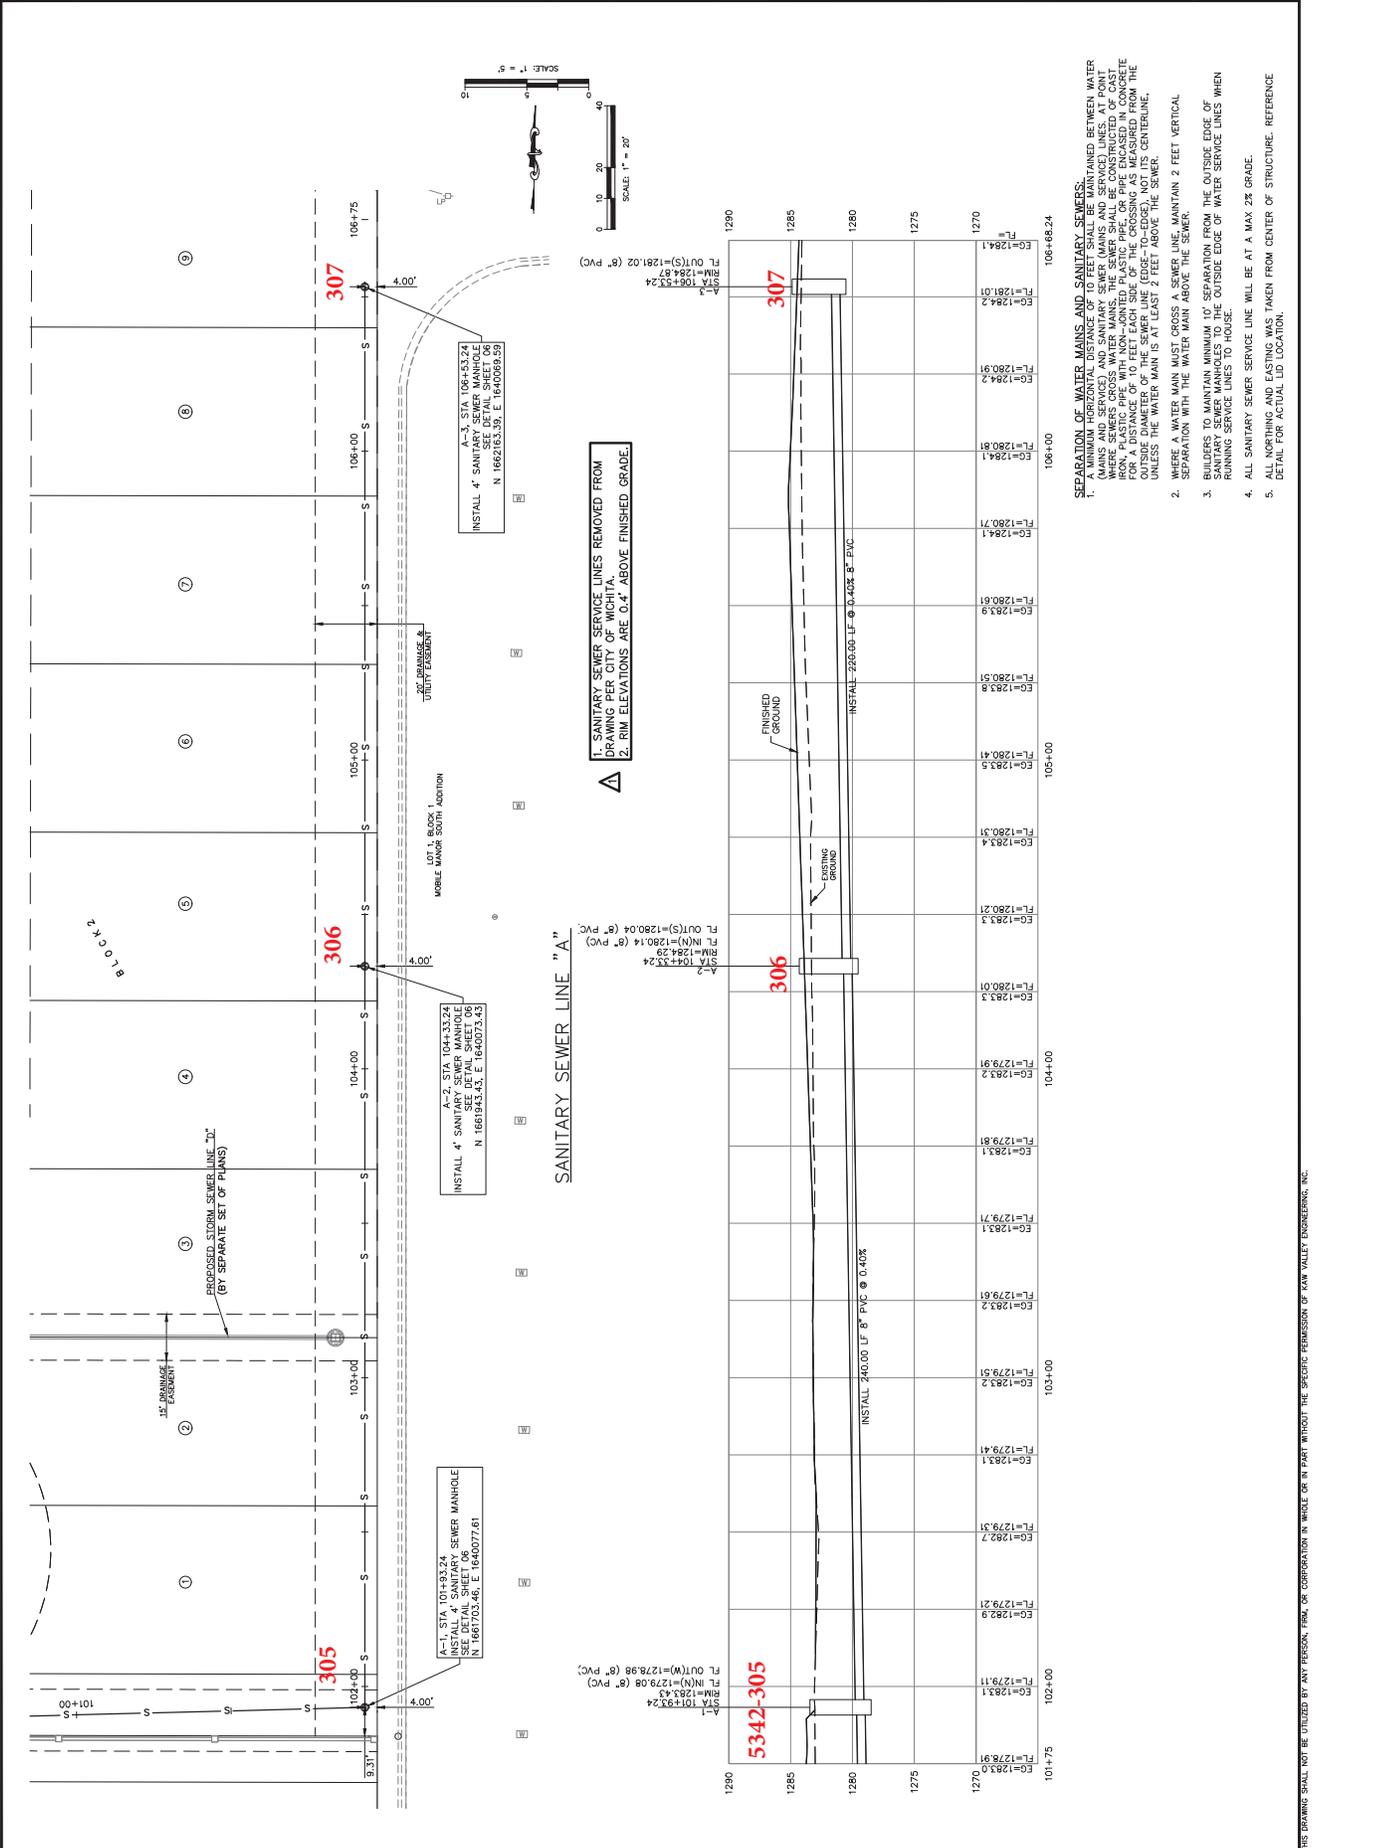

THIS DRAWING SHALL NOT BE UTILIZED BY ANY PERSON, FIRM, OR CORPORATION IN WHOLE OR IN PART WITHOUT THE SPECIFIC PERMISSION OF KAW VALLEY ENGINEERING, INC.

