

A: House to R-O-W  
 B: House to Back of Curb



VAC2010-09

# Air Capital Land Surveyors


1900 N. AMIDON, SUITE 209  
 WICHITA, KANSAS 67203

[316] 838-9071

| LEGEND            | Section | A     | B     |
|-------------------|---------|-------|-------|
| MEASURED DISTANCE | 1       | 12.1' | 51.5' |
| MEASURED DISTANCE | 2       | 7.5'  | 49.7' |
| MEASURED DISTANCE | 3       | 9.0'  | 47.5' |
| 1/8" Rebar LS #77 |         |       |       |
| MONUMENT          |         |       |       |
| OF BEGINNING      |         |       |       |

## PLAT OF SURVEY

DEC. 30, 2009

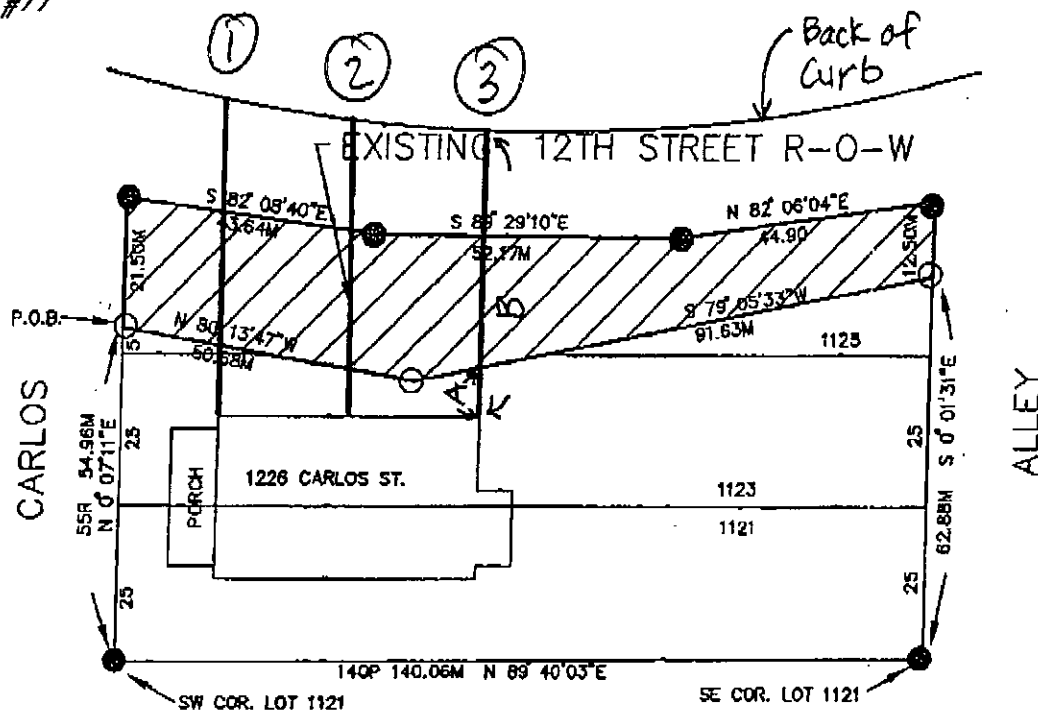

IS )  
 ) SS  
 GWICK )

Previtera, being a duly licensed land surveyor in said County hereby certify that I caused the land shown in the exhibit to be surveyed and that said survey and the exhibit are true and correct to the best of my knowledge

available.

NOTE

ROBERT A. PREVITERA  
 LICENSED  
 LS-1146  
 SURVEYOR  
 Dec. 30, 2009

A = House to R.O.W.  
B = House to Back of Curb



VAC2010-09

# Air Capital Land Surveyors

1900 N. AMIDON, SUITE 209  
WICHITA, KANSAS 67203

[316] 838-9071

## LEGEND

1 DISTANCE

2 DISTANCE

3 DISTANCE

Rebar LS #77


INUMENT

BEGINNING

| Section | A     | B     |
|---------|-------|-------|
| 1       | 1.0'  | 29.5' |
| 2       | 10.7' | 36.1' |
| 3       | 25.2' | 41.2' |

## PLAT OF SURVEY

DEC. 30, 2009

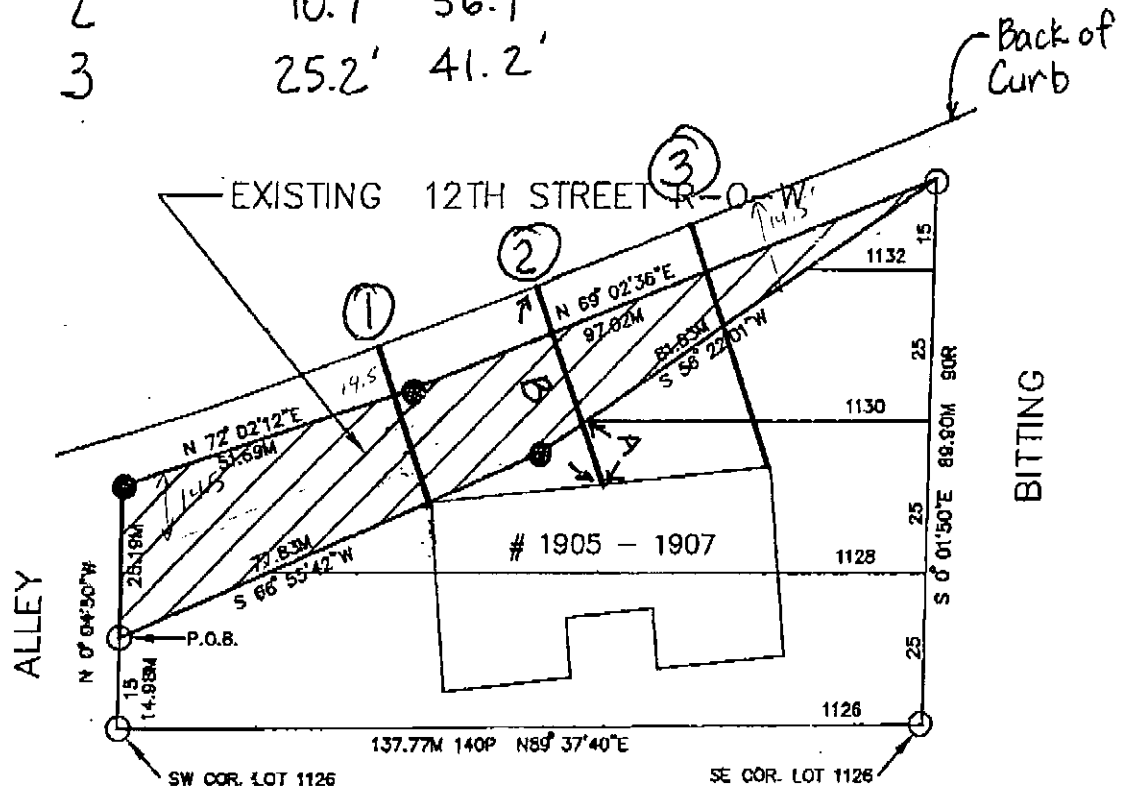


LEGAL

A tr.  
north  
desc.  
Bitt.  
City  
the  
as 91  
more

Begin  
point  
1126,  
an a:  
12" 1  
north  
56° 2  
of la  
of th  
corne  
begin


15 )  
SS  
GWICK )

evitera, being a duly licensed land surveyor in said County  
hereby certify that I caused the land shown in the  
exhibit to be surveyed and that said survey and the  
exhibit are true and correct to the best of my knowledge

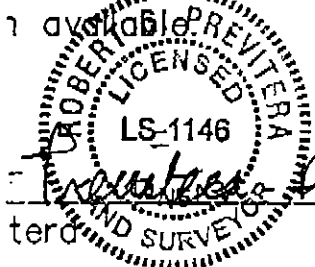

NOTE:

66

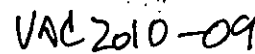

V-1328

5-30-1985

5-20-1995  
Lots 1128, 1130, 1132