




NE Corner, Section 7,
T29S, R1E of the
6th P.M.

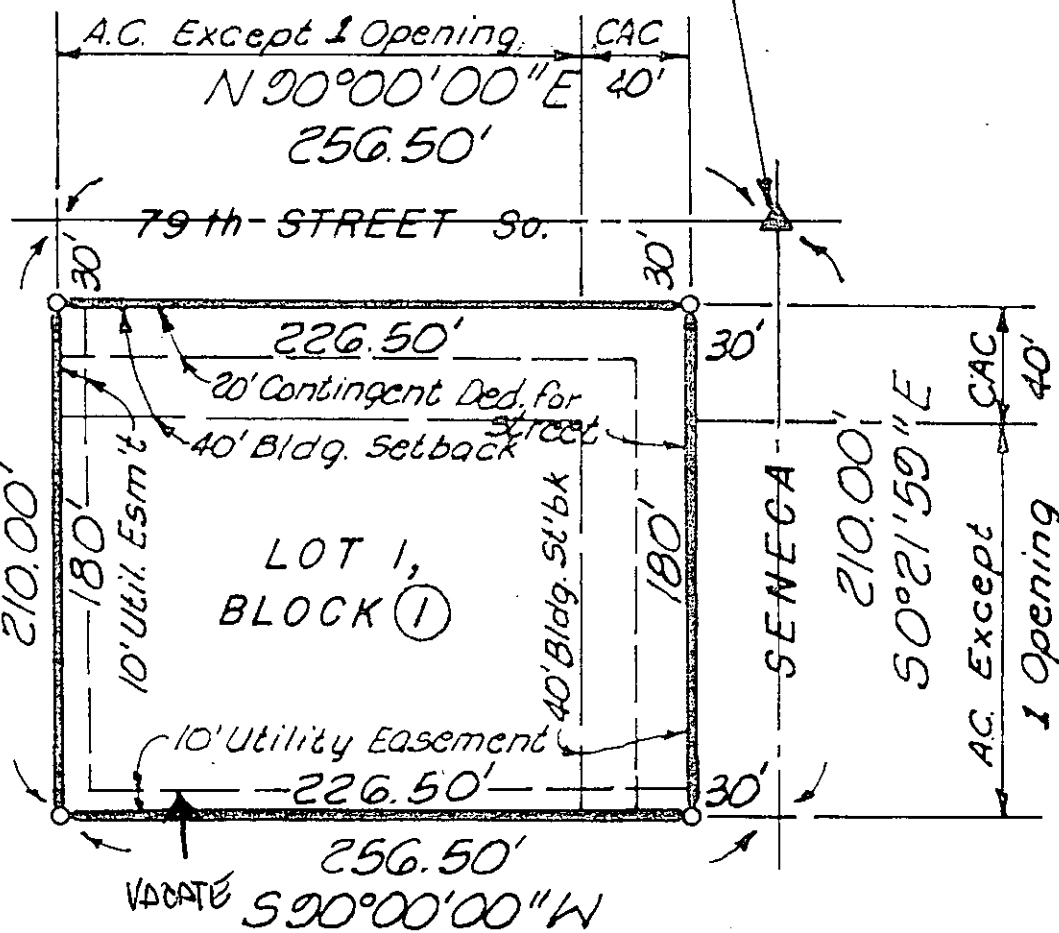

Scale: 1"=100'
November 24, '81
Bench Mark - R.R. Spike
in P.P. 45' SE of NE
Cor. Sec. 7, T29S, R1E.
Elev. 1257.34

UPC 2010-10