

PROPERTY LINE


NORTH

6'-6" WOOD
WEST FENCE

30' SETBACK

2'-3"

GATE

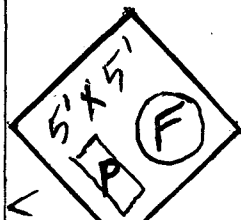

13'-1"

10'-0"

1'-0"

15'-0"

HOUSE

7'-6"


POOL

6'-6" WOOD
SOUTH FENCE

26th STREET

N
26th
A

CLARENCE STREET

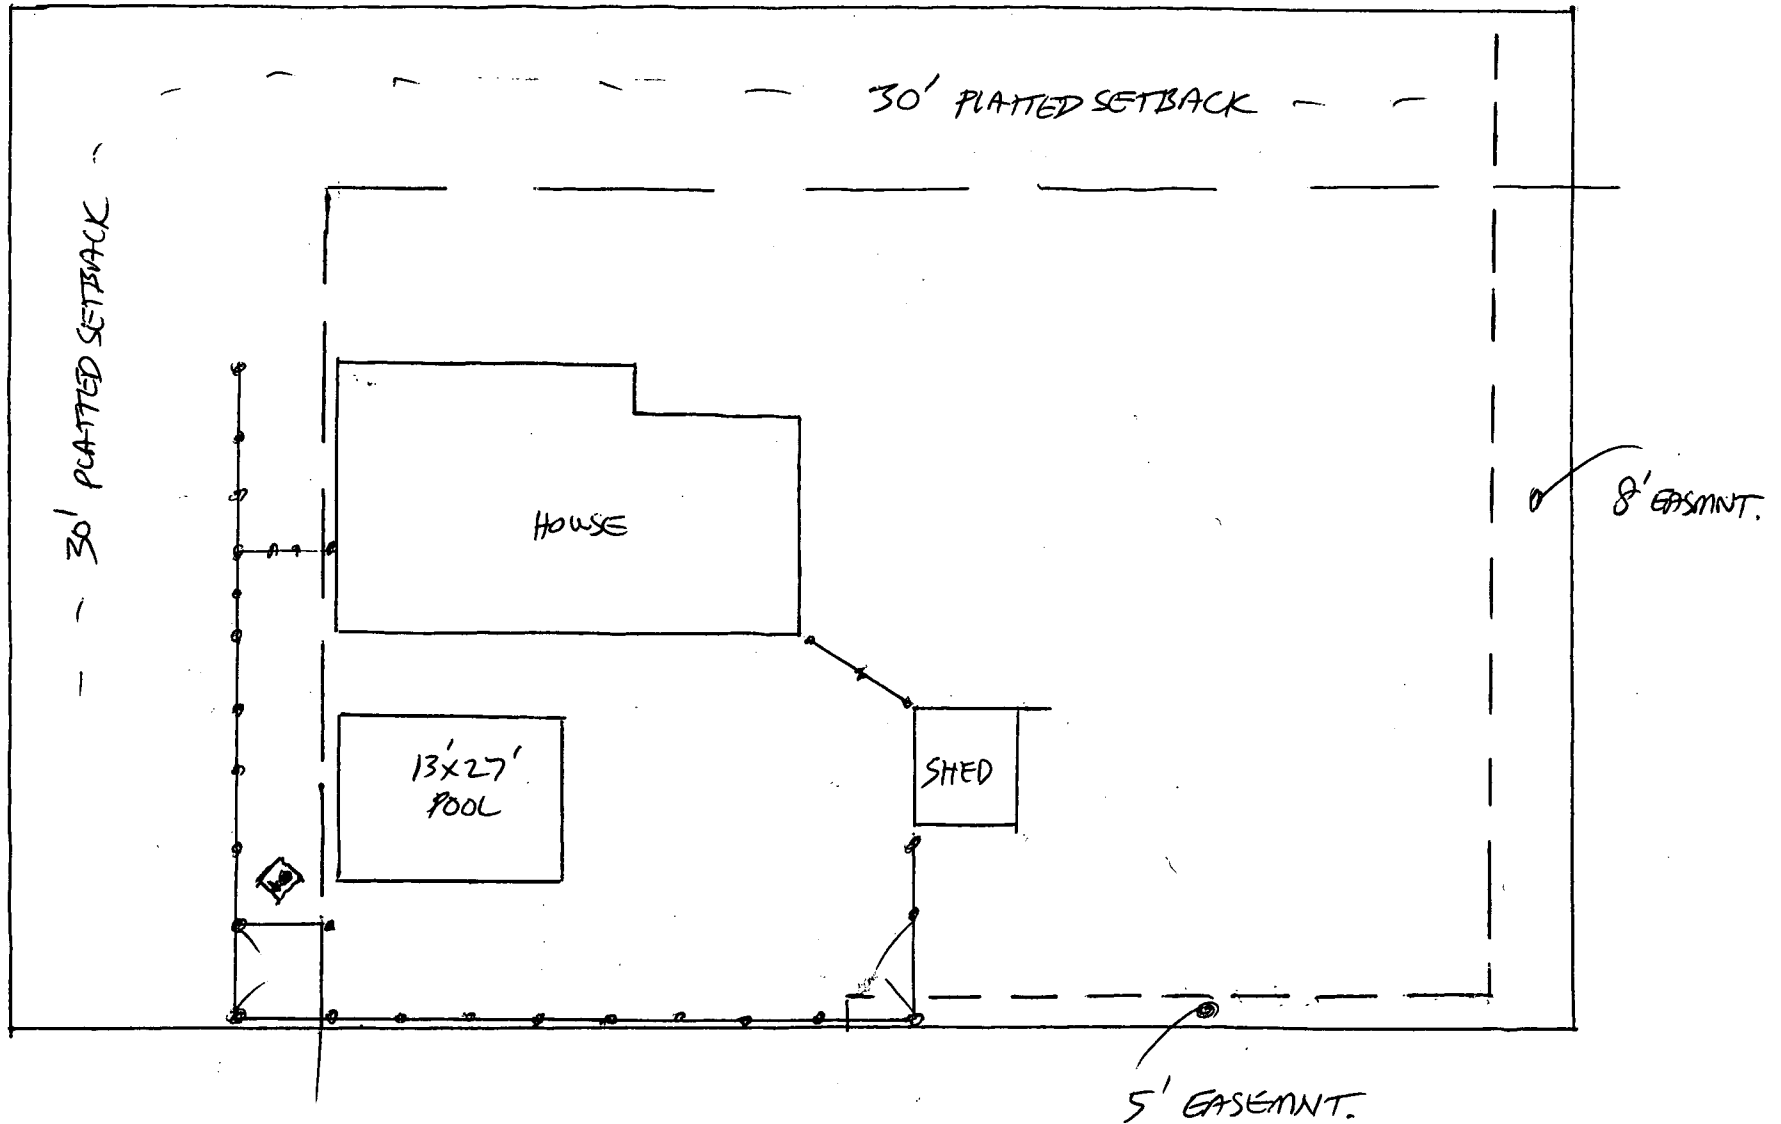



BUD 2012
-01600
30' PLOTTED
30' RPT
SETBACK

CARENO

PLOTTED
30' RPT
SETBACK

26th ST

218.75'

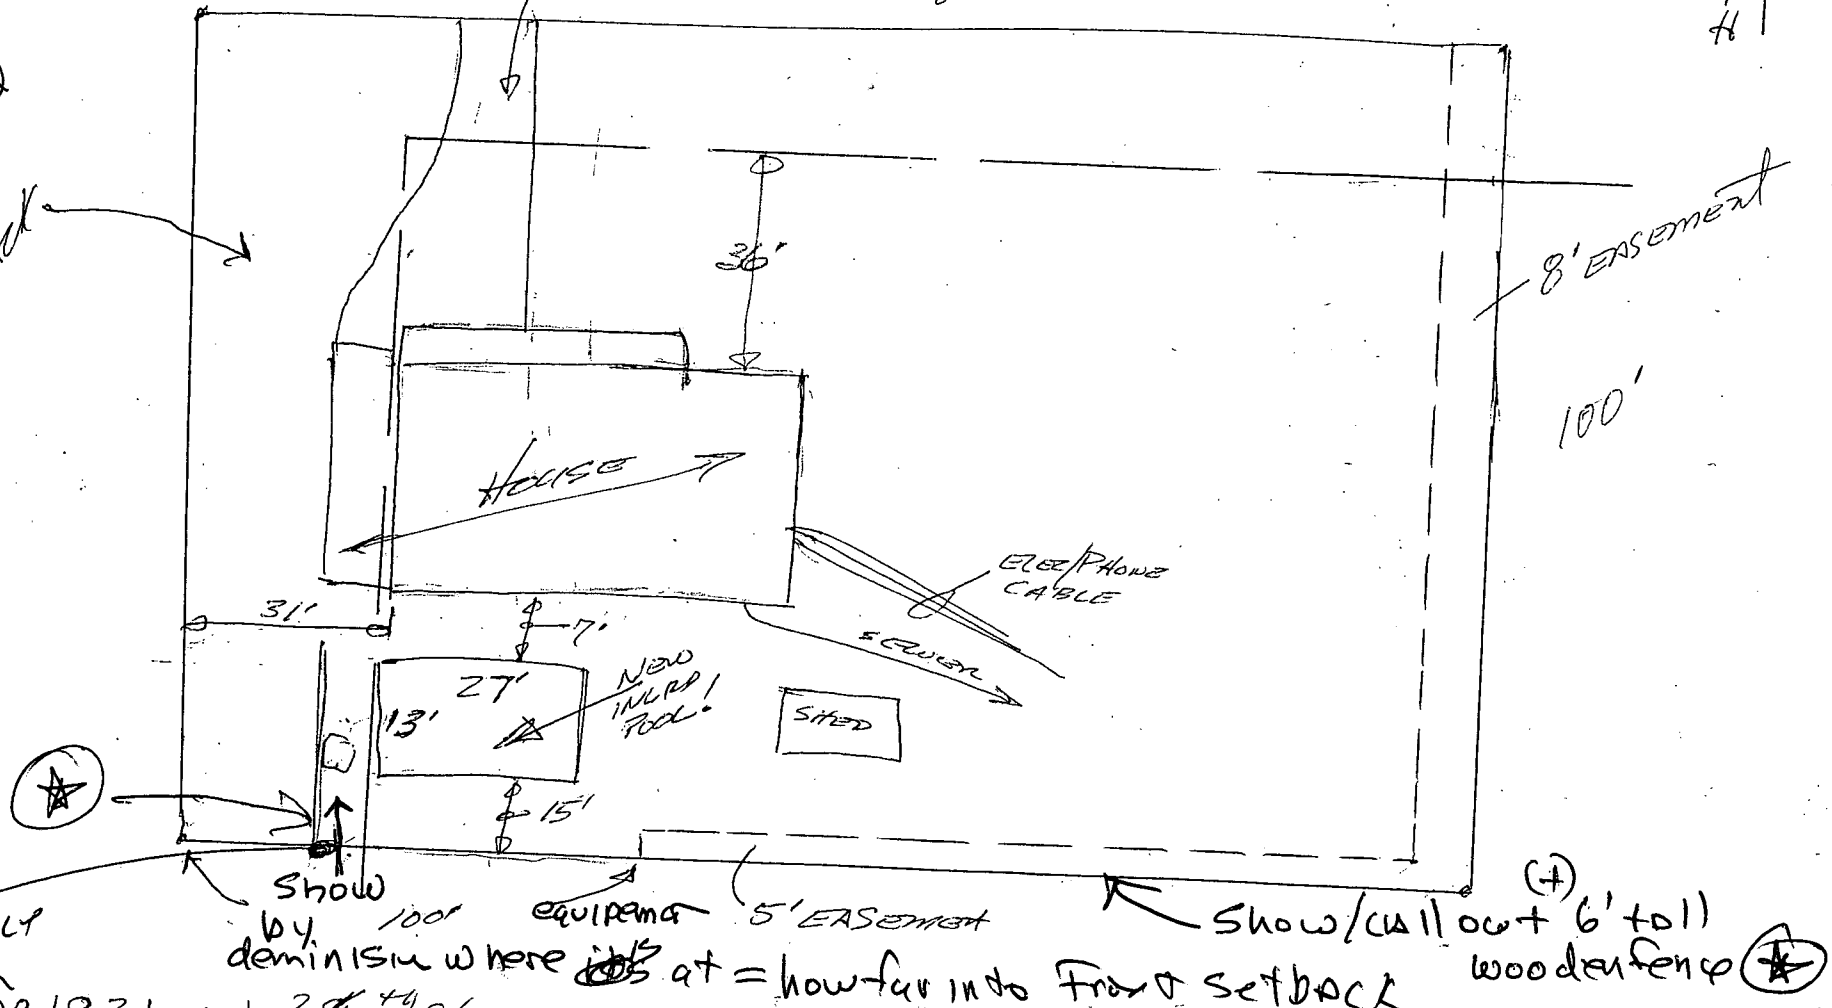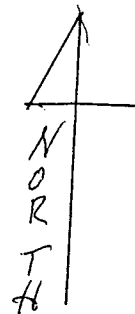

15th's
where
wood fence
located on
south side
ends?
if so, 50
50

Lot 7 Block 3

NORTHWEST GARDENS ADDN

13 JUNE 2012