


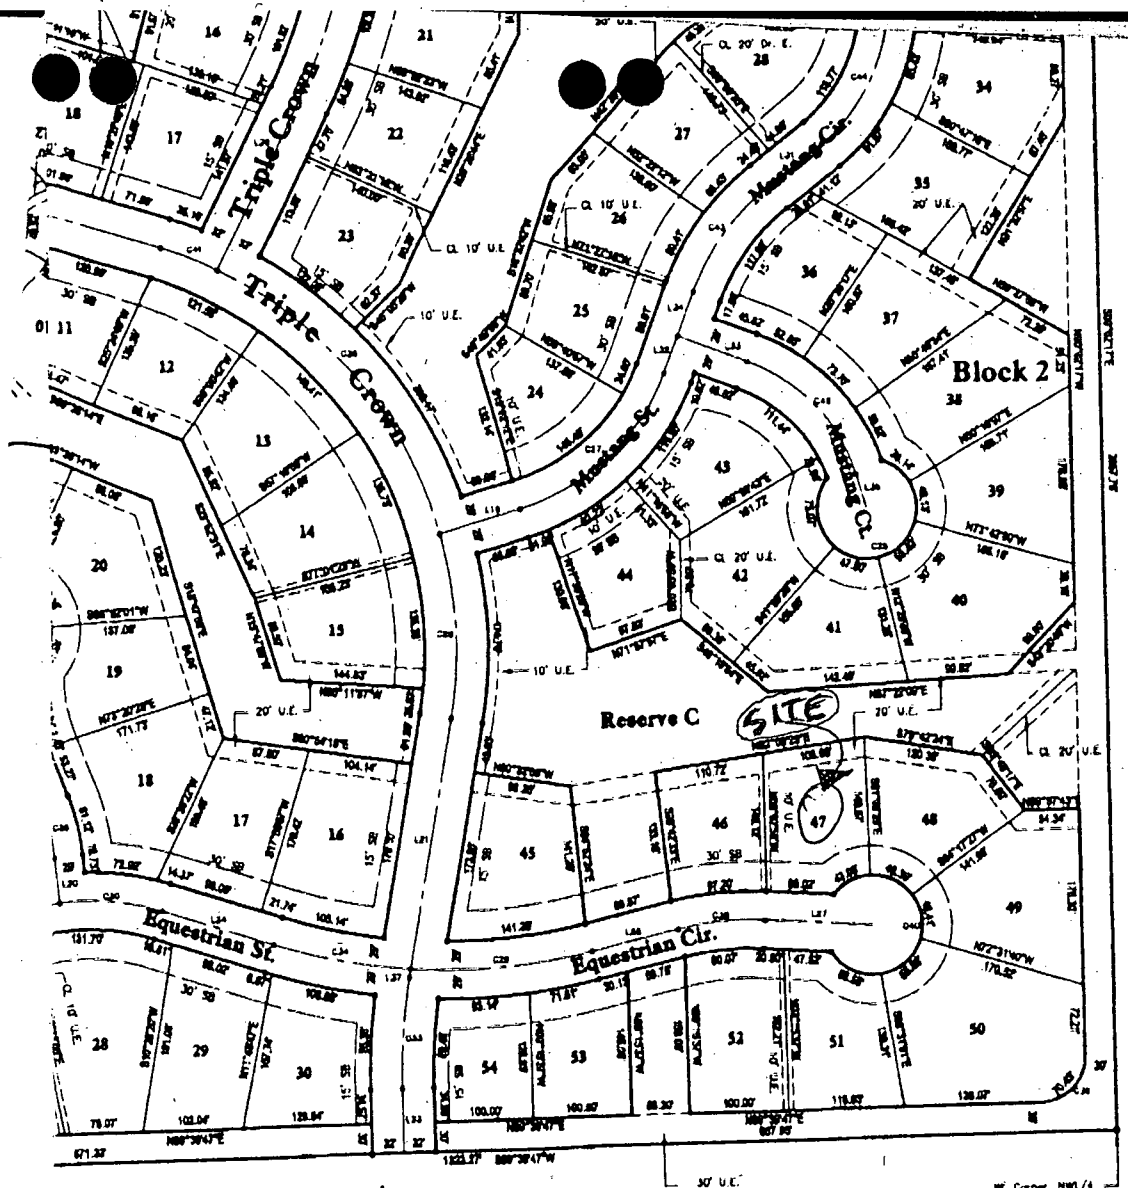

NE Corner, NW 1/4
Section 36-27-2E
Found 1 1/4" Galv. Pipe



8/25/01

roads
feature

System
of Di
Reg
in

County, Kansas

VAC2013-12

MINIMUM BUILDING ELEVATIONS		
Minimum Low Opening Elevation		
Location	NWFO Datum	City Datum
Lots 1-4, Bldg 1	1918.0	198.8
Lots 5-10, Bldg 1	1927.3	198.8
Lots 11-20, Bldg 2	1939.4	198.8
Lots 21-30, Bldg 2	1938.0	197.3
Lots 31-40, Bldg 3	1938.0	197.3
Lots 41-50, Bldg 3	1938.0	197.3