


N.E. 1/4 SEC. 33, TWP. 27, R. 1 E.

WI
129

CASE No. 77C1491

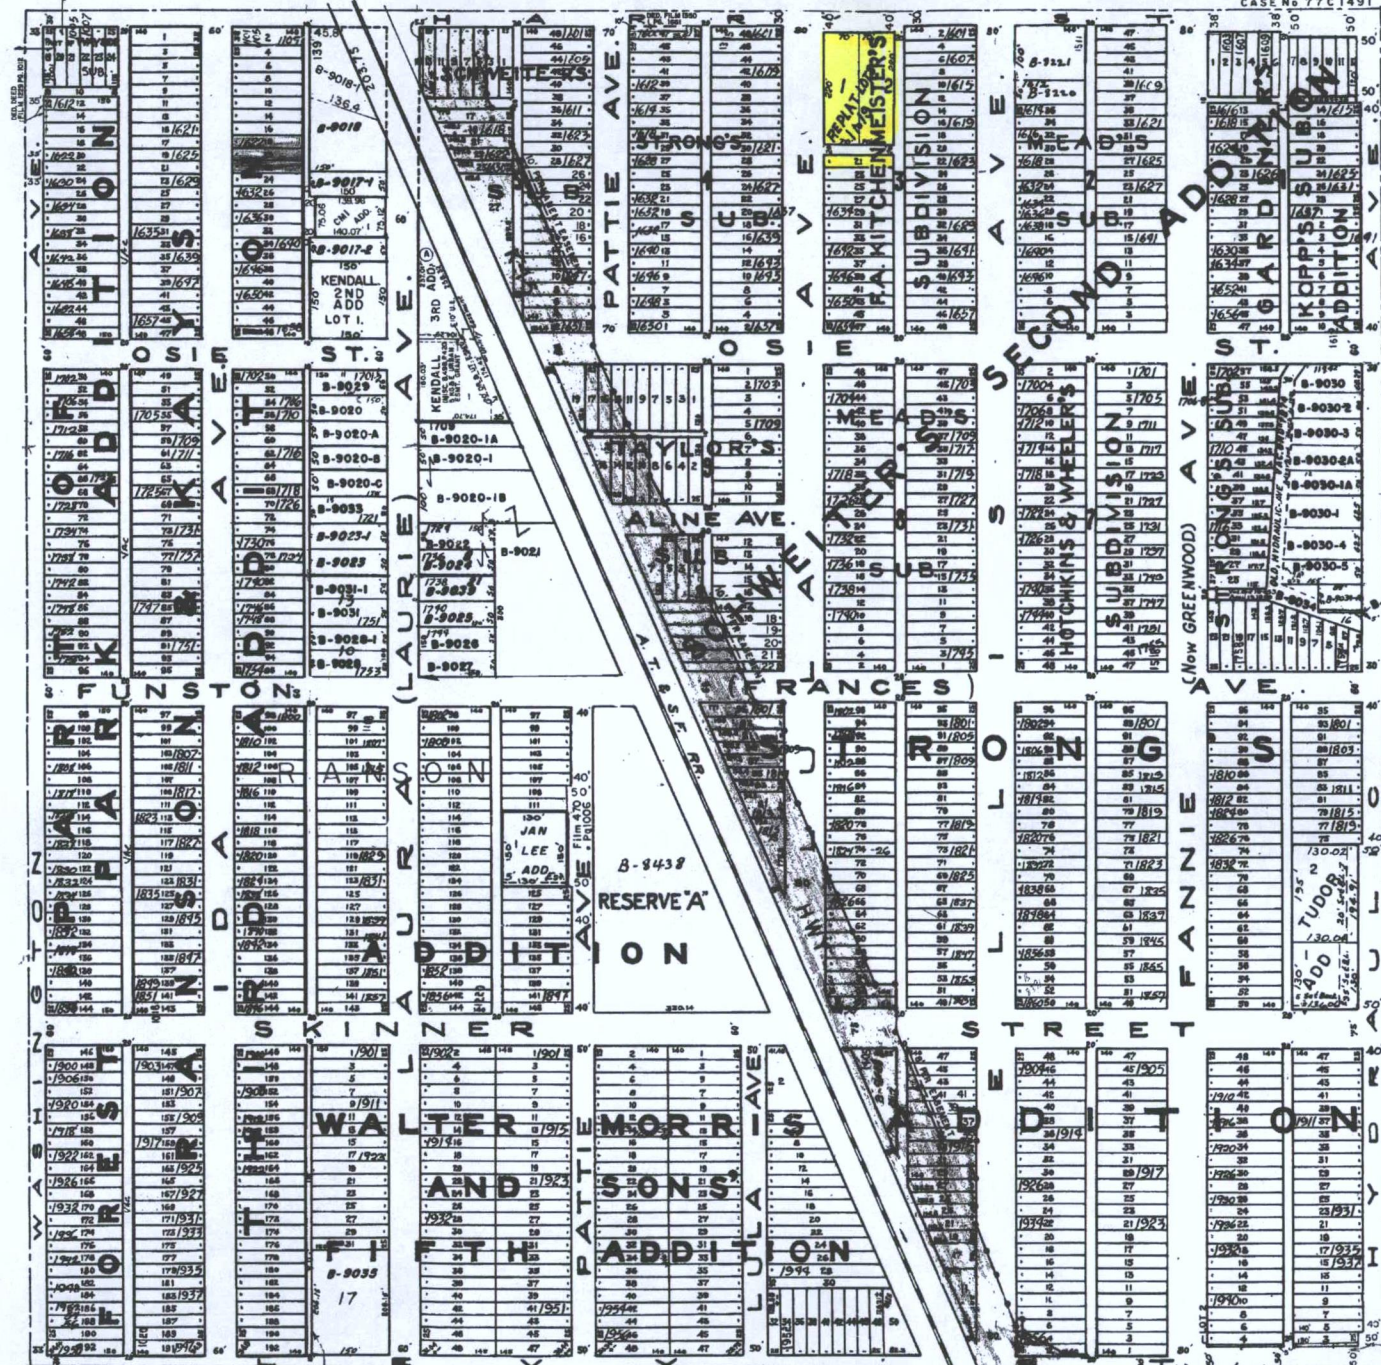

NOTE:
OLD HYDRAULIC Vac 12-3-1975
East of Lot 45 S 46 Film 223 Pg 135

DEDICATION 12-12-72 BK 41 PG 106

THIS SHEET PREPARED UNDER SUPERVISION OF
JAMES ALFORD SEDGWICK COUNTY CLERK