


6.	16°30'00" Lt.	06°59'41"	819.14'	118.77'	235.90'
7.	120°53'35" Lt.	44°04'11"	130.00'	229.27'	274.30'
8.	00°57'36" Lt.	00°28'11"	11,936.34'	100.0'	200.00'
9.	02°56'16" Rt.	00°44'05"	7,799.53'	200.0'	399.91'
10.	04°33'24" Lt.	03°15'23"	1,759.44'	70.0'	139.93'
11.	10°08'23" Rt.	04°37'16"	1,239.89'	110.0'	219.42'
12.	07°33'39" Lt.	05°24'30"	1,059.38'	70.0'	139.80'

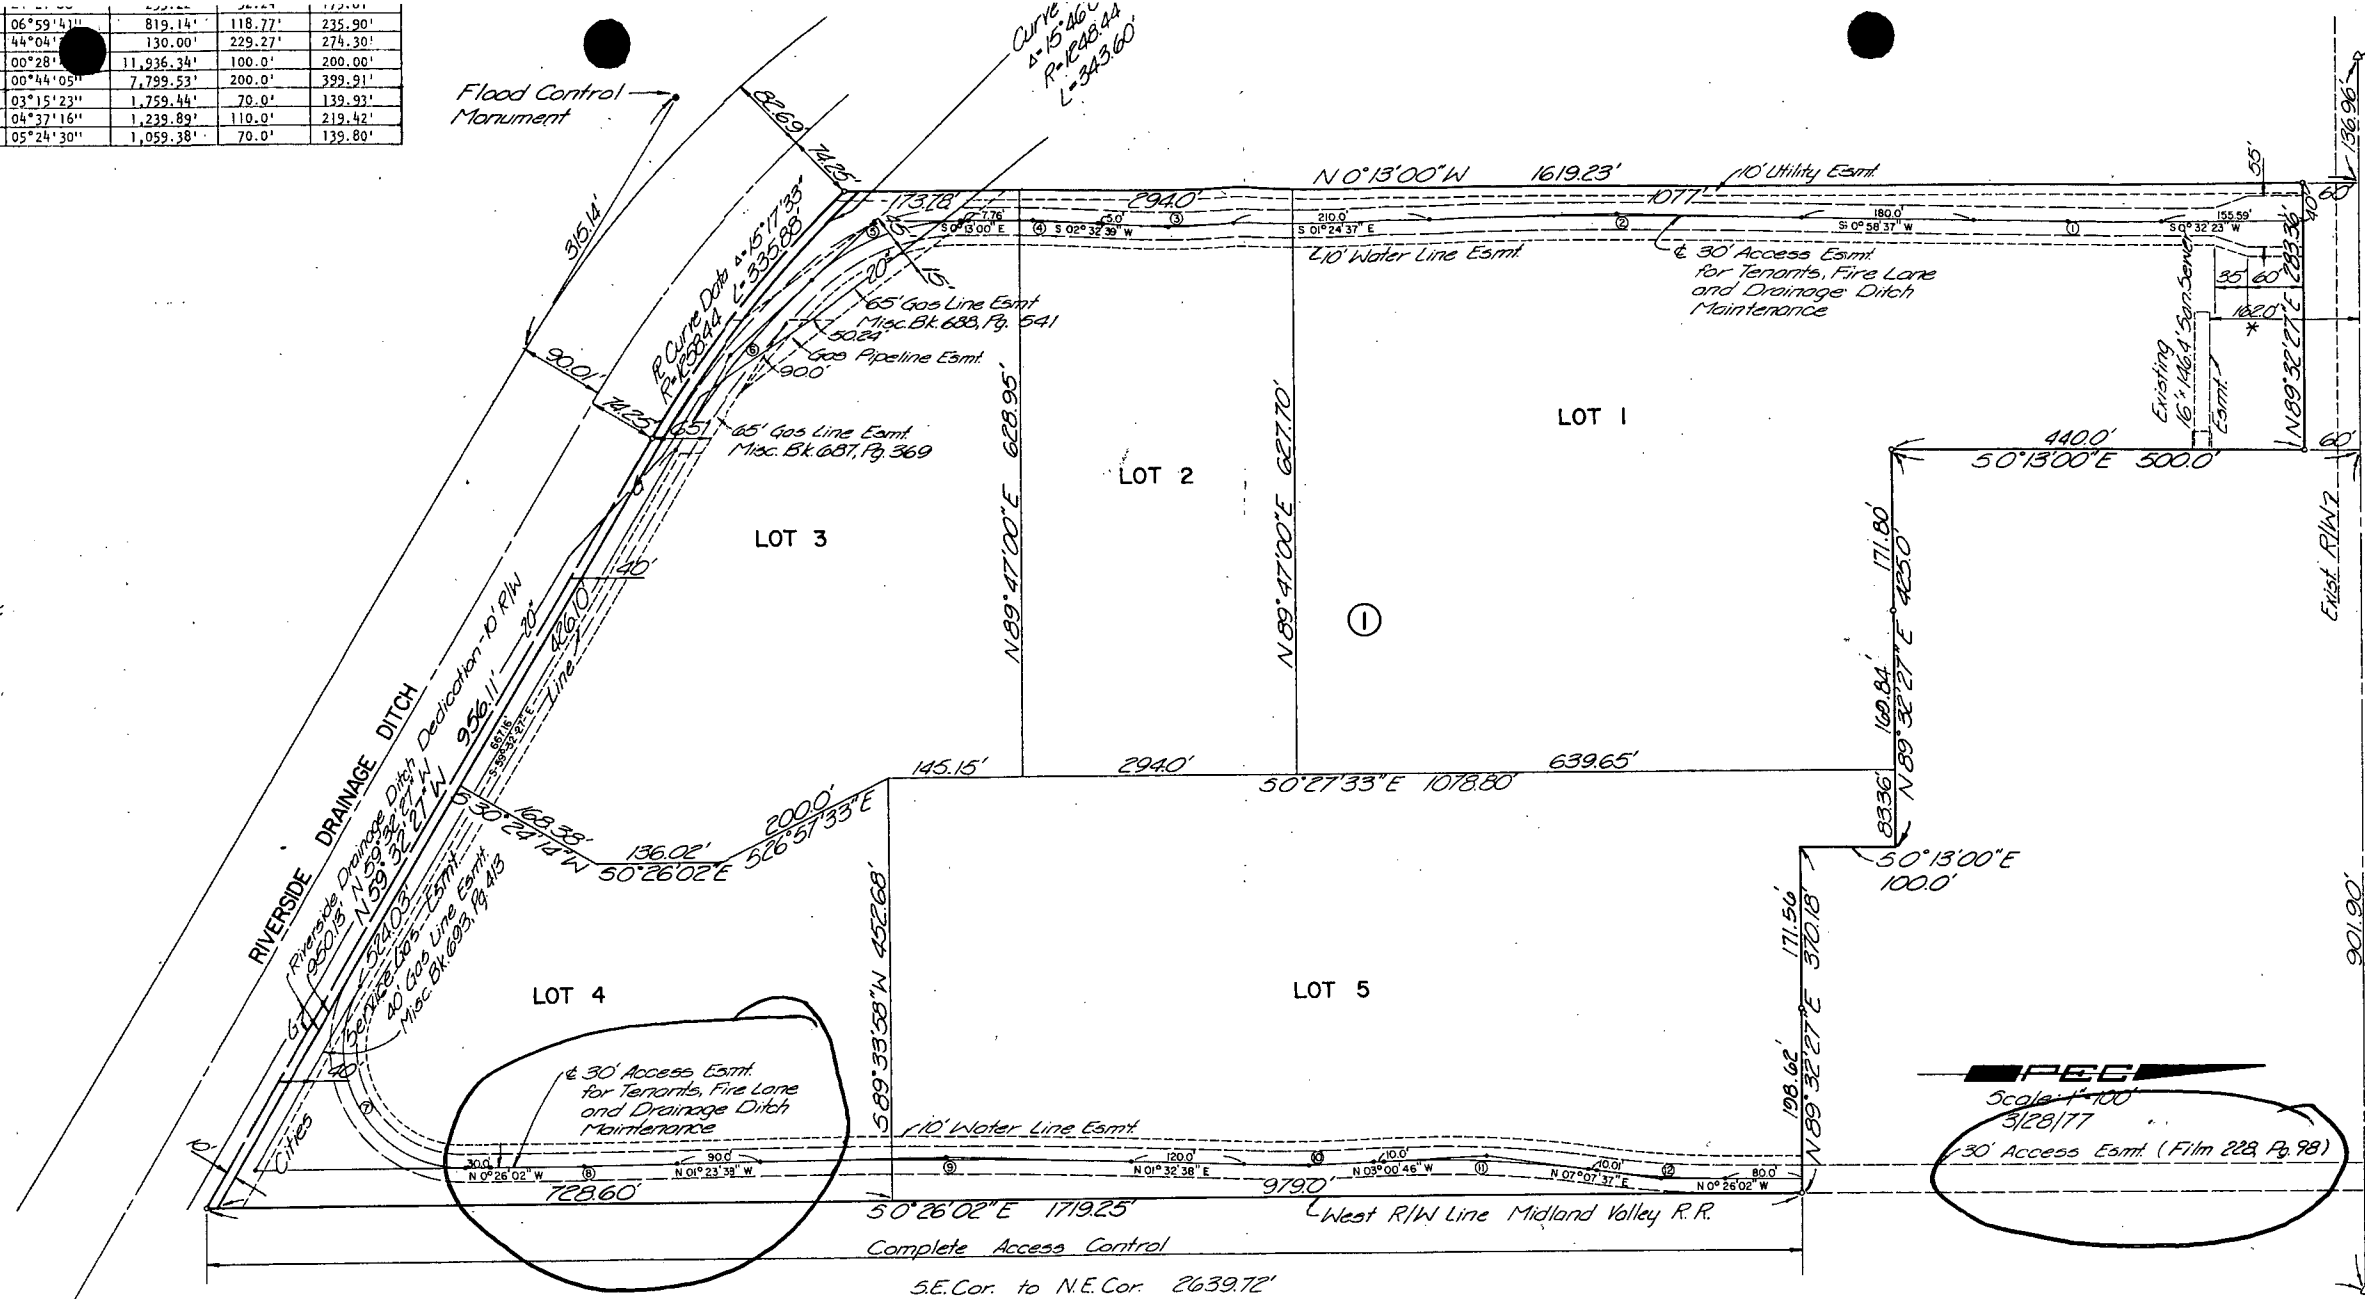

SE. Cor. N.W. 1/4, Sec. 17
T28S, R1E of the 6th P.M.

VAC2013-37

REFILE
415398

* this plat has been refiled this 28 day of Nov. 1978
to show correction in Lot 1, of distance from the
North line of San. Sewer Esmt. to the North line
of Sec. 17, T28S, R1E, to be 162 feet, as shown.

Bette F. Mc Cart Register of Deeds.
Bette F. Mc Cart
Pat Kettler Deputy
Pat Kettler



SHEET 1 OF 2

B2 8 19 H-1-6-16 A