


72'

SITE PLAN

APPROVED ~~10/28/20~~ BY *klmorga*

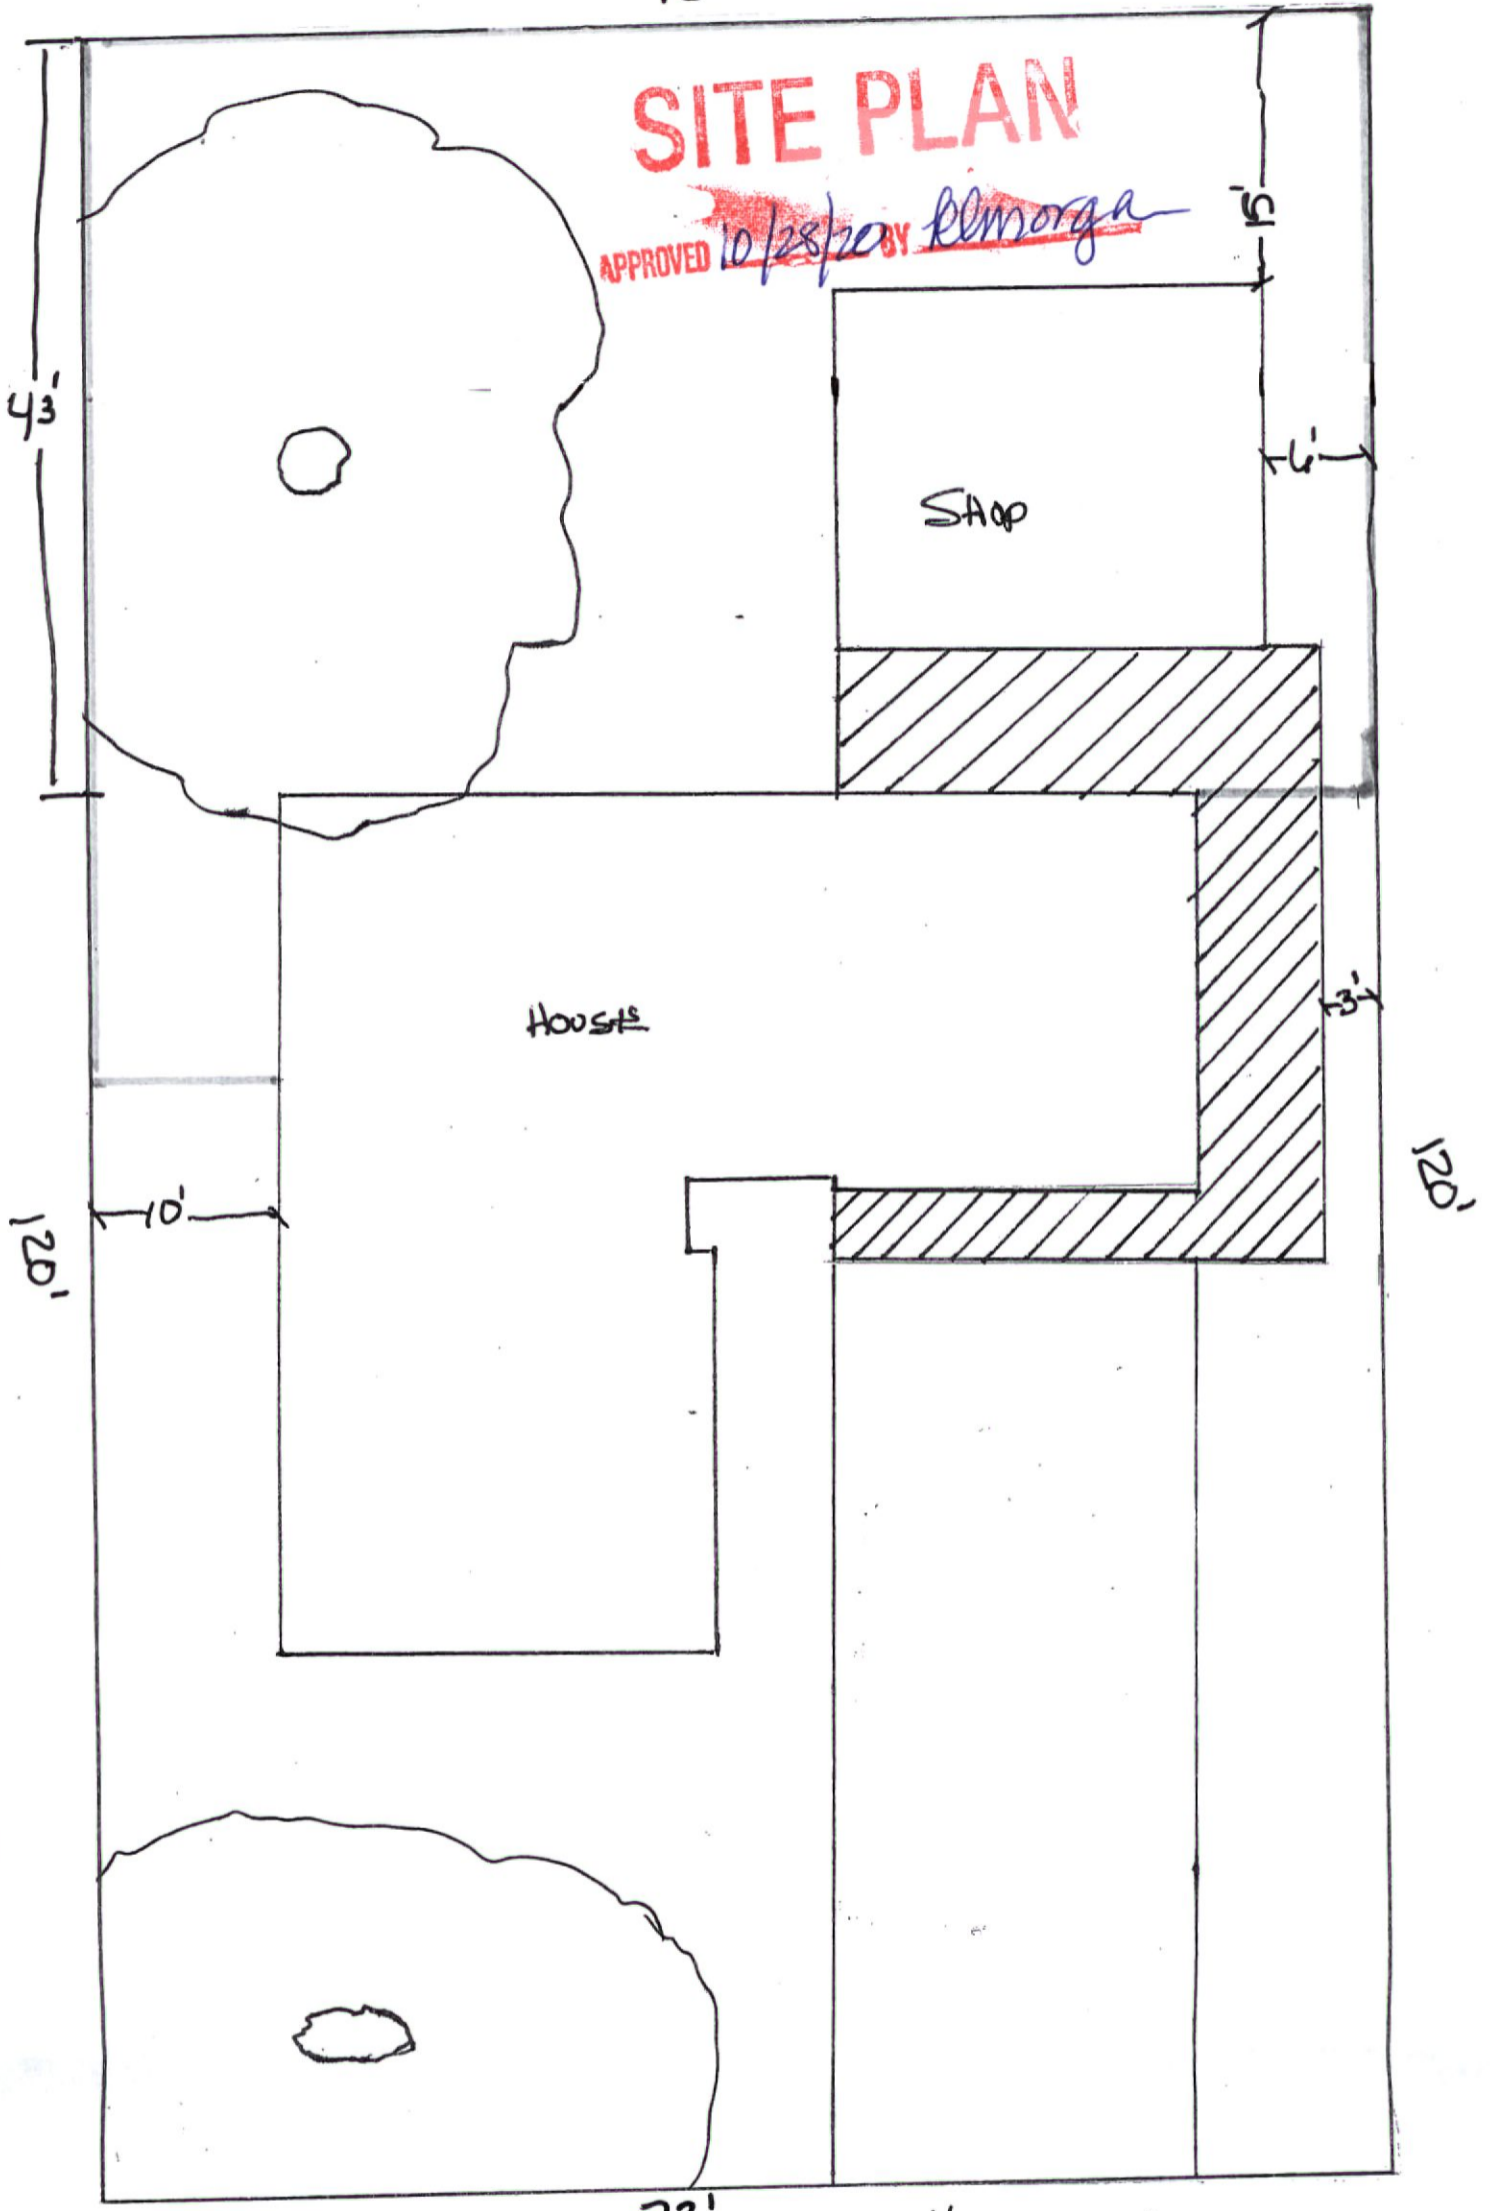

120'

120'

72'

NORTH →

SCALE $\frac{3}{32} = 1'$

— FENCE

▨▨▨▨ Proposed Addition

CONNECT Shop to House AND ENCROACH INTO SIDE YARD 3'

819 N WESTLINK