


The parking arrangement is approved
and as to geometrics as noted (for 27 spaces)
However 27 spaces are required; therefore
this parking layout does not have final
approval of the Traffic Eng. Div.


R. E. Taylor
Asst. Traffic Eng.
3/20/73

LINCOLN

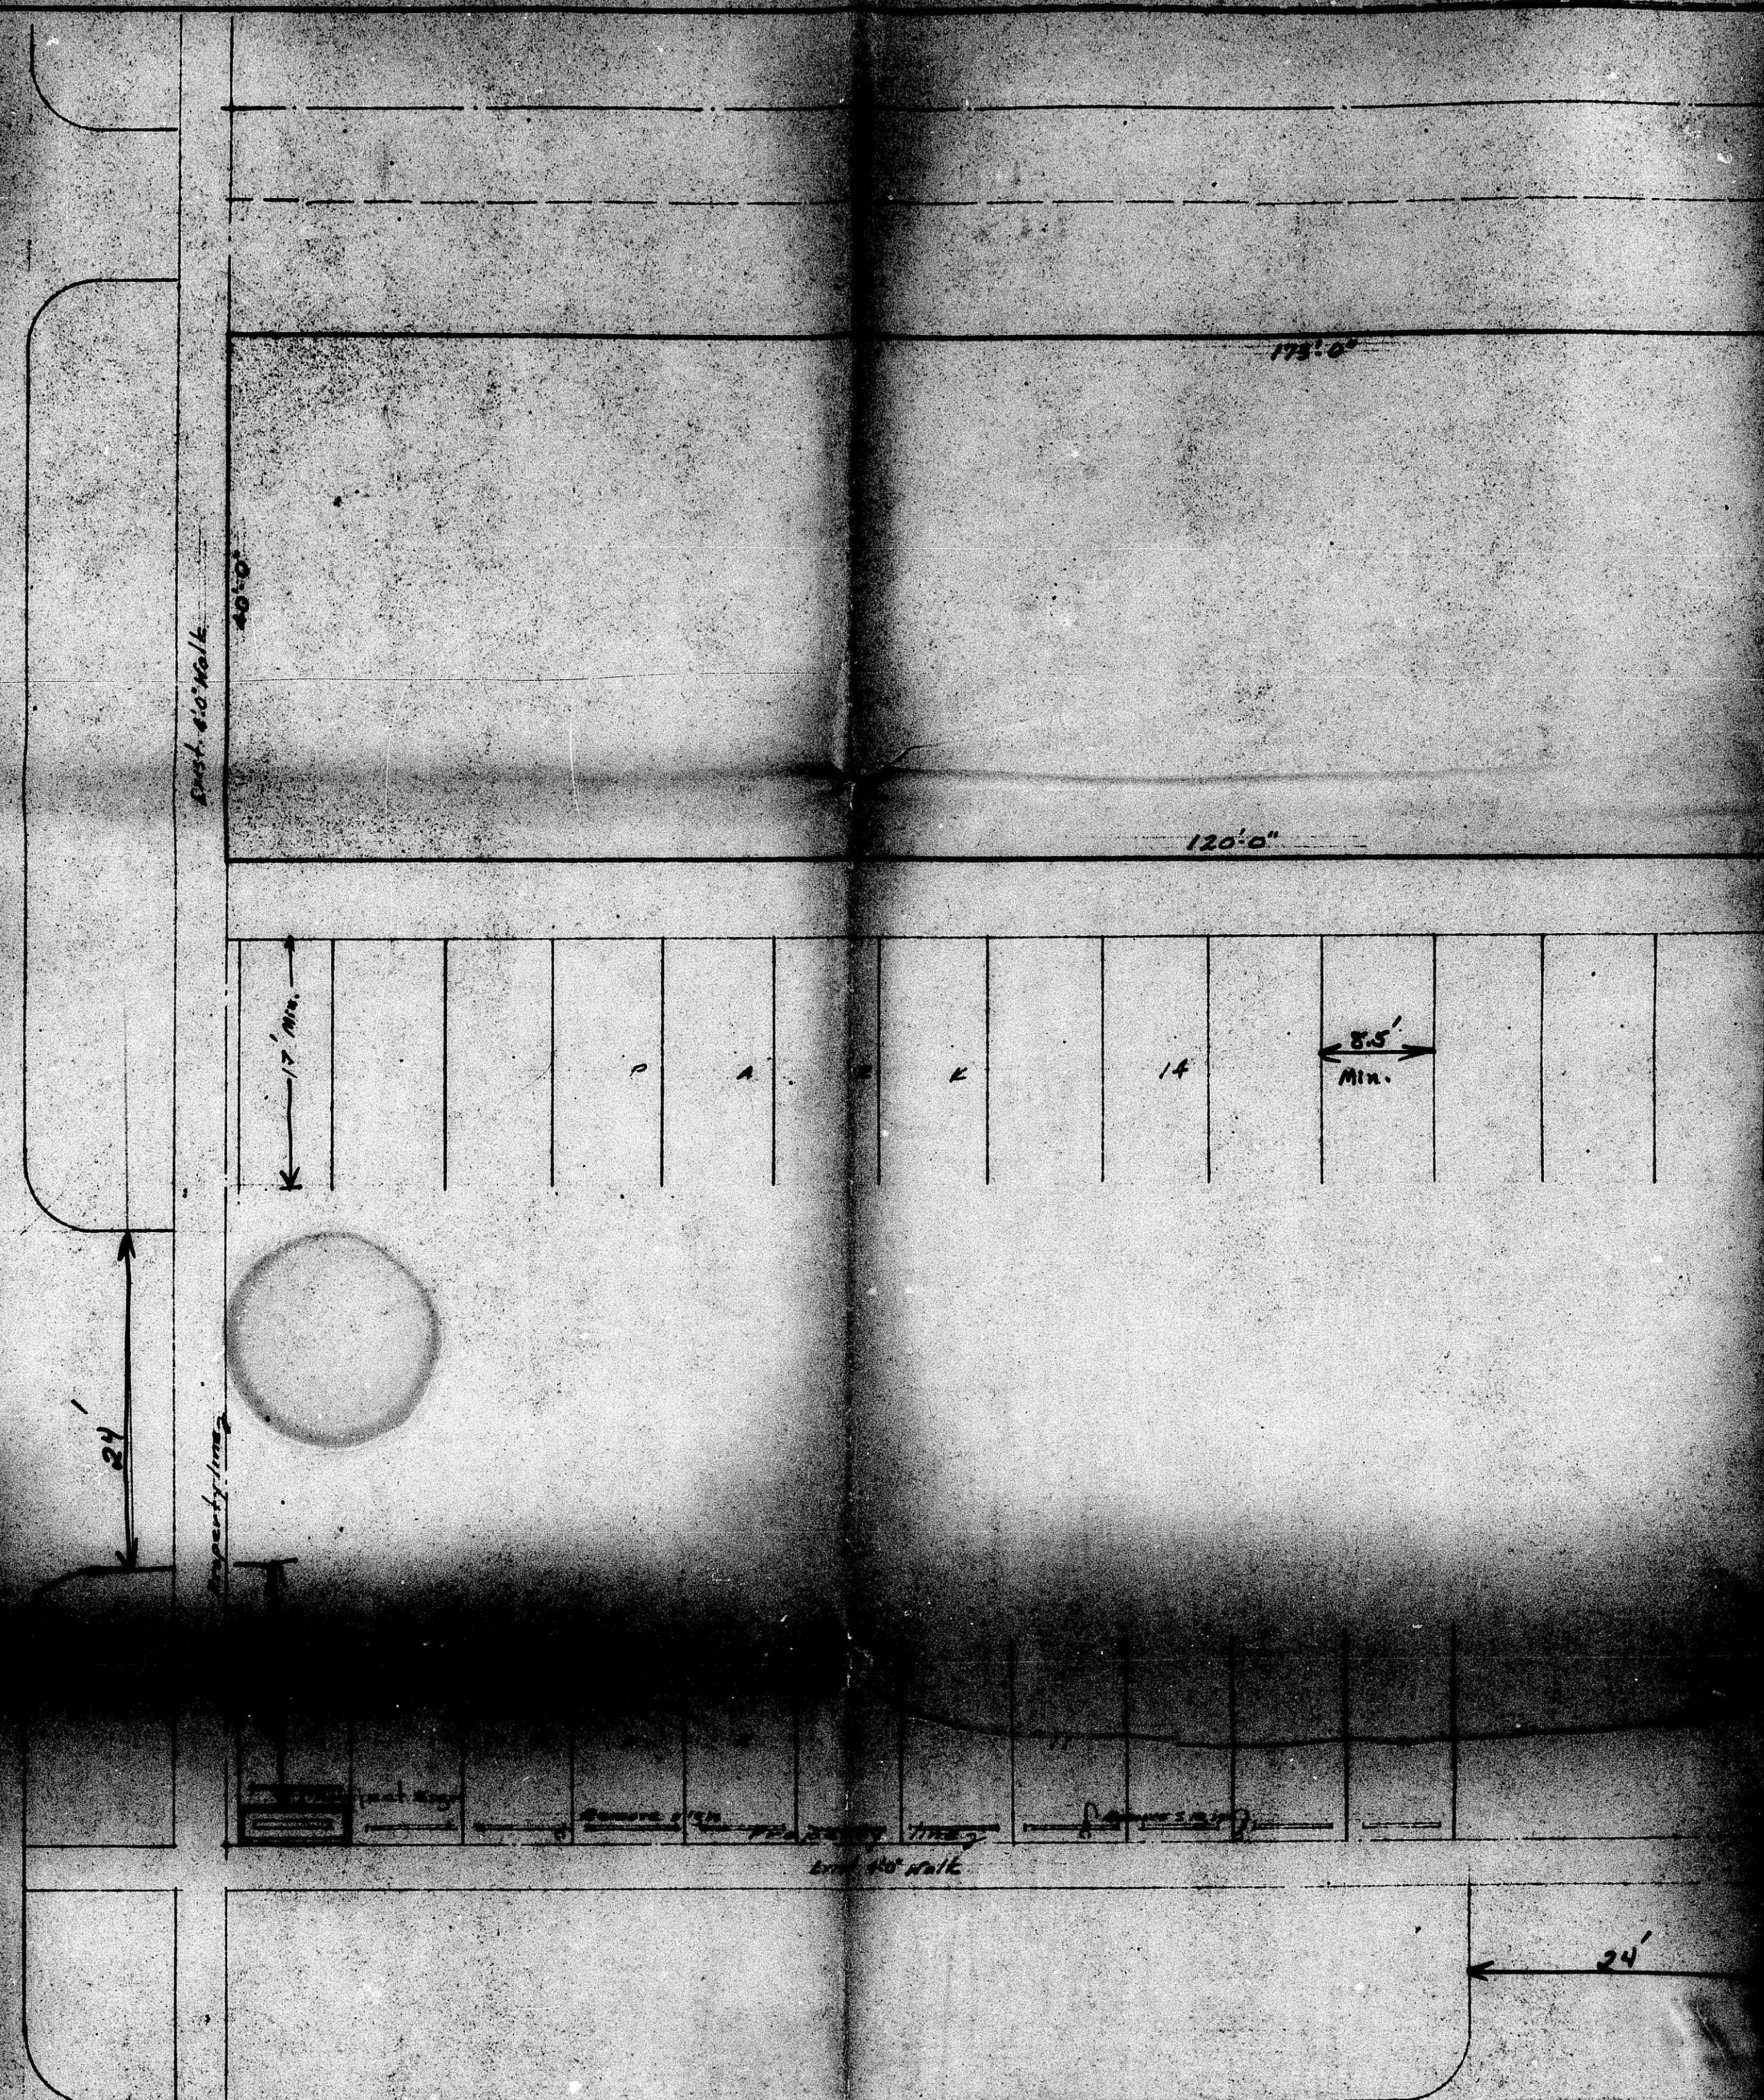

OLIVER



SITE PLAN 1/8" = 1'-0"

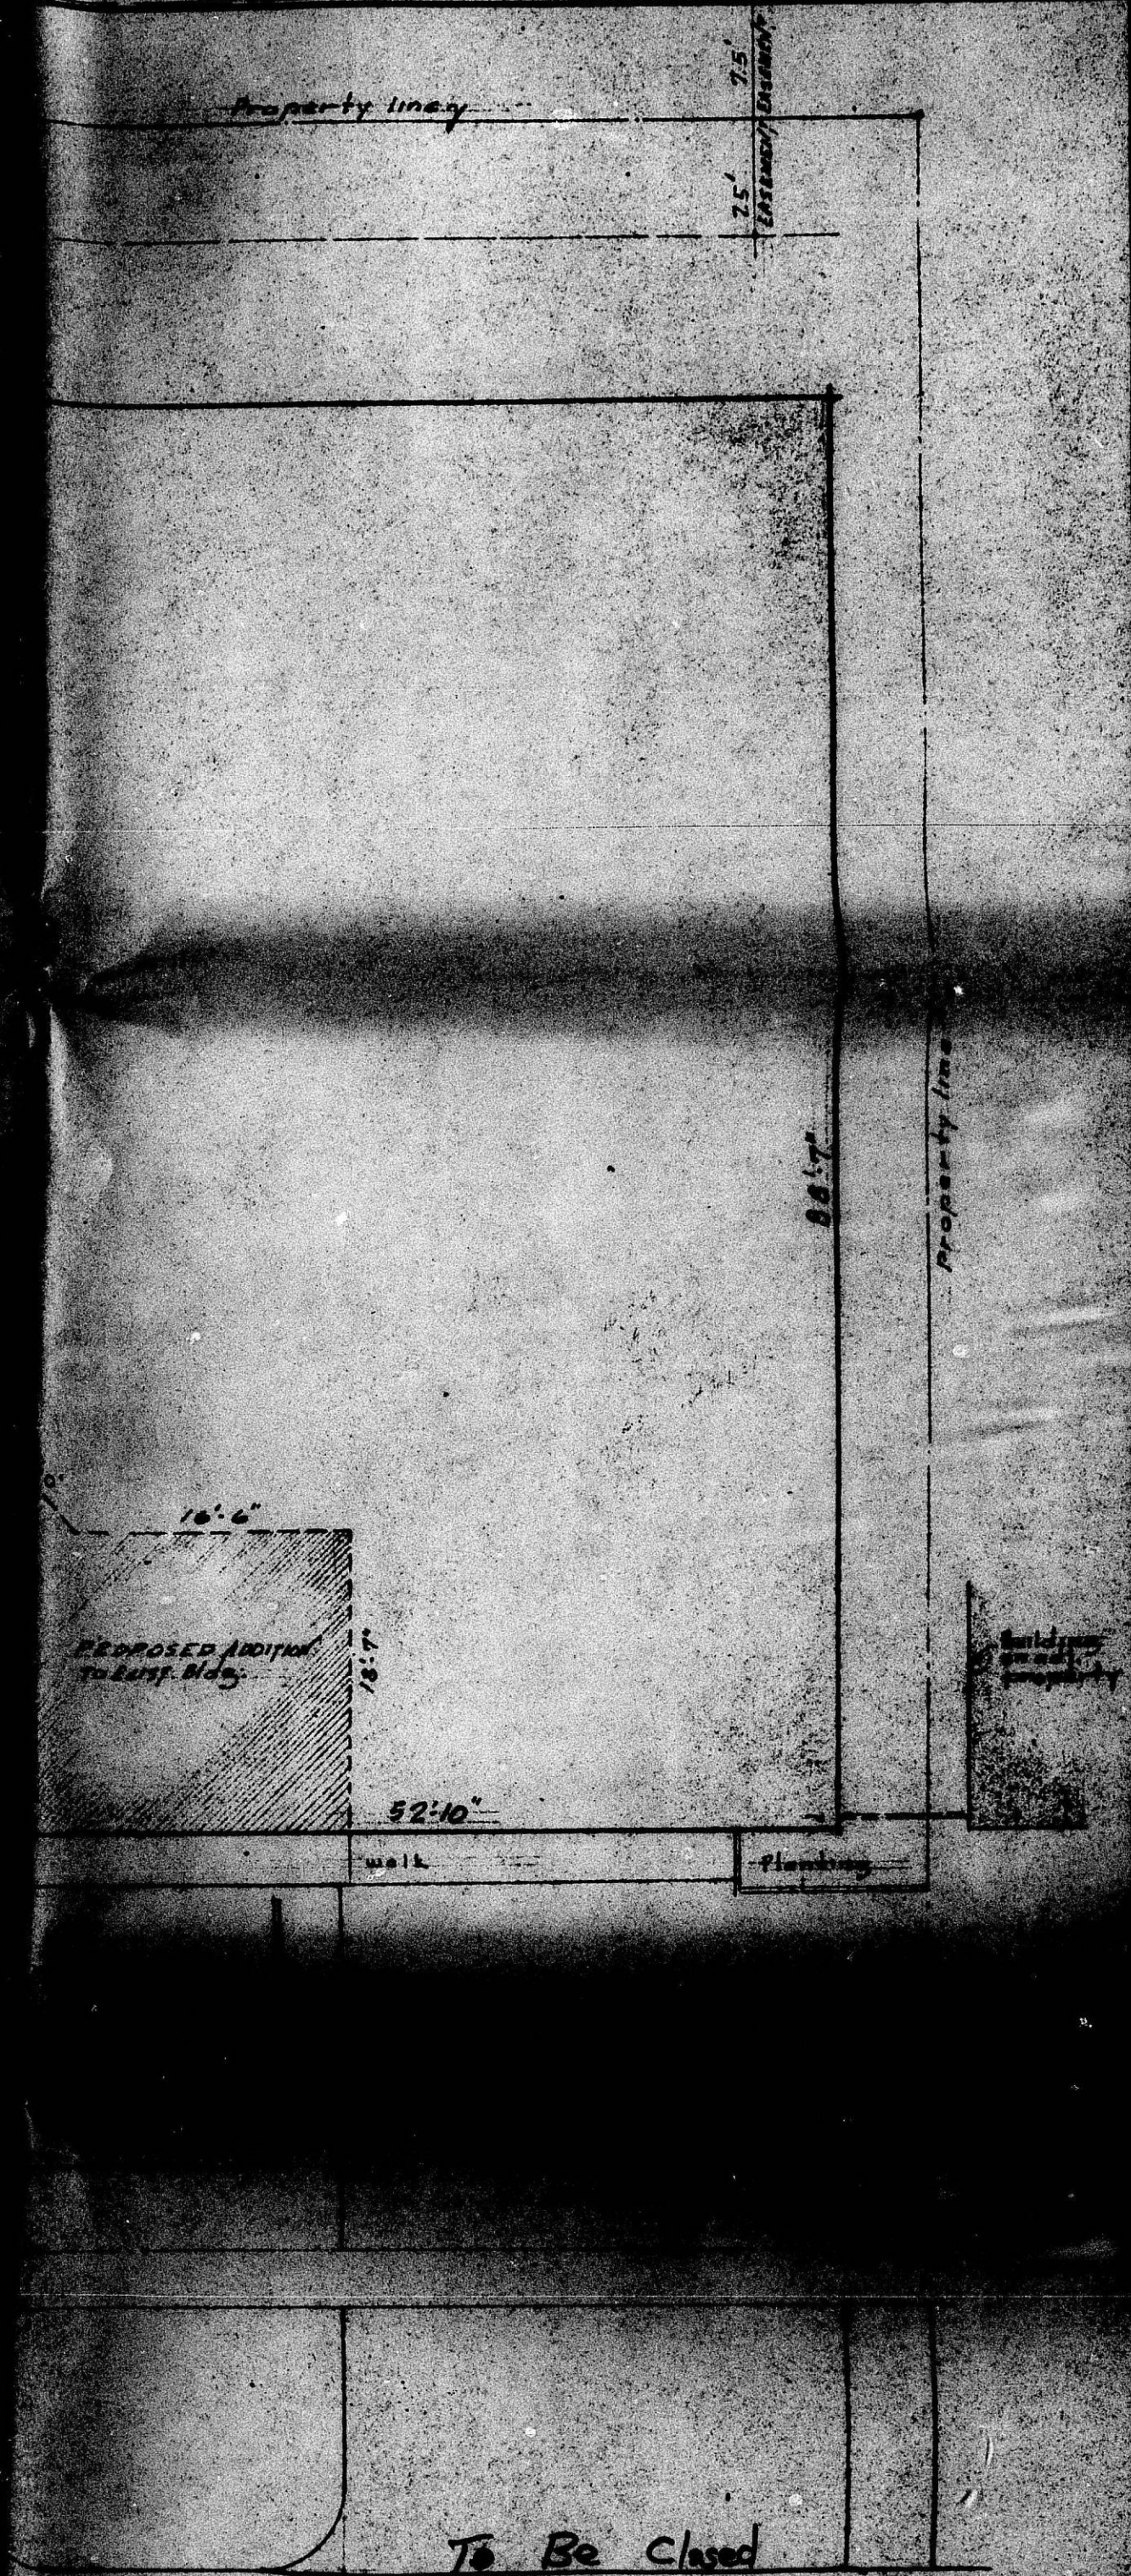


To Be Closed

BUILDING RENOVATION FOR LINCOLN OLIVER	
LINCOLN OLIVER - NICHOLS, RAYSON	
DATE: 5-7-73	DESIGNED BY: T. R. R. T. R. T.
3408 D. L. SIMMONS, NICHOLS, RAYSON	1-2


BZA 10-73

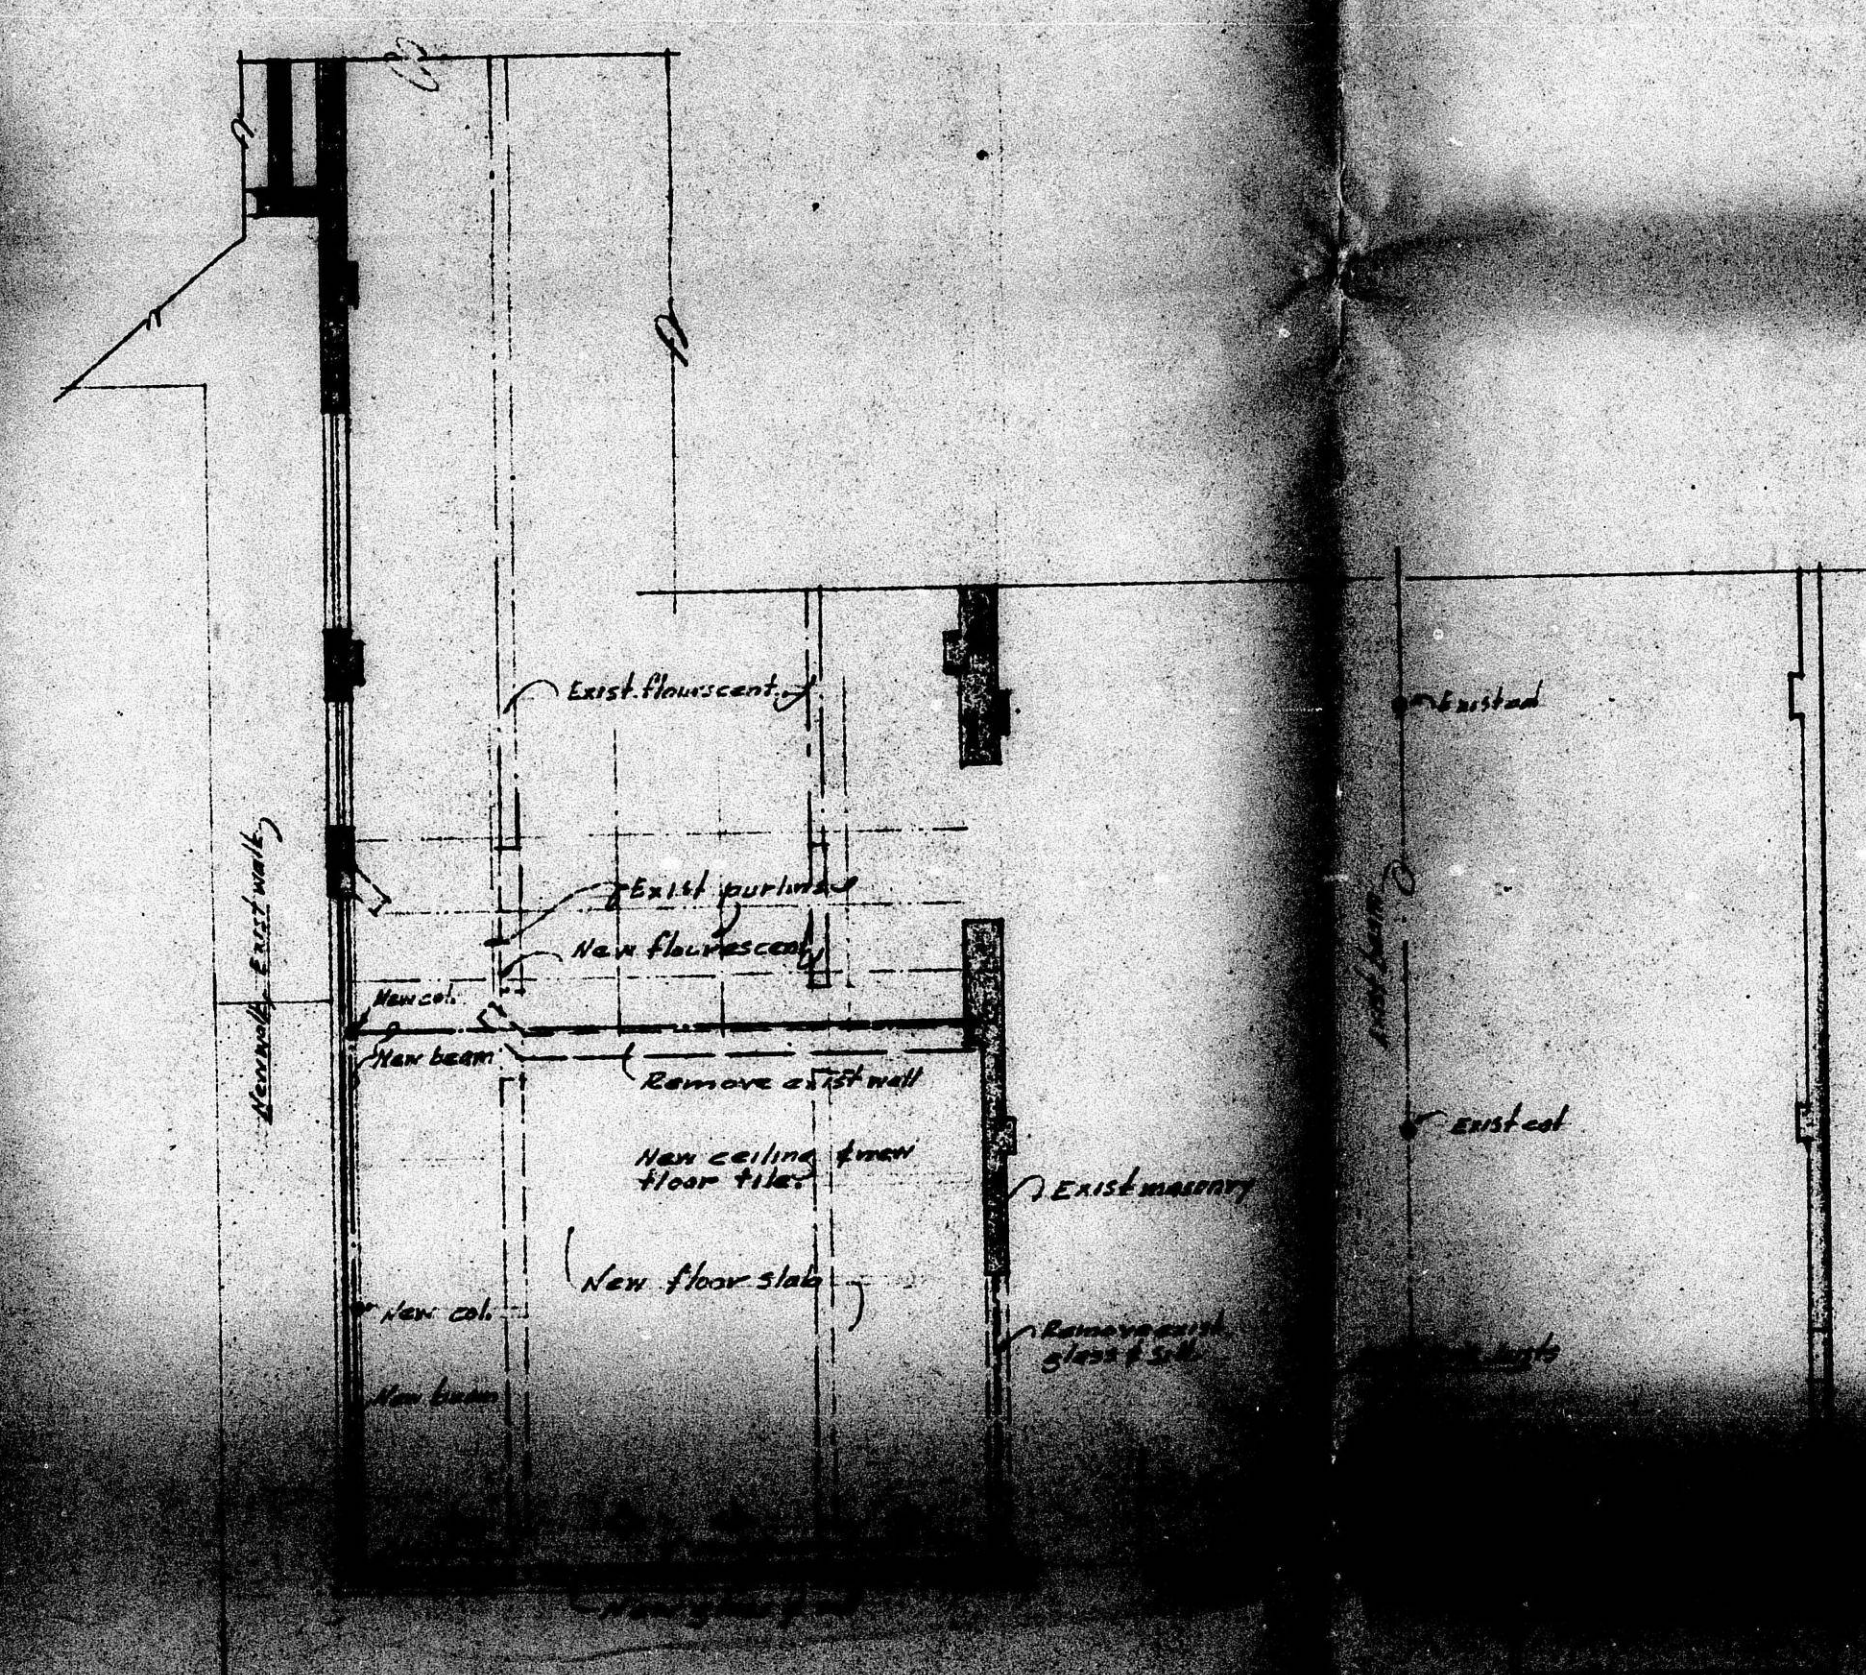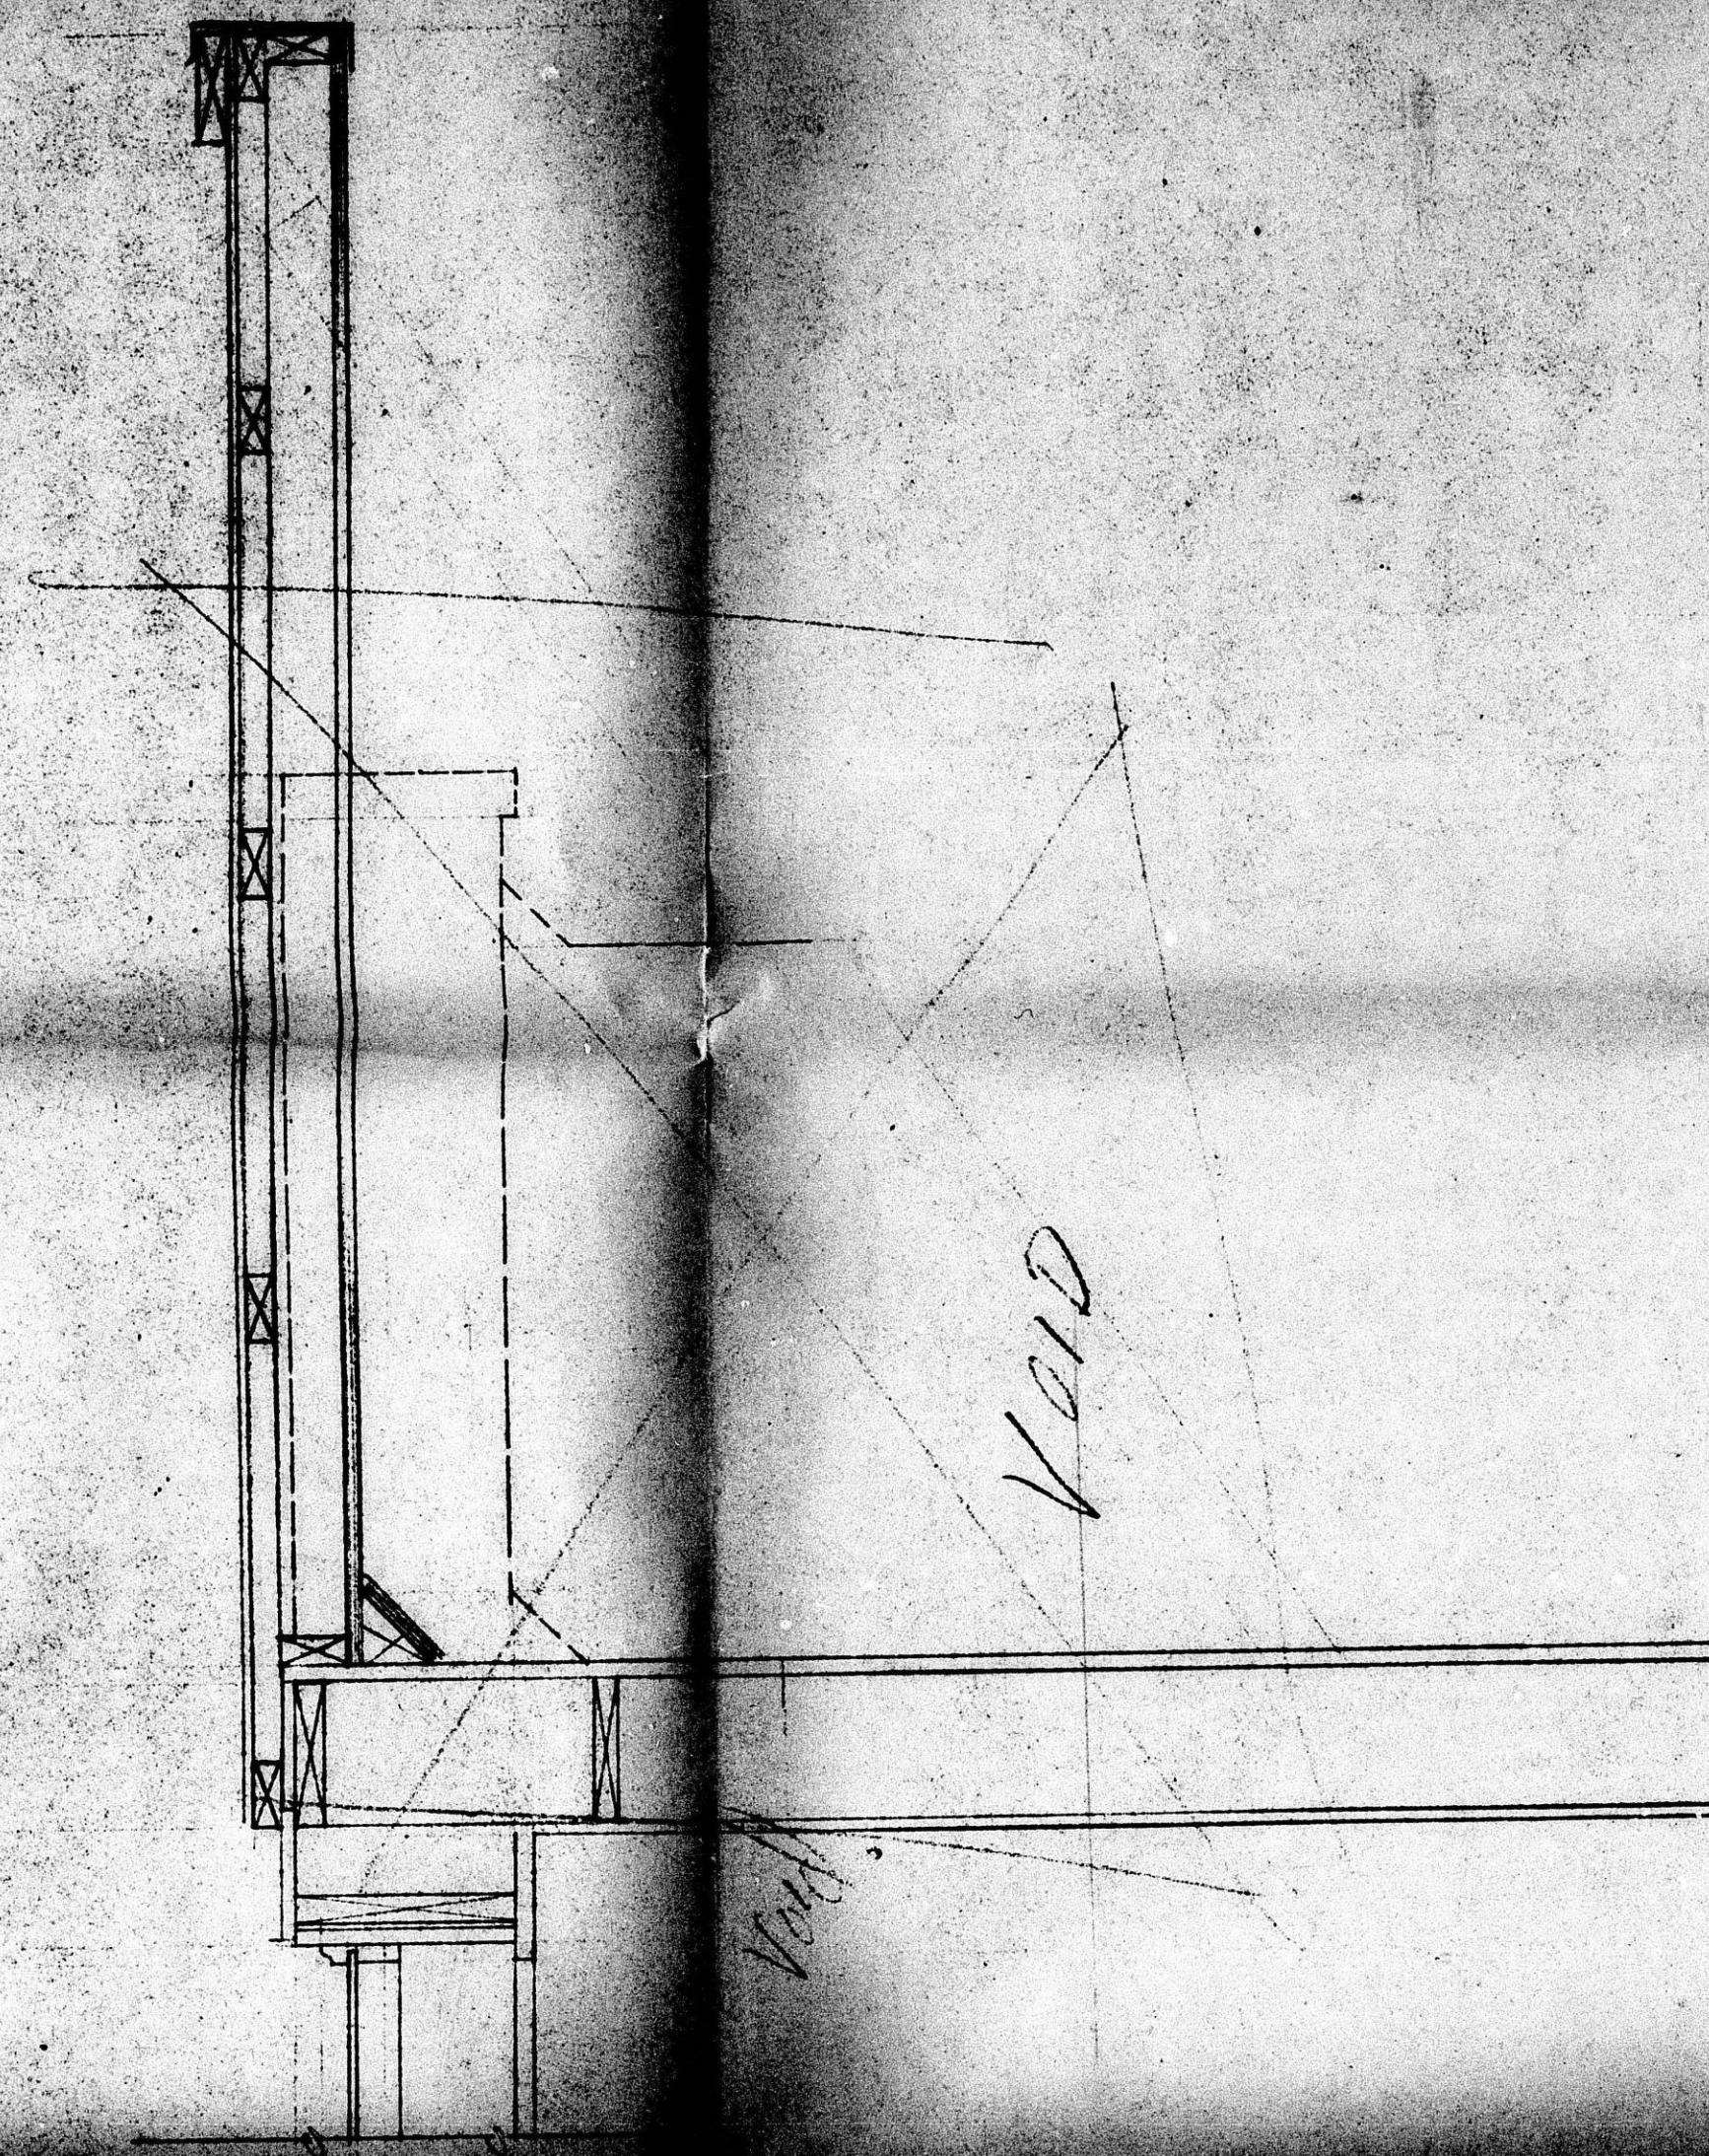

FLOOR PLAN

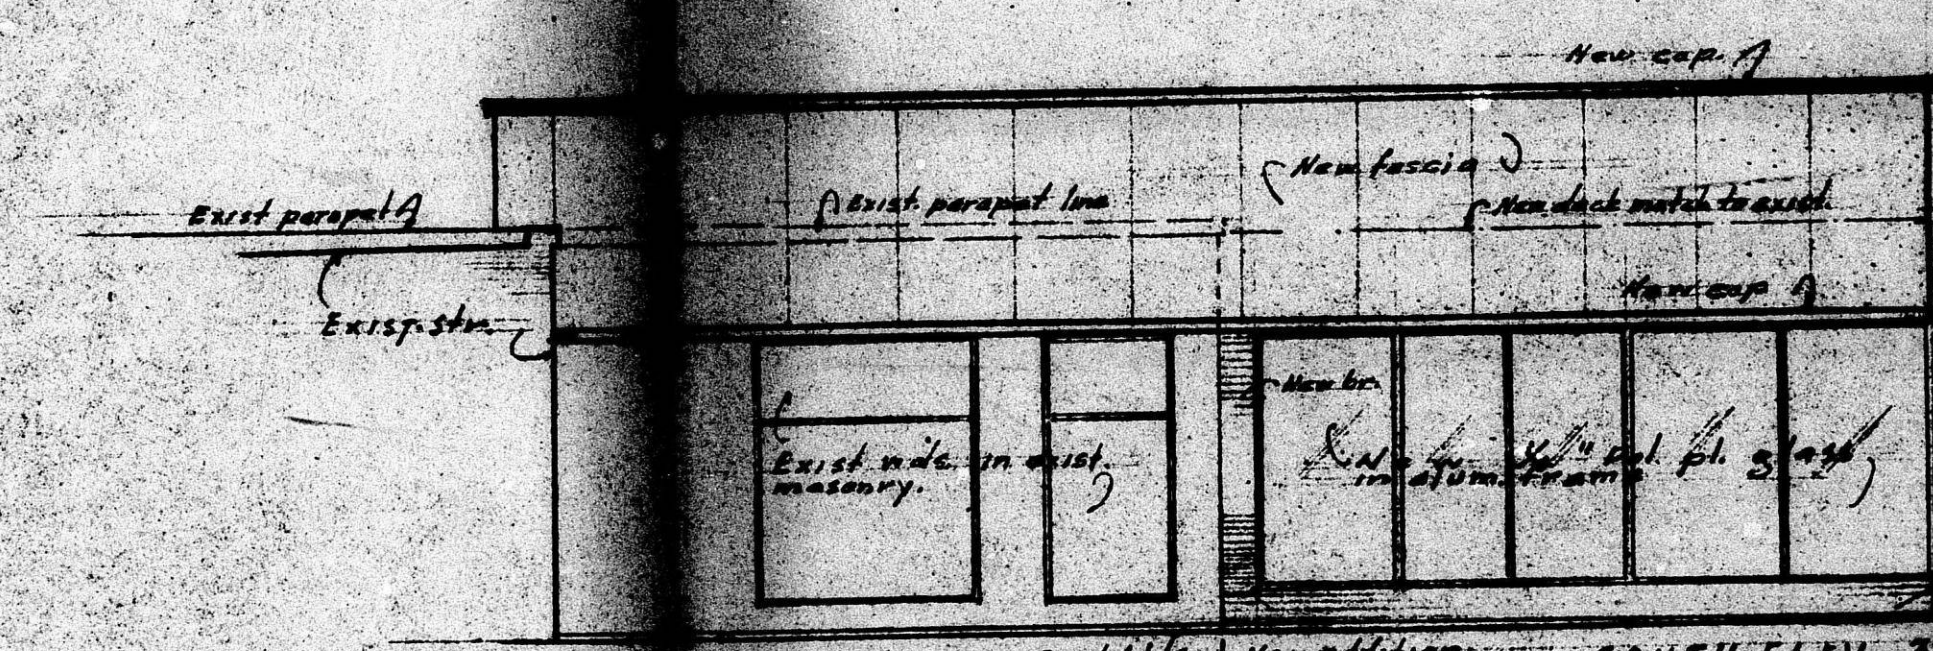

SOUTH ELEV. 36'-0"

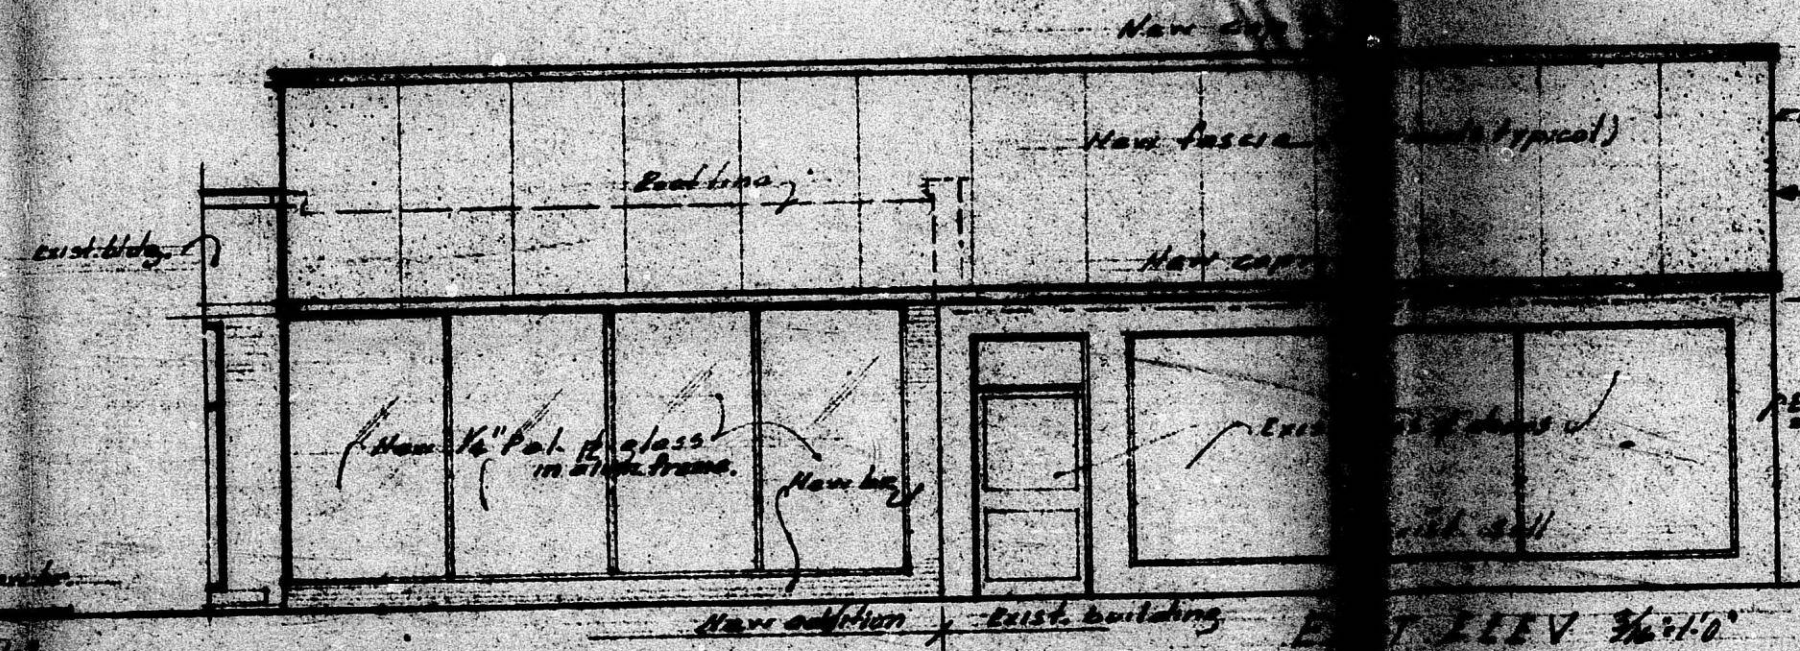

EAST ELEV. 36'-0"

LANDO CORP. LINCOLN & OLIVER	
Kichita, Kansas	
DATE 8-7-73	DESIGNED BY
DRAWN BY	
CHECKED BY	
APPROVED BY	

Sheet 2 of 7

7/20/77

28' 0"

31' 0"

4' WALK

4' WALK

6' 0" WALK

4' 0" WALK

22' 9"

4' 0" WALK

18' 0"

20' 0"

Lot 11, 12, 13 except the south 1.83 ft. of Lot 11, Oliver Heights.

OLIVER

LEGAL DESCRIPTION Lot 13 except the south 1.83 ft. of Lot 11, Oliver Heights. SITE PLAN 1/2" = 1' 0" (AS CONSTRUCTED)



LAND CO. CORP. LINCOLN & OLIVER	
NICHITA, KS.	
DATE: 5-7-77	APPROVED BY:
AS CONSTRUCTED	

SL 1547