


GENERAL PROVISIONS

- This development is proposed to contain a gross area of 40.01 acres ± and a net area of 36.04 acres ± (1,569,915.6 sq. ft. ±).
- Curb cuts - the maximum number of curb cuts along Central Avenue shall not exceed 6. The maximum number of curb cuts along Woodlawn shall not exceed 6.
- Maximum land coverage by buildings shall not exceed 30 percent of the total area for parcels 3, 4, 5, 6, 7, and 8.
- All utilities shall be installed underground.
- Advertising signs along Woodlawn Avenue and Central Avenue shall not exceed 30 feet in height and shall be placed so as not to project over public right-of-way. No billboard advertisement or roof signs shall be used. No signing will be permitted adjacent to Murdock Avenue.
- Maximum building height (see individual parcels).
- A fire lane, 20 feet in width, (with sufficient turning radii at corners for standard fire apparatus) shall be provided around all main structures constructed within parcels 3, 5, and 6, except for the building in the northwest corner of parcel 6 which shall not be required to have a firelane on the north or west sides. Said fire lane shall have a 3/4 inch asphalt base with 1 1/2 inch asphalt surface. No parking shall be allowed in such fire lane although it may be used for passenger loading and unloading. Prior to final approval of the plan, the Fire Chief, or his designated representative, shall approve the plan as to the location and design of the fire lane.
- The transfer of title of all or any portion of the land included within the Community Unit Plan (or any amendments thereto) does not constitute a termination of the Plan or any portion thereof, but said Plan shall run with the land for development and be binding upon present owners, their successors and assigns.
- A planting strip no less than 10 feet wide shall be placed along the south and west boundaries of parcels 3, 4, 5, and 6 when adjacent to AA, A, AA-1 or B zoning and separated by an alley, public way, or street.
- An International Engineering Permit on parcels 3, 5, and 6.
- At least one access point shall be provided to parcels 3, 5, and 6 in the event that it is cul-de-saced at the western property line.
- In the event that Murdock Street is cul-de-saced, the R.O.W. necessary for the cul-de-sac will be provided by parcel 1.
- A landscape plan for the 10 foot landscape areas as shown on the plan, indicating the type, location, method of watering, and specification of plant materials, shall be submitted to the Planning Department for review and approval prior to the issuance of any building permits on parcel 5. A landscape plan for the area on the south boundary was approved by the Planning Department on August 26, 1976.
- The development of this property proceeding in accordance with the development plan as approved by the Planning Commission, and any substantial deviation of the plan, as determined by the Superintendent of Central Inspection and the Director of Planning, shall constitute a violation of the building permit authorizing construction of the proposed development. Any major changes in this development plan to be resubmitted to the Planning Commission and City Commission for their consideration.
- Parcel 8 provisions:
 - Building setbacks per plan; building to be located generally at northeast corner of parcel 8.
 - Complete access control along Murdock Avenue.
 - Surface drainage from parcel 8 onto parcels 1 or 2 not permitted.
 - Four foot berm to be constructed and maintained along north side of parcel 8. See 5/25/82 Adjustment letter.
 - Parking not permitted within 8'-0" of south and west property lines of parcel 8.
 - All exterior lighting to be directed downward.
 - Water service for parcel 8 to be obtained from City of Wichita Water Mains.
 - Fences along south and west sides of parcel 8 to be repaired by parcel 8 owners if damaged by parcel 8 users.
- Access control provided between parcels 3 and 6 except the east 60'. Control to be provided by circulation design and existing covenants. Circulation design for each building to be approved by Planning Department prior to building permits on said parcels being issued.
- An area 25' x 30' located at the northwest corner of parcel 6 shall be available for A.C. condenser and electric transformer location. Said equipment will not interfere with drainage.

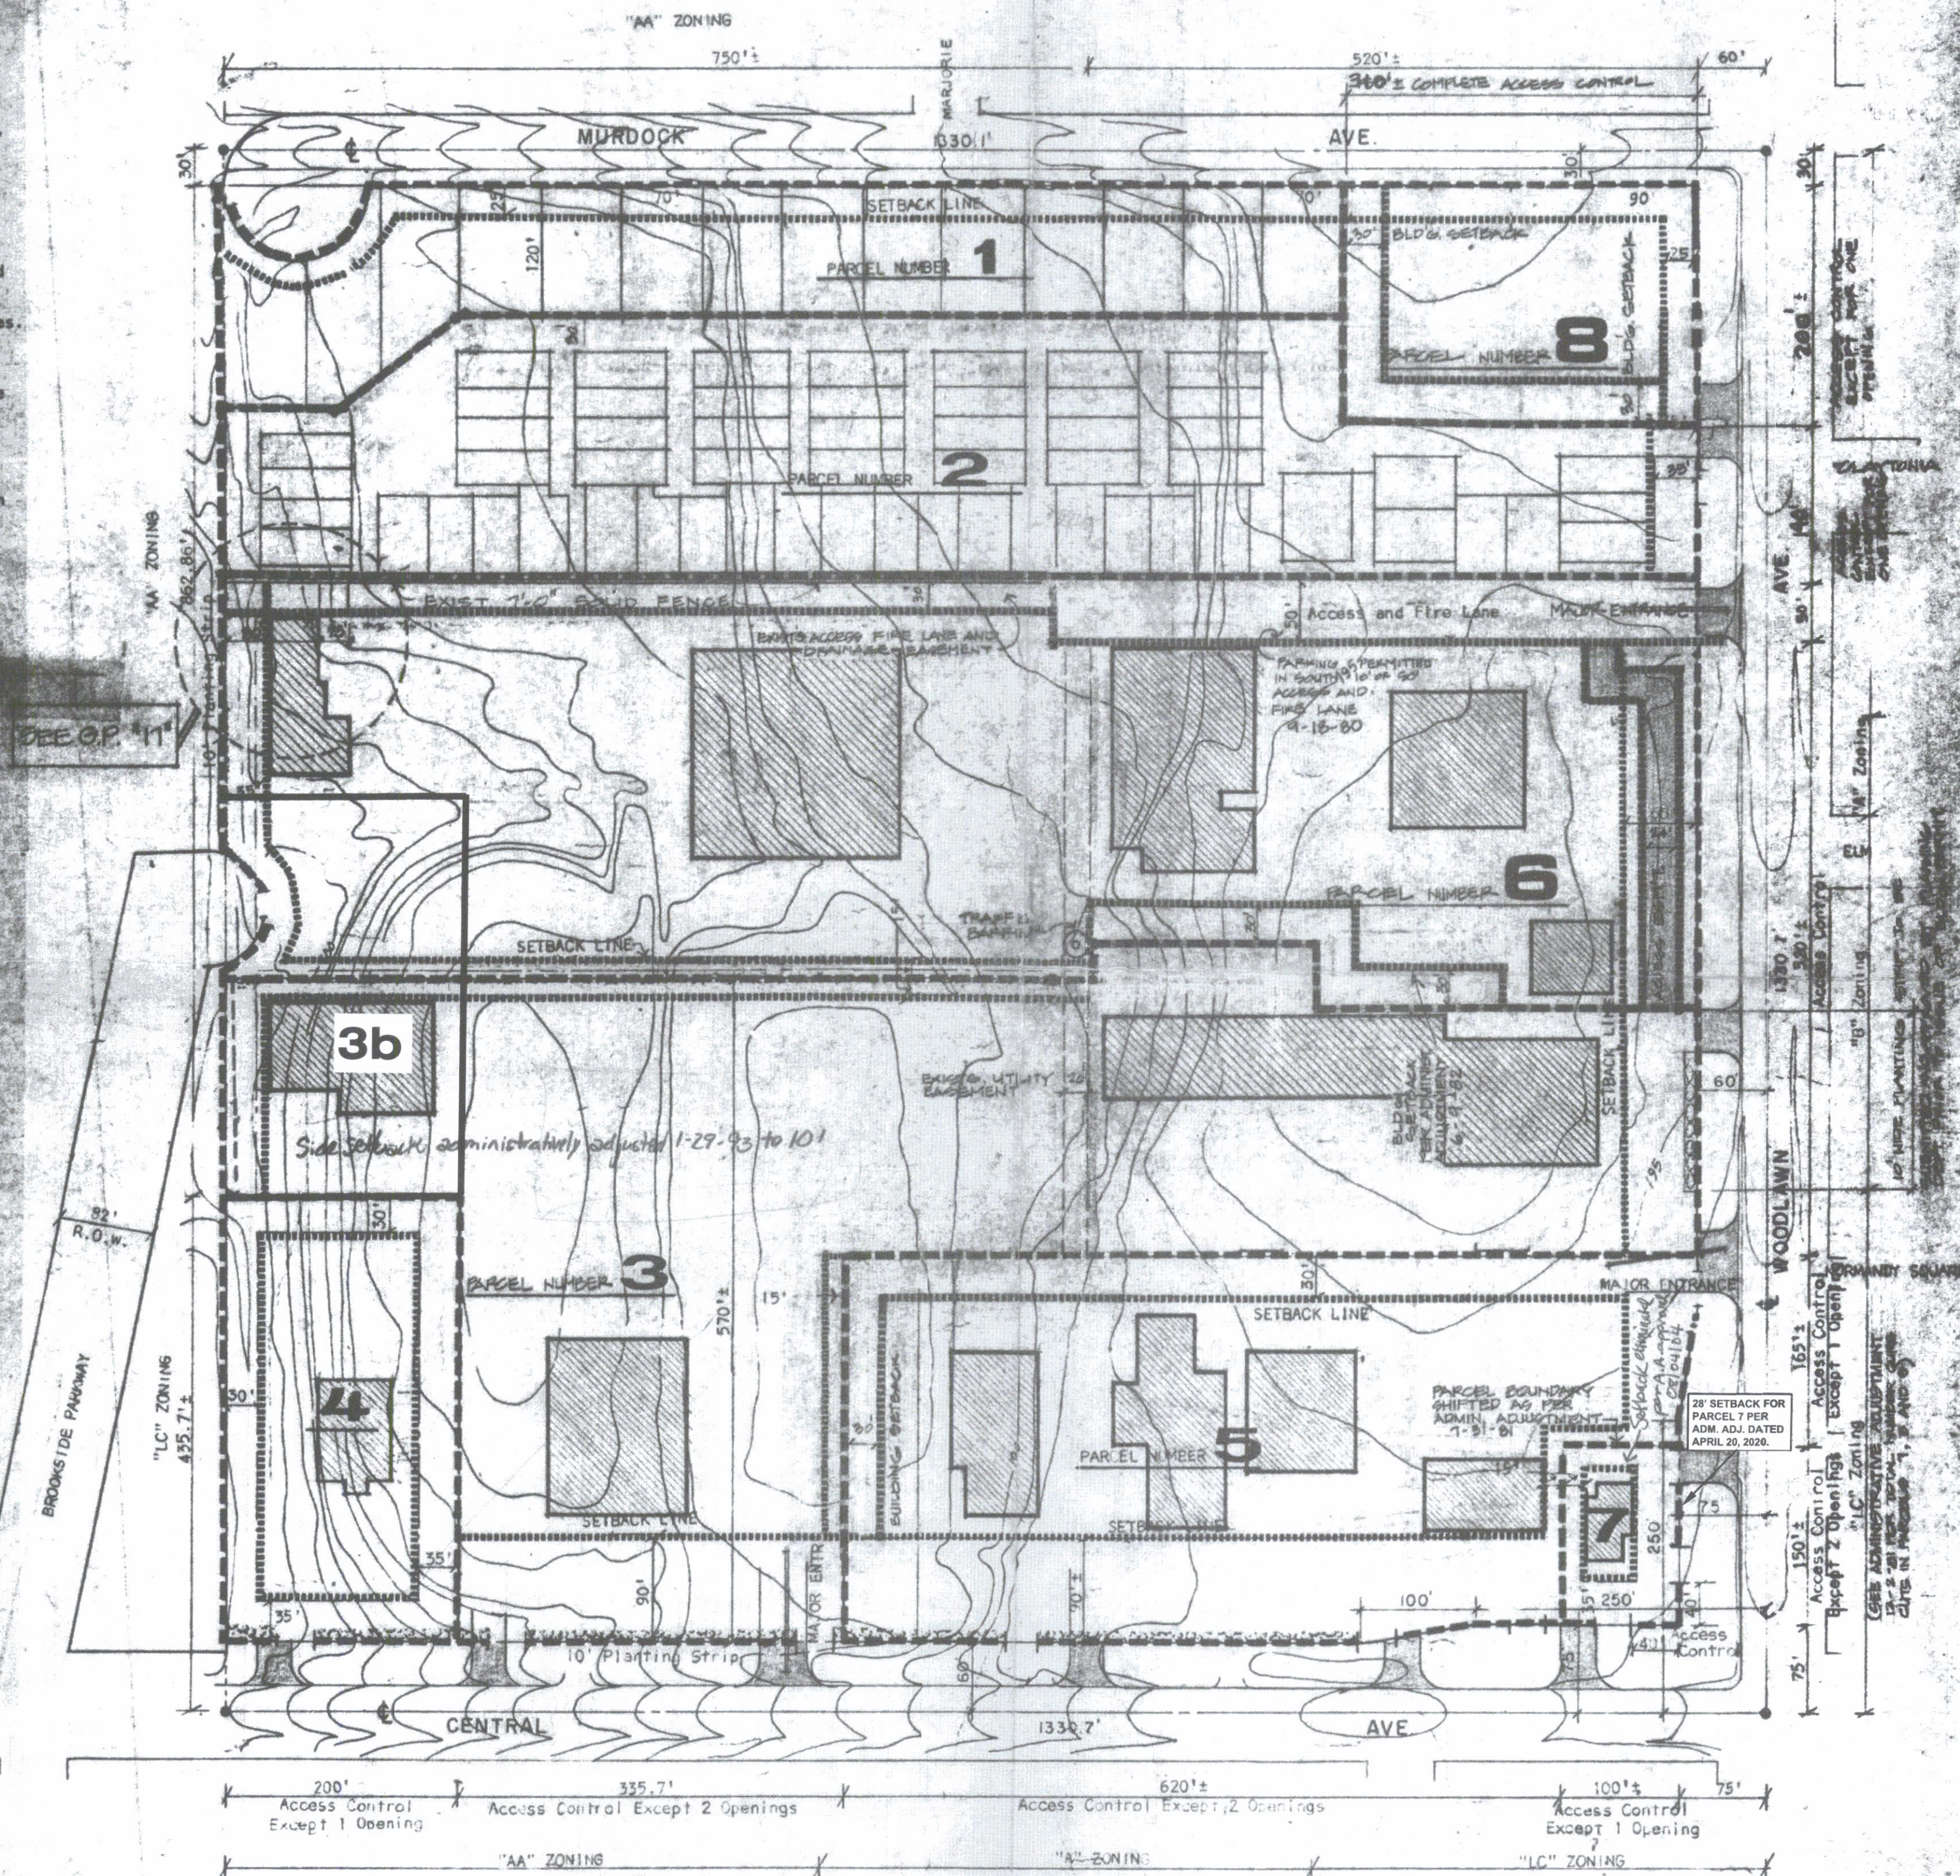

C-K-M COMMUNITY UNIT PLAN

DEVELOPER: C-K-M DEVELOPMENT CO.


Dated Oct. 24, 2024
APPROVED CUP

MAPC Per Admin Adjustment
1 of 4 CUR 24-36

Parcel Number	Proposed General Use	Shopping Center
	Total Net Area 1.45 ac ± Maximum Gross Floor Area Floor Area Ratio Maximum Building Height Maximum Land Coverage Parking Ratio as Required by Zoning Ordinance	63,078 Sq. Ft. 25,231 Sq. Ft. 40 55 Ft. 30 %
Parcel Number 2	Proposed General Use	Multi-Family Residential
	Total Net Area 4.55 ac ± Maximum Gross Floor Area Floor Area Ratio Maximum Building Height Maximum Land Coverage Parking Ratio as Required by Zoning Ordinance	195,543 Sq. Ft. 35 Ft. 55
Parcel Number 3	Proposed General Use	Shopping Center
	Total Net Area 6.50 ac ± Maximum Gross Floor Area Floor Area Ratio Maximum Building Height Maximum Land Coverage Parking Ratio as Required by Zoning Ordinance	371,010 Sq. Ft. 148,404 Sq. Ft. 40 55 Ft. 30 %
Parcel Number 4	Proposed General Use	Financial
	Total Net Area 1.75 ac ± Maximum Gross Floor Area Floor Area Ratio Maximum Building Height Maximum Land Coverage Parking Ratio as Required by Zoning Ordinance	75,180 Sq. Ft. 10,400 Sq. Ft. 27 35 Ft. 30 %
Parcel Number 5	Proposed General Use	Food Service & Retail Sales Office/Professional & Medical Offices and Office Uses Included in "BB" Zoning District
	Total Net Area 5.05 ac ± Maximum Gross Floor Area Floor Area Ratio Maximum Building Height Maximum Land Coverage Parking Ratio as Required by Zoning Ordinance	220,015 Sq. Ft. 88,005 Sq. Ft. 40 35 Ft. 30 %
Parcel Number 6	Proposed General Use	Offices and Uses Permitted in "BB" Zoning District Single-Family and Other Residential Uses
	Total Net Area 9.01 ac ± Maximum Gross Floor Area Floor Area Ratio Maximum Building Height Maximum Land Coverage Parking Ratio as Required by Zoning Ordinance	431,902 Sq. Ft. 172,760 Sq. Ft. 40 35 Ft. 30 %
Parcel Number 7	Proposed General Use	Financial
	Total Net Area 14.4 ac ± Maximum Gross Floor Area Floor Area Ratio Maximum Building Height Maximum Land Coverage Parking Ratio as Required by Zoning Ordinance	45,000 Sq. Ft. 6,000 Sq. Ft. 40 35 Ft. 30 %
Parcel Number 8	Proposed General Use	Ophthalmologist, including Sales and Dispensing of Optical Items; Medical Offices and Office Uses Included in "BB" Zoning District
	Total Net Area 1.12 ac ± Maximum Gross Floor Area Floor Area Ratio Maximum Building Height Maximum Land Coverage Parking Ratio as Required by Zoning Ordinance	22,000 Sq. Ft. 24,000 Sq. Ft. Ground Level, Excluding Basement 40 1 Story, Max. 22 Feet 12,000 Sq. Ft.

DP-45
APPROVED CUP

MAPC 10-18-84
BCC 11-13-84

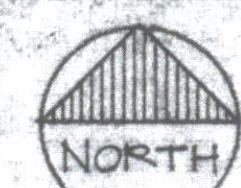

LEGEND

- BUILDING SETBACK LINE
- ACCESS EASEMENT
- PARCEL PROPERTY LINE
- ACCESS ENTRANCE DRIVES
- STRUCTURE

MAPD COPY 10-2

MAY 21, 1982
 MAY 21, 1984
 MAY 21, 1984
 OCTOBER 24, 2024 AD

AUG 14, 1972
 SEPT 27, 1972
 DEC 10, 1972
 FEB 6, 1973
 MAY 1, 1973

AUG 14, 1972
 SEPT 27, 1972
 DEC 10, 1972
 FEB 6, 1973
 MAY 1, 1973

JULY 13, 1972

Title Date Project

C-K-M COMMUNITY UNIT PLAN

BAUGHMAN
 REVISED PER ADM. ADJ. 4/20/20

Keith Parker Associates
 Architects - Planners - Commercial Consultants



**Wichita-Sedgwick County
Metropolitan Area
Planning Department**

Genesis Health Clubs E Central, LLC
6100 E Central Ave., Ste 3
Wichita, KS 67208

October 24, 2024

Baughman Company, P.A.
Attn: Jay Cook
315 S. Ellis Ave.
Wichita, KS 67211

RE: CUP2024-00036 – Administrative Adjustment in the City to the C-K-M CUP DP-45 to create a new CUP parcel around two existing ownership parcels on property zoned LC Limited Commercial District, located 375 feet north of East Central Avenue and one-quarter mile west of North Woodlawn Blvd. (6100 E. Central Ave., Ste. 3).

Legal Description: North 194.3 feet of the West 200 feet of Lot 6; together with that part of Lot 8 described as Commencing 195ft south of the Northwest Corner of Lot 8; thence along a Southernly angle along the West line to the Southwest Corner of Lot 8; thence East 200 ft.; thence North 133.72 Ft to a point 195 ft. South of the North Line; thence West 200 ft to beginning, all in the Kapaun 1st Addition, Wichita, Sedgwick County, Kansas.

Dear Applicant,

We received and reviewed your request for an Administrative Adjustment to CUP DP-45 to create a new CUP parcel around two existing ownership parcels that are under common ownership. This would create Parcel 3b from Parcels 3 and 6. Parcels 3 and 6 are large CUP parcels comprised of multiple ownership parcels within them. The request would allow future CUP changes to the current ownership parcels to be more narrowly tailored than requesting changes to the whole of Parcel 3 and/or 6.

The following reflects the proposed modifications identified in red letters:

GENERAL PROVISIONS

Parcel 3

- Proposed General Use: Shopping Center
- Total Net Area: ~~9.19~~ 8.50 Ac. +/- or ~~409,798~~ 371,010 sq. ft. +/-
- Maximum Gross Floor Area: ~~163,919~~ 148,404 sq. ft. +/-
- Floor Area Ratio: 0.40
- Maximum Building Height: 55 ft.
- Maximum Land Coverage: 30%
- Parking Ratio as required by Zoning Ordinance

Parcel 6

- Proposed General Use: Offices and Uses Permitted in the "BB" Zoning District, except Residential
- Total Net Area: ~~40.47~~ 9.91 Ac. +/- or ~~456,192~~ 431,902 sq. ft. +/-
- Maximum Gross Floor Area: ~~182,477~~ 172,760 sq. ft. +/-
- Floor Area Ratio: 0.40
- Maximum Building Height: 55 ft.
- Maximum Land Coverage: 30%
- Parking Ratio as required by Zoning Ordinance

Parcel 3b

- Proposed General Use: Shopping Center
- Total Net Area: 1.45 Ac. +/- or 63,078 sq. ft. +/-
- Maximum Gross Floor Area: 25,231 sq. ft. +/-
- Floor Area Ratio: 0.40
- Maximum Building Height: 55 ft.
- Maximum Land Coverage: 30%
- Parking Ratio as required by Zoning Ordinance


On the basis of our review, we find that adjusting the CUP in the manner stated above is consistent with the approved CUP and will not have an adverse effect on the CUP or adjacent properties, nor will it be a substantial deviation of the original plan.

Our signatures below indicate that the CUP shall be adjusted as stated in this letter. This CUP adjustment shall not be deemed to alter any other provisions of the CUP except as expressly stated herein.

The "Development Application" sign should now be removed from the property. Please submit one (1) electronic copy and four (4) full-sized paper copies of the revised CUP drawing within 60 days in order for this adjustment to be considered final.



Scott Wadle, Director
Metropolitan Area Planning Department

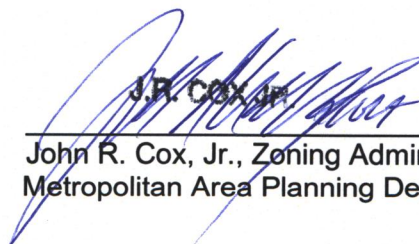

J.R. COX, JR.

John R. Cox, Jr., Zoning Administrator
Metropolitan Area Planning Department

cc: MABCD
Brandon Johnson, CM District I
Cameron Jackson, CSR District I

GENERAL PROVISIONS

- This development is proposed to contain a gross area of 40.01 acres ± and a net area of 36.04 acres ± (1,569,915.6 sq. ft. ±).
- Curb cuts - the maximum number of curb cuts along Central Avenue shall not exceed 6. The maximum number of curb cuts along Woodlawn shall not exceed 6.
- Maximum land coverage by building shall not exceed 30 percent of the total area for parcels 3, 4, 5, 6, 7, and 8.
- All utilities shall be installed underground.
- Advertising signs along Woodlawn Avenue and Central Avenue shall not exceed 30 feet in height and shall be placed so as not to project over public right-of-way. No billboard advertisement or roof signs shall be used. No signing will be permitted adjacent to Murdock Avenue.
- Maximum building height (see individual parcels).
- A fire lane, 20 feet in width, (with sufficient turning radii at corners for standard fire apparatus) shall be provided around all main structures constructed within parcels 3, 5, and 6, except for the building in the northwest corner of parcel 6 which shall not be required to have a firelane on the north or west sides. Said fire lane shall have a 3 1/2 inch asphalt base with 1 1/2 inch asphalt surface. No parking shall be allowed in such fire lane although it may be used for passenger loading and unloading. Prior to final approval of the parking, the Fire Chief, or his designated representative, shall approve the plan as to the location and design of the fire lane.
- The transfer of title of all or any portion of the land included within the Community Unit Plan (or any amendments thereto) does not constitute a termination of the Plan or any portion thereof, but said Plan shall run with the land for development and be binding upon present owners, their successors and assigns.
- A planting strip no less than 10 feet wide shall be placed along the south and east boundaries of parcels 3, 4, and 5 when adjacent to AA, A, R8, or B zoning and separated by an alley, public way, or street.
- An interior circulation roadway shall be provided and submitted to the Department of Engineering for review and approval prior to the issuance of the building permits on parcels 3, 4, and 5.
- At least one access point shall be provided to Brookside Parkway in the event that it is cul-de-saced at the western property line.
- In the event that Murdock Street is cul-de-saced, the R.O.W. necessary for the cul-de-sac will be provided by parcel 1.
- A landscape plan for the 10 foot landscape areas as shown on the plan, indicating the type, location, method of watering, and specification of plant materials, shall be submitted to the Planning Department for review and approval prior to the issuance of any building permits on parcel 3. A landscape plan for the area on the south boundary was approved by the Planning Department on August 20, 1975.
- The development of this property proceeding in accordance with the development plan as approved by the Planning Commission, and any substantial deviation of the plan, as determined by the Superintendent of General Inspection and the Director of Planning, shall constitute a violation of the building permit authorizing construction of the proposed development. Any major changes in this development plan to be resubmitted to the Planning Commission and City Commission for their consideration.
- Parcel 8 provisions:
 - Building setbacks per plan; building to be located generally at northeast corner of parcel 8.
 - Complete access control along Murdock Avenue.
 - Surface drainage from parcel 8 onto parcels 1 or 2 not permitted.
 - Four foot berm to be constructed and maintained along north side of parcel 8. *See 5/25/82 Adjustment letter*
 - Parking not permitted within 8'-0" of south and west property lines of parcel 8.
 - All exterior lighting to be directed downward.
 - Water service for parcel 8 to be obtained from City of Wichita Water Mains.
 - Fences along south and west sides of parcel 8 to be repaired by parcel 8 owners if damaged by parcel 8 users.
- Access control provided between parcels 3 and 6 except the east 60'. Control to be provided by circulation design and existing covenants. Circulation design for each building to be approved by Planning Department prior to building permits on said parcels being issued.
- An area 25' x 30' located at the northwest corner of parcel 6 shall be available for A.C. condenser and electric transformer location. Said equipment will not interfere with drainage.

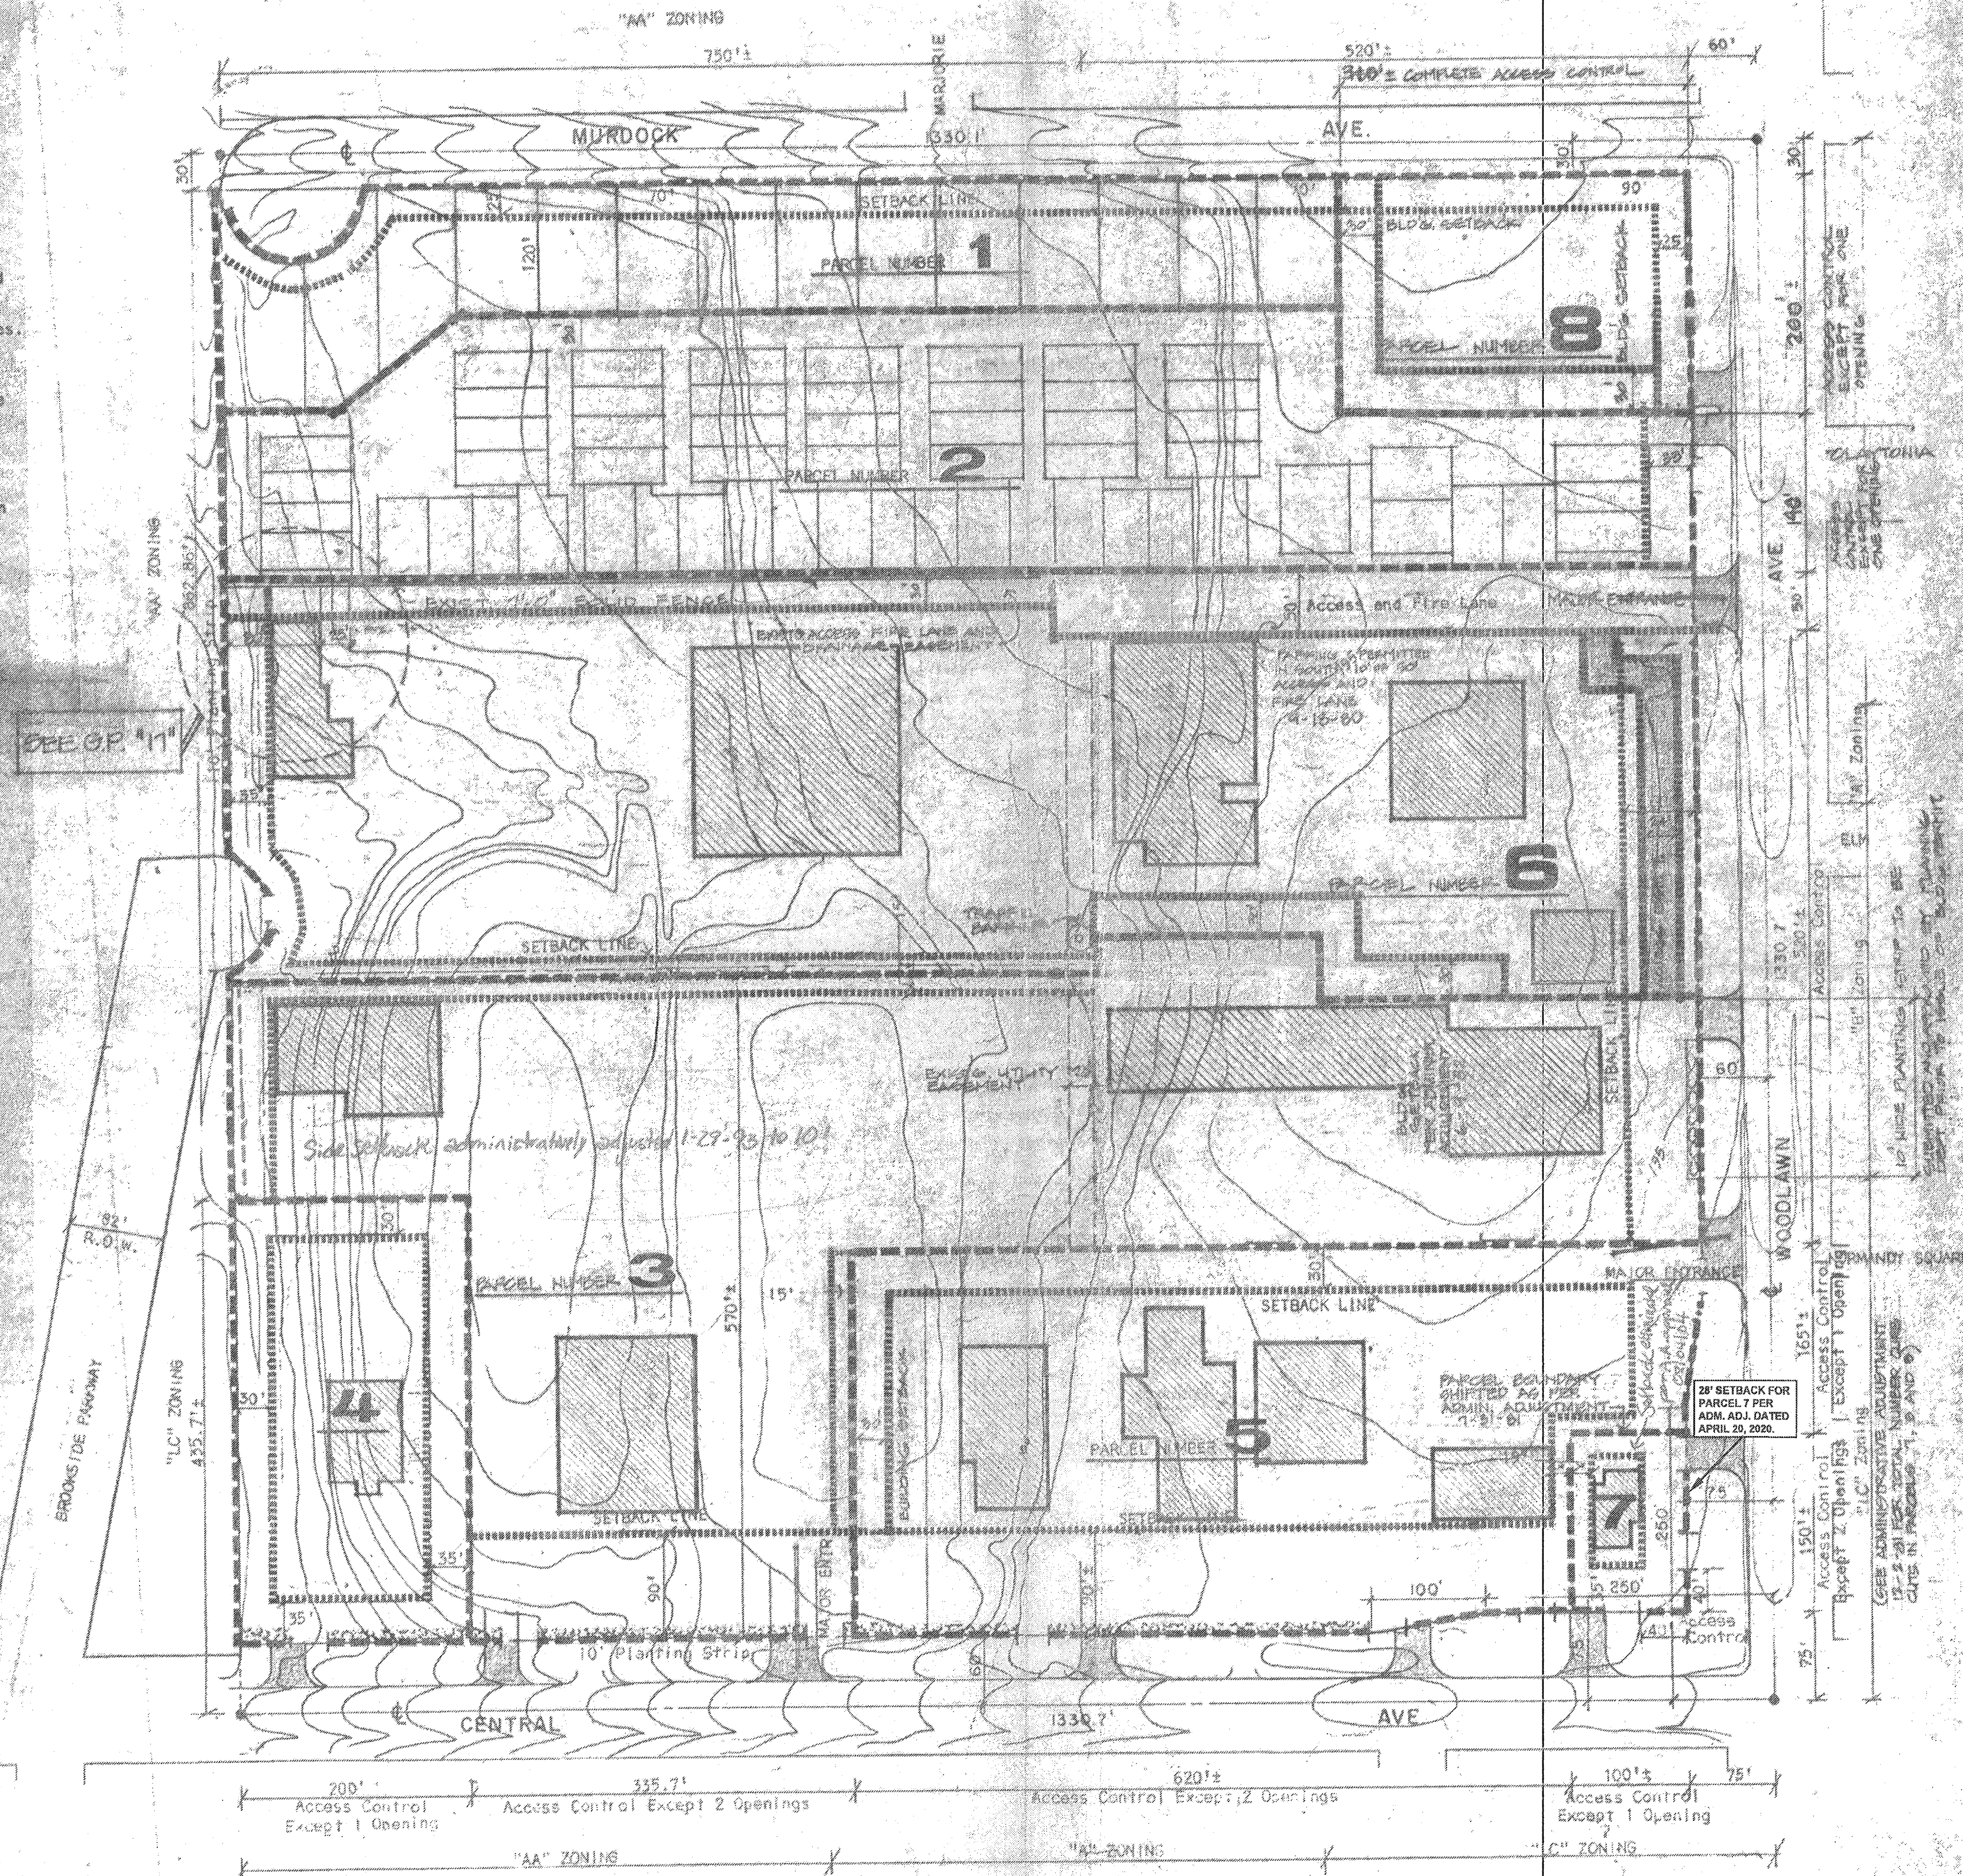

PARCEL NUMBER 1	Proposed General Use	Single-Family and Other Residential
	Total Net Area 0.80 Ac. ±	120,729 Sq. Ft. ±
	Maximum Building Height	35 Ft.
	Parking Ratio as Required by Zoning Ordinance	14
PARCEL NUMBER 2	Proposed General Use	Multi-Family Residential
	Total Net Area 1.95 Ac. ±	190,241 Sq. Ft. ±
	Maximum Building Height	35 Ft.
	Parking Ratio 1.5 spaces per D.U.	55
	Density Not to Exceed 15.4 D.U.s/Acre	
	Total Number of D.U.'s	301
PARCEL NUMBER 3	Proposed General Use	Shopping Center
	Total Net Area 9.39 Ac. ±	409,729 Sq. Ft. ±
	Maximum Gross Floor Area	164,236 Sq. Ft. ±
	Floor Area Ratio	40
	Maximum Building Height	35 Ft.
	Maximum Land Coverage	20%
	Parking Ratio as Required by Zoning Ordinance	
PARCEL NUMBER 4	Proposed General Use	Financial
	Total Net Area 1.72 Ac. ±	77,170 Sq. Ft. ±
	Maximum Gross Floor Area	60,000 Sq. Ft. ±
	Floor Area Ratio	27
	Maximum Building Height	35 Ft.
	Maximum Land Coverage	30%
	Parking Ratio as Required by Zoning Ordinance	
PARCEL NUMBER 5	Proposed General Use	Food Service & Retail Sales
	Total Net Area 5.05 Ac. ±	220,015 Sq. Ft. ±
	Maximum Gross Floor Area	88,005 Sq. Ft. ±
	Floor Area Ratio	40
	Maximum Building Height	35 Ft.
	Maximum Land Coverage	30%
	Parking Ratio as Required by Zoning Ordinance	
PARCEL NUMBER 6	Proposed General Use	Offices and Uses Permitted in "AA" Zoning District Except Residential
	Total Net Area 10.42 Ac. ±	556,129 Sq. Ft. ±
	Maximum Gross Floor Area	155,692 Sq. Ft. ±
	Floor Area Ratio	40
	Maximum Building Height	35 Ft.
	Maximum Land Coverage	30%
	Parking Ratio as Required by Zoning Ordinance	
PARCEL NUMBER 7	Proposed General Use	Financial
	Total Net Area .34 Ac. ±	15,000 Sq. Ft. ±
	Maximum Gross Floor Area	6,000 Sq. Ft. ±
	Floor Area Ratio	40
	Maximum Building Height	35 Ft.
	Maximum Land Coverage	30%
	Parking Ratio as Required by Zoning Ordinance	
PARCEL NUMBER 8	Proposed General Use	Orthodontist, including sales and dispensing of optical items; Medical Offices and Office Uses included in "B2" Zoning District
	Total Net Area 1.42 Ac. ±	62,000 Sq. Ft. ±
	Maximum Gross Floor Area	24,000 Sq. Ft. Ground Level, Excluding Basement
	Floor Area Ratio	40
	Maximum Building Height	1 Story, Max. 22 Feet
	Maximum Land Coverage	18,000 Sq. Ft.
	Parking Ratio as Required by Zoning Ordinance	

APPROVED CUP

MAPD 10-18-84
Bole 11-13-84
MAPD COPY 10-4
As Per AA CUP 10-18-84
4-20-2020 PER



LEGEND

- BUILDING SETBACK LINE
- ACCESS EASEMENT
- PARCEL PROPERTY LINE
- ACCESS ENTRANCE DRIVE
- STRUCTURE

C-K-M COMMUNITY UNIT PLAN

DEVELOPER: C-K-M DEVELOPMENT CO.

MAY 21, 1982
MAY 7, 1984
MAY 24, 1984
MAY 2, 1984

1980
NOV. 3, 1980
DEC. 10, 1980
JAN. 2, 1981
FEB. 2, 1981
MAR. 2, 1981
APR. 2, 1981

1981
AUG. 14, 1981
SEPT. 21, 1981
OCT. 12, 1981
NOV. 12, 1981
DEC. 12, 1981
JAN. 12, 1982
FEB. 12, 1982
MAR. 12, 1982

Issue REV. 10/20/20

239 Patton Suite 2
Wichita, Kansas • 67211
(316) • 263 - 8261

Architects • Planners • Commercial Consultants
Keith Parker Associates

C-K-M COMMUNITY UNIT PLAN DP-A5

JULY 13, 1972 Date


Project

BAUGHMAN
REVISED PER ADM. ADJ. 4/20/20

1. GRASS BERM HEIGHT AND CONFIGURATION IS DETERMINED BY AVAILABLE SPACE AND MAXIMUM SLOPE FOR GRASS BERMS - 3(RUN):1(RISE). NO FILL SOIL TO BE PLACED WITHIN DRIPLINE OF EXISTING PIN OAKS.

2. PINES SHOWN AT INSTALLATION SIZE (DIAMETER). PINES TO BE 12' TO 15' TALL, SCOTCH VARIETY, INSTALLED W/ 11" DIA. TREE SPADE.

EXIST'G PIN OAKS
(ACTUAL DRIPLINE SHOWN)

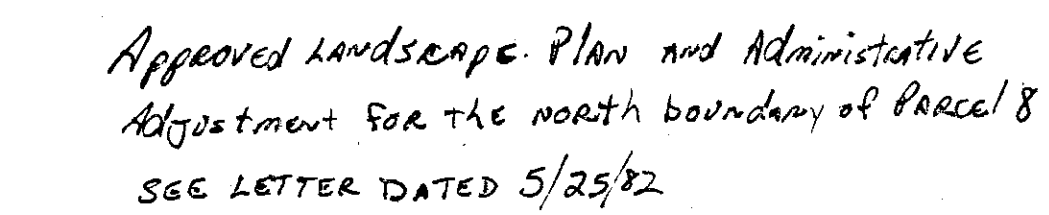

Robert A. Lakin
Robert A. Lakin Dir. of Planning
Robert B. Feldman
Robert B. Feldman Superintendent of Gen. Insp.

DP 45

— JUNIPER GROUND COVER



$$1'' = 10' - 0''$$

REV. 5-11-82
REV. 4-24-82

4-22-80

462

APPROVED REVISED
 LANDSCAPE PLAN FOR
 PARCEL 4, DP45 CKM CUP
 [Signature] 3-27-81
 DATE

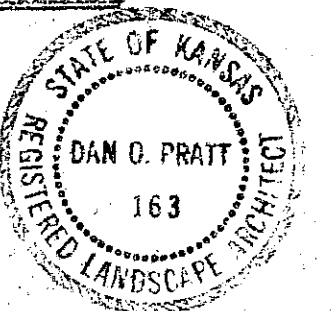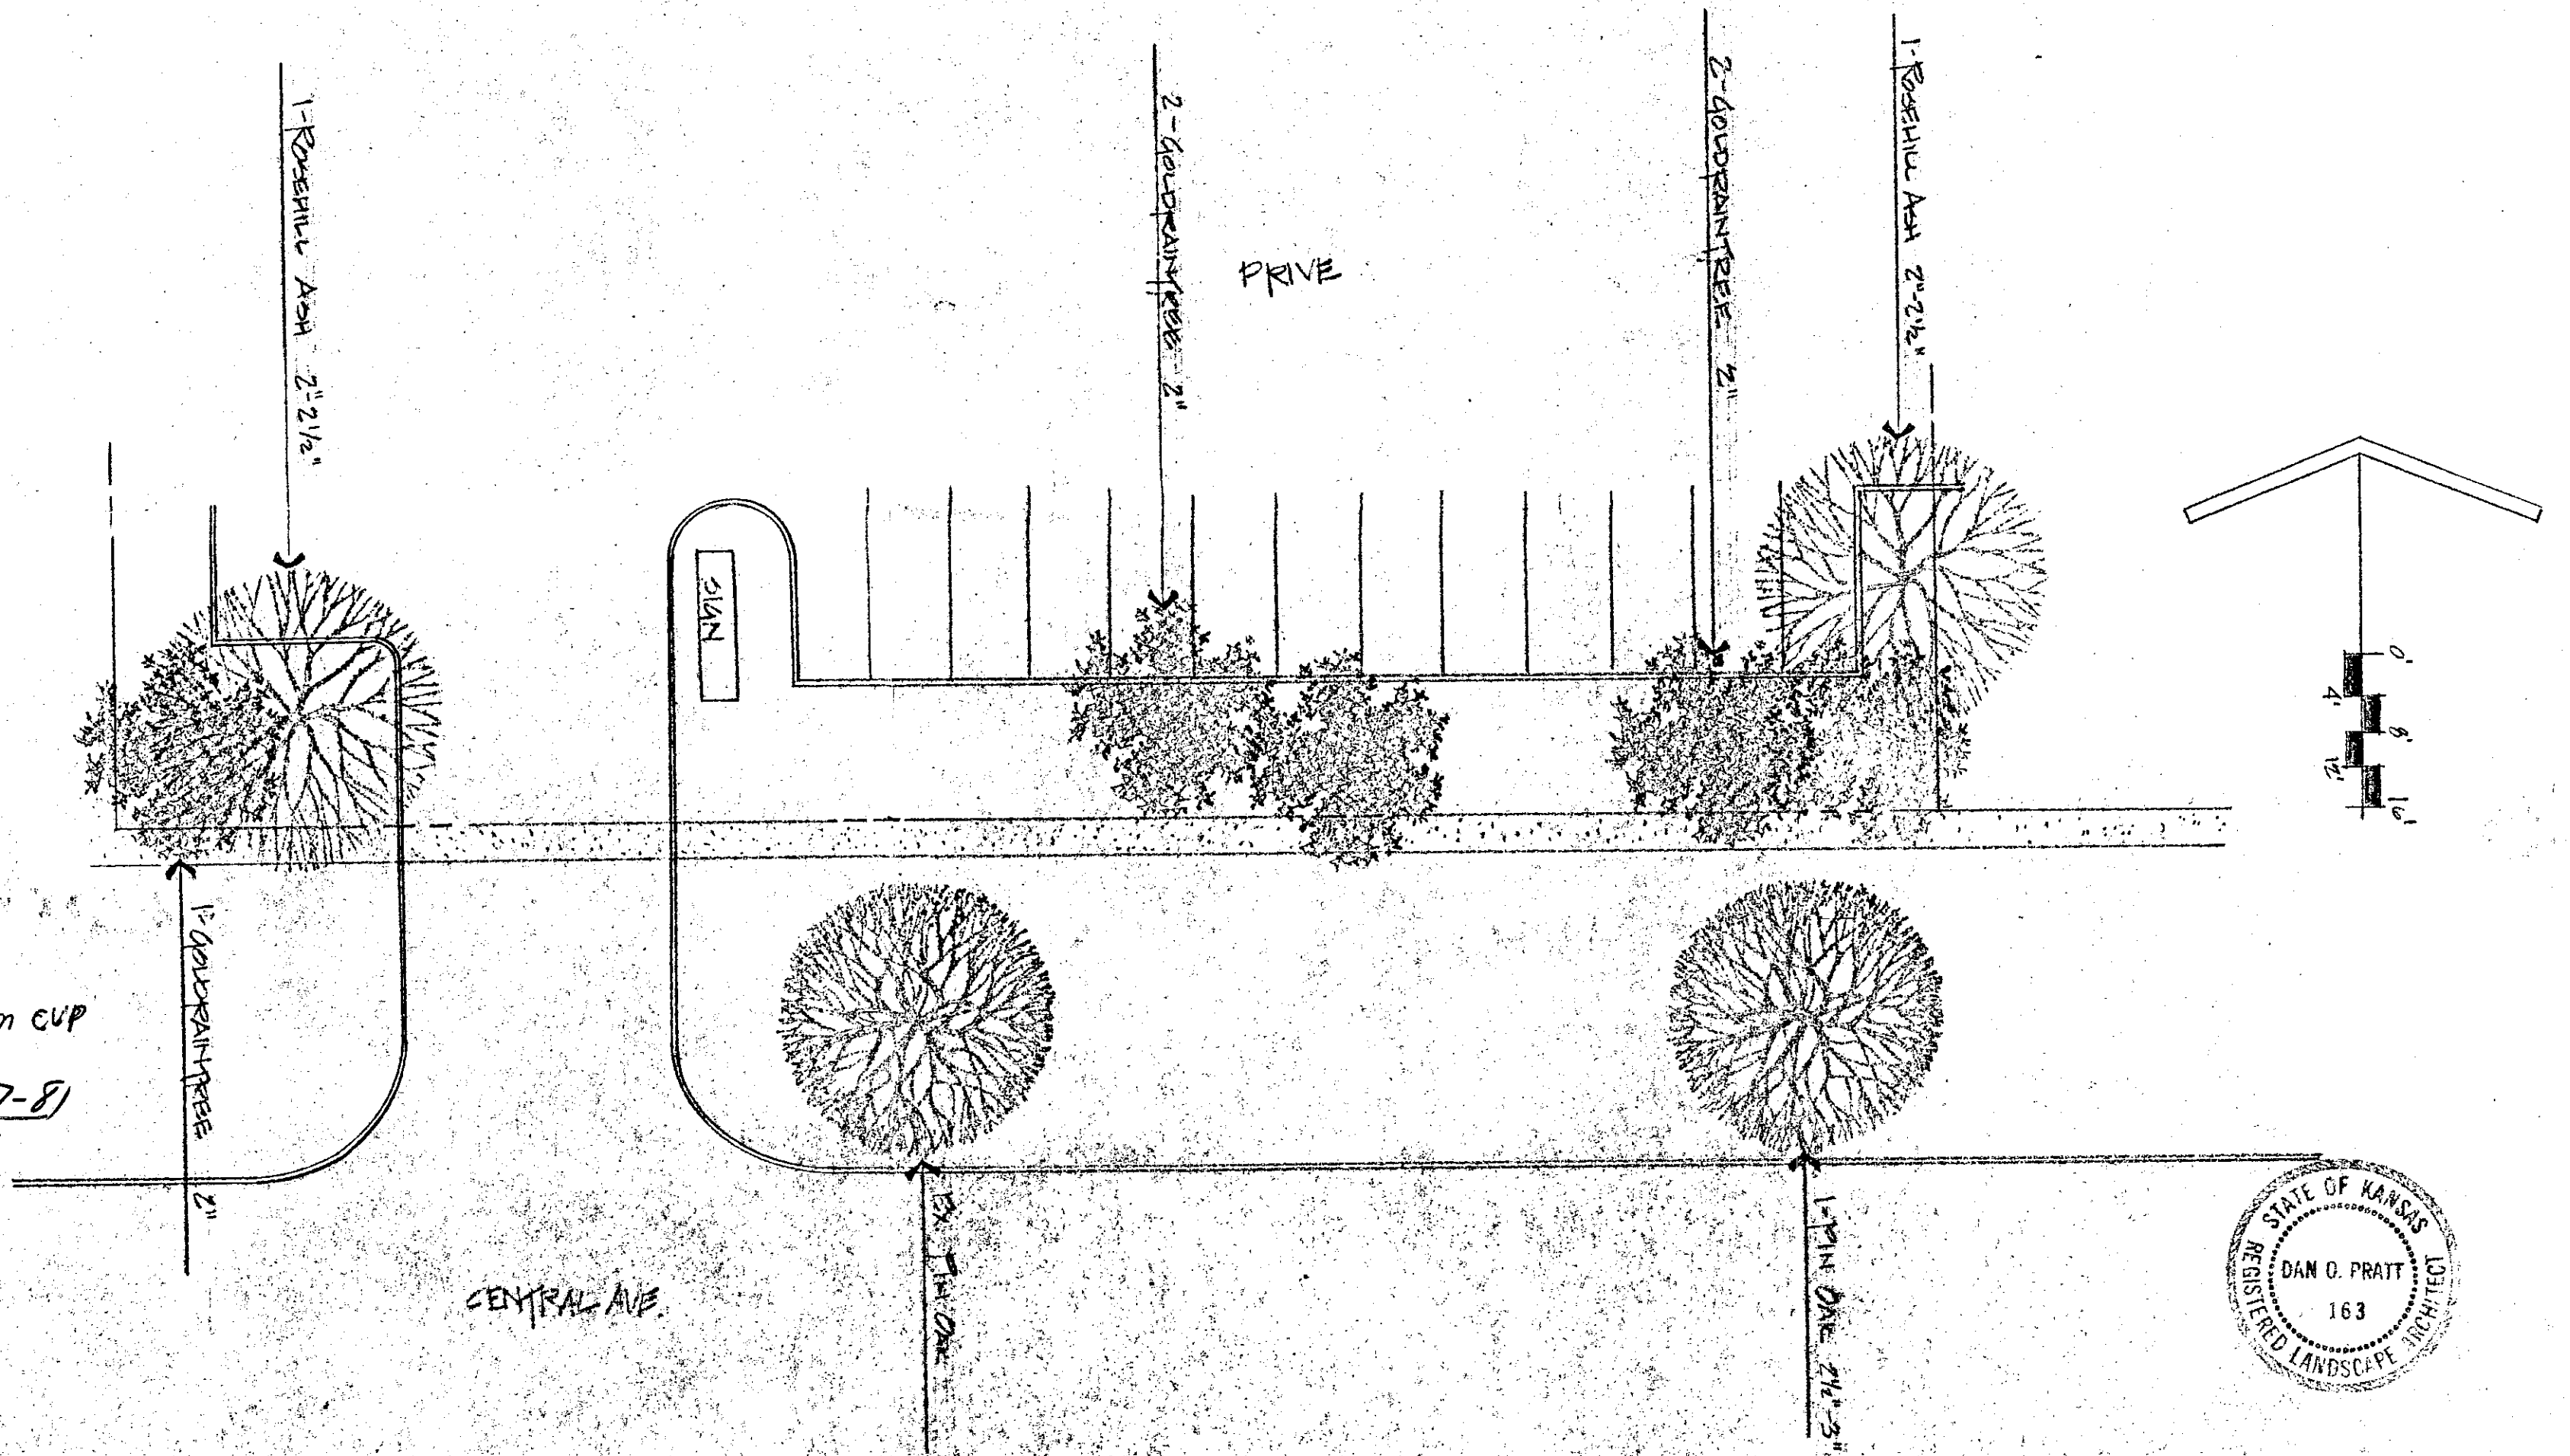

SHEET
 1/1

A LANDSCAPE PLAN FOR
 UNITED AMERICAN BANK & TRUST CO.
 6030 EAST CENTRAL
 REVISED PLANTING PLAN (PARTIAL)

DRAWN ROP
 DATE 3/14/81
 SCALE 1/4" = 1'-0"

Roger's
 Nursery, Inc.
 3500 NORTH HILLSIDE • P.O. BOX 8005 WICHITA, KANSAS 67208 • (316)-838-1401

LEGEND:
 A EXISTING PIN OAK TO REMAIN
 B JAPANESE BLACK PINE 10'-12'
 C VERIGATED BLUE PRITZER 10'
 D PARSONI JUNIPER 50'
 E MANHATTAN BUCCINUMUS 50'
 F THORNLESS HONEY LOCUST 10'-12'
 G SEA GREEN JUNIPER 50'
 H YUCCA PENDULA 50'
 I HOLLYWOOD JUNIPER 10'
 X SPRINKLER HEAD (POP UP)
 Y RECESSED KEYED HYDRANT


APPROVED LANDSCAPE PLAN AMENDMENT For Lot 4 of Kapaun First Addition in the C-K-M CUP (DP 45)


John H. Gilbrath

10-23-79

DATE

HEART THOUGHTS INC.
 6200 E. CENTRAL
 REVISION TO LANDSCAPE PLANS
 GOODVIN & ASSOCIATES ARCHITECTS
 OCTOBER 18, 1979

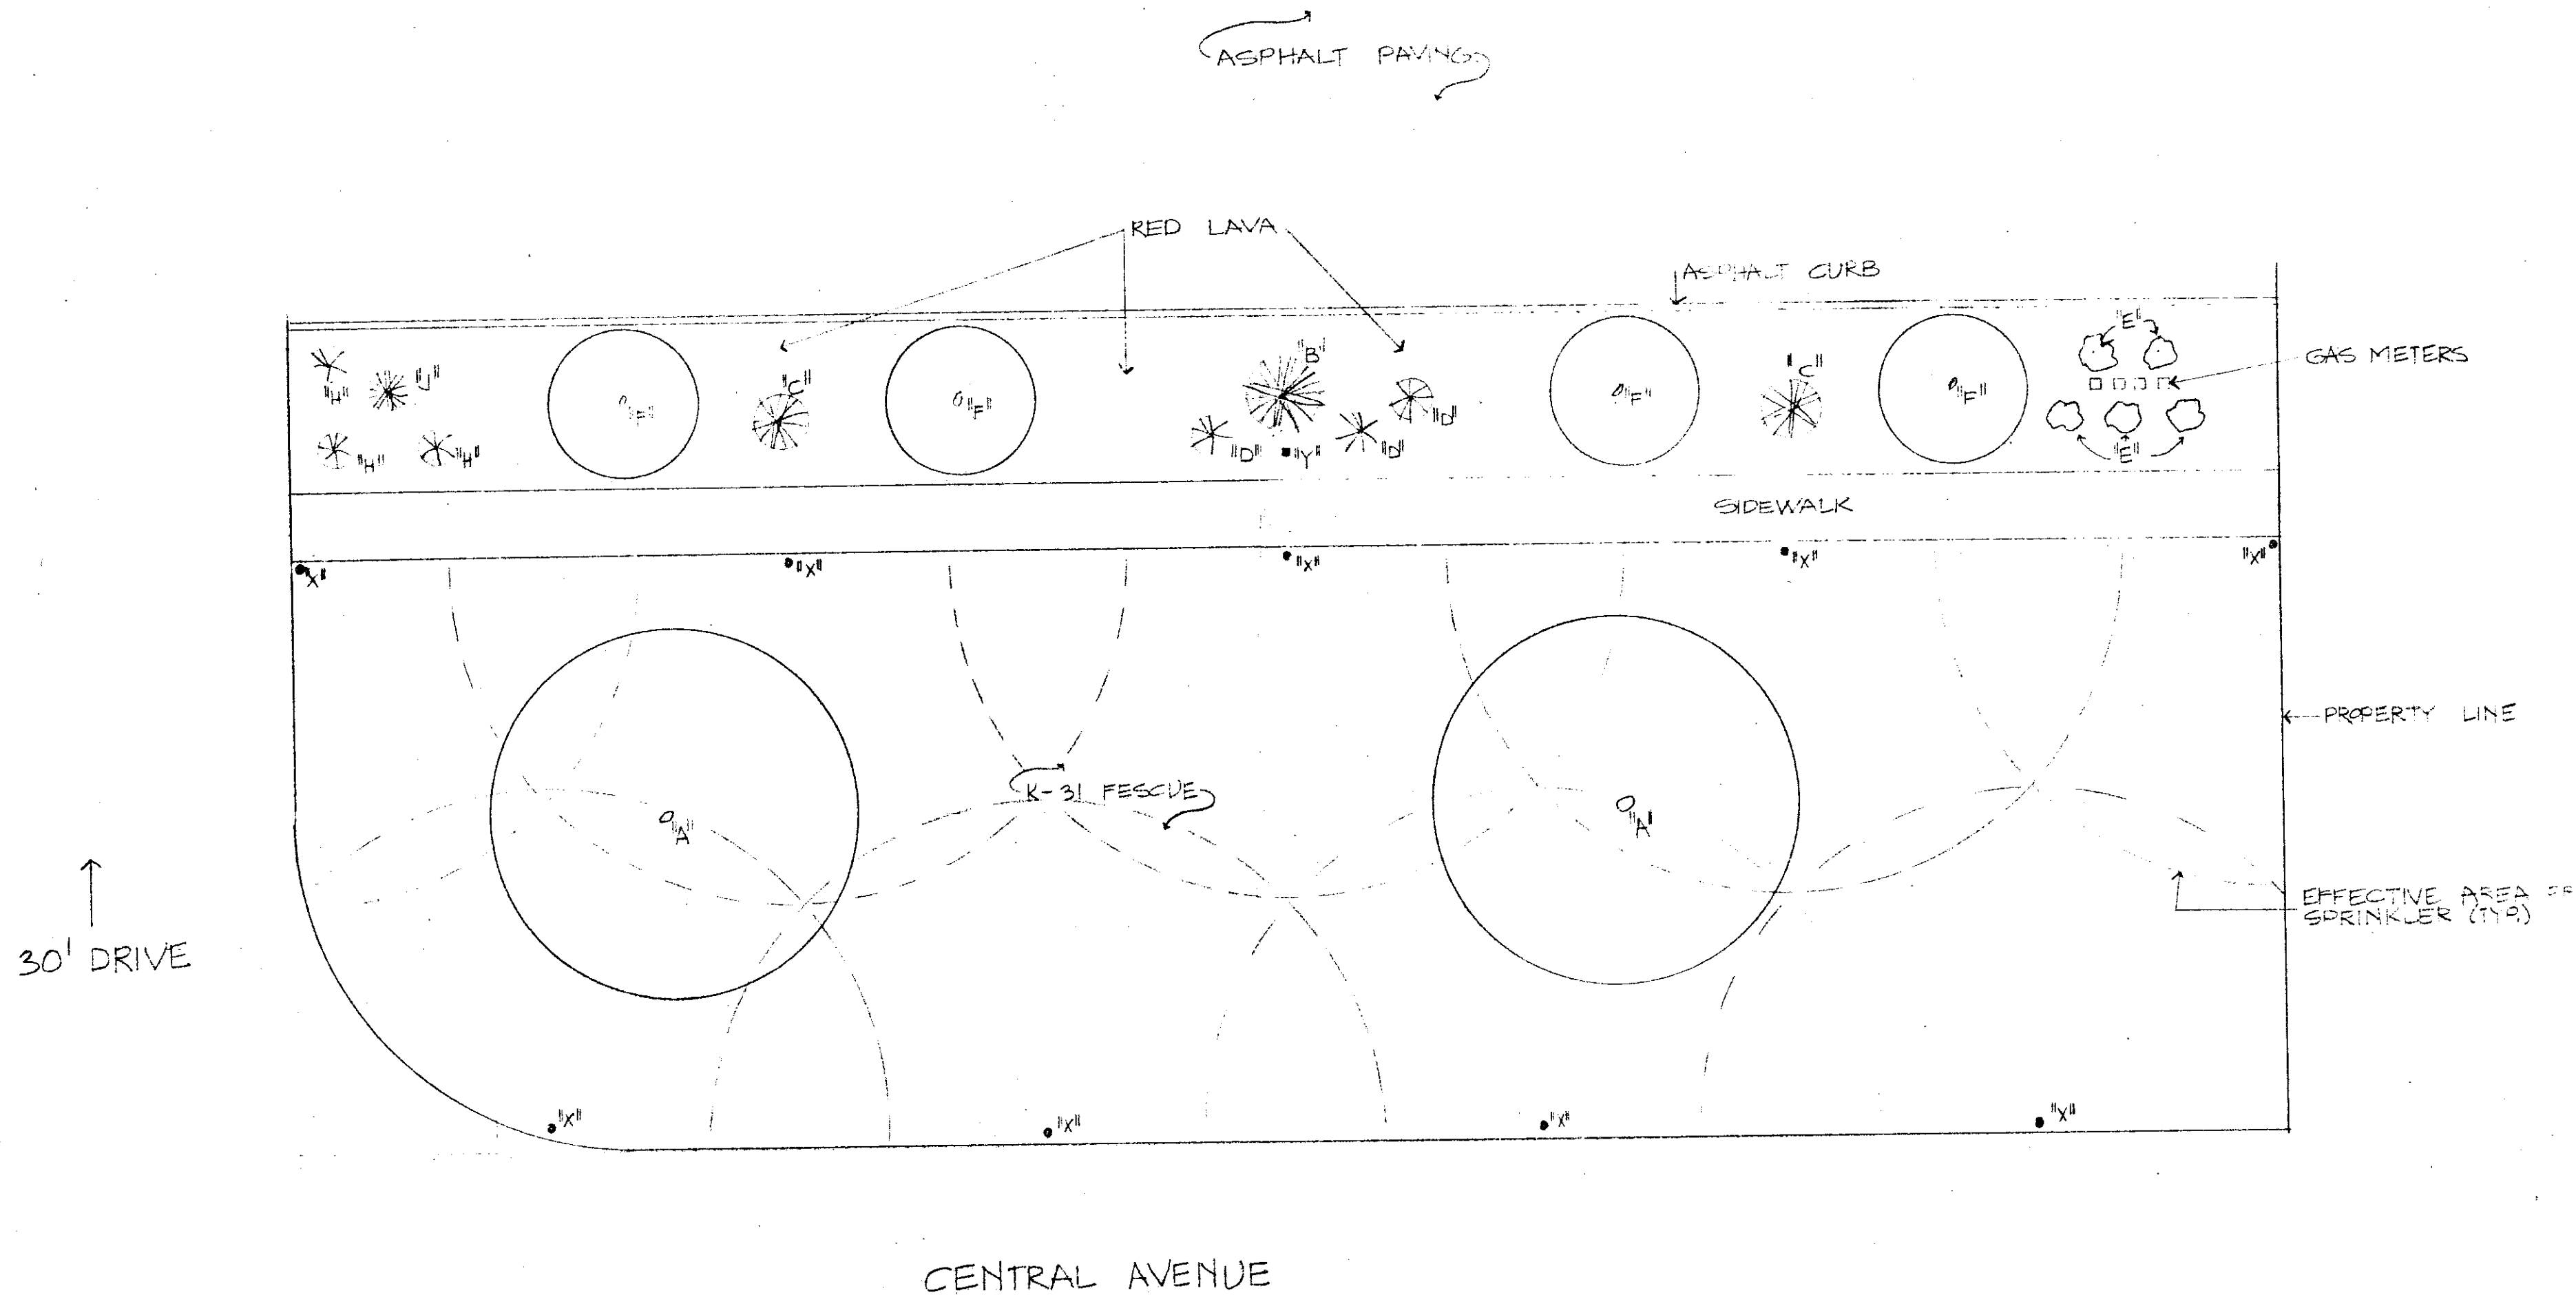

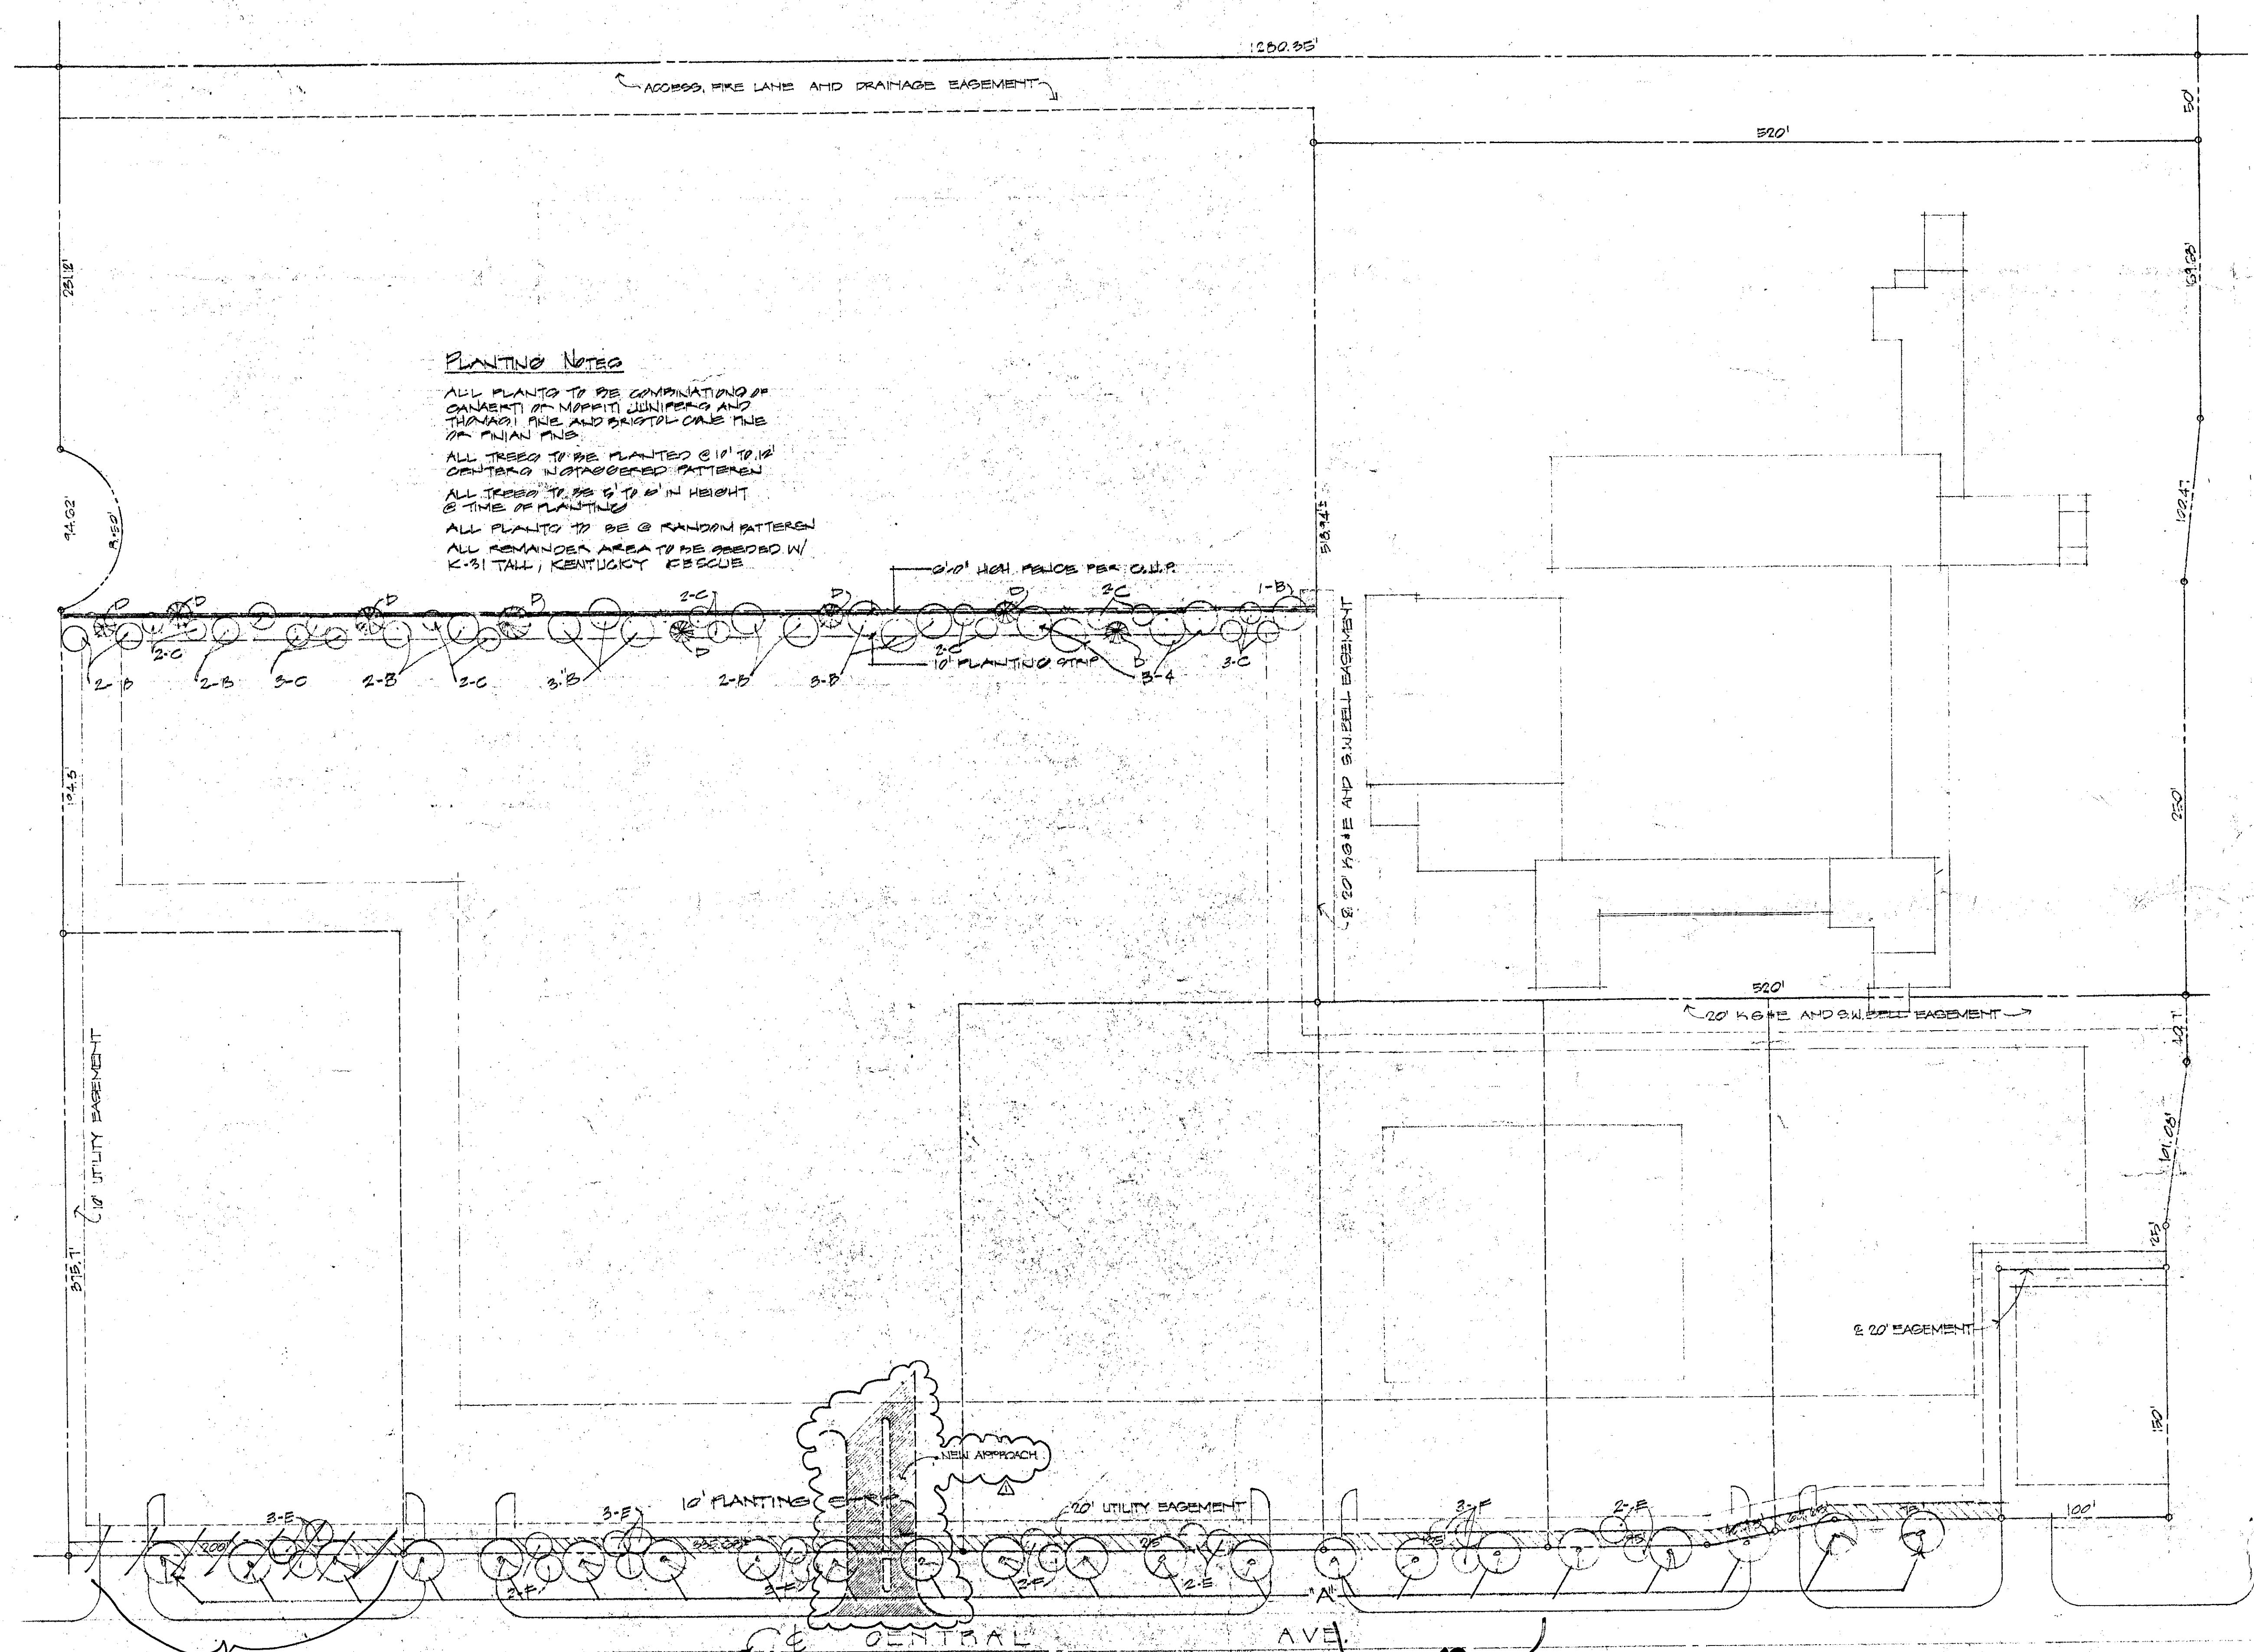

PLANTING NOTES
 ALL PLANTS TO BE COMBINATIONS OF
 CANEART JUNIPER, THORNLESS HONEY LOCUST,
 THORNLESS HONEY LOCUST, AND BISTOL CANE FINE
 OR PLAIN FINE.
 ALL TREES TO BE PLANTED @ 10' TO 12'
 CENTERS IN RANDOM PATTERN.
 ALL TREES TO BE 5' TO 6' IN HEIGHT
 @ TIME OF PLANTING.
 ALL PLANTS TO BE @ RANDOM PATTERN.
 ALL REMAINING AREA TO BE COVERED W/
 K-31 TALL, KENTUCKY BLUEGRASS.

SUPERCEDED
 SEE REVISED
 PLAN DATED
 3/27/81

PLANTING LIST

CODE	PLANT NAME	QUANTITY	METH. PTD.	REMARKS
A	PIN OAK	20	EXIST. 14-20HT	
B	THORNLESS HONEY LOCUST	20	BB 40'x40'	
C	CANEART JUNIPER	10	BB 14'x14'	
D	HONEY LOCUST, GOLDEN RAIN, MARLBOROUGH ONE 8+	10	EXIST 6-12HT	NATURE MATERIALS ON SITE TO BE MOVED AS POSSIBLE
E	GOLDEN RAIN TREES	10	BB 14'x14'	
F	THORNLESS HONEY LOCUST	3	BB 14'x14'	

LANDSCAPE PLAN
 AMENDED FOR LOT 4
 SEE PLAN AND LETTER
 IN 14-23-79

LANDSCAPE PLAN
 AMENDED FOR LOT 4
 SEE PLAN AND LETTER
 IN 14-23-79



LANDSCAPE PLAN

APPROVED IN ACCORDANCE WITH
 GENERAL PROVISION No. 12
 OF DP-45 (C-K-M CUP)
 JAMES H. SILLWOLD 8-24-76
 DATE

prints issued

revisions

parker krebiel associates
 architects
 (316) 233 6251
 10211 east waterman
 wichita, Kansas 67211

drawn

checked

approved by

drawn

checked

approved by

A COMMERCIAL DEVELOPMENT
 CENTRAL & WOODLAWN
 WICHITA KANSAS

sheet title
 LANDSCAPE PLAN
 SITE PERIMETER

sheet number
 1
 of 2 sheets



Wichita-Sedgwick County Metropolitan Area Planning Department

July 28, 2015

Robert W. Kaplan, Agent
301 N. Main, Ste. 1600
Wichita, KS 67202

REVISED

RE: CUP2015-17 – City CUP Administrative Adjustment to DP-45 to allow increase in sign area in CUP DP-45; generally located at the northwest corner of East Central and North Woodlawn.

Dear Applicants:

We received and reviewed your request for an Administrative Adjustment to DP-45, the C-K-M Community Unit Plan (“CUP”). We understand that you wish to increase the square footage of shopping center identification sign on East Central by 48 square feet.

On the basis of our review, we find that adjusting the CUP in the manner stated in the above paragraph is consistent with the approved CUP and will not have an adverse effect on the CUP or adjacent properties, nor will it be a substantial deviation of the original plan.

Our signatures below indicate that the CUP shall be adjusted as stated in this letter. This CUP adjustment shall not be deemed to alter any other provisions of the CUP except as expressly stated herein. This approval is subject to the following conditions:

1. All signs shall be permitted and installed within one year.
2. The Administrative Adjustment applies only to the sign located at the major entrance on East Central located between 6100 and 6160 East Central.

The “Development Application” sign should now be removed from the property. Please submit four (4) copies of the revised CUP drawing within 60 days in order for this adjustment to be considered final.

W. David Barber, Interim Director
Metropolitan Area Planning Department

Thomas J. Stolz, Director
Metropolitan Area Building and Construction
Department

cc: J.R. Cox, MABCD
Lavonta Williams, CM District I
Janet Johnson, Community Liaison District I



Wichita-Sedgwick County Metropolitan Area Planning Department

October 28, 2014

C-K-M-C&W
555 N. Woodlawn
Wichita, KS 67208

Ferris Consulting
Attn: Greg Ferris
PO Box 573
Wichita, KS 67201

RE:CUP2014-27- Amendment to Community Unit Plan (CUP) DP-45 Parcel 5 to permit a night club in the city (a rental event center with alcohol service and dancing) at 6160 East Central (north of East Central, West of Woodlawn).

Dear Applicants:

At its regular meeting on **October 9, 2014**, the Wichita-Sedgwick County Metropolitan Area Planning Commission (MAPC) considered the above captioned request. The action of the MAPC was to **APPROVE** the request subject to the following conditions:

- (1) No outdoor speakers, entertainment, food or drink service is permitted.
- (2) The site shall maintain all necessary licenses for a nightclub in the city.
- (3) The site shall conform to all applicable codes and regulations in include but not limited to zoning, building, fire and health.
- (4) The proposed uses for Parcel 5 shall be amended to add: "Nightclub in the City except that the nightclub will be open only for reserved special events and will not be open to the general public more than six days per year."
- (5) The facility shall close no later than 2 a.m.
- (6) The applicant shall submit four revised copies of the CUP to the Metropolitan Area Planning Department within 60 days of approval or the request shall be considered denied and closed.
- (7) If the Zoning Administrator finds that there is a violation of any of the conditions of the CUP amendment, the Zoning Administrator, in addition to enforcing the other remedies set forth in the Unified Zoning Code, may, with the concurrence of the Planning Director, declare the CUP amendment null and void.

This is a reminder that the zoning notification signs should now be removed from the property. If you have any questions concerning this application, please contact our office at 268-4421.

City Hall • 10th Floor • 455 North Main • Wichita, Kansas 67202-1688

T 316.268.4421 **F** 316.268.4390

www.wichita.gov



Current Plans Manager

Current Plans Division

Copies to: Lavonta Williams, WCC CM I

Alana Haynes, NA I

JR Cox, MABCD

Tom Stolz, MABCD

Paul Hays, MABCD

Ruth Yarnall, 6405 E. Elm 67206

Jacob Ruse 1310 N, Dunsworth, Wichita, KS 67212

Skyler Wanless, 8015 W. 12th St., Wichita, KS 67212

Dave Brown, 428 N. Edgemoor, Wichita,