



**Wichita-Sedgwick County Metropolitan Area Planning Department**

April 21, 2011

Steve Kelly Homes, Inc.  
Attn: Stephen Kelly  
633 N. Kessler  
Wichita, KS 67203

Larry Coleman  
17515 W. MacArthur Rd.  
Wichita, KS 67052

**Re: BZA2011-00018: Administrative Adjustment to allow a detached accessory structure to be placed in front of the primary structure on less than five acres in SF-5 Single-family Residential ("SF-5") zoning.**

**Legal Description: Lots 5 and 6; Block D, Callahan Addition, Wichita, Sedgwick County, Kansas; generally located west of the intersection of Tyler Rd. and Maple St., on the south side of Maple St.**

Dear Applicants:

We have reviewed your request for a Zoning Adjustment to permit an accessory structure in front of the principal structure on less than five acres. From reviewing your application, we understand that you propose to construct a detached garage on a 0.46-acre lot. According to the Unified Zoning Code Article III, Section E.1.e.6, the front setback (front of the property) shall be provided along the shorter street frontage. We understand that you propose to construct the accessory structure between the primary dwelling and West Maple Street, on a corner lot with the shorter frontage along West Maple Street. Therefore, you have requested a Zoning Adjustment to permit an accessory structure to be placed in front of the principal structure.

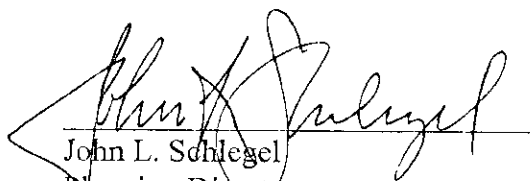
Sec. V-I.2.n of the Unified Zoning Code allows a Zoning Adjustment that would permit an accessory structure to be placed in front of the principal structure on less than five acres of land, when the conditions required by Sec. V-I.6 of the Code are met. We find that permitting an accessory structure in front of the principal structure on your property meets the four conditions required by Sec. V-I.6 of the Unified Zoning Code as set out below:

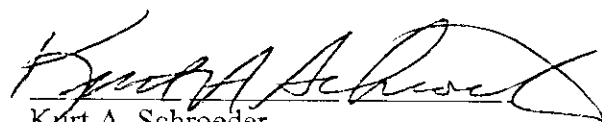
- 1) Impact on safety and convenience of vehicular and pedestrian circulation: This request is for a detached garage on a private lot. Public vehicular and pedestrian circulation will not be affected as the garage will provide sufficient space for parking vehicles on the property and will not interfere with traffic circulation patterns.
- 2) Impact on existing uses in surrounding areas: There should be no negative impact on the existing uses in surrounding areas as a result of the garage being placed in front of the house, as the structure will be set back 32-feet from Maple Street and 40-feet from Herschel Street.
- 3) Compatibility with existing or permitted uses on abutting sites: Placing an accessory structure in front of a principal structure is within allowable adjustments and should not detract from the existing or permitted uses on abutting sites, which primarily are single family residences.
- 4) Effect on public health, safety or welfare: There will be no encroachment into public utility easements or right-of-way; therefore, there should be no negative impact on the public health, safety or welfare, nor will properties or improvements in the vicinity be materially injured.

Our signatures below indicate that a Zoning Adjustment to permit an accessory structure to be placed in front of the principal structure on less than five acres of land for the aforementioned property is hereby GRANTED, subject to the following conditions:

- 1) The site shall be developed in general conformance with the approved site plan, and all permits necessary to construct the improvements shall be acquired.
- 2) The permitting of an accessory structure in front of the principal structure shall apply only to the proposed garage illustrated on the approved site plan. All other structures or additions on the subject property shall conform to the development standards of the Unified Zoning Code unless a separate Zoning Adjustment or Variance is granted.
- 3) If the Zoning Administrator finds that there is a violation of any of the conditions of the Zoning Adjustment, the Zoning Administrator, in addition to enforcing the other remedies set forth in the Unified Zoning Code, may, with the concurrence of the Planning Director, declare that the Zoning Adjustment is null and void.

The "Development Application" sign should now be removed from the property.

  
John L. Schlegel  
Planning Director

  
Kurt A. Schroeder  
Superintendent of Central Inspection

cc: Kurt Schroeder, Office of Central Inspection  
J.R. Cox, Office of Central Inspection  
Paul Hays, Office of Central Inspection  
JEFF LONGWELL, CM DISTRICT V

Steve Kelley  
Homes, Inc.  
633 N. Kessler  
Wichita, KS 67203  
316-393-5254

Lot 5, 6 BIK D.  
Callahan Add.

Customer: Don + Pat Coleman

1/16" = 1' W E N S

**APPROVED**

BZA2011-00018

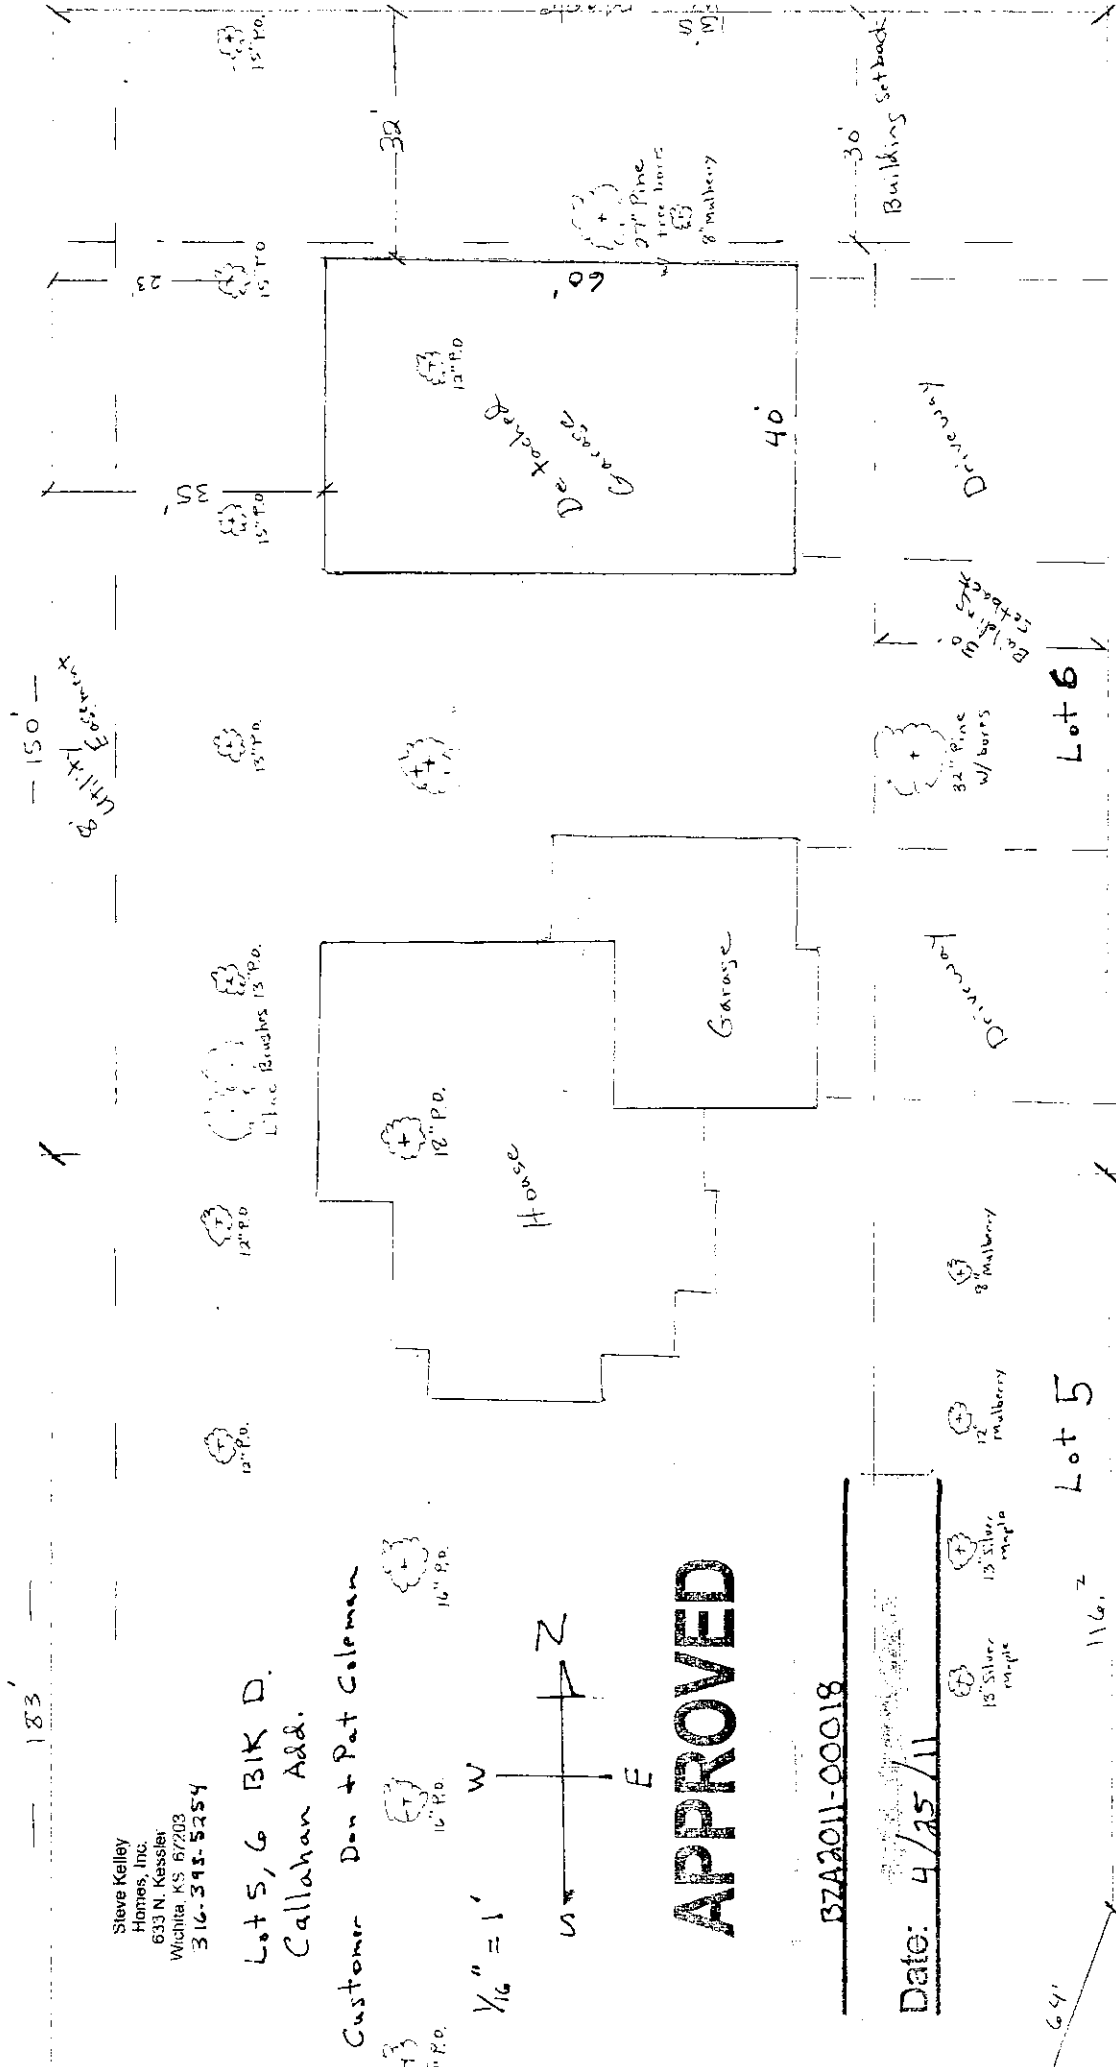
Date: 4/25/11

15' Silver maple  
12' Mulberry  
8' Mulberry

Lot 5

64'

116.2'



Herschel Street