


- 3) Compatibility with existing or permitted uses on abutting sites: The single-family residence is compatible with abutting sites, which also are developing with single-family residences. The encroachment into the side setback should not reduce compatibility with abutting sites.
- 4) Effect on public health, safety or welfare: There will be no encroachment into public utility easements or right-of-way; therefore, there should not be a negative impact on the public health, safety or welfare nor will properties or improvements in the vicinity be materially injured.


Our signatures below indicate that an Administrative Adjustment to reduce the side setback on the north from 6' to 5'5" for the aforementioned property is hereby granted, subject to the following conditions:

- 1) The site shall be developed in general conformance with the approved site plan.
- 2) The setback reduction shall apply only to the side yard setback encroachment illustrated on the approved site plan. All other structures or additions on the subject property shall conform to the setbacks permitted by the Unified Zoning Code unless a separate Zoning Adjustment or Variance is granted.
- 3) If the Zoning Administrator finds that there is a violation of any of the conditions of the Zoning Adjustment, the Zoning Administrator, in addition to enforcing the other remedies set forth in the Unified Zoning Code, may, with the concurrence of the Planning Director, declare that the Zoning Adjustment is null and void.

The "Development Application" sign should now be removed from the property.

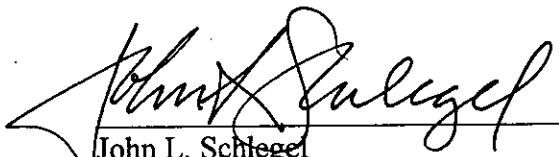

John L. Schlegel
Planning Director

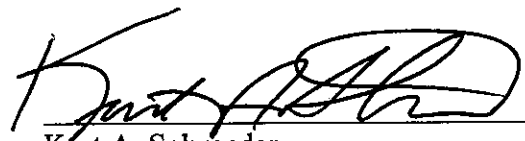

Kurt A. Schroeder
Superintendent of Central Inspection

Enclosure

cc: Kurt Schroeder, Office of Central Inspection
Paul Hays, Office of Central Inspection
Randy Sparkman, Office of Central Inspection
Herb Shaner, Office of Central Inspection



Wichita-Sedgwick County Metropolitan Area Planning Department

April 1, 2005

Sharon Zenner
Don Klausmeyer Construction
10008 W. York
Wichita, KS 67215

Re: BZA2005-00014: Administrative Adjustment to reduce the side setback on the north from 6' to 5'-5".

Legal Description: Lot 35, Block C, Copper Gate Estates Addition, Wichita, Sedgwick County, Kansas. Generally located south of 13th Street North and west of 135th Street West (13621 W. Ponderosa Ct.).

Dear Ms. Zenner:

We have reviewed your request for an Administrative Adjustment to reduce a side setback on the aforementioned property. From reviewing your application, we understand that a single family residence is under construction on the property and that the structure encroaches into the side setback on the north by seven inches. From reviewing the site plan submitted with your application, we understand that the encroachment into the setback is for the northwest corner of the structure rather than an entire building wall.

Sec. V-I.2.a. of the Unified Zoning Code allows an adjustment to reduce setbacks by up to 20 percent when the conditions required by Sec. V-I.6. of the Code are met. We find that the reduction of the setback as proposed meets the four conditions required by Section V-1.6. of the Unified Zoning Code as set out below:

- 1) Impact on safety and convenience of vehicular and pedestrian circulation: The proposed encroachment should have no impact on the safety and convenience of vehicular and pedestrian circulation in the vicinity because the side yard does not provide vehicular access and sufficient space remains for pedestrian access.
- 2) Impact on existing uses in surrounding areas: There should be no negative impact on the existing uses in surrounding areas as a result of the reduction of the setback, as sufficient separation between buildings is maintained and the encroachment into the setback is minor and involves only the corner of the structure rather than an entire building wall.



City Hall • 10th Floor • 455 North Main • Wichita, Kansas 67202-1688

T 316.268.4421 F 316.268.4390

www.wichita.gov

DON KLAUSMEYER CONST. L.L.C.

LOT 35, BLK. C
COPPER GATE ESTATES ADD'N.
13621 W. PONDEROSA CT.

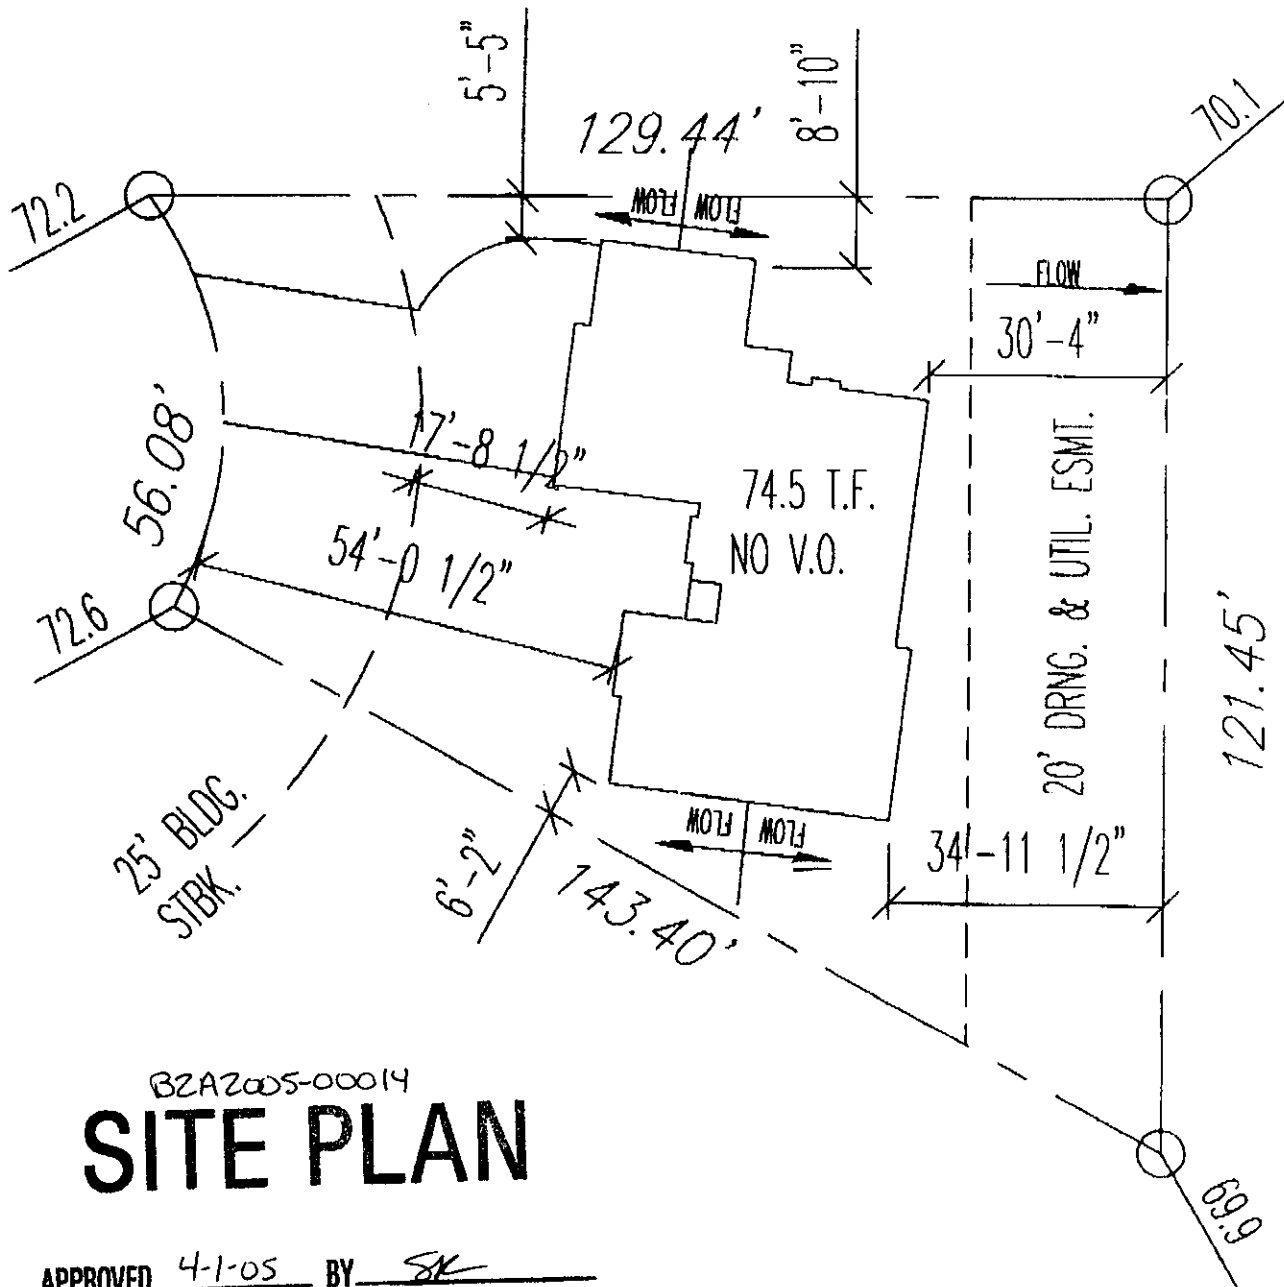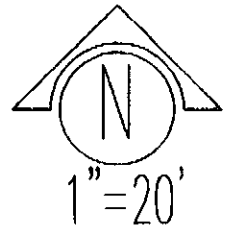

B2A2005-00014

SITE PLAN

APPROVED 4-1-05 BY SK

REVISED: 3-23-05