


1941
FOUNTAIN ~ SL GILBERT TO N.L. MORRIS
30' CONC.

From Sta 2+0 to 6+0
set grade with
plane table
P.H.

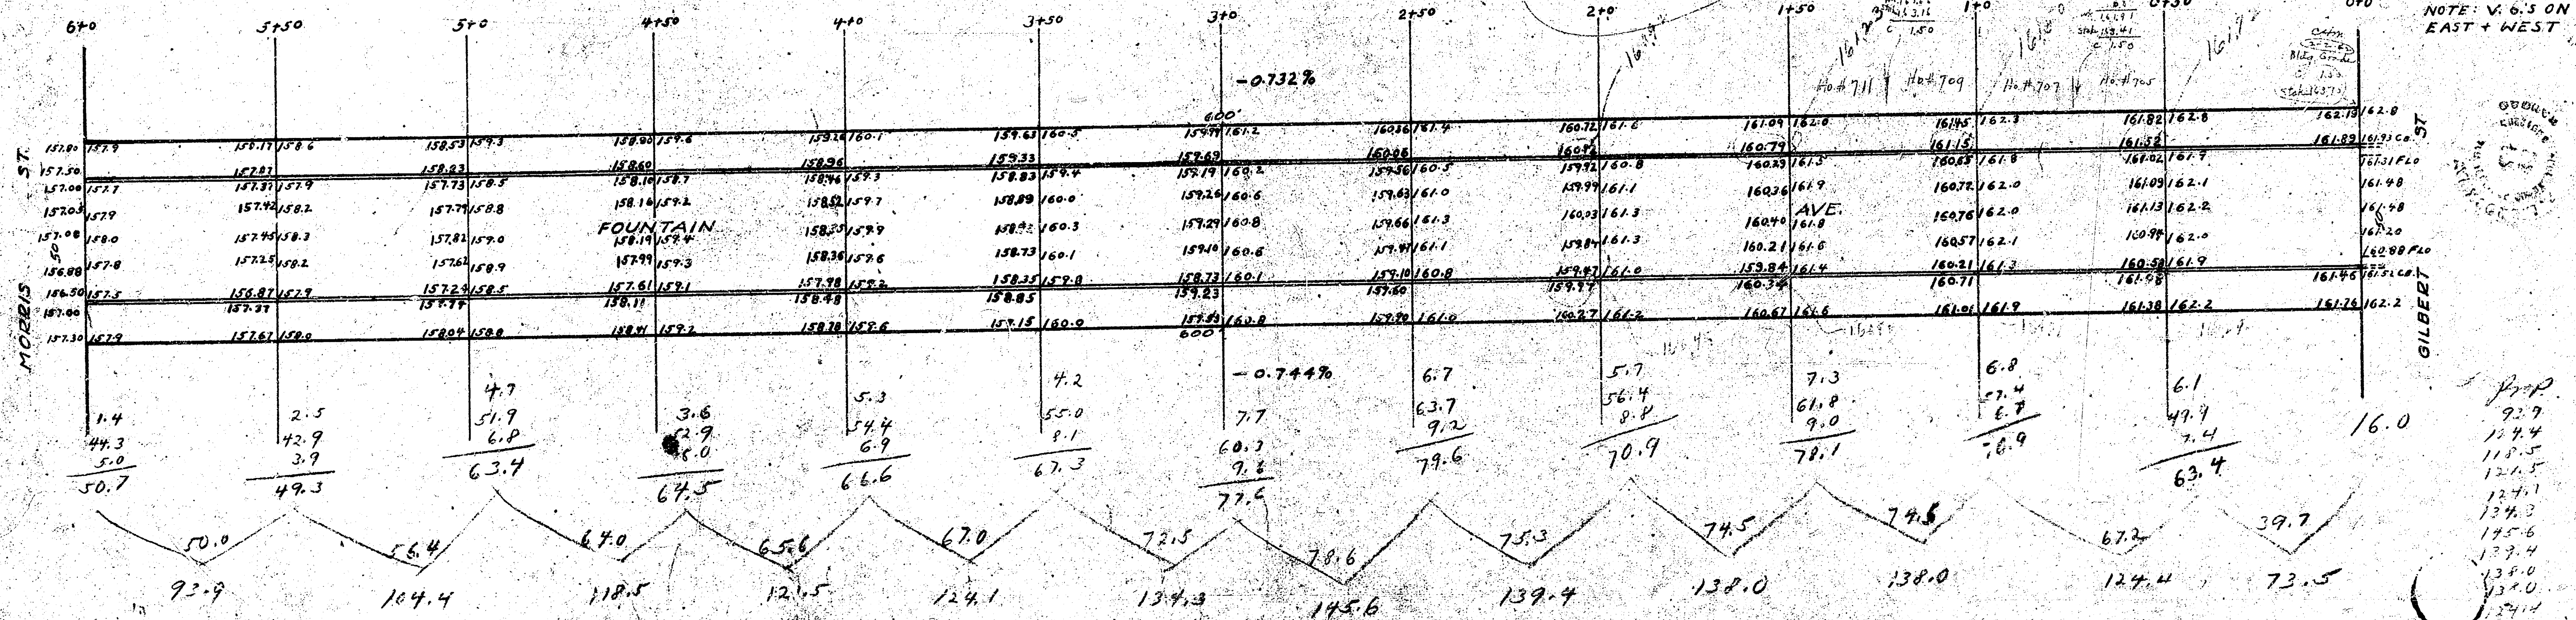

B.M. 16152 END OF EAST CB SE FOUNTAIN + GILBERT

Exp. J. S. L.