


26-2-30 Cond.

PM. 104.17 "U" in Hatched
S. E. Cor. Luce, Madison
& Gilbert

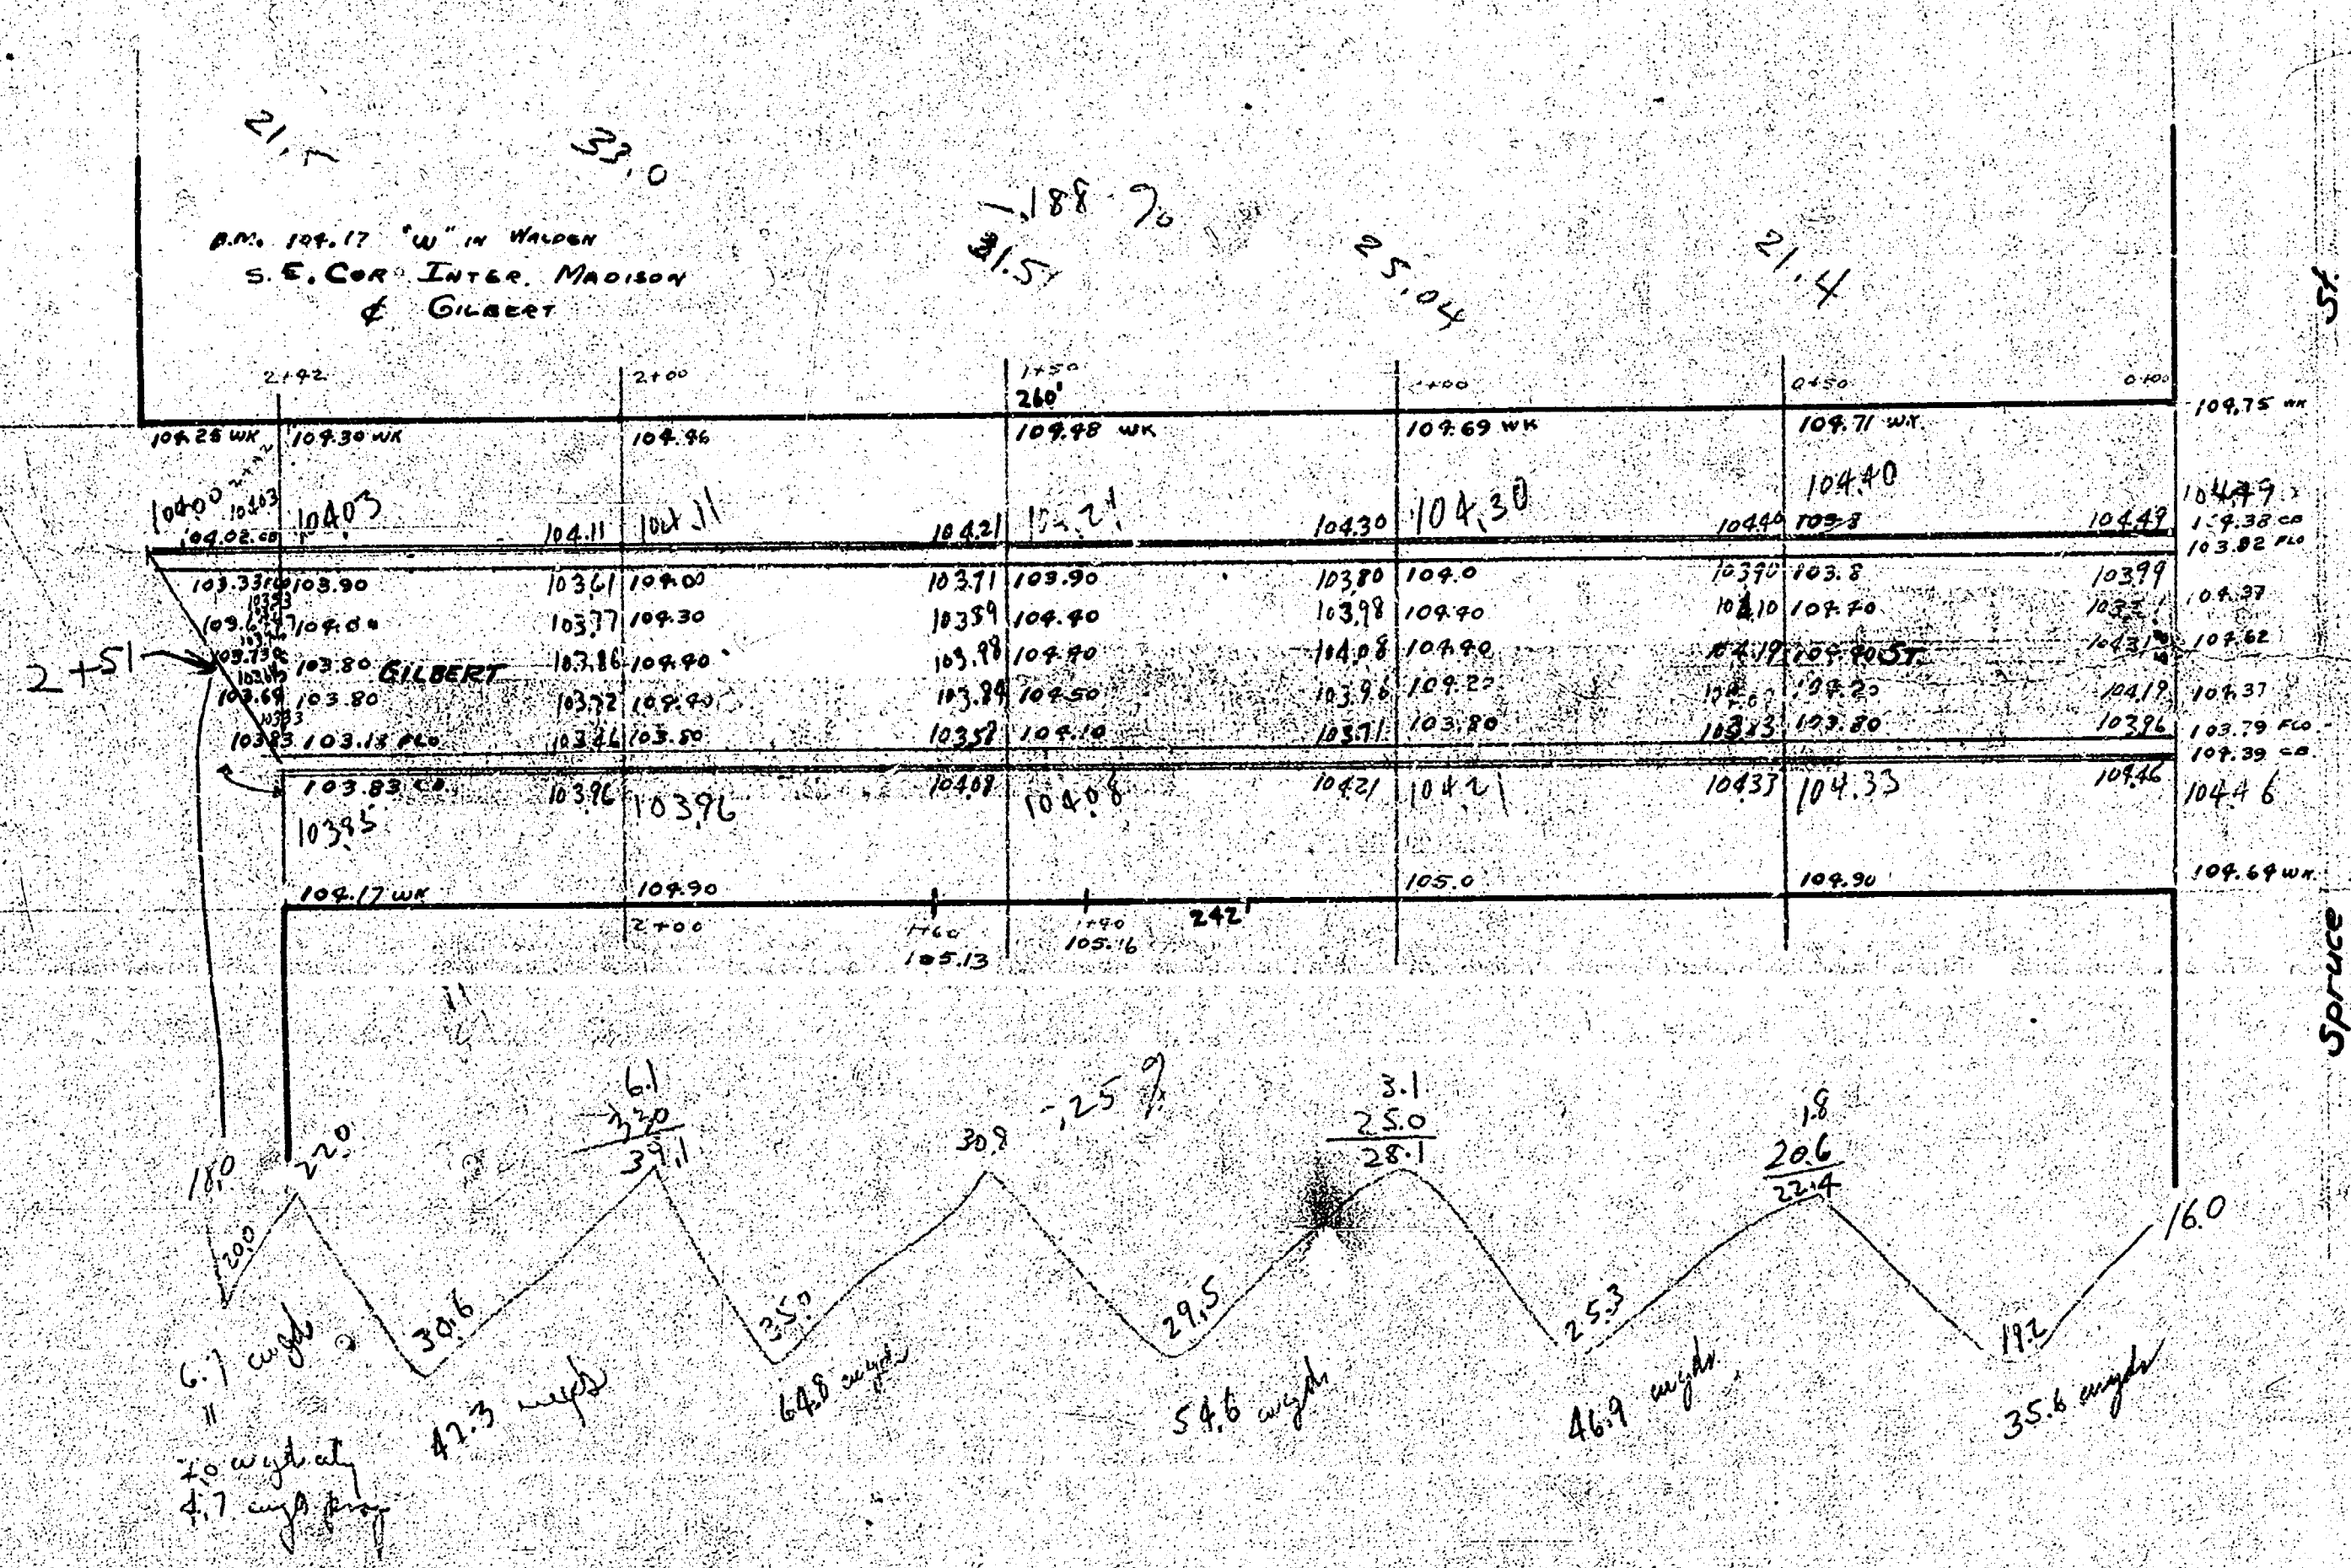

$$Avg = 253.9 + 254 = 279.3 \text{ cuple}$$

$$Ck = 20 + 02 = 22$$

$$281.5$$

Survey Plan
1935
Gilbert St.
H. Madison
to
W. Spruce