


1942
ORME ST. - E.L. CRESTWAY TO W.L. OLIVER
26-2-30 S.A.B.B.

NOTE: THE INDICATED MEASUREMENTS OF THE DROP
IN THE SOUTH SIDE ARE GREATER THAN THE PLATED
DISTANCES. A SURPLUS OF 3.6' WAS PROVED
TO THE SOUTH SIDE FROM CRESTWAY TO OLIVER

NOTE: FOR CALCULATING EXCAVATION
0.2 FT. WAS ADDED TO ALL DIRT READINGS.

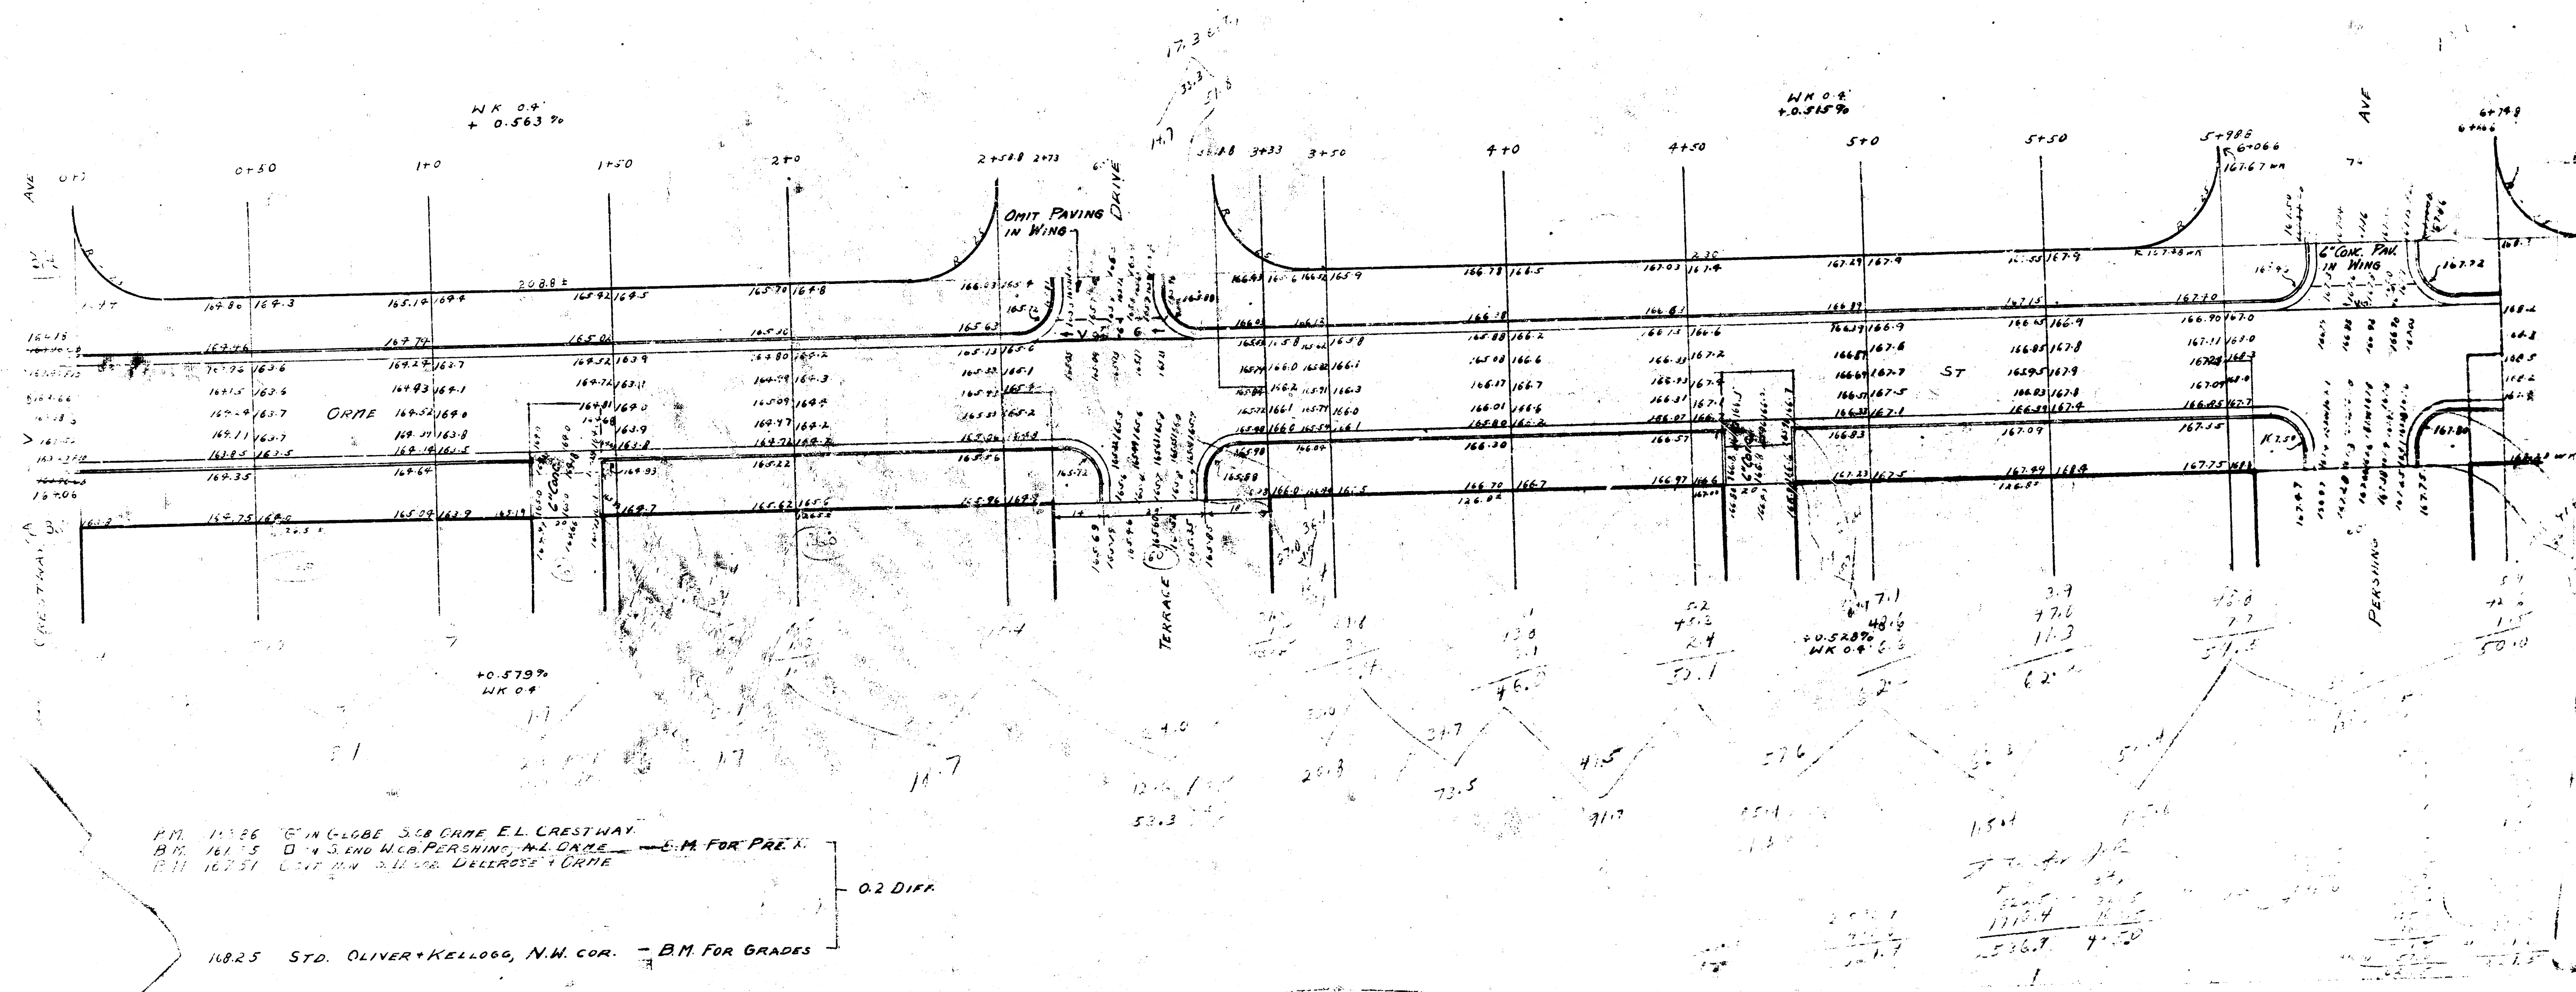

NOTE. FRONT OF WALSH S.S. CRME
FERRISING TO DELLROSE IS ON P.L.
JEFFERSON SCHOOL.