




146.25
 B.M. 127.34 SE. cor. sec. 25th & Grove - This BM reset
 B.M. 127.34 SE. cor. sec. 25th & N. Platt
 (B.M. 127.34 is 0.15 higher than old C. Grove 127.19)
 Put grades reset from new cb. elevations taken in
 the field after put was constructed

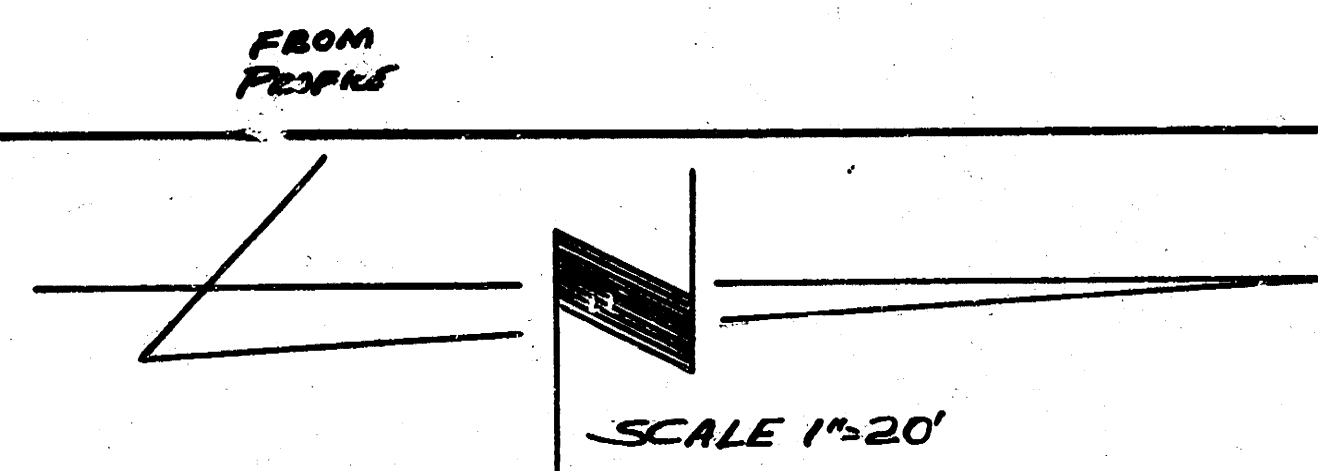


PROPERTY
 113.0
 118.7
 106.5
 100.6
 106.5
 132.0
 159.0
 158.3
 133.0
 141.1
 140.1
 121.0
 1598.6
 159.8
 +10.90
 1758.5 CUYDAS EXC

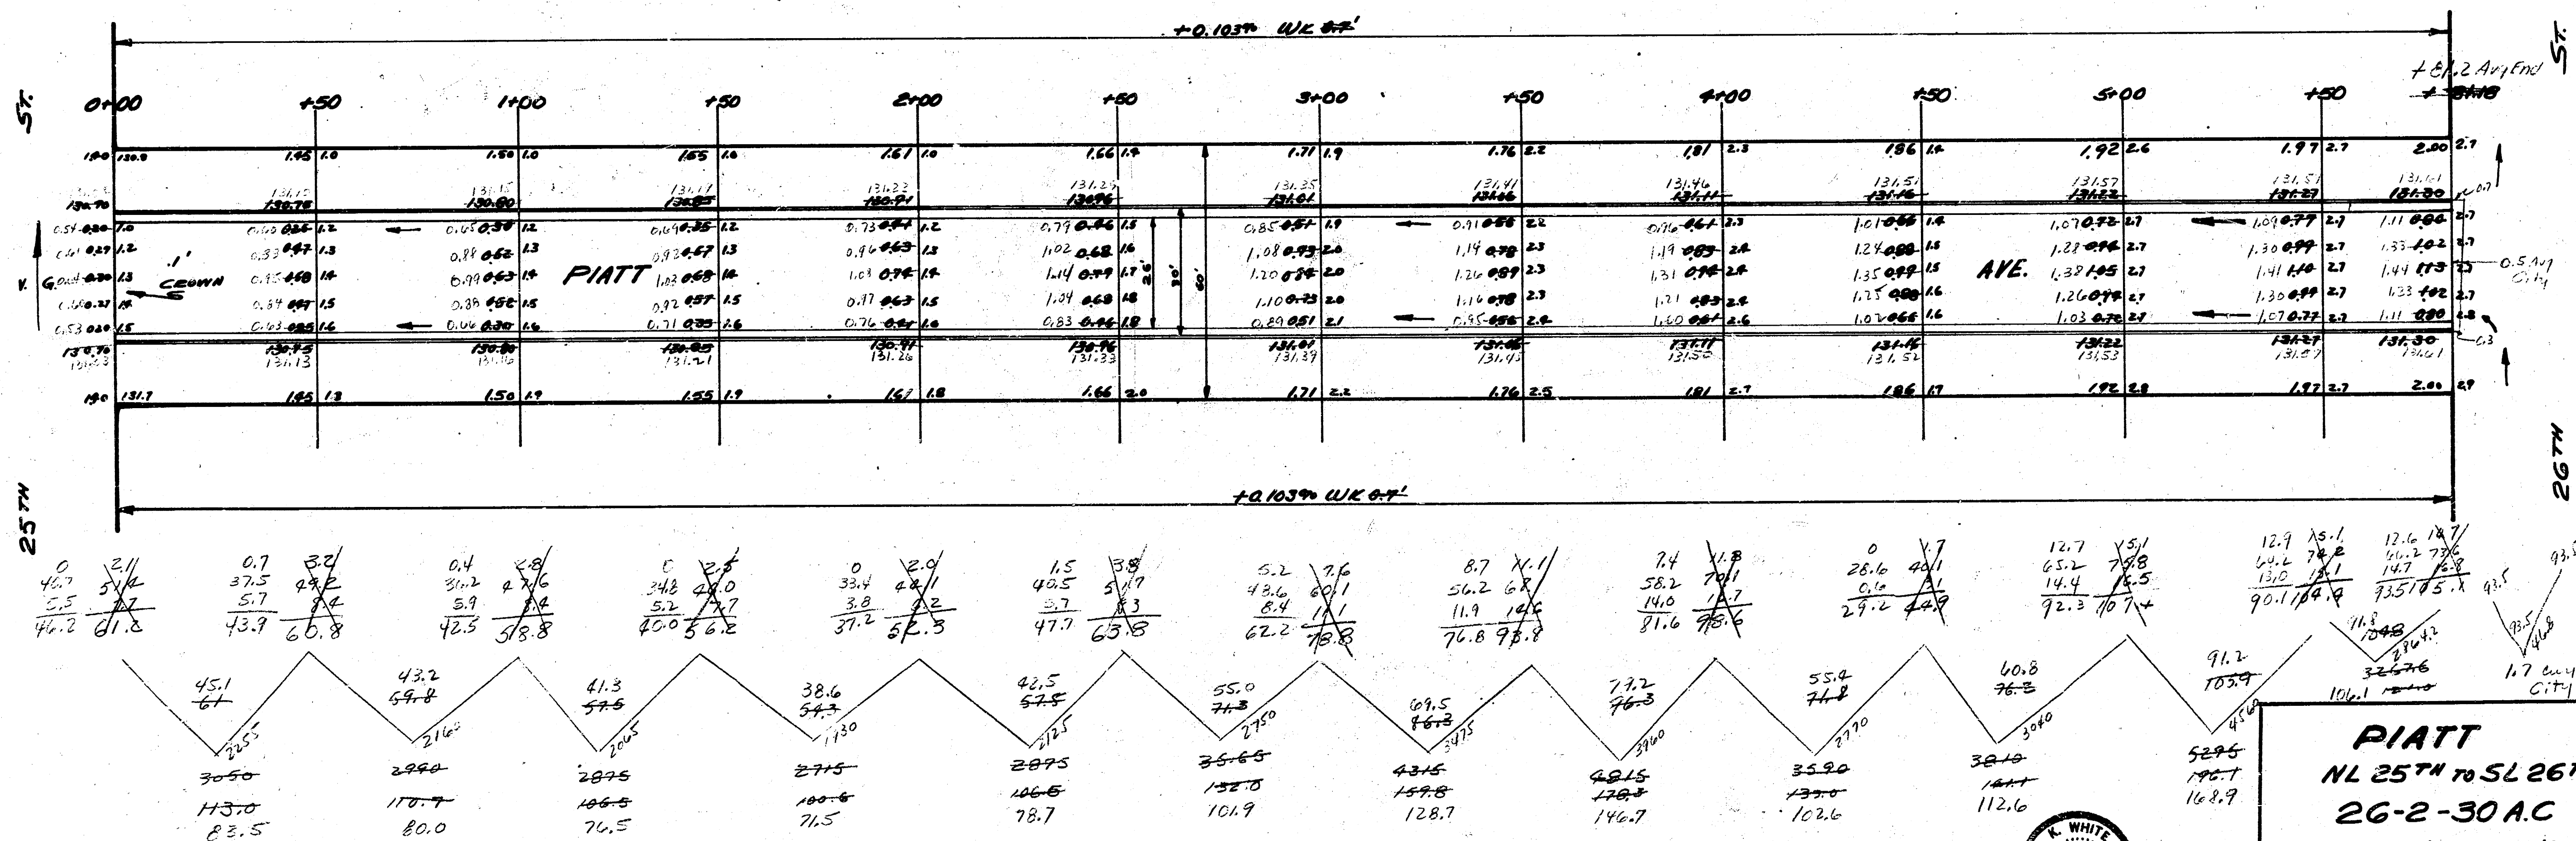


PIATT
 NL 25TH TO SL 26TH
 26-2-30 A.C.
 CITY OF WICHITA KANSAS
 LK WHITE CITY ENGINEER
 JUNE 12 1952 Prev. No. CH-395

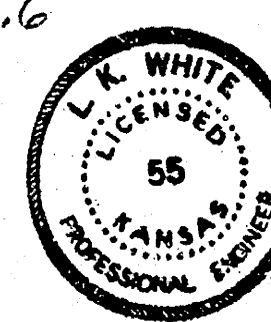

BM. 146.5 STANDARD SE COR 25TH & GENE
 ELEV. 146.5 - ELEV. step 44.3269 N. PIATT
 (ELEV. 4.15 higher than std. 3 Grove 125.15 (146.5))
 End elevations to be finished cut

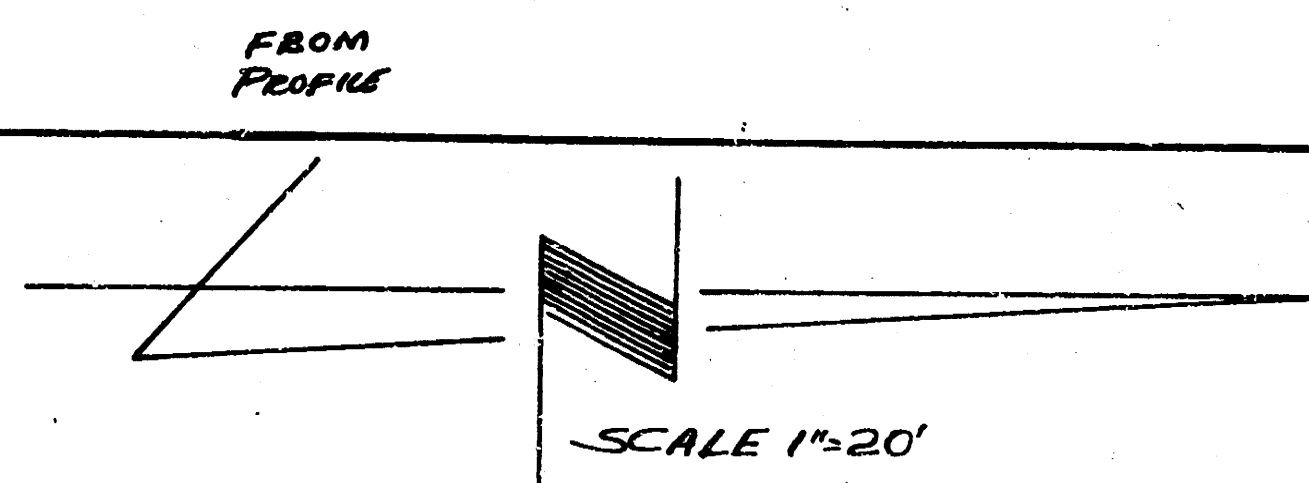

Bar. 129.38 2 E Cor. Conc. Step Hrs. 2469 N. PIATT

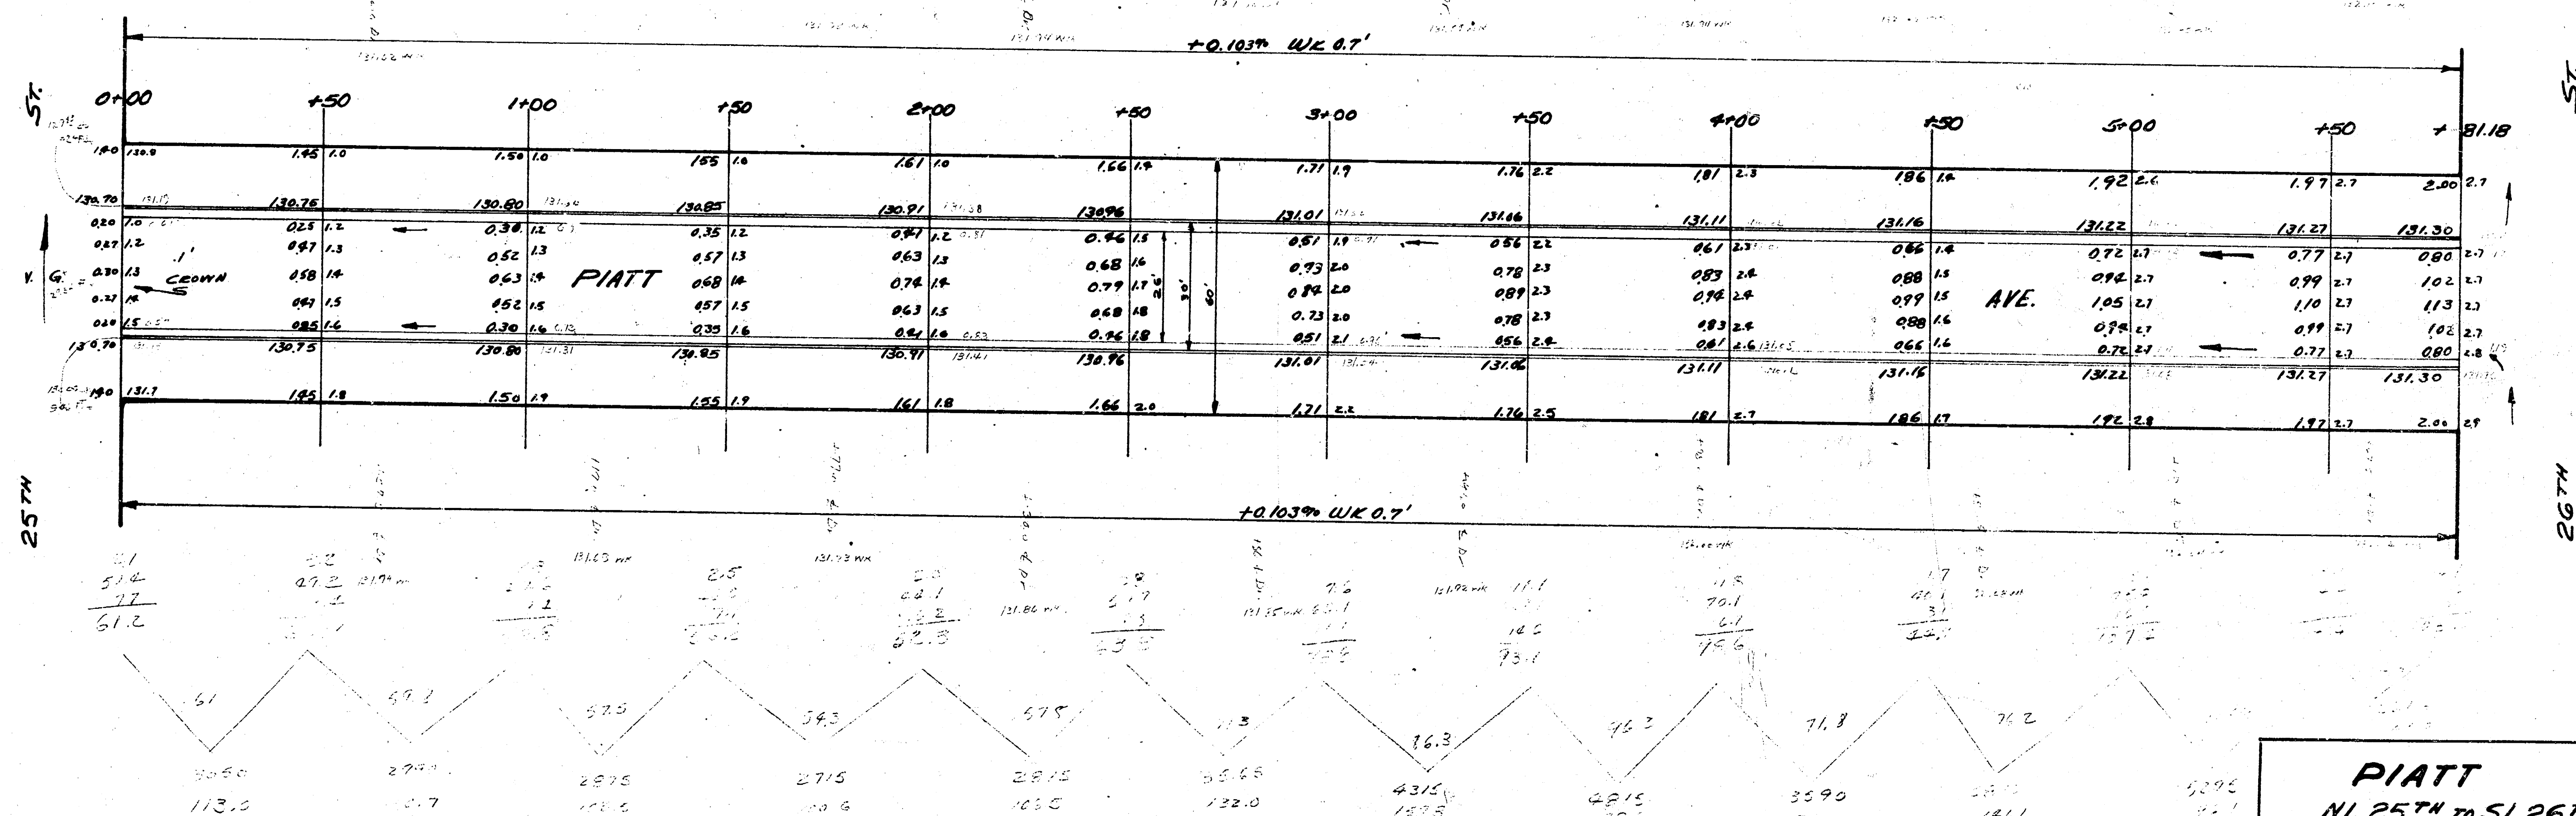

PIATT
 NL 25TH TO SL 26TH
 26-2-30 A.C
 CITY OF WICHITA KANSAS
 LK WHITE CITY ENGINEER
 JUNE 12 1952 Prov. No. C11-345



