

CITY OF WICHITA, KANSAS

STORM SEWER EXTENSION TO SERVE YELLOW FREIGHT ADDITION



PRIVATE PROJECT NO.: 408PPS (607861)

INDEX

SHEET 1 TITLE SHEET
SHEET 2-3 PLAN-PROFILE SHEETS

GENERAL NOTES

1. CONTRACTOR WILL BE REQUIRED TO PROVIDE A MINIMUM ADVANCE NOTICE OF TWENTY-FOUR (24) HOURS TO UTILITY COMPANIES PRIOR TO STARTING ANY EXCAVATION.
2. ALL WORK SHALL BE COMPLETED IN ACCORDANCE WITH CITY OF WICHITA, KANSAS STANDARD SPECIFICATIONS.
3. EXISTING UTILITIES AND THEIR LOCATIONS, AS SHOWN ON THE PLANS, REPRESENT THE BEST INFORMATION OBTAINABLE FOR DESIGN. LOCATION INFORMATION HAS BEEN OBTAINED FROM THE VARIOUS UTILITY COMPANIES AND IS EITHER FROM COMPANY RECORD DRAWINGS OR COMPANY PROVIDED FIELD LOCATIONS. THE CONTRACTOR WILL BE REQUIRED TO WORK AROUND EXISTING UTILITIES WITHIN THE RIGHT-OF-WAY WHICH DO NOT CONFLICT WITH PROPOSED CONSTRUCTION.
4. RUBBLE FROM THE REMOVAL OF MISCELLANEOUS STRUCTURES AND EXCESS EXCAVATION WHICH IS TO BE WASTED SHALL BE DISPOSED OF ON SITES TO BE PROVIDED BY THE CONTRACTOR. THESE SITES SHALL BE APPROVED BY THE ENGINEER AS TO SUITABILITY, APPEARANCE AND SITE LOCATION. LOCATIONS THAT, IN THE OPINION OF THE ENGINEER, WILL LEAVE UNSIGHTLY APPEARANCE WILL NOT BE APPROVED.
5. THE CONTRACTOR SHALL BE RESPONSIBLE FOR PRESERVING PROPERTY IRONS. THE CONTRACTOR WILL BE REQUIRED TO RE-ESTABLISH ANY PROPERTY IRONS WHICH ARE DAMAGED OR DESTROYED BY HIS CONSTRUCTION OPERATIONS. SUCH IRONS SHALL BE RE-ESTABLISHED BY A LICENSED LAND SURVEYOR OR IN ACCORDANCE WITH STATE LAW.
6. GRASS AREAS DISTURBED BY CONSTRUCTION OR STORAGE OF MATERIALS SHALL BE REPLANTED EITHER BY SEEDING OR SODDING WITH THE SAME TYPE OF GRASS AS WAS EXISTING PRIOR TO WATER LINE CONSTRUCTION. SEE "SPECIAL PROVISIONS" IN THE STANDARD SPECIFICATION NO. 14533 FOR SEEDING AND SODDING OF COOL SEASON AND WARM SEASON GRASSES.
7. IT SHALL BE CONTRACTOR'S RESPONSIBILITY TO PROVIDE CONSTRUCTION STAKING AND INSPECTION SERVICES AS REQUIRED BY THE CITY OF WICHITA.

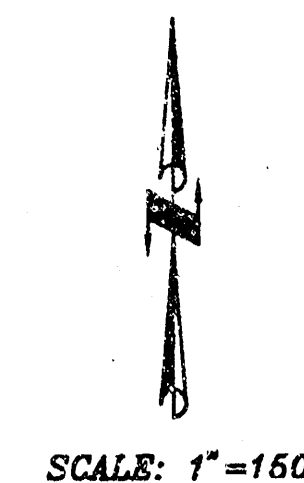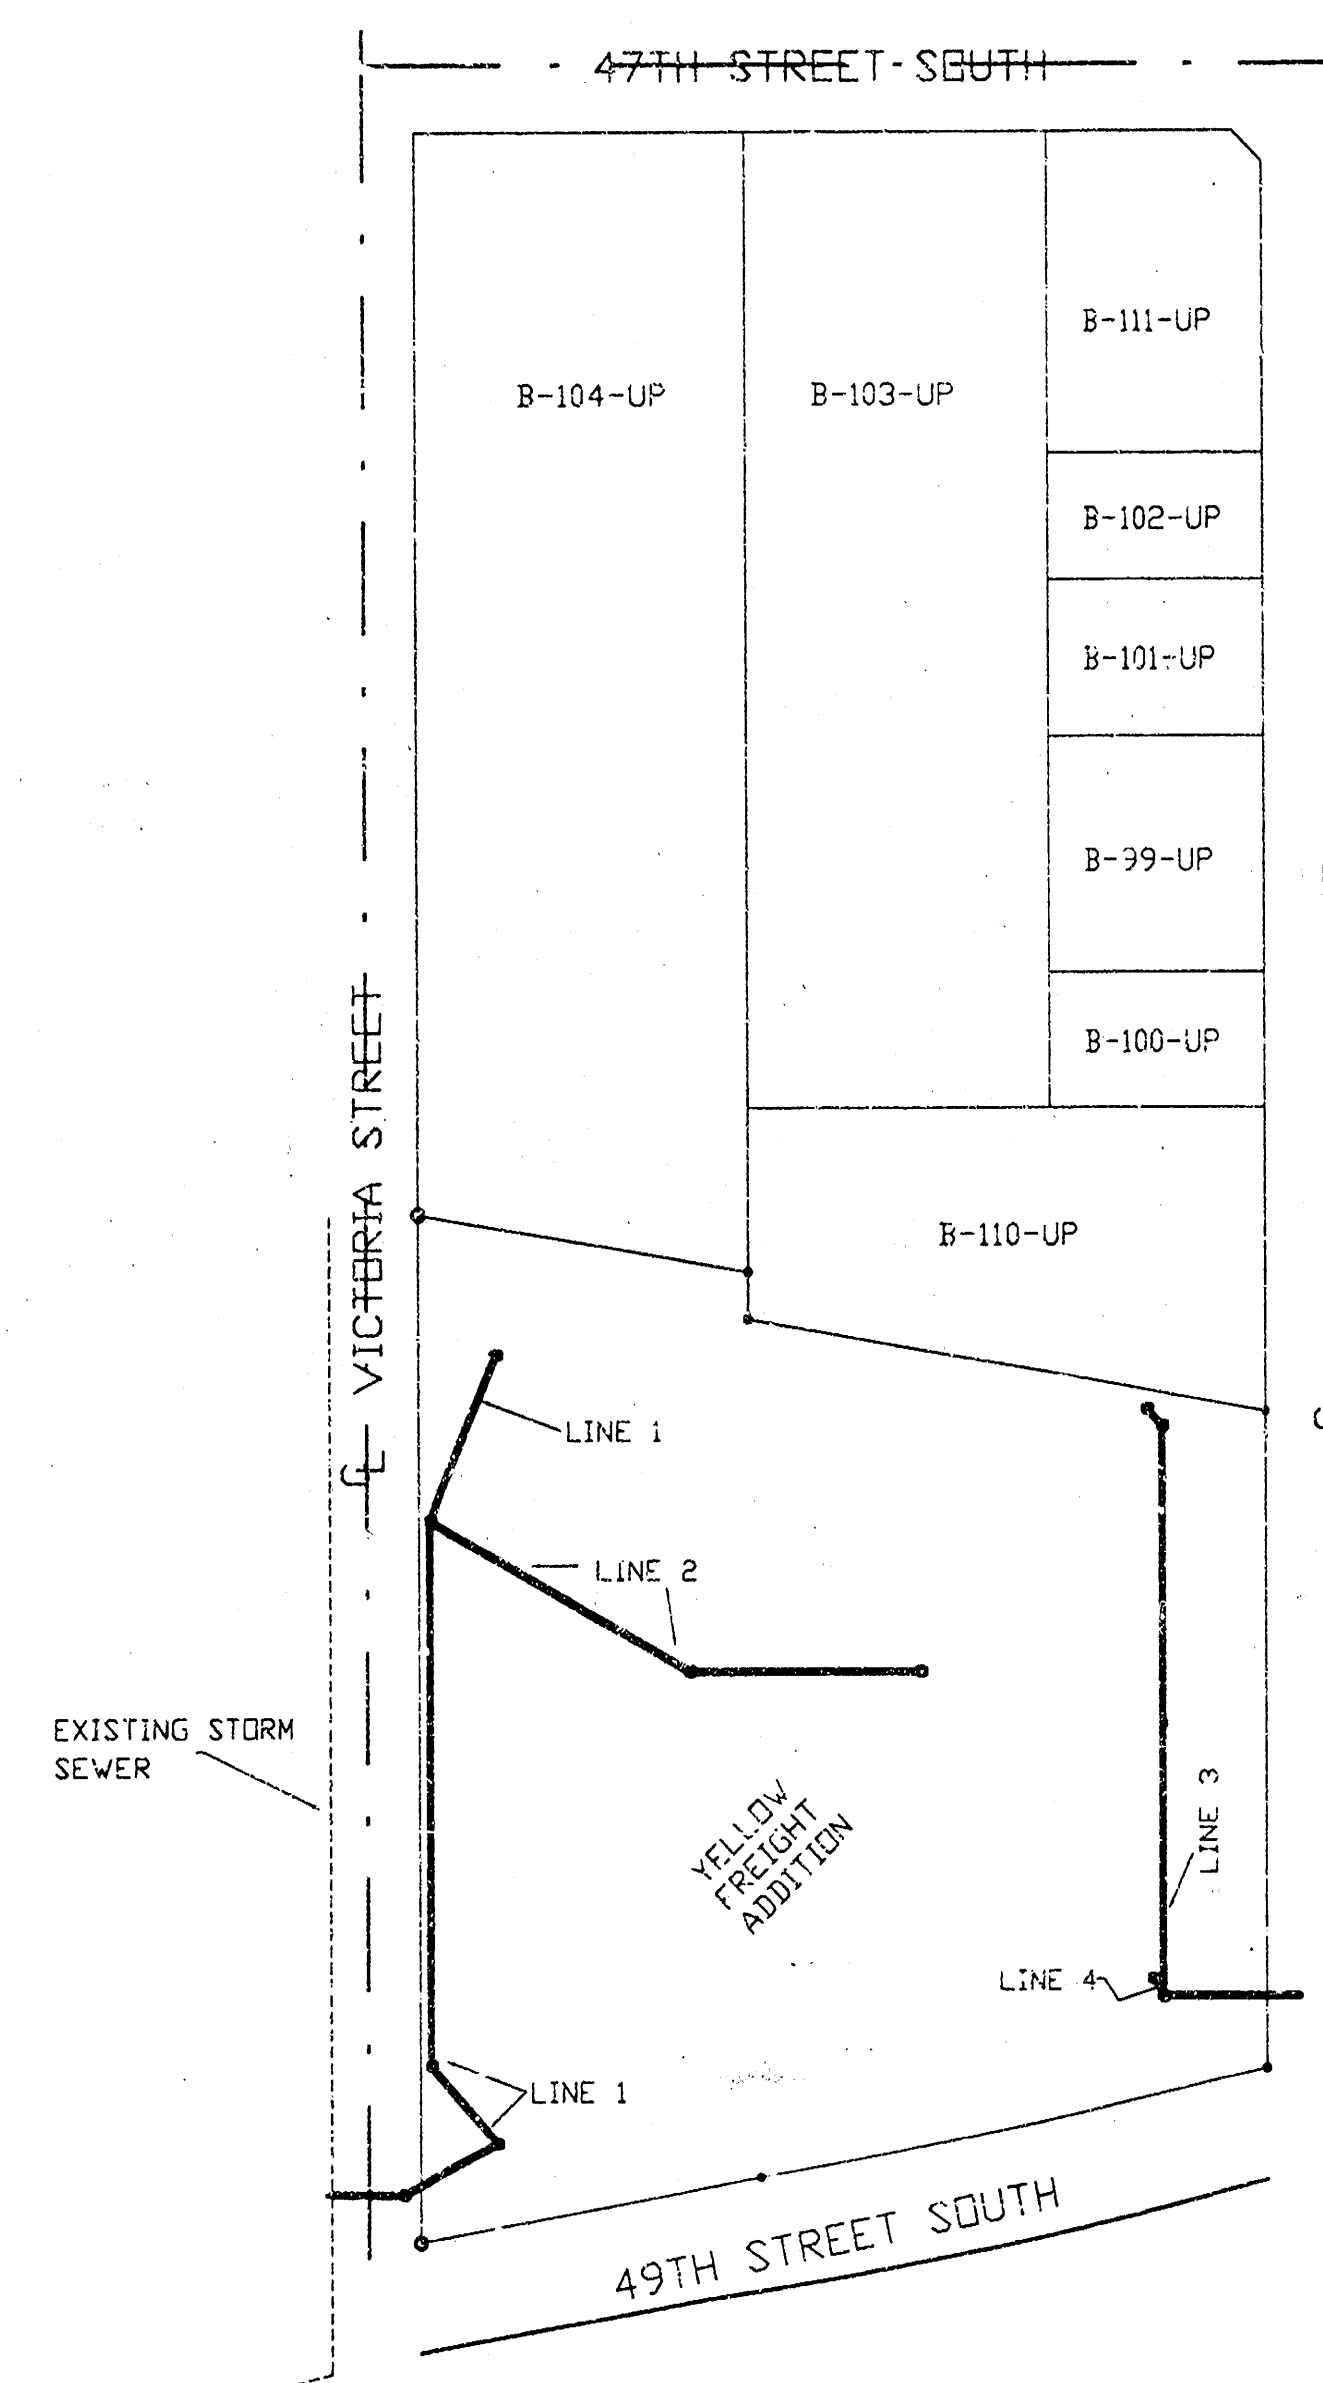


NOTE TO CONTRACTOR

INSPECTION AND TESTING FOR THIS PROJECT IS TO BE PROVIDED BY A LICENSED CONSULTING ENGINEERING FIRM UNDER CONTRACT WITH THE OWNER/DEVELOPER. SAID INSPECTION TO BE IN ACCORDANCE WITH THE CITY OF WICHITA STANDARD ENGINEERING PRACTICES AND CERTIFIED BY A LICENSED PROFESSIONAL ENGINEER. NO WORK SHALL BE PERFORMED IN DEDICATED EASEMENTS OR PUBLIC RIGHT-OF-WAY BY THE CONTRACTOR WITHOUT SUCH INSPECTION NOR SHALL ANY WORK BE COMMENCED IN DEDICATED EASEMENTS OR PUBLIC RIGHT OF WAY WITHOUT WRITTEN AUTHORIZATION BY THE CITY ENGINEER.

APPROVED AS NOTED

BY CITY ENGINEER OF WICHITA

Sanitary Sewers _____
Storm Sewers VRH 8/26/93
Driveway Approaches _____
Water Mains _____
Paving _____

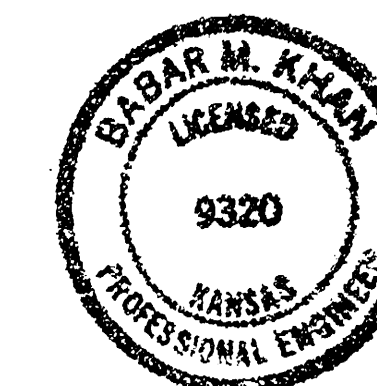

8/26/93

LOCATION MAP

MICHAEL E. LINDEBAK, P.E., CITY ENGINEER

BENCH MARK
RAILROAD SPIKE IN SE FACE POWER POLE
AT S.W. CORNER 49TH ST. SOUTH & HYDRAULIC
ELEV. = 80.99

STORM SEWER EXPANSION YELLOW FREIGHT ADDITION


SCALE: As Shown	APPROVED:	DRAWN BY:
DATE:	CHECKED:	
PROJECT NO.:		SHEET NO.: 1 OF 3

ME MUNICIPAL ENGINEERS
254-LAURA, SUITE 201
WICHITA, KANSAS 67211
316-262-3842

SCALE:
 PLAN: 1" = 40'
 PROFILE: 1" = 40' (H)
 1" = 5' (V)


NOTE:

1. CONTRACTOR SHALL BACKFILL STORM SEWER TRENCH FROM STATION 0+02 TO STATION 0+45 ON LINE 1 WITH FLOWABLE FILL IN ACCORDANCE WITH CITY OF WICHITA STANDARDS.

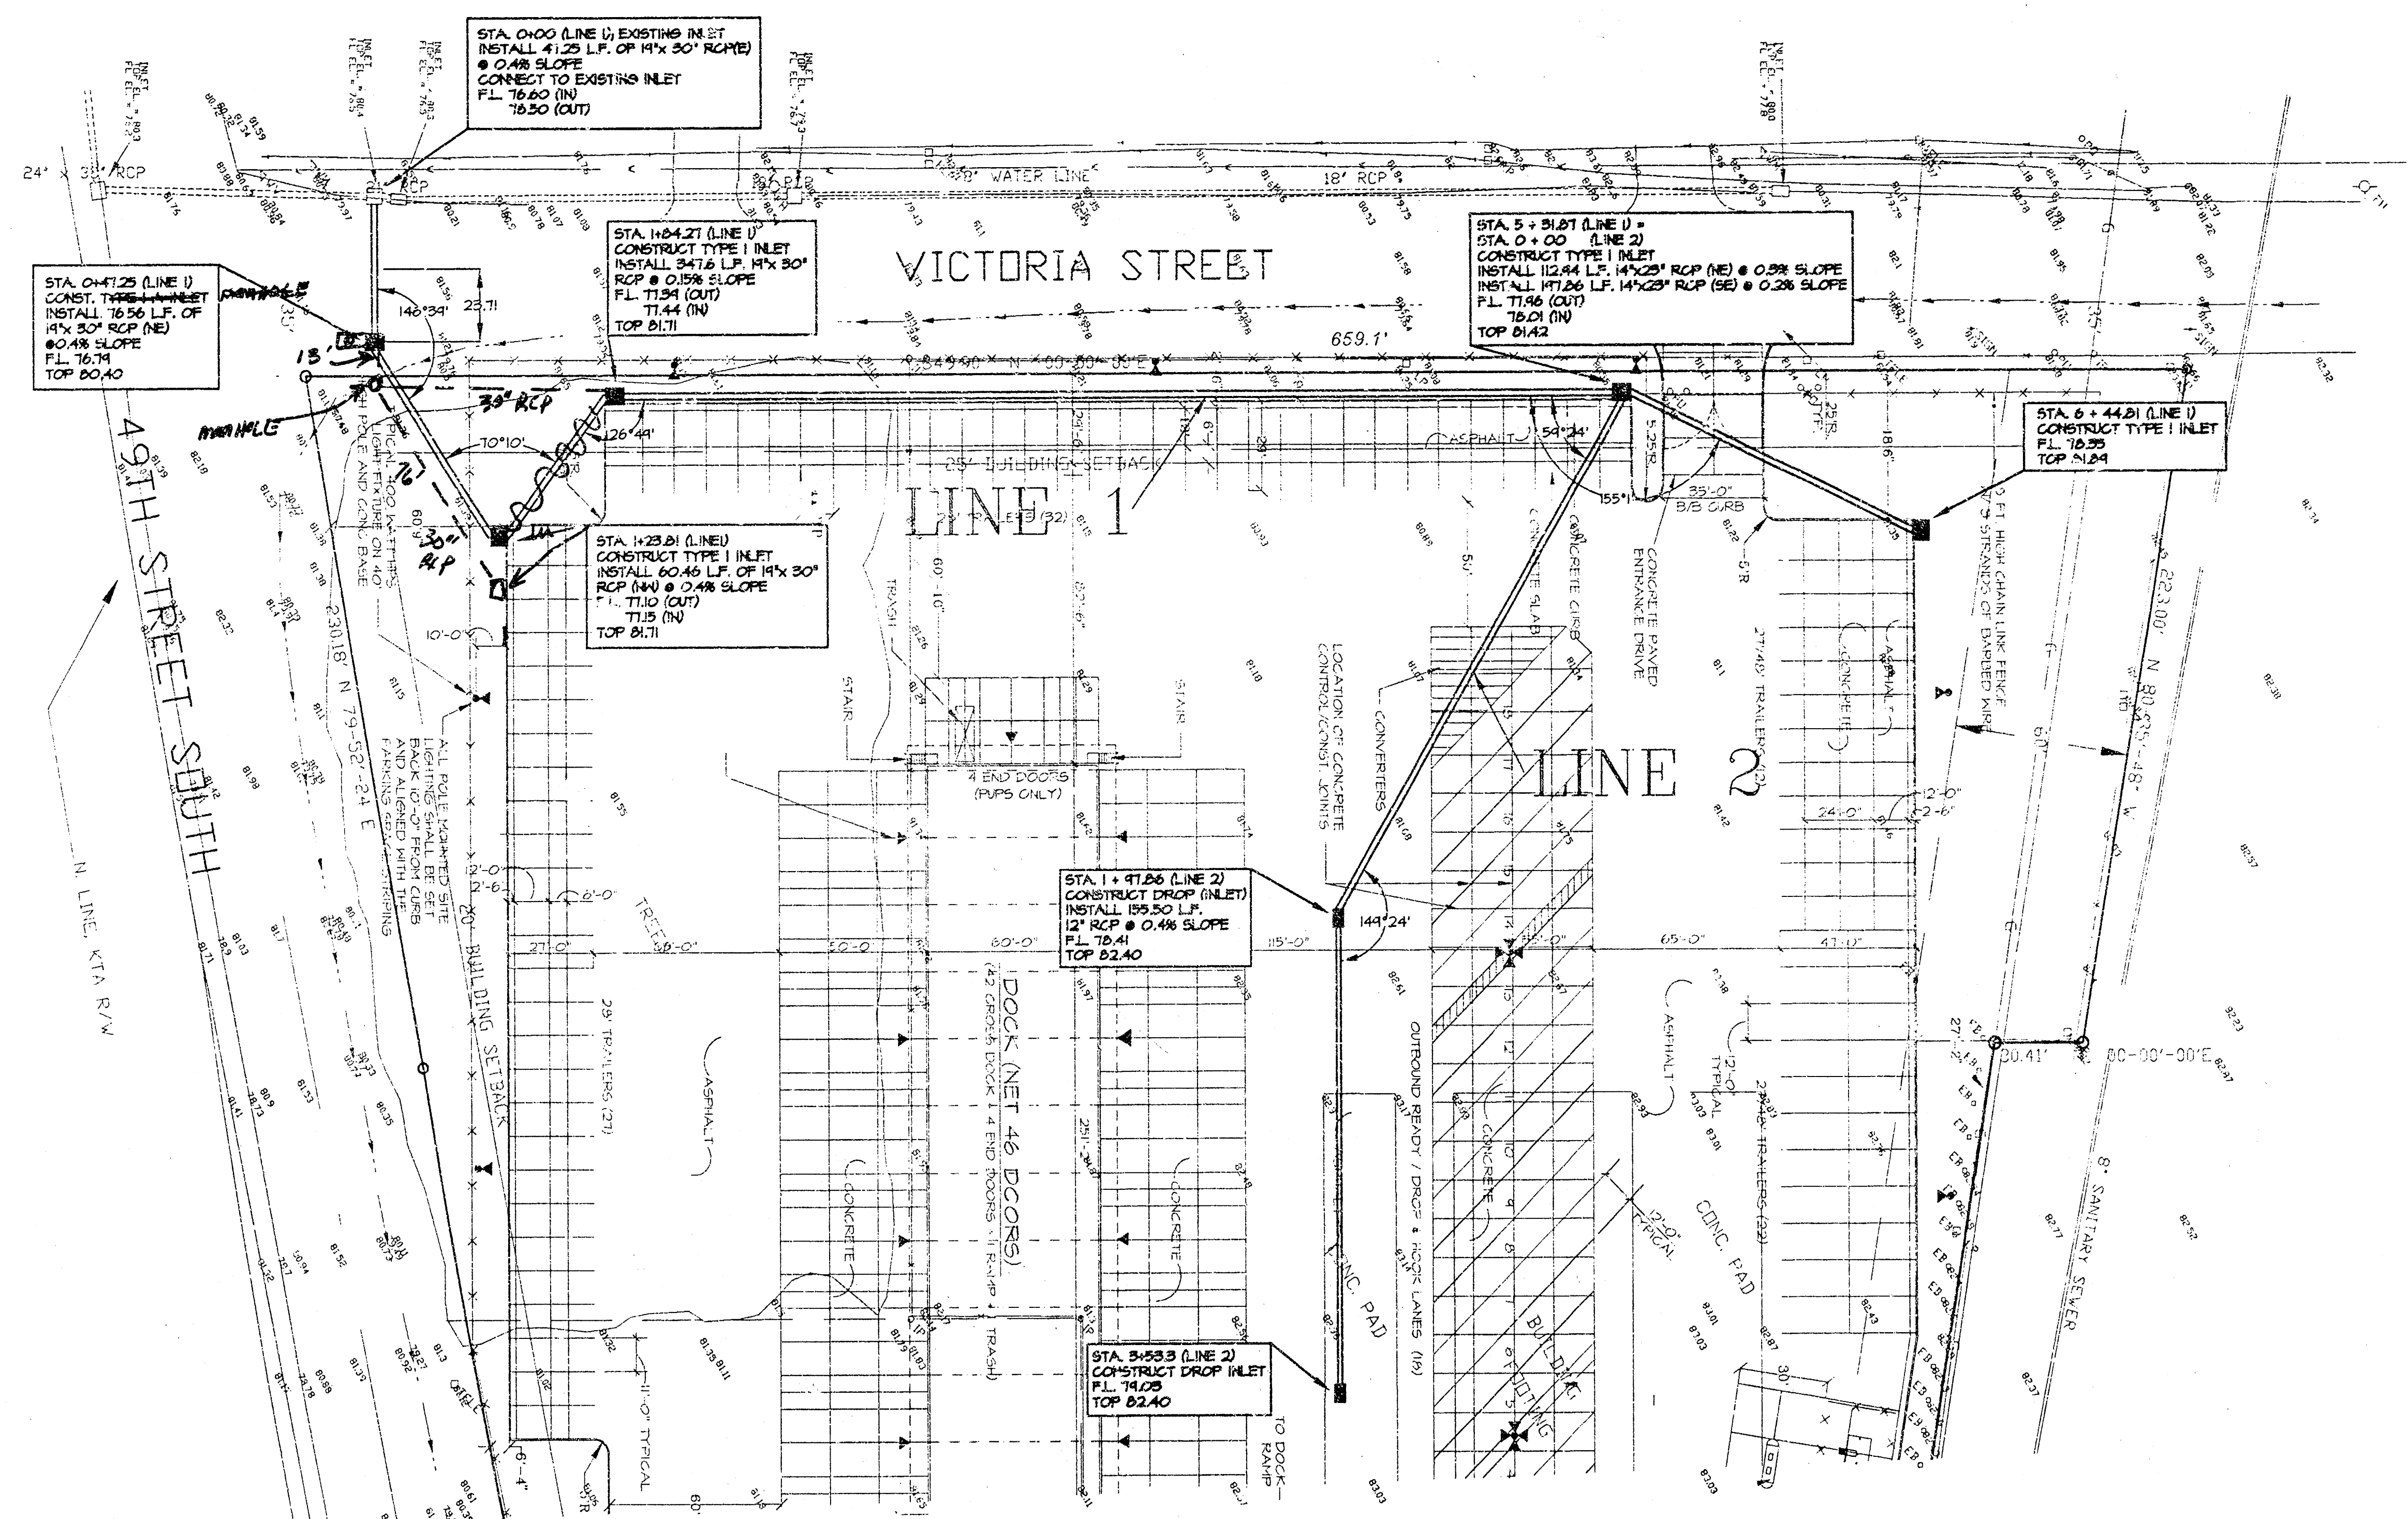

LEGEND

- EXISTING TREE
- GAS METER
- EXISTING FIRE HYDRANT
- EXISTING LIGHT POLE
- EXISTING POWER POLE
- CMP CORRUGATED METAL PIPE
- RCP REINFORCED CONCRETE PIPE
- EXISTING CONTOURS
- EXISTING SPOT ELEVATIONS
- PARKING METER
- SIGNS
- TRAFFIC SIGNAL
- UNDERGROUND WATER LINE
- UNDERGROUND TELEPHONE
- UNDERGROUND ELECTRICAL
- UNDERGROUND GAS
- EXISTING WATER VALVE
- EXISTING WATER METER
- EXISTING MANHOLE

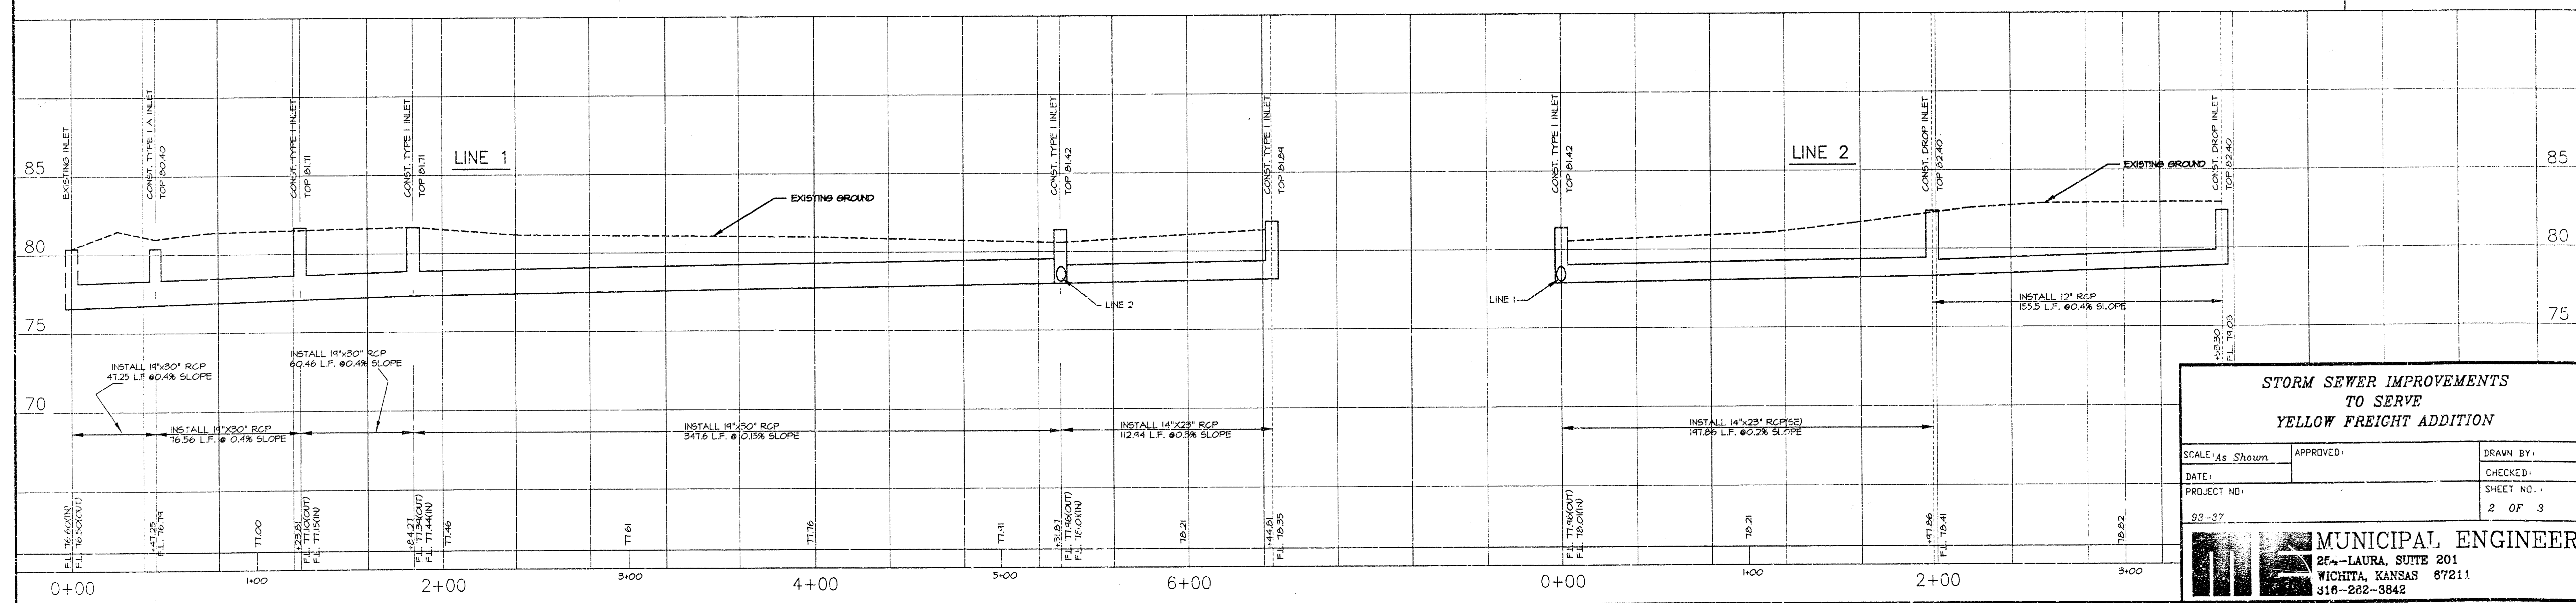


STORM SEWER IMPROVEMENTS TO SERVE YELLOW FREIGHT ADDITION

SCALE: As Shown
 APPROVED: _____
 DATE: _____
 PROJECT NO: _____
 DRAWN BY: _____
 CHECKED: _____
 SHEET NO: 2 OF 3


MUNICIPAL ENGINEERS
 2601 LAURA, SUITE 201
 WICHITA, KANSAS 67211
 316-262-3842

SCALE:
 PLAN : 1" = 40'
 PROFILE : 1" = 40' (H)
 1" = 5' (V)

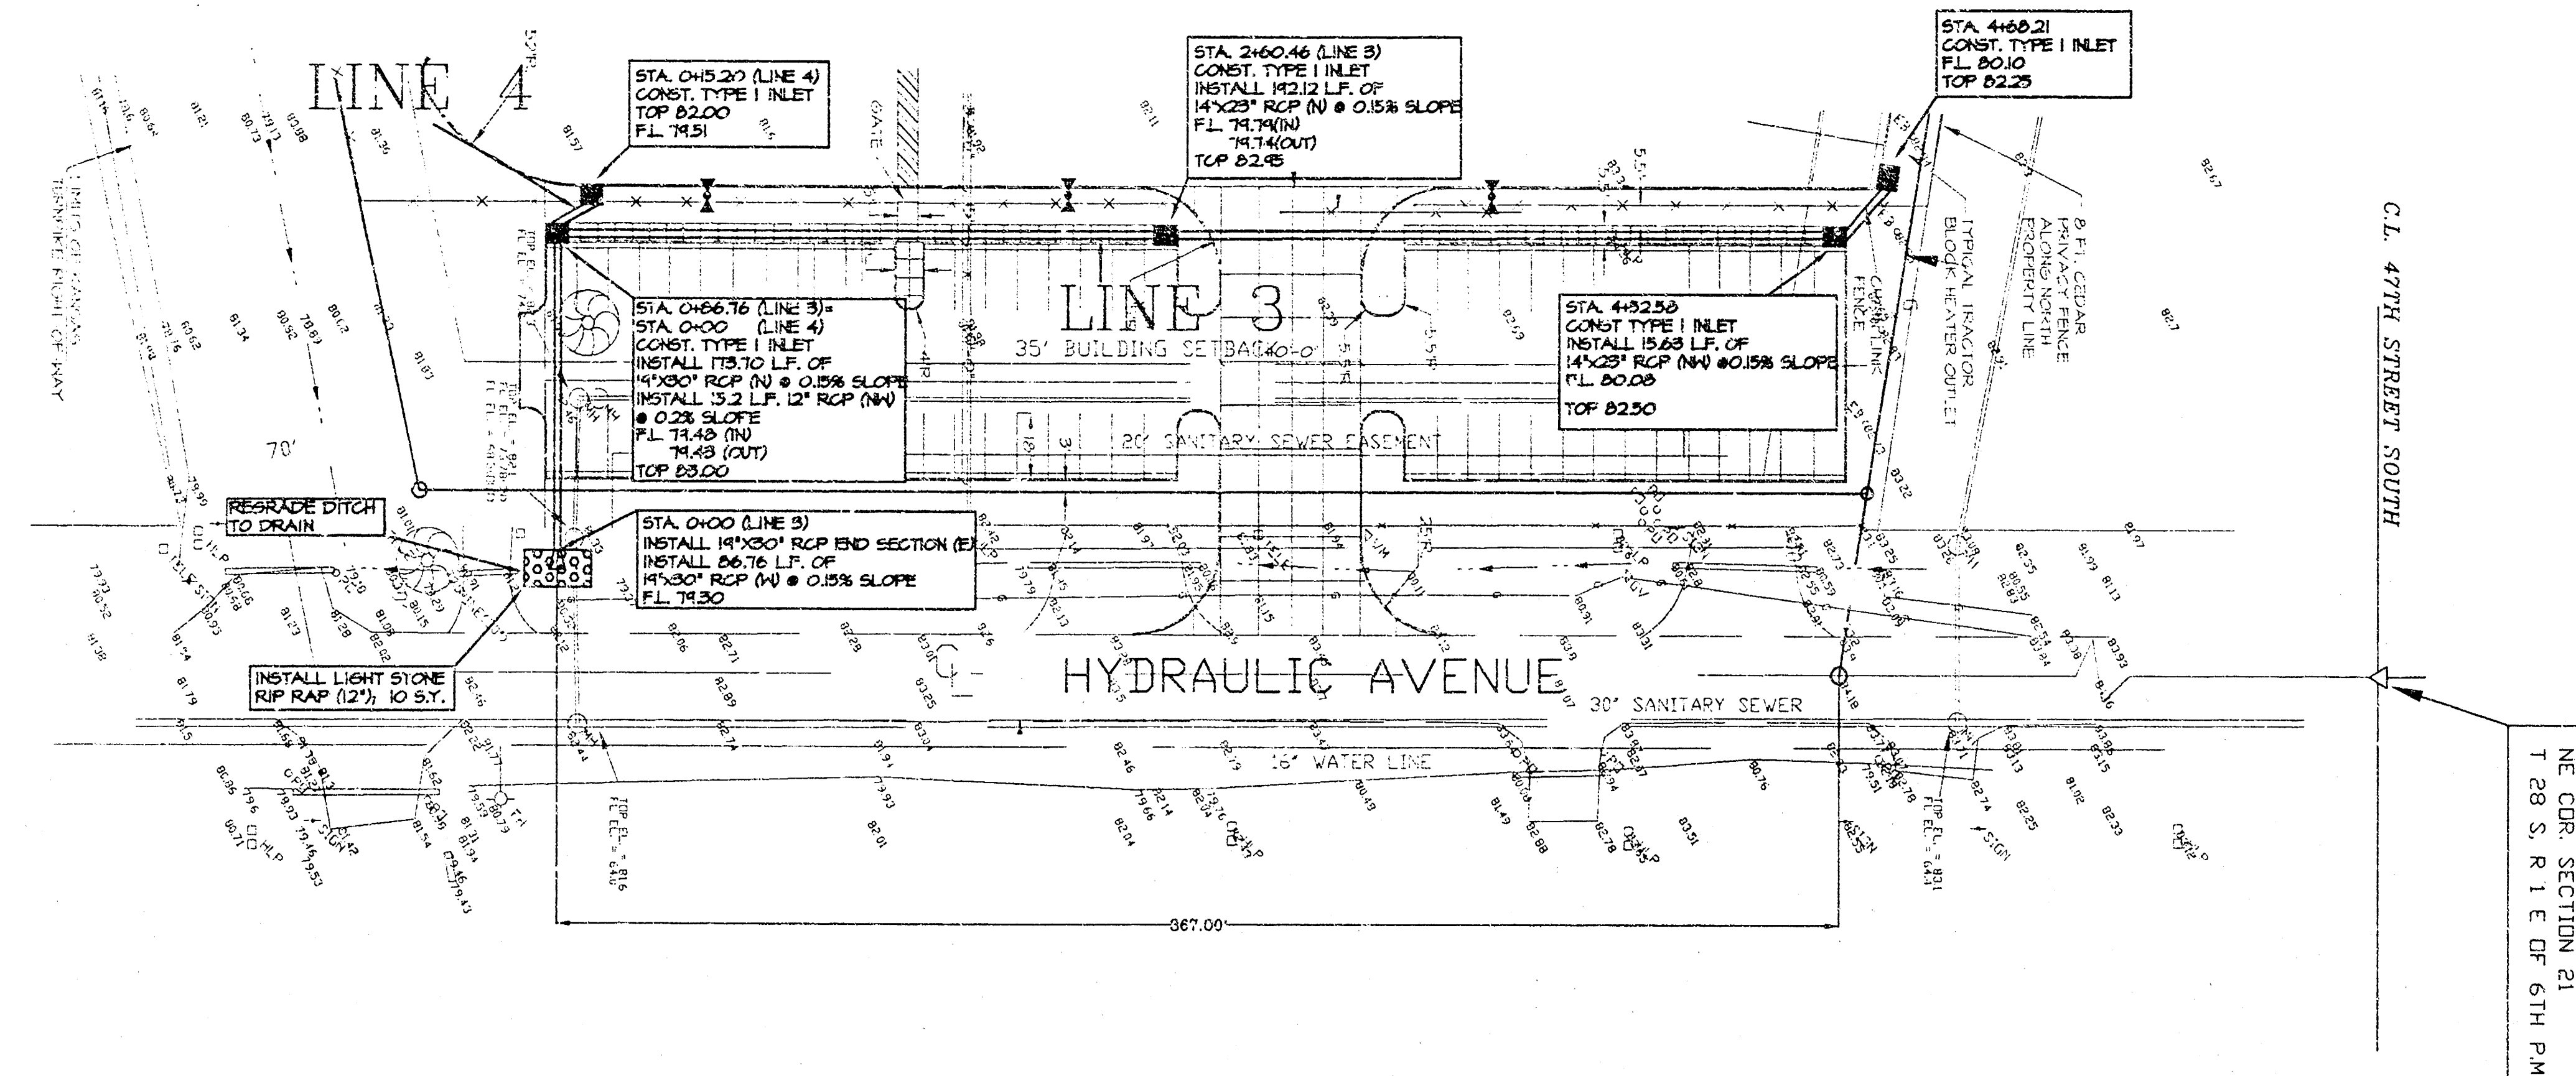

LEGEND

	EXISTING TREE
	GAS METER
	EXISTING FIRE HYDRANT
	EXISTING LIGHT POLE
	EXISTING POWER POLE
	CORRUGATED METAL PIPE
	REINFORCED CONCRETE PIPE
	EXISTING CONTOURS
	EXISTING SPOT ELEVATIONS
	PARKING METER
	SIGNS
	TRAFFIC SIGNAL
	UNDERGROUND WATER LINE
	UNDERGROUND TELEPHONE
	UNDERGROUND ELECTRICAL
	UNDERGROUND GAS
	EXISTING WATER VALVE
	EXISTING WATER METER
	EXISTING MANHOLE

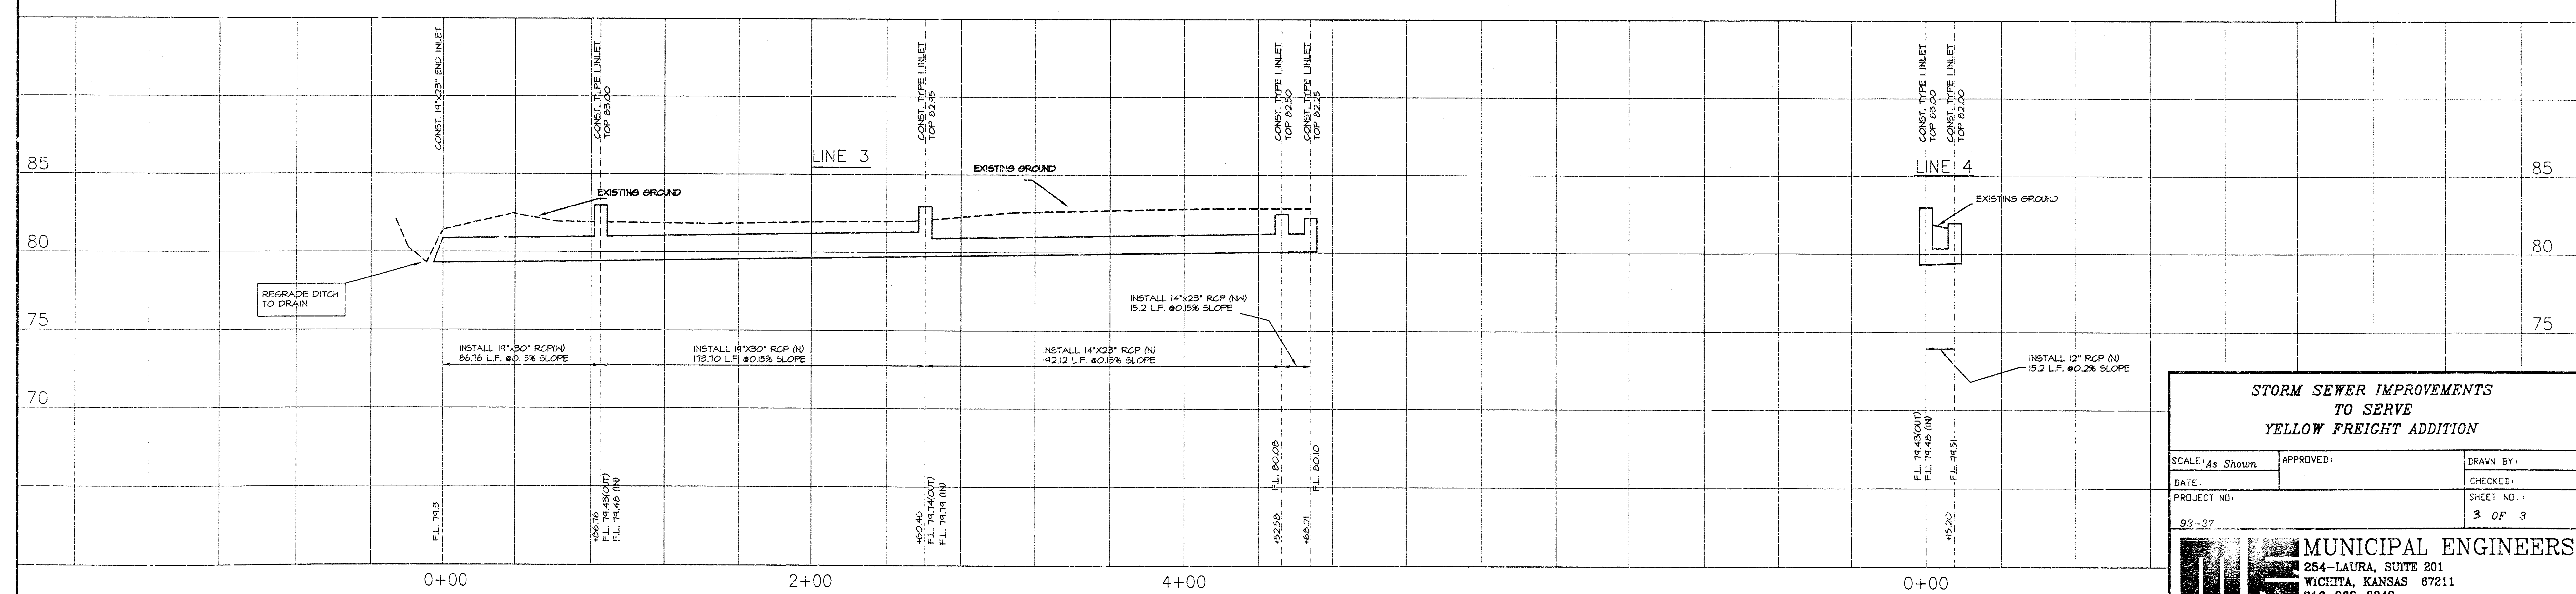

**STORM SEWER IMPROVEMENTS
 TO SERVE
 YELLOW FREIGHT ADDITION**

SCALE: As Shown	APPROVED:	DRAWN BY:
DATE:	CHECKED:	
PROJECT NO:		SHEET NO. 3 OF 3

Municipal Engineers
 254-Laura, Suite 201
 Wichita, Kansas 67211
 316-262-5842